




11+25

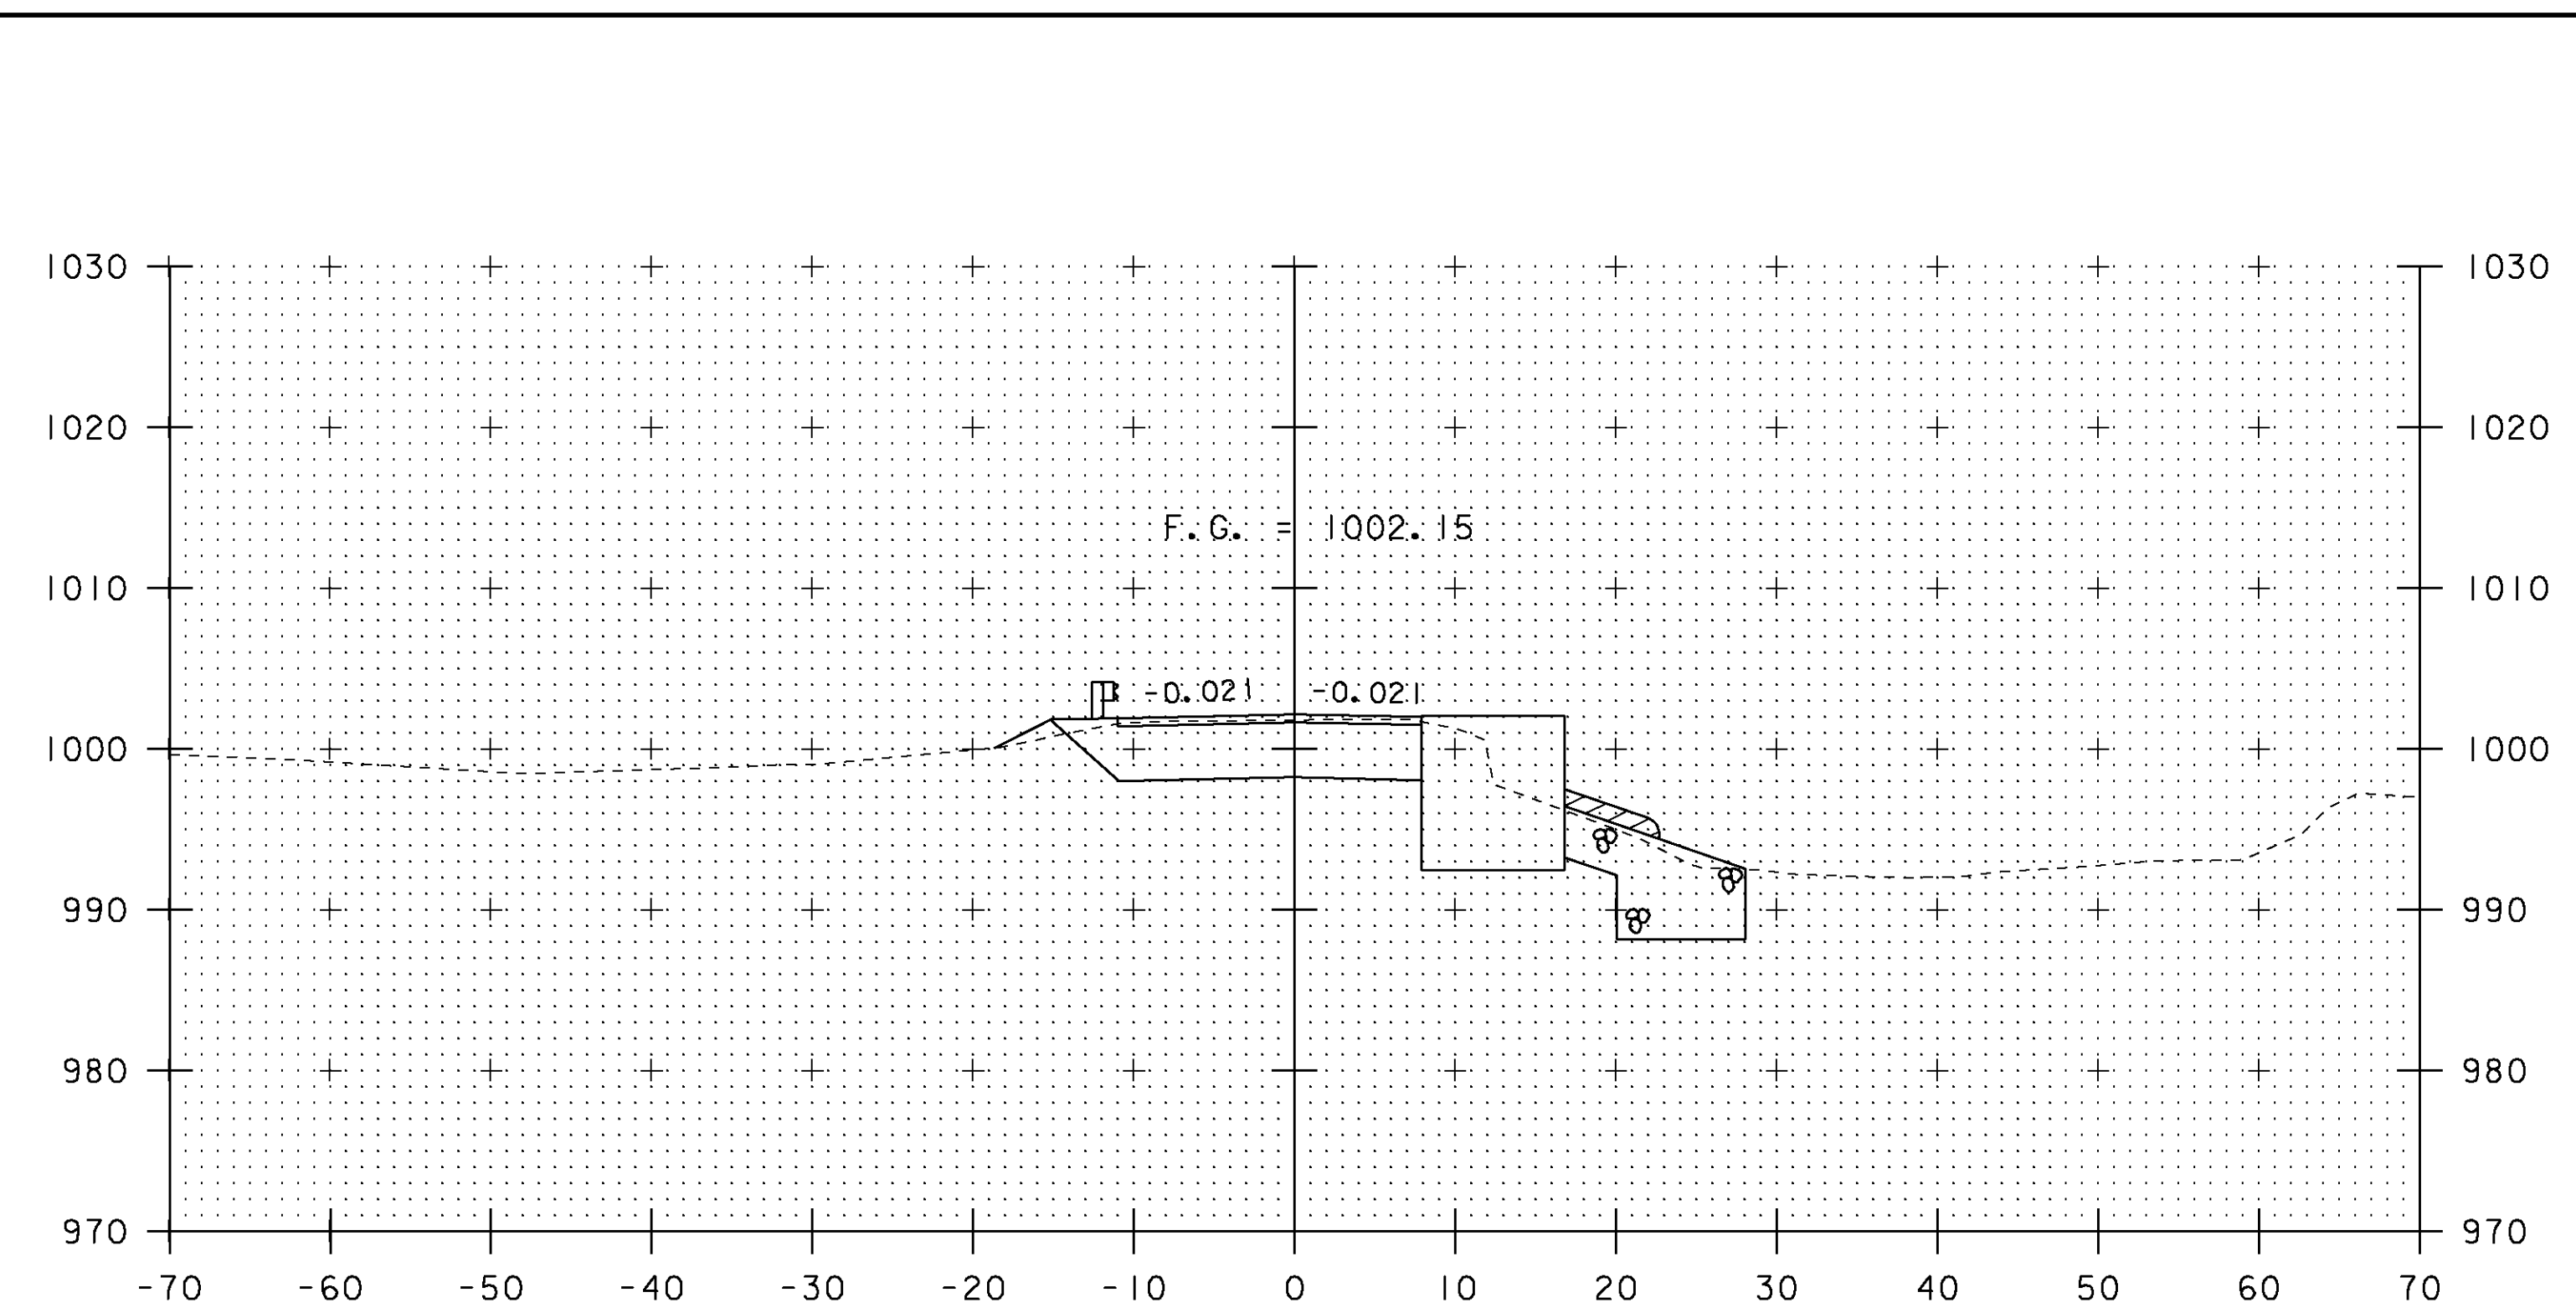


11+75

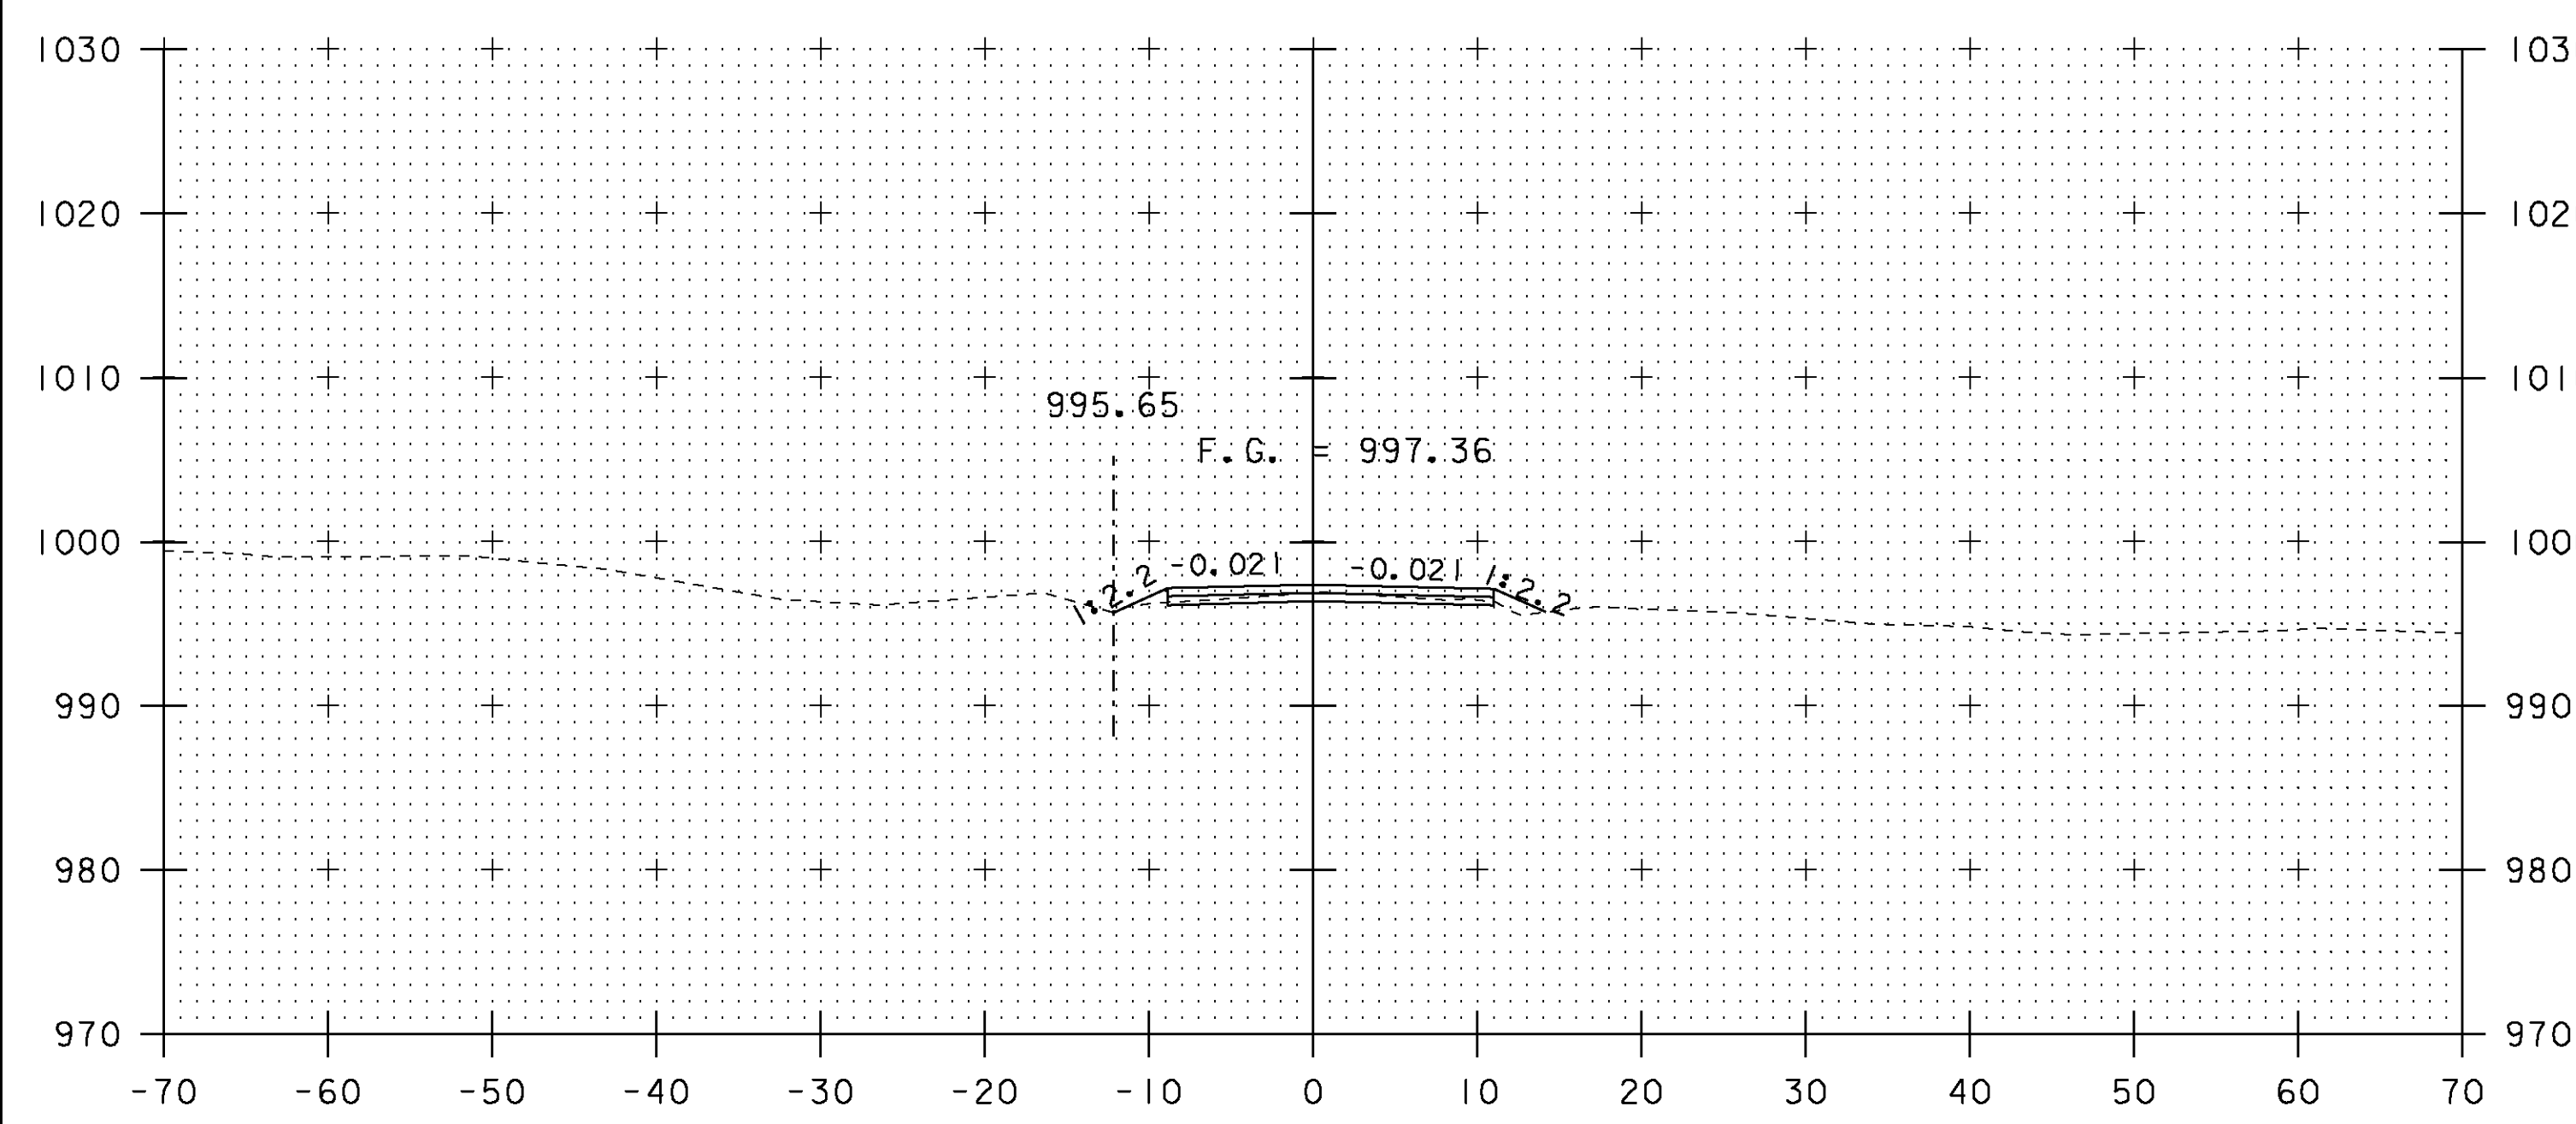

11+00

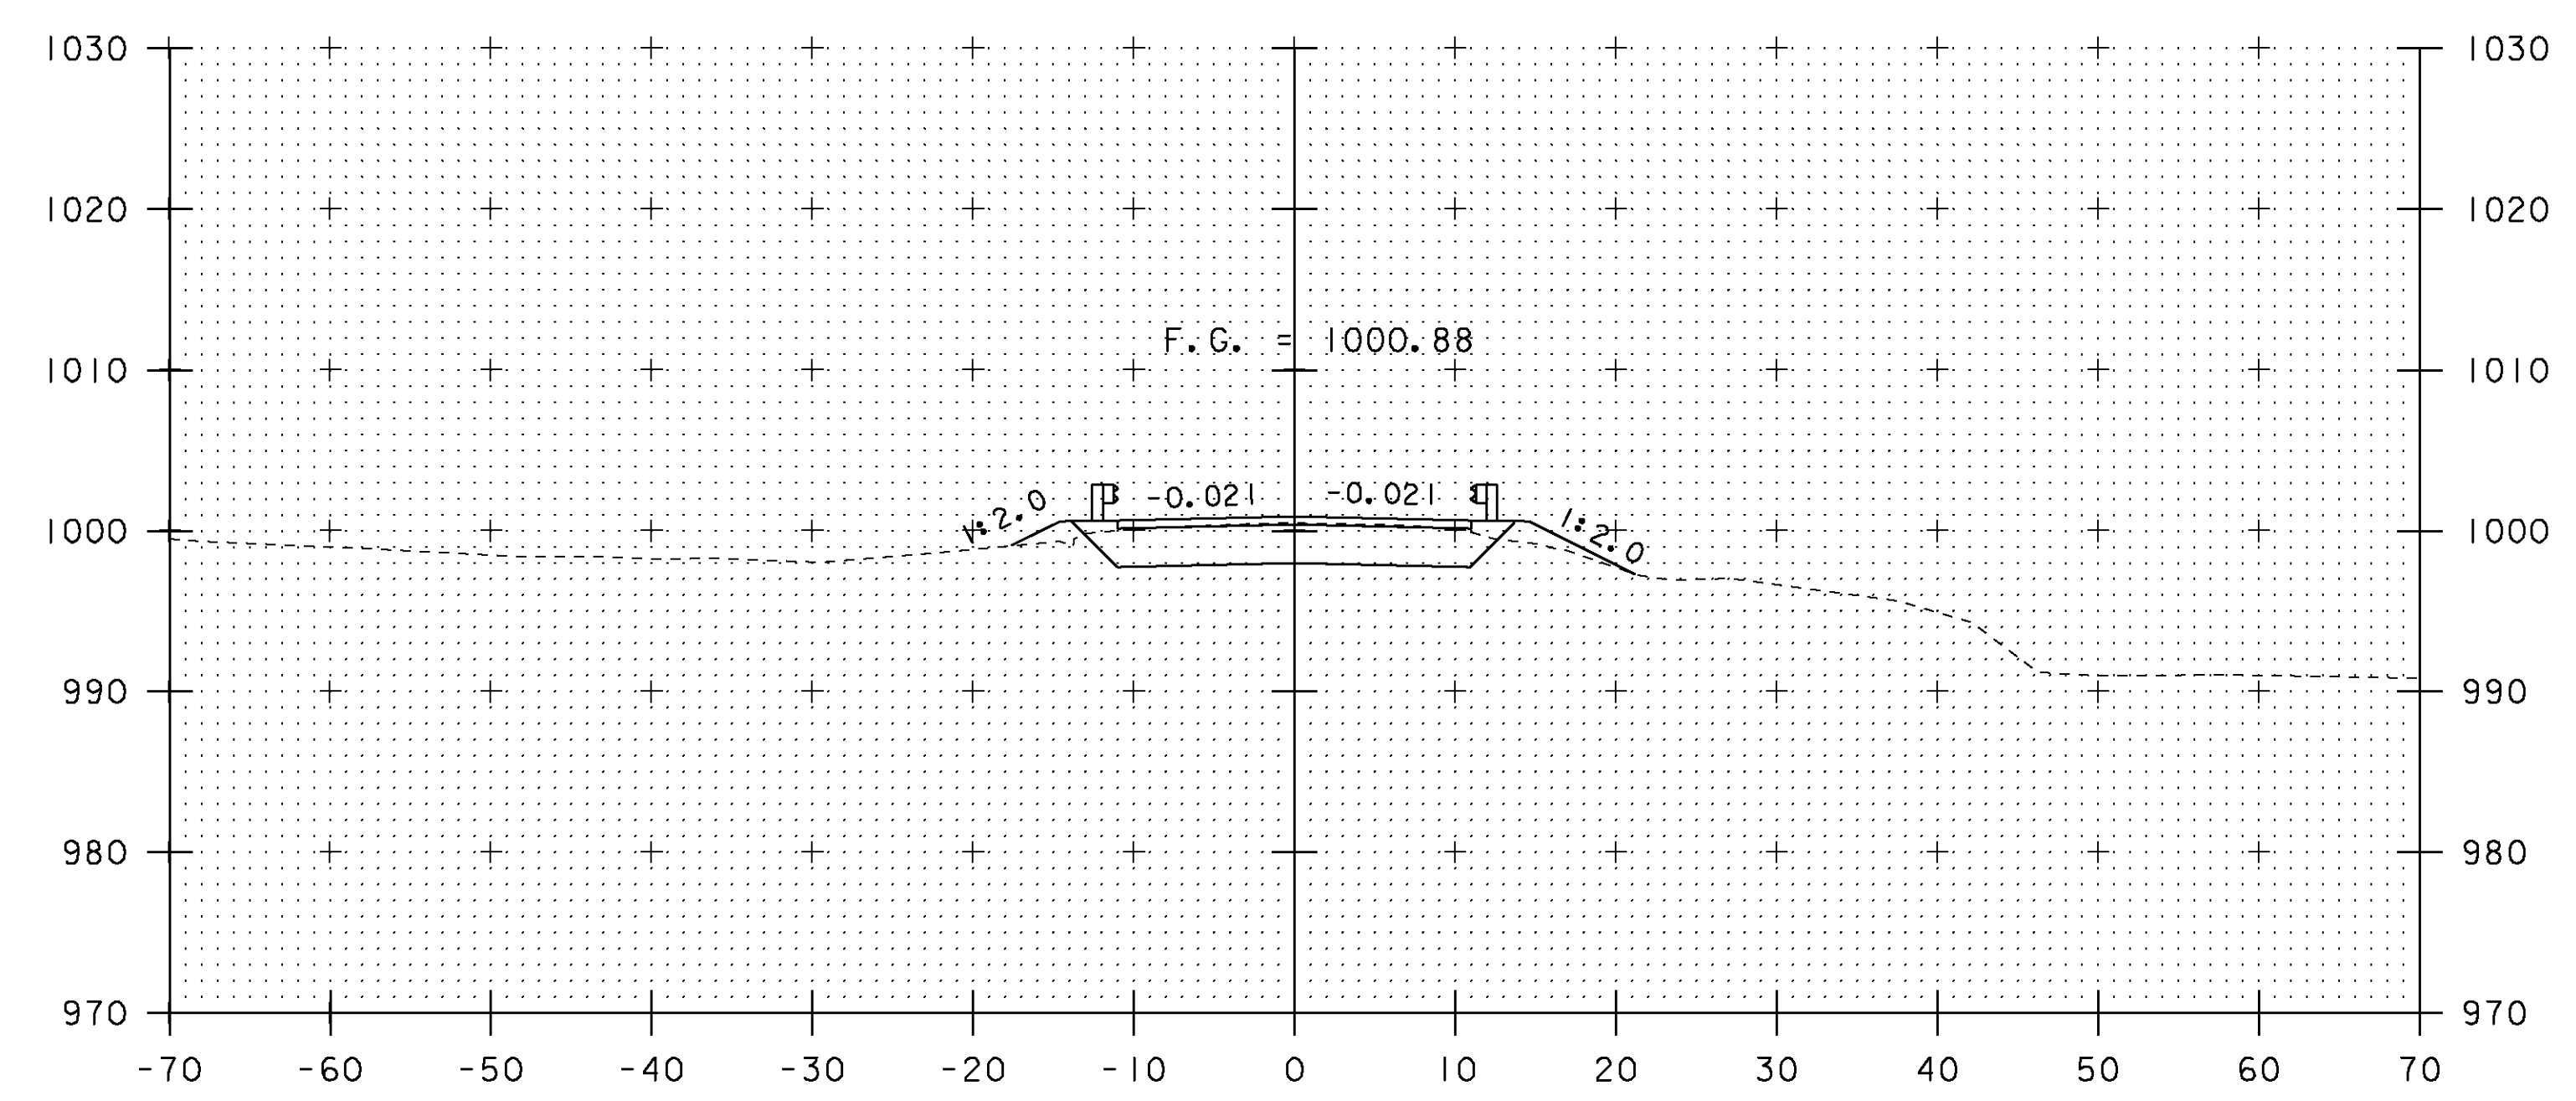

BEGIN PROJECT
11+50

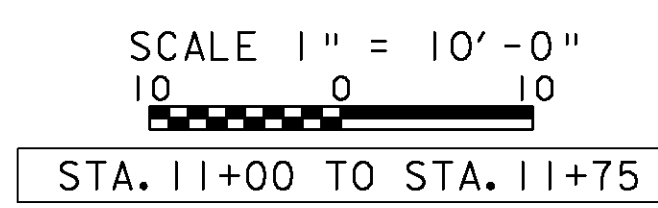

PROJECT NAME: MENDON	PROJECT NUMBER: BRO 1443 (43)
FILE NAME: s01j272xs.dgn	PLOT DATE: 07-SEP-2010
PROJECT LEADER: K. HIGGINS	DRAWN BY: G. LAROCHE
DESIGNED BY: G. LAROCHE	CHECKED BY: J. SALVATORI
MAINLINE SECTIONS #2	SHEET 28 OF 32