




12+25
END BRIDGE STA 12+16.00

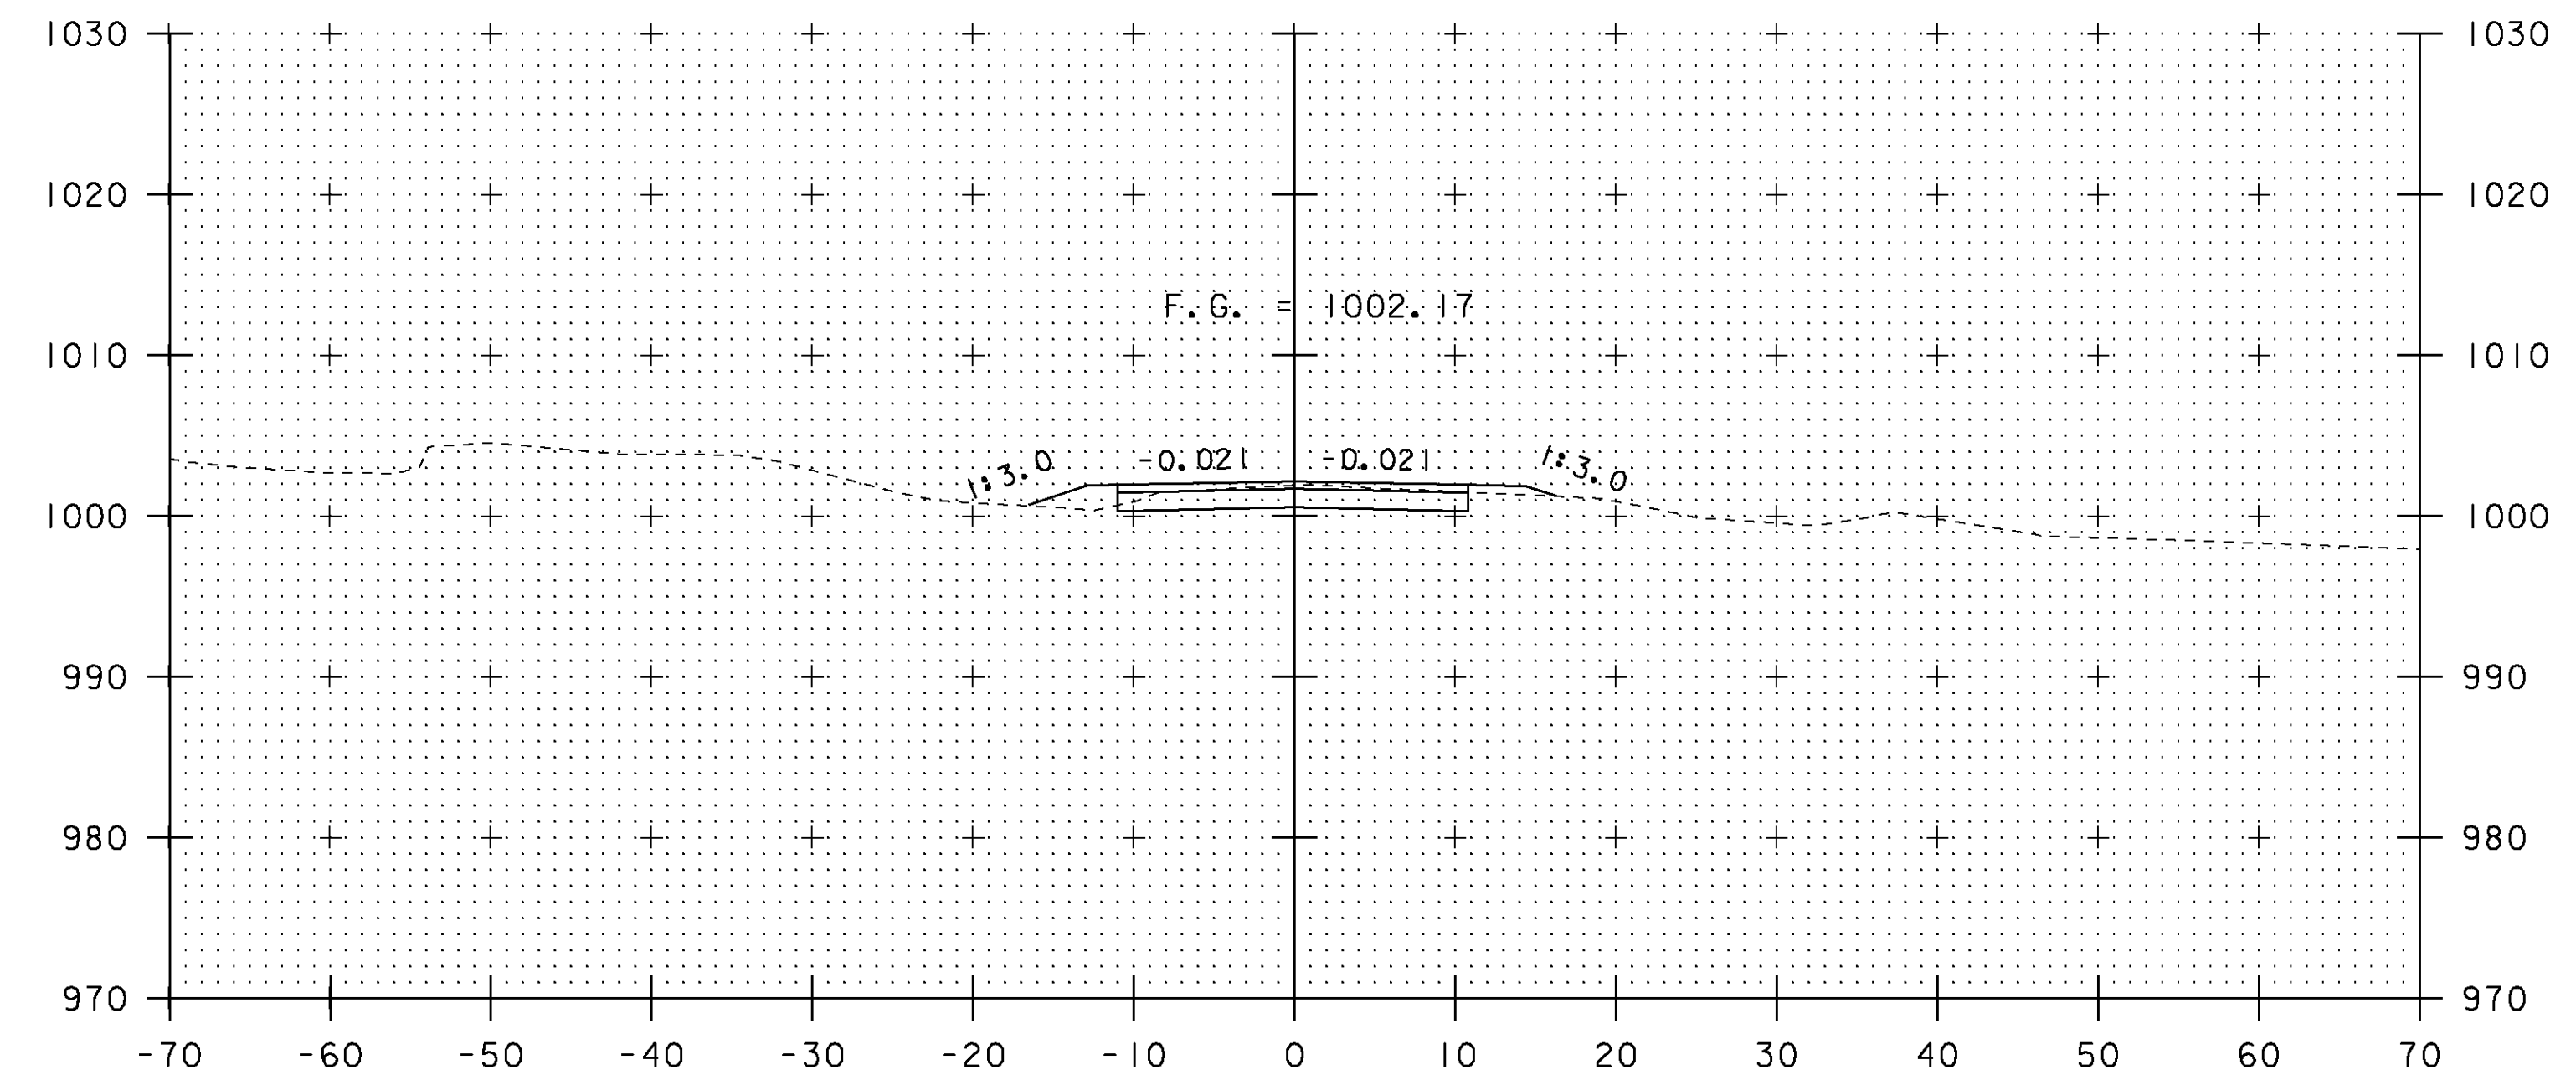


12+75

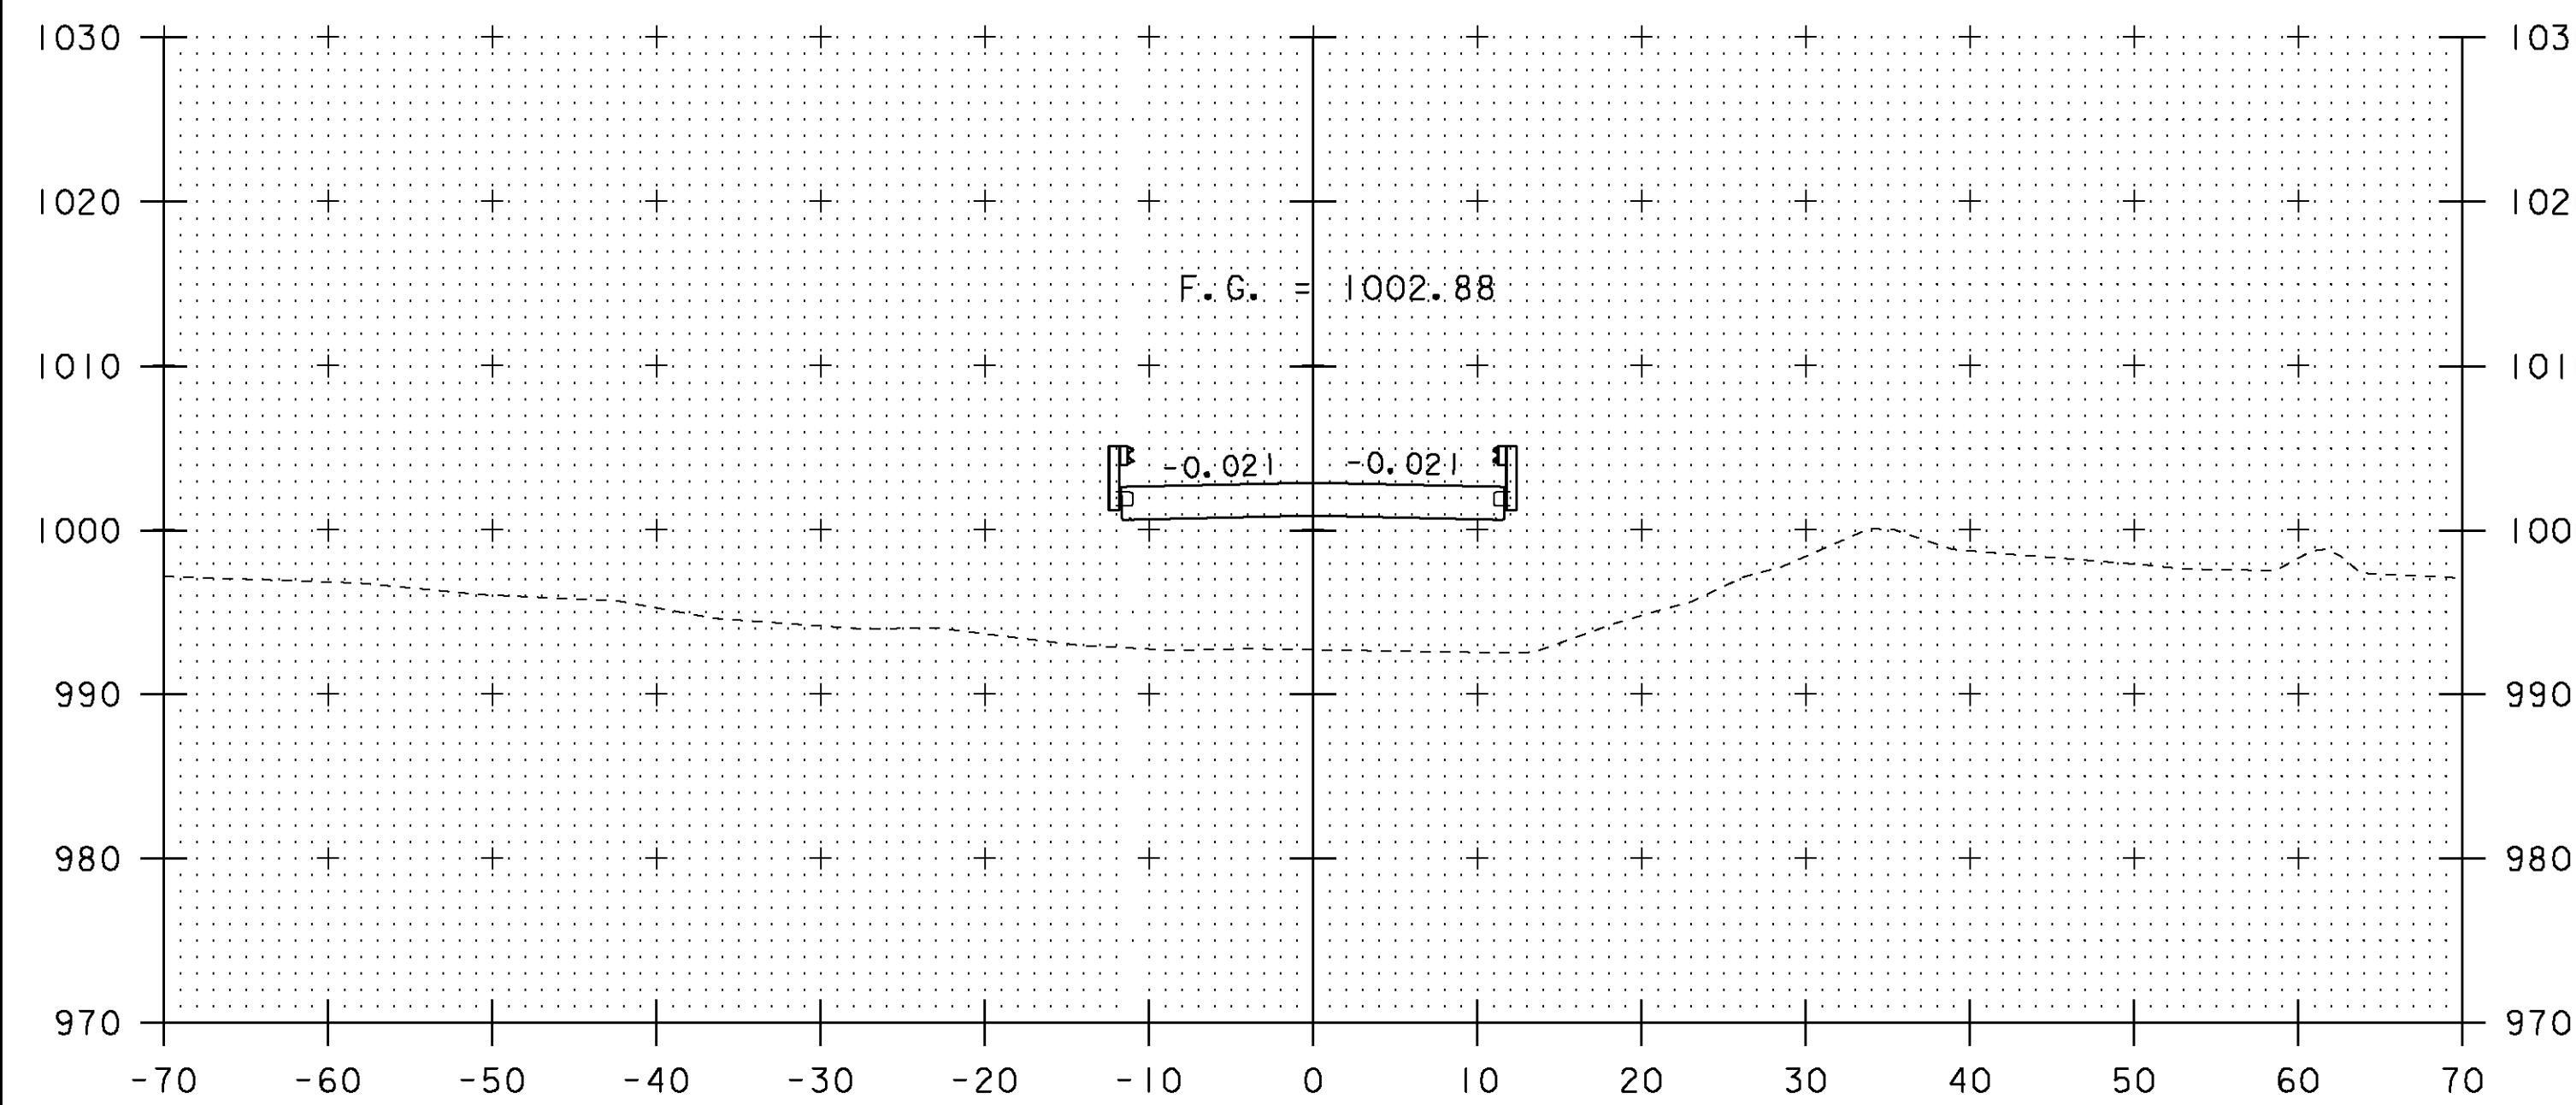

12+00
BEGIN BRIDGE STA 11+77.00

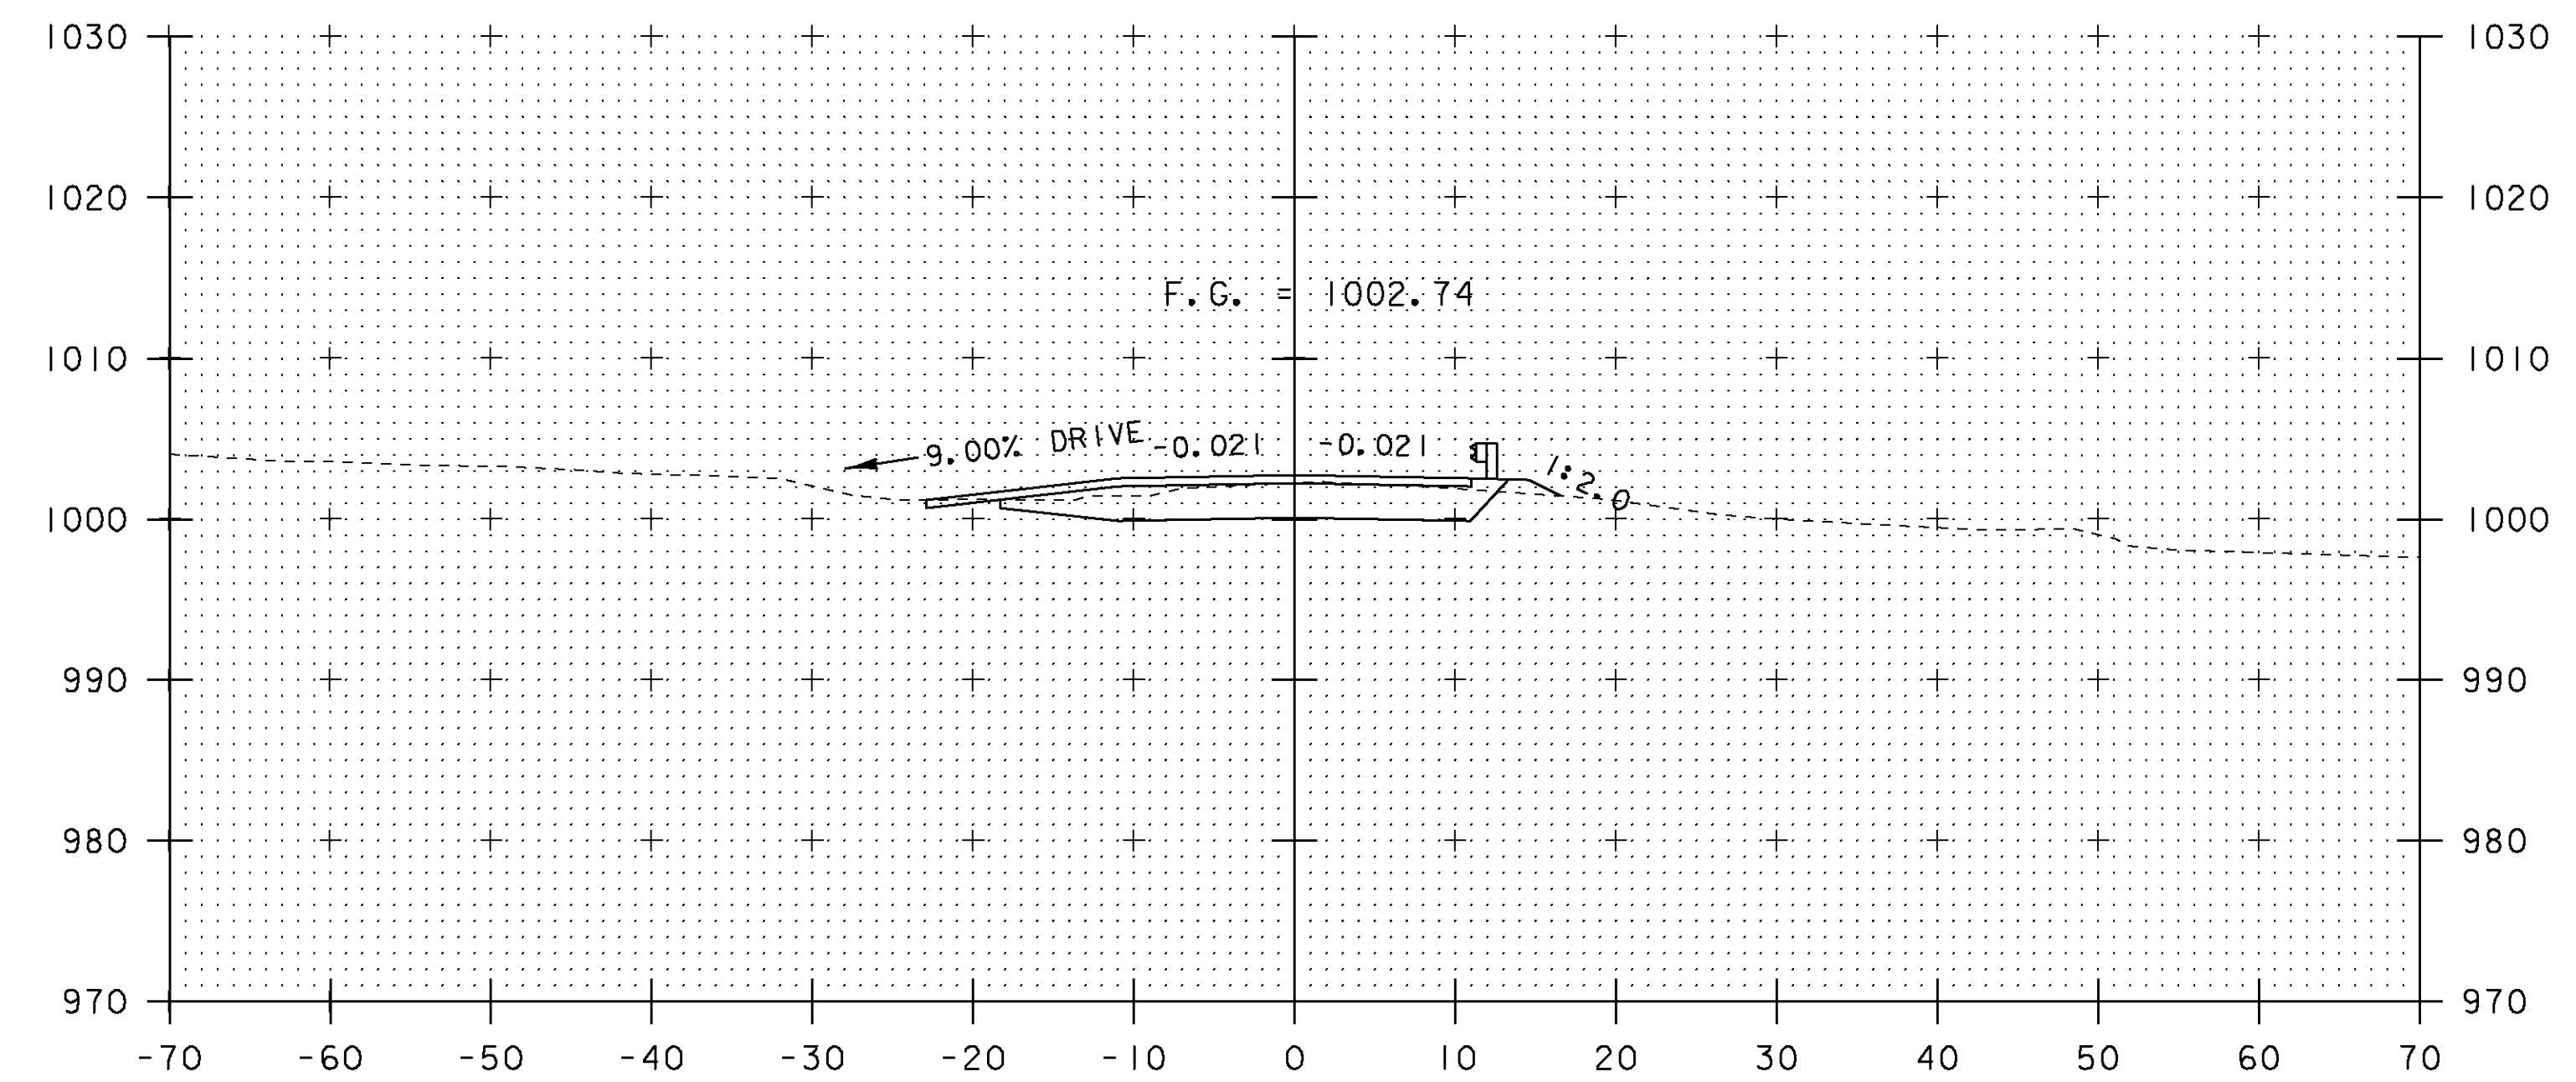

END PROJECT
12+50

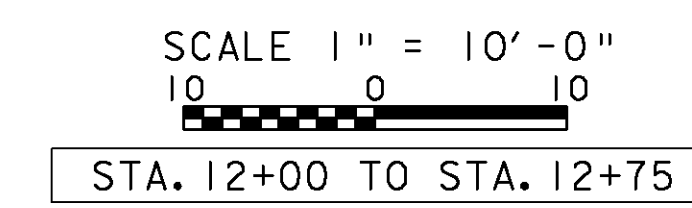

PROJECT NAME: MENDON	FILE NAME: s01j272xs.dgn	PLOT DATE: 07-SEP-2010
PROJECT NUMBER: BRO 1443 (43)	PROJECT LEADER: K. HIGGINS	DRAWN BY: G. LAROCHE
	DESIGNED BY: G. LAROCHE	CHECKED BY: J. SALVATORI
	MAINLINE SECTIONS #3	SHEET 29 OF 32