




EXISTING GROUND NO LONGER VALID SINCE IRENE 8-28-11.  
NEW SURVEY REQUIRED FOR CHANNEL SECTIONS  
(TYP ALL SHEETS 31 & 32).

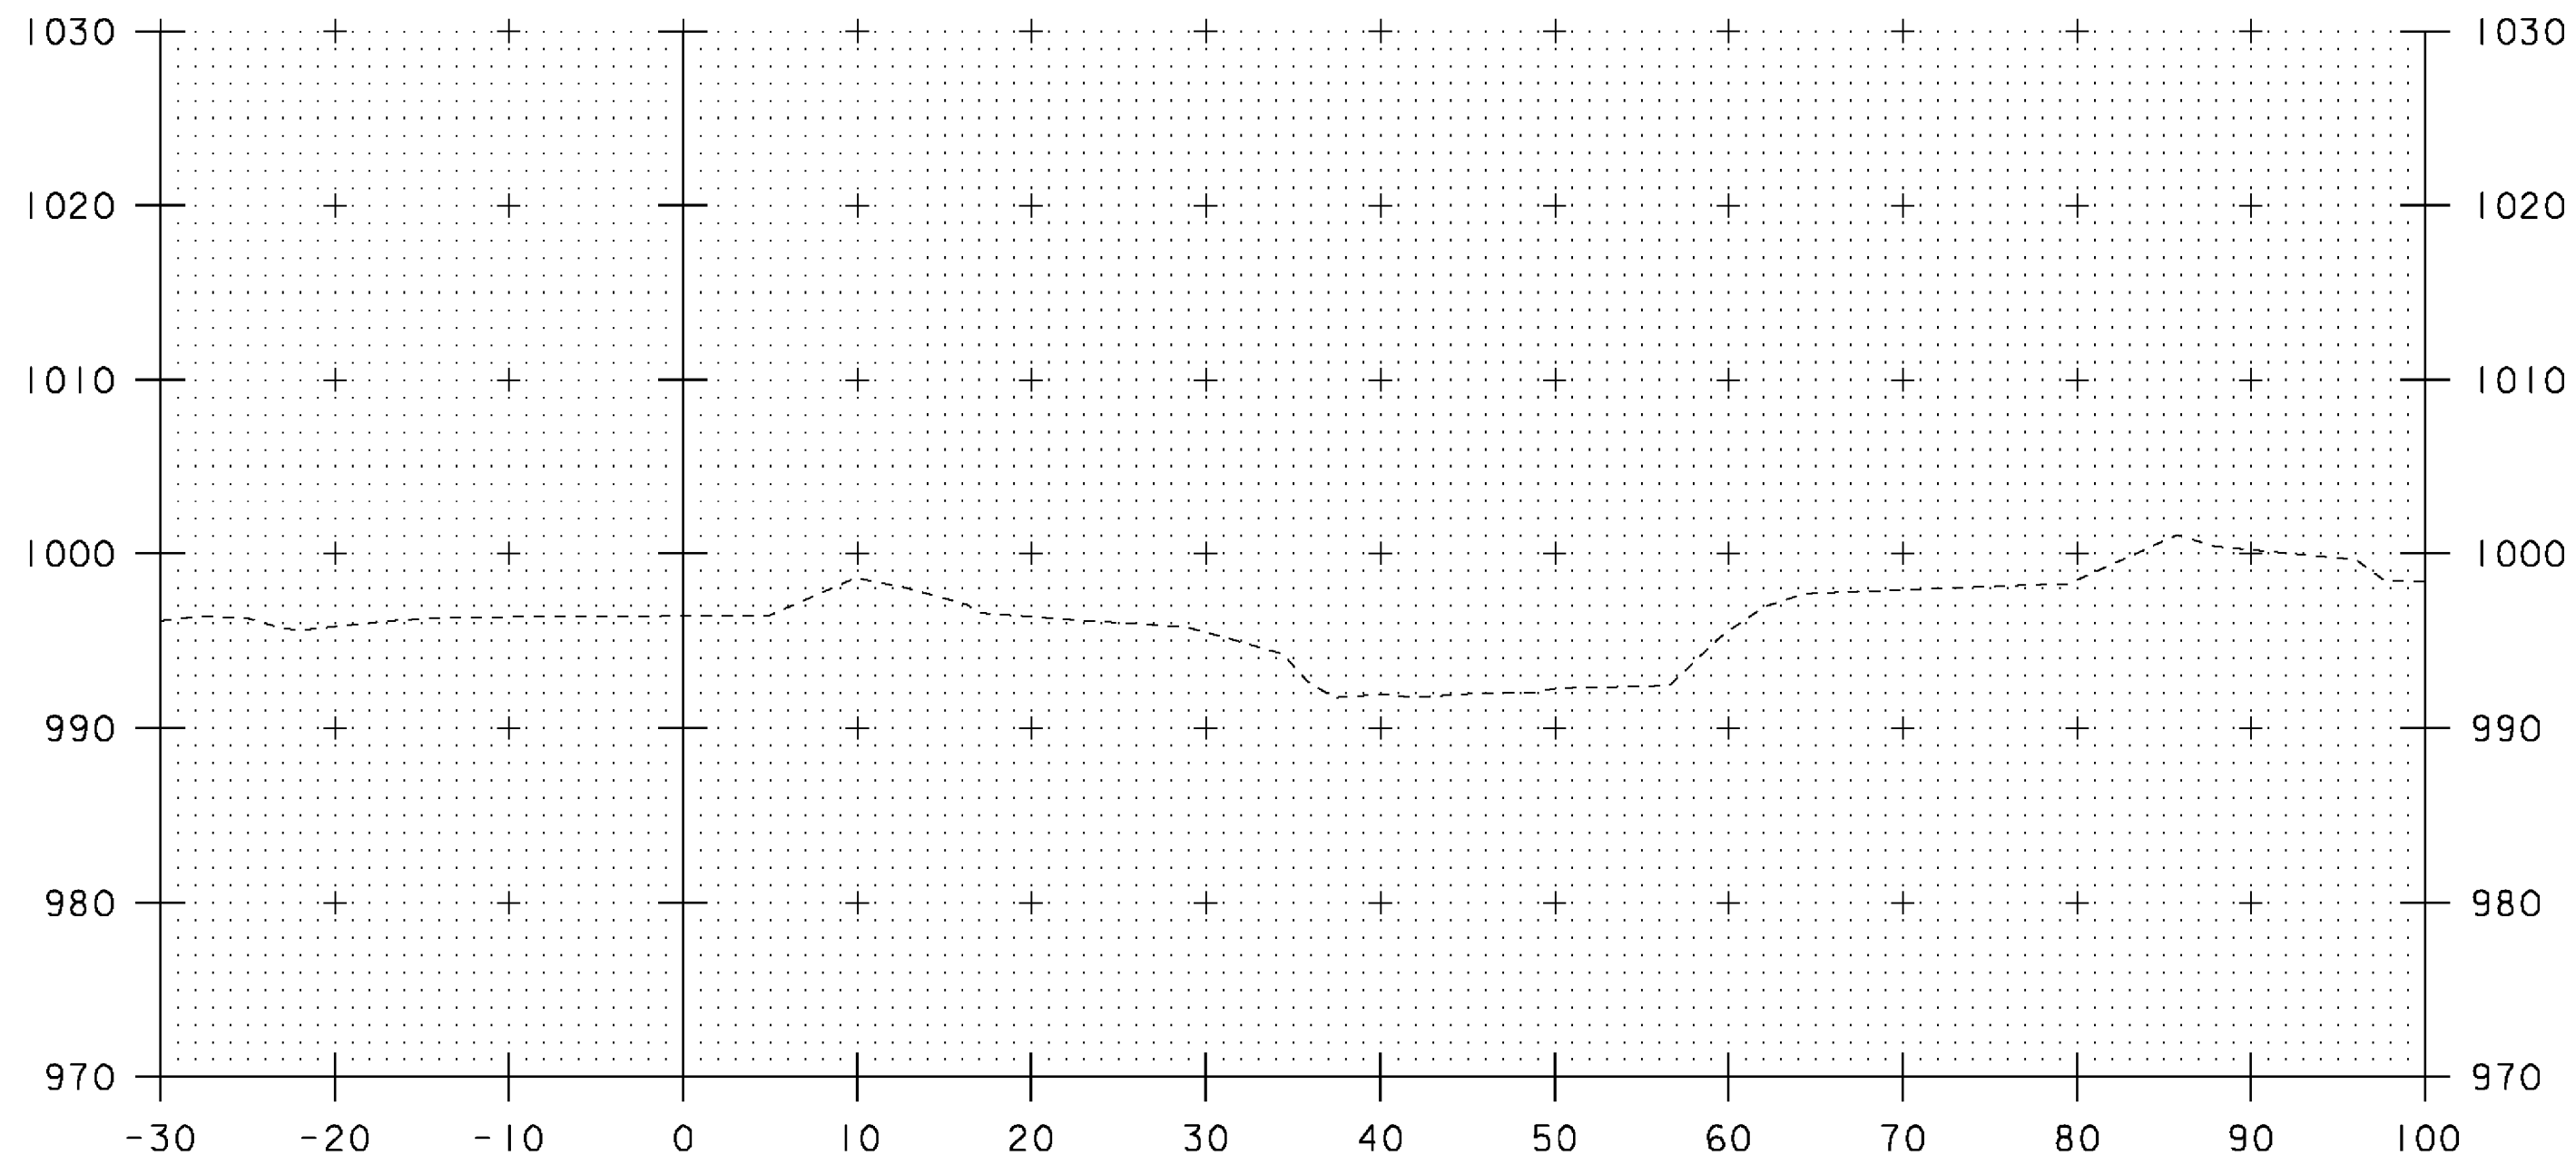


51+25

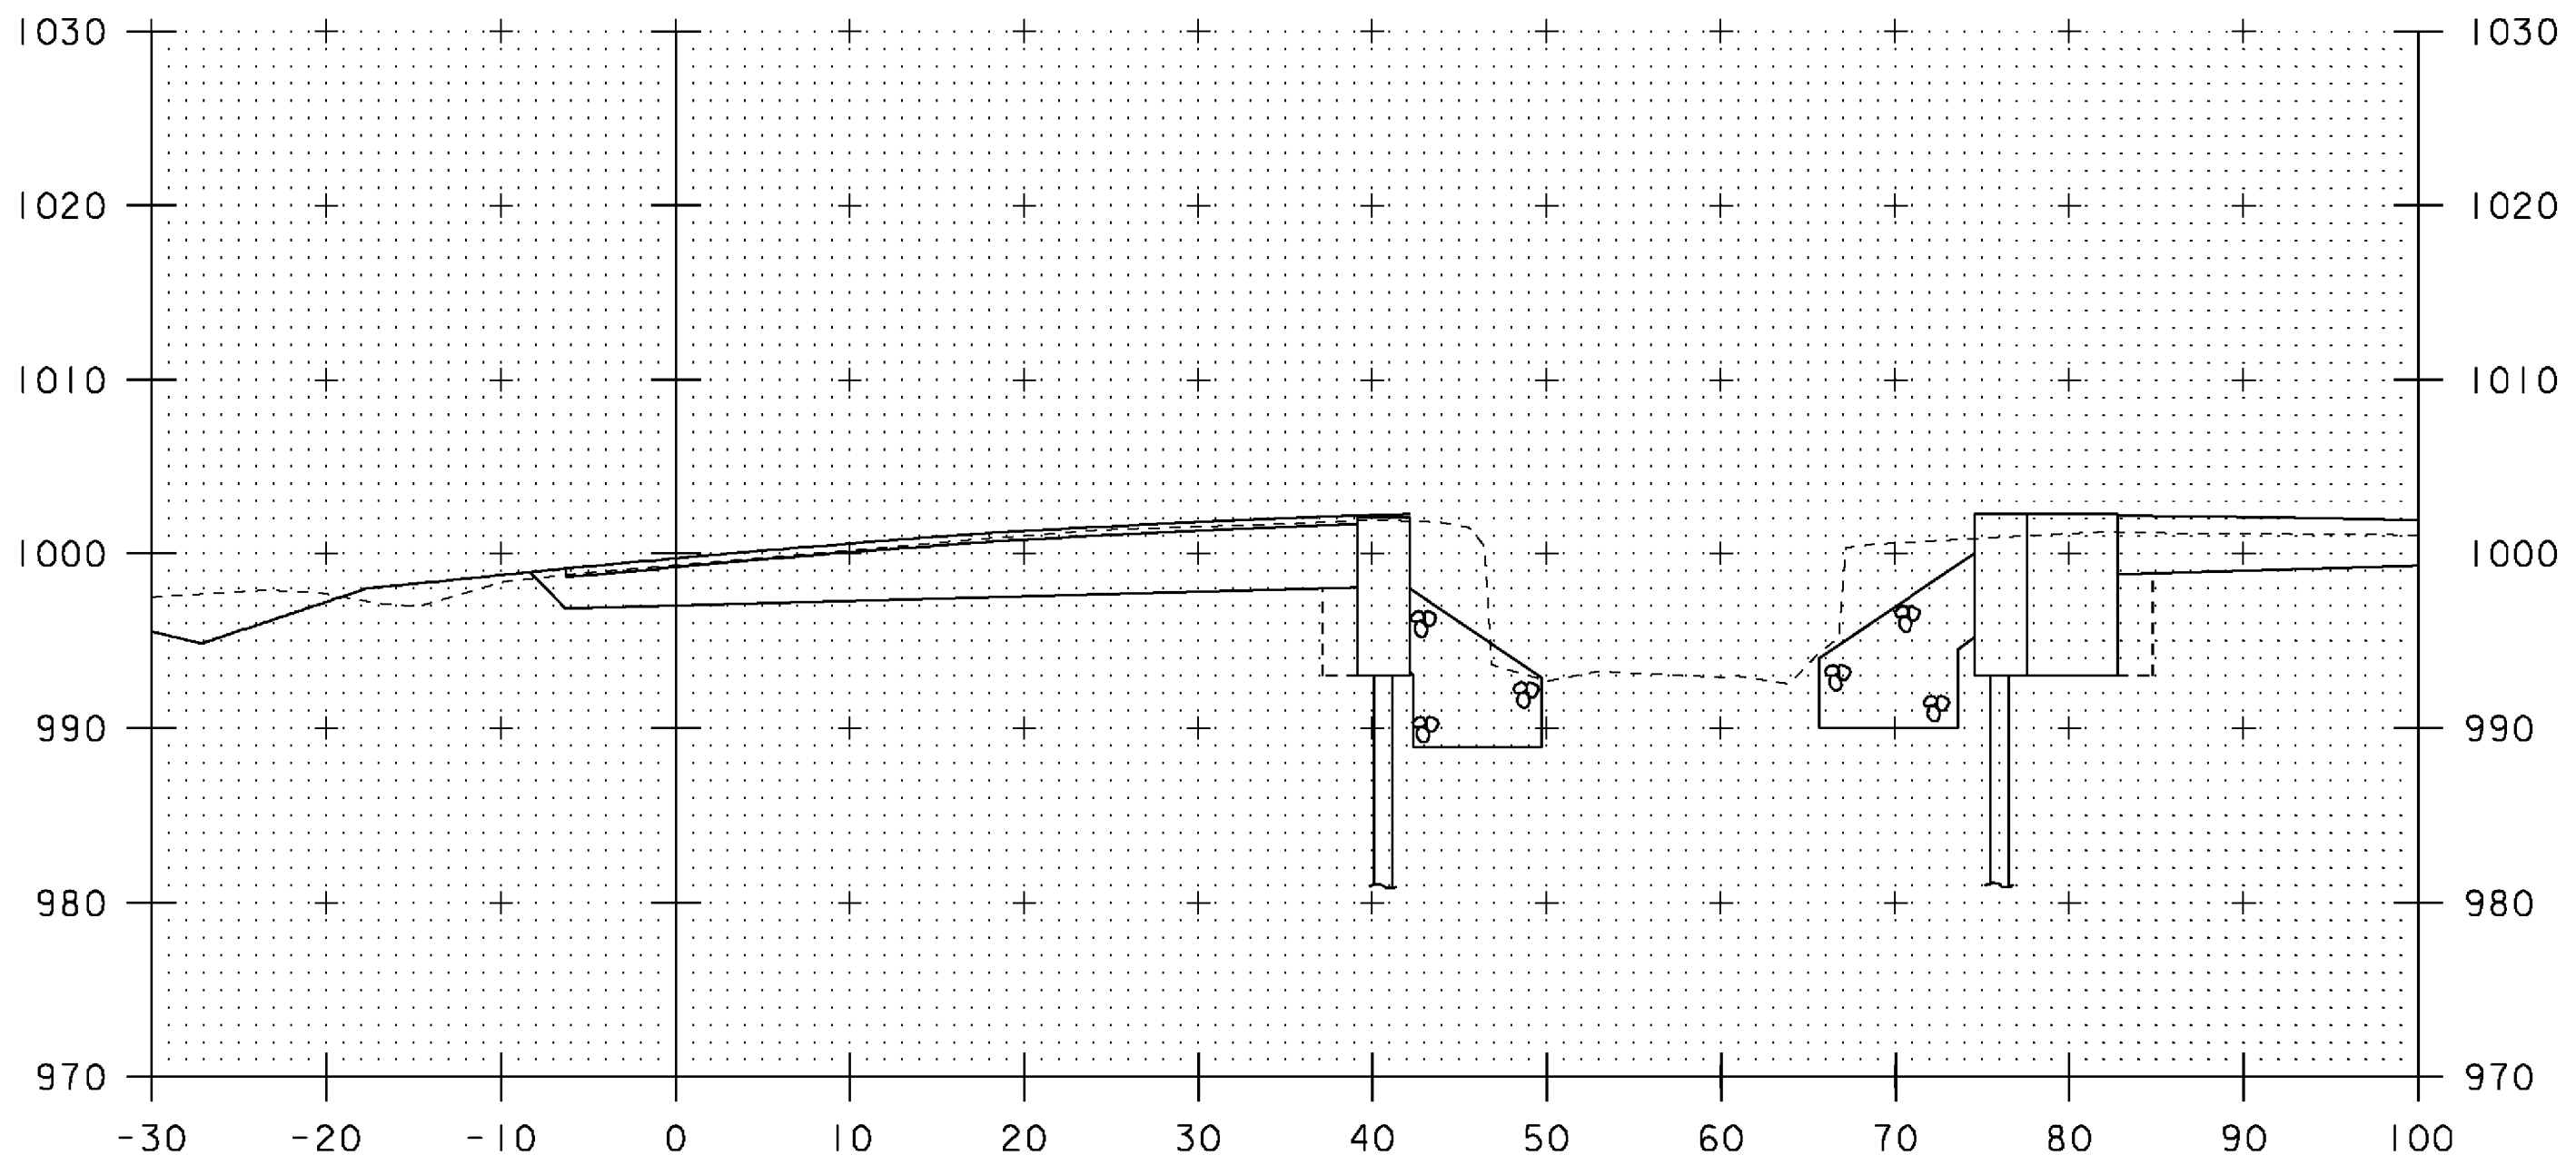

51+60

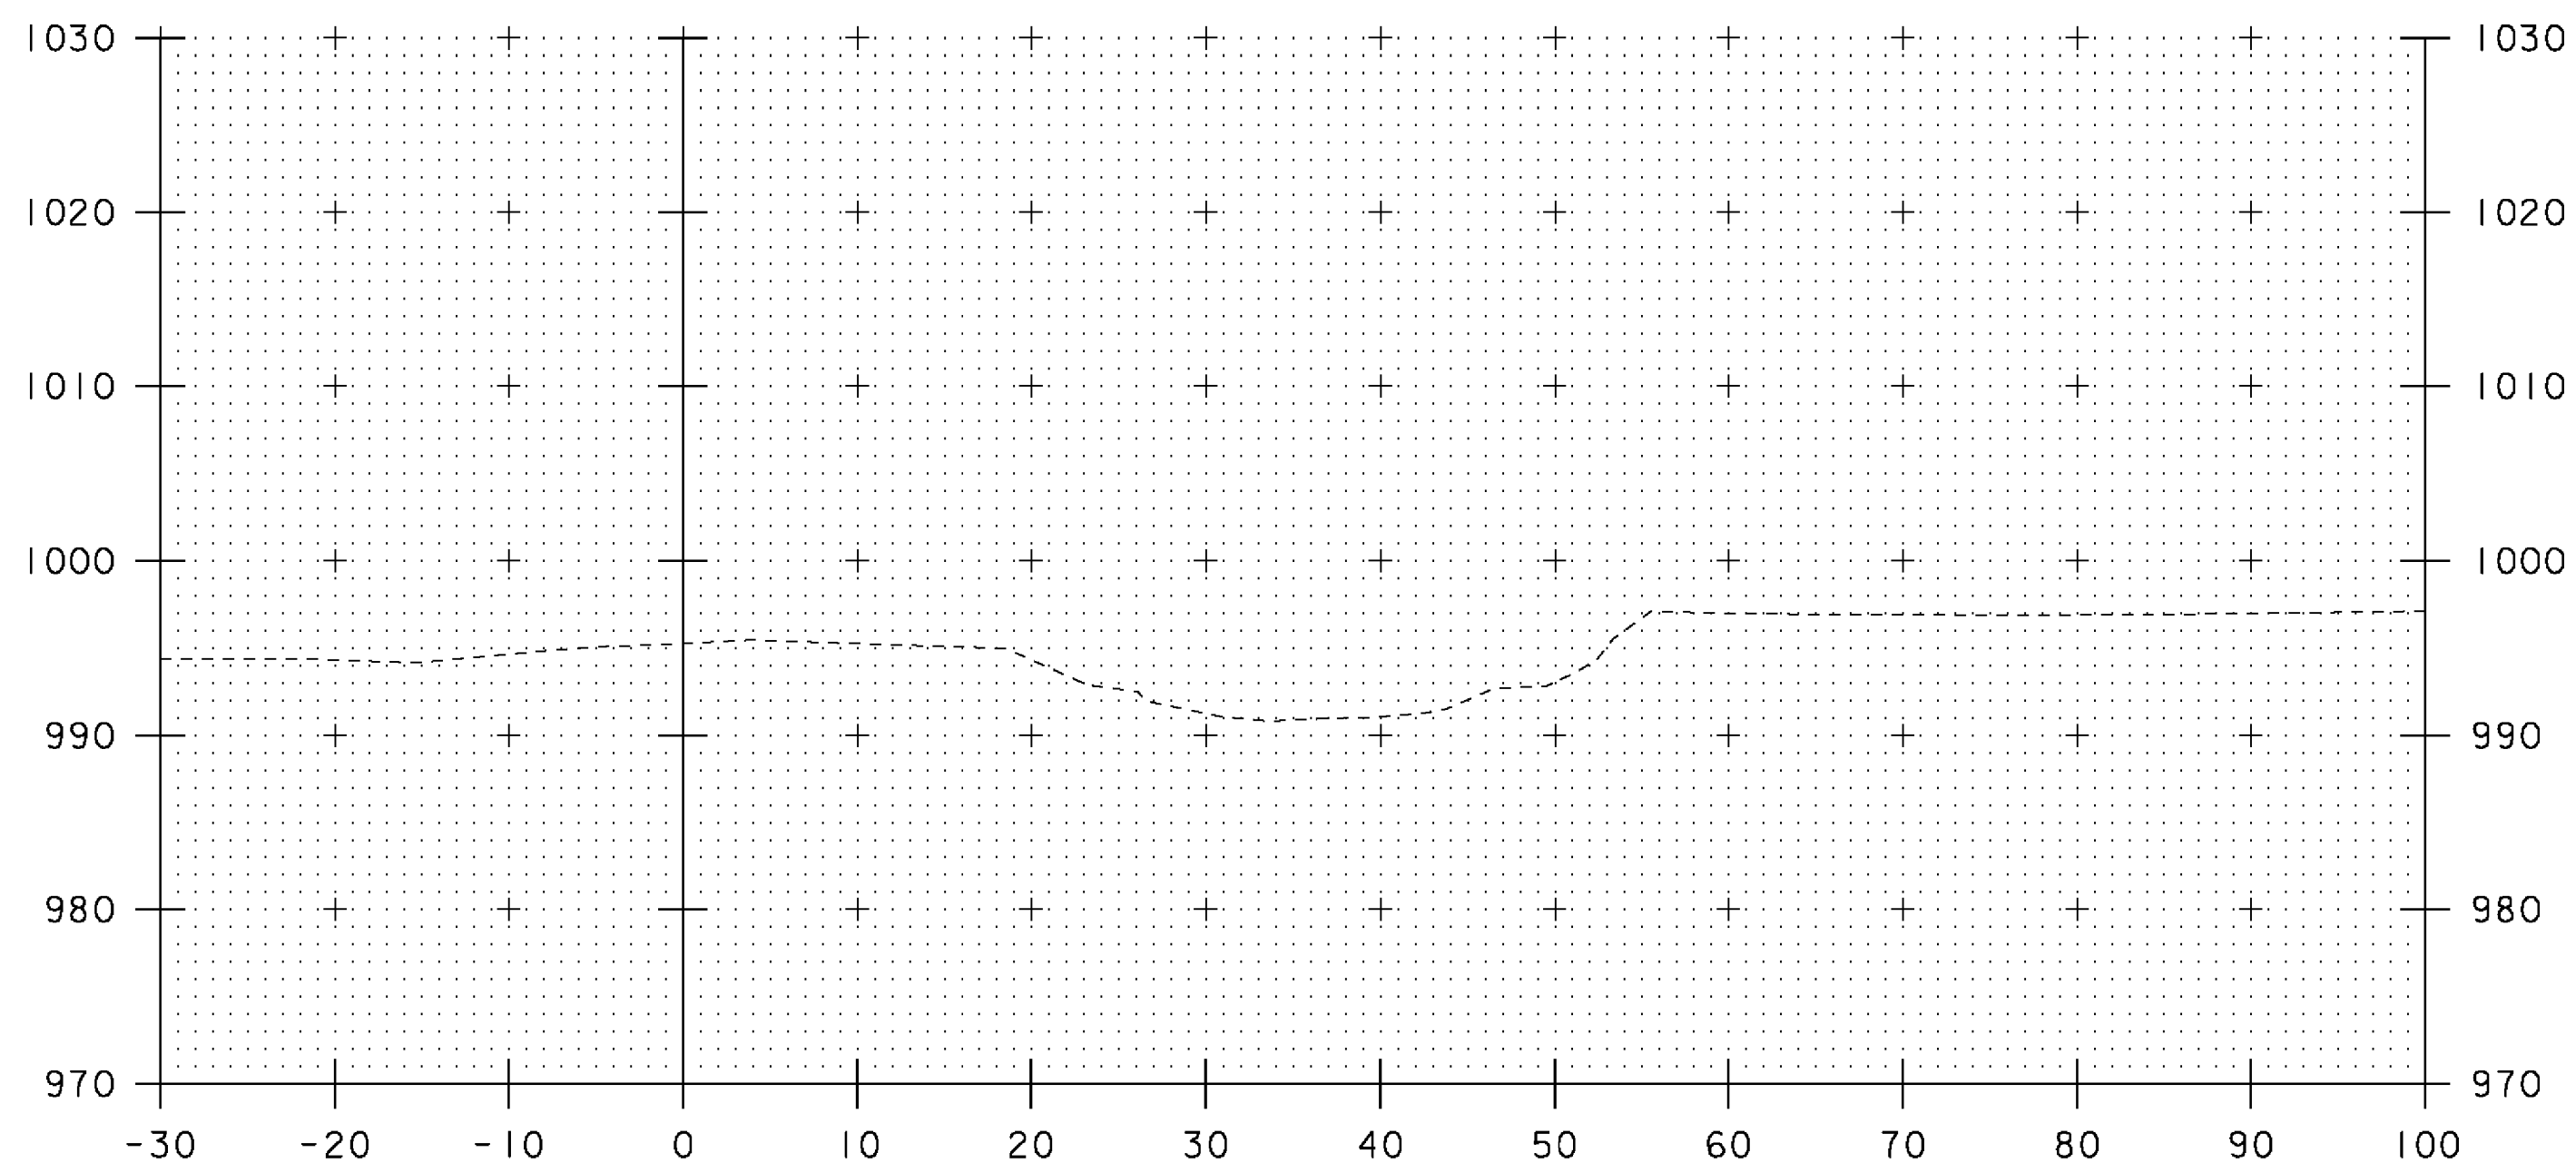

51+00

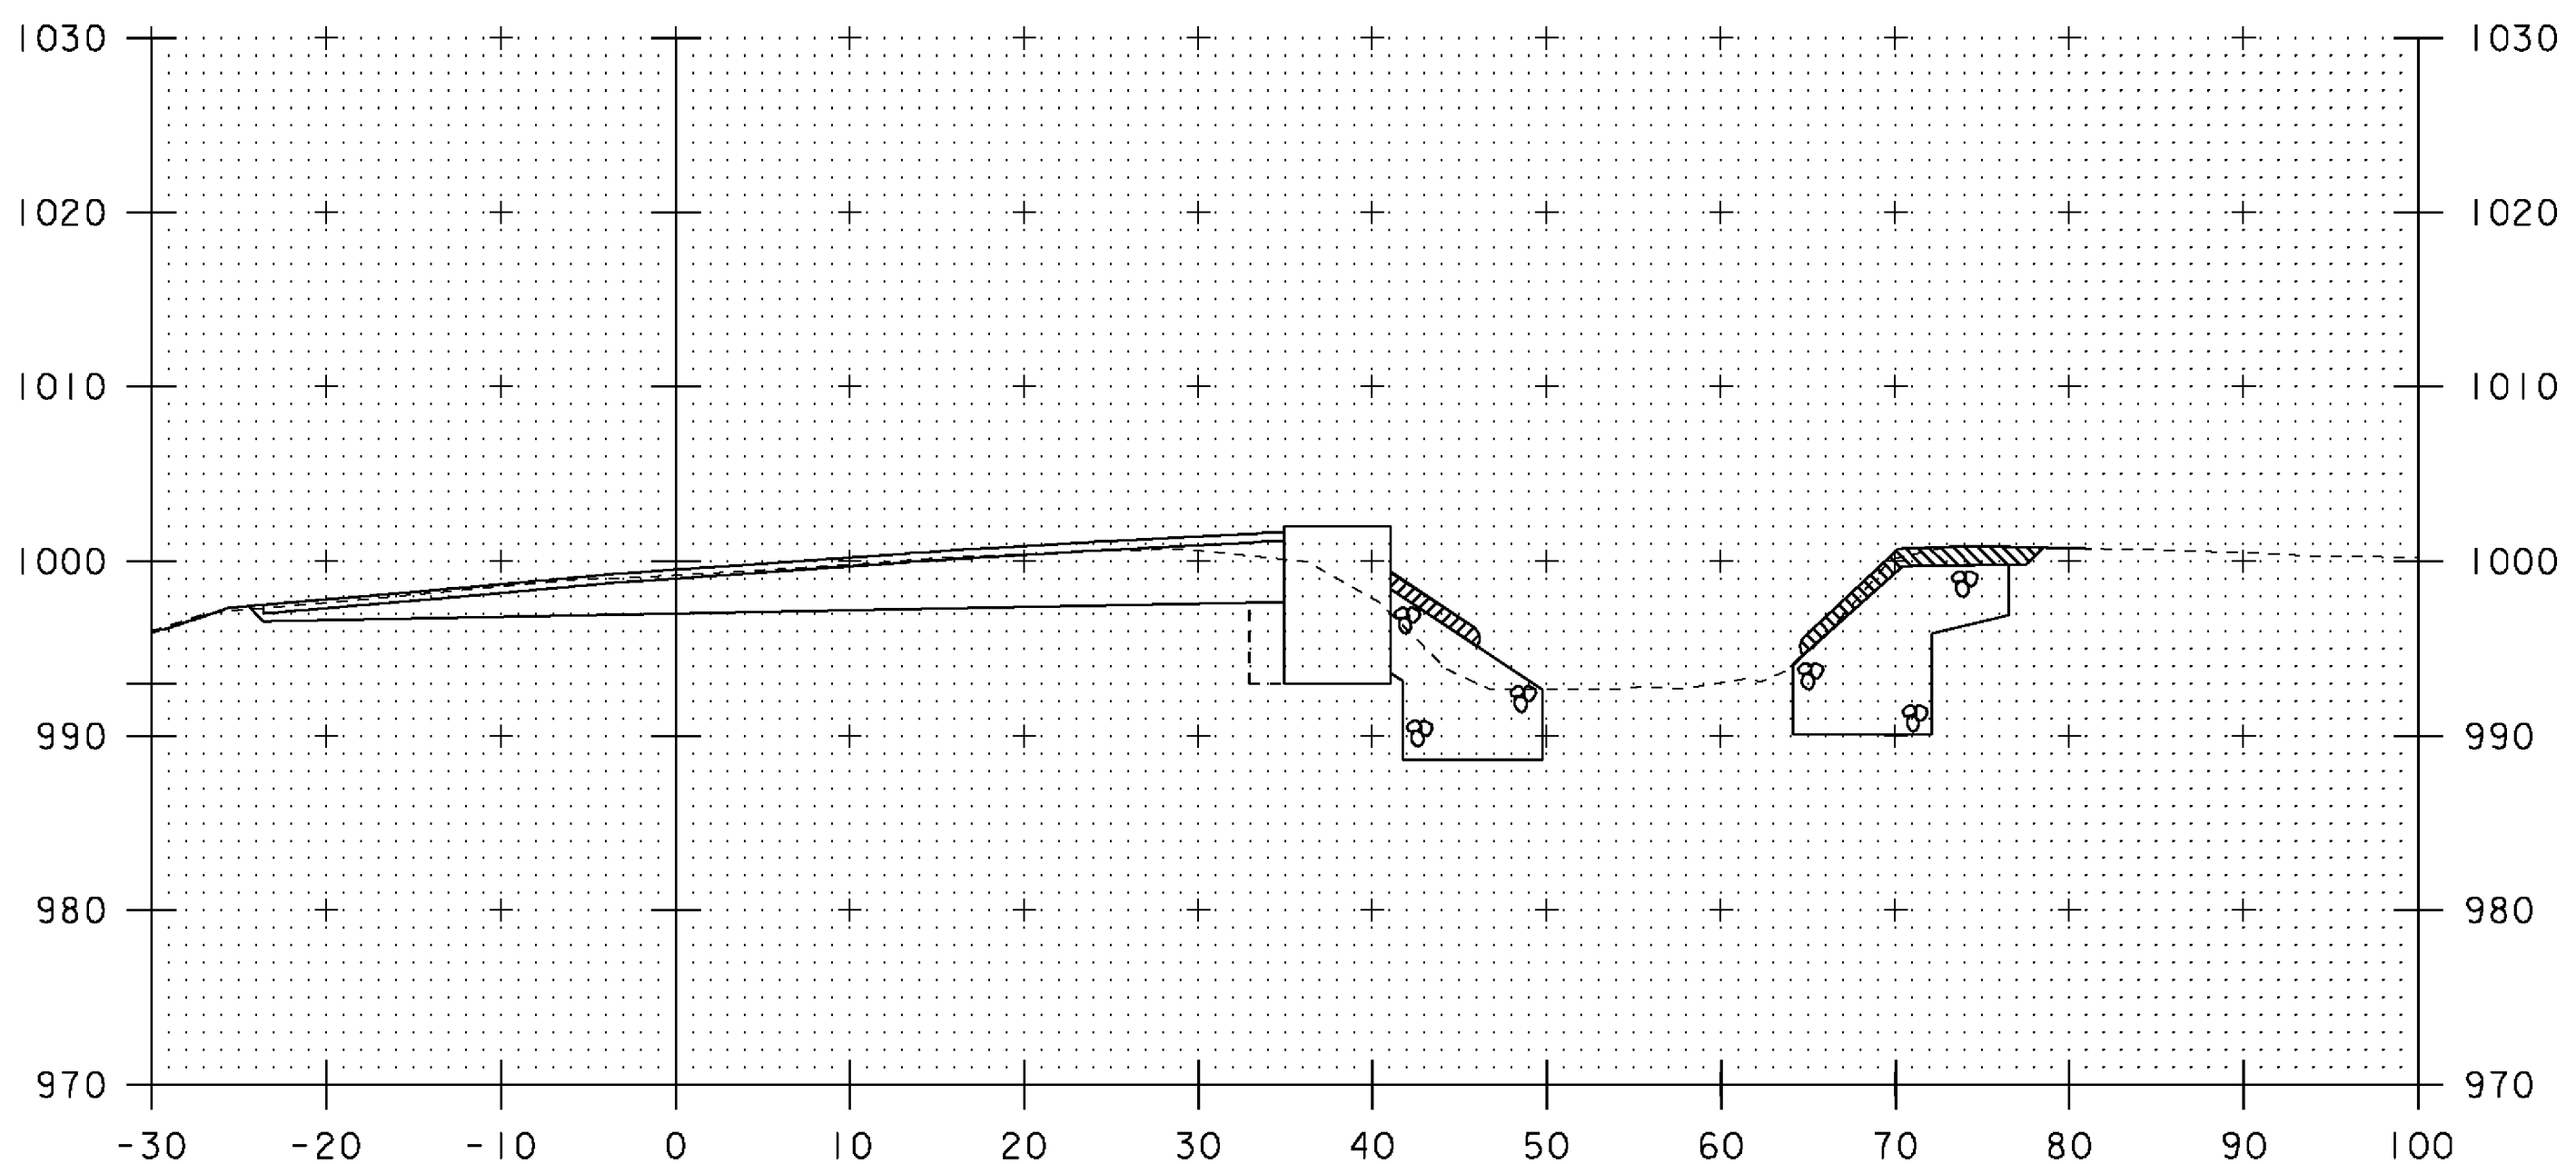

51+50

STA 51+41 RT. (ABUT #1)  
BEGIN UNCLASSIFIED CHANNEL EXCAVATION  
BEGIN STONE FILL, TYPE IV  
BEGIN GEOTEXTILE UNDER STONE FILL  
BEGIN GRUBBING MATERIAL  
END GRUBBING MATERIAL 51+56 RT.

STA 51+48 RT. (ABUT #2)  
BEGIN UNCLASSIFIED CHANNEL EXCAVATION  
BEGIN STONE FILL, TYPE IV  
BEGIN GEOTEXTILE UNDER STONE FILL  
BEGIN GRUBBING MATERIAL

SCALE 1" = 10'-0"  
10 0 10

STA. 51+00 TO STA. 51+60

PROJECT NAME: MENDON  
PROJECT NUMBER: BRO 1443 (43)

FILE NAME: s01j272xs.dgn  
PROJECT LEADER: K. HIGGINS  
DESIGNED BY: G. LAROCHE  
CHANNEL SECTIONS #1

PLOT DATE: 07-SEP-2010  
DRAWN BY: G. LAROCHE  
CHECKED BY: J. SALVATORI  
SHEET 31 OF 32