 
 

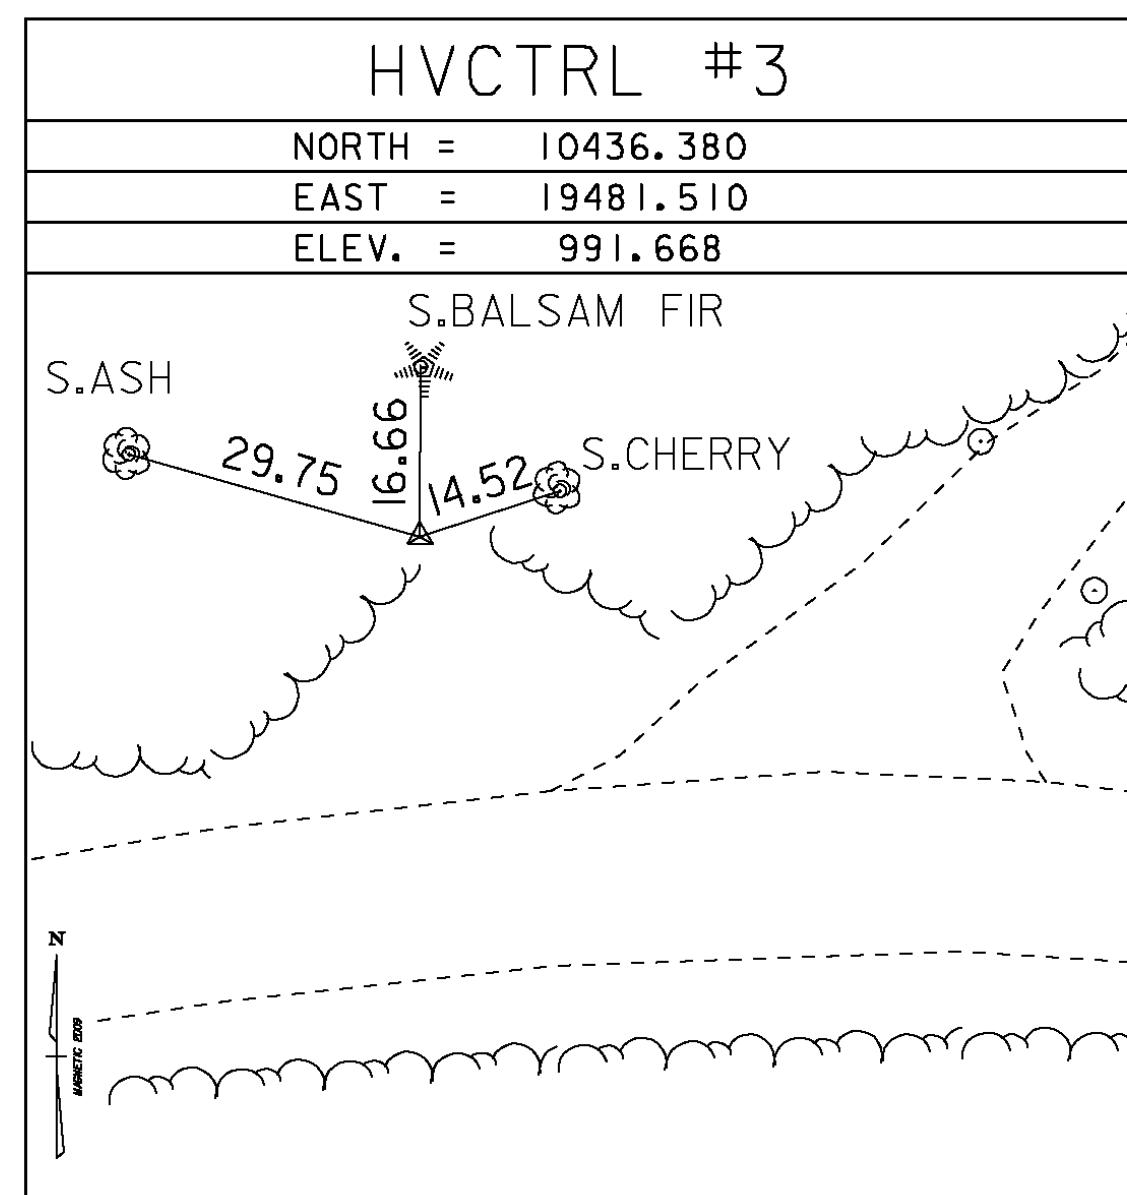
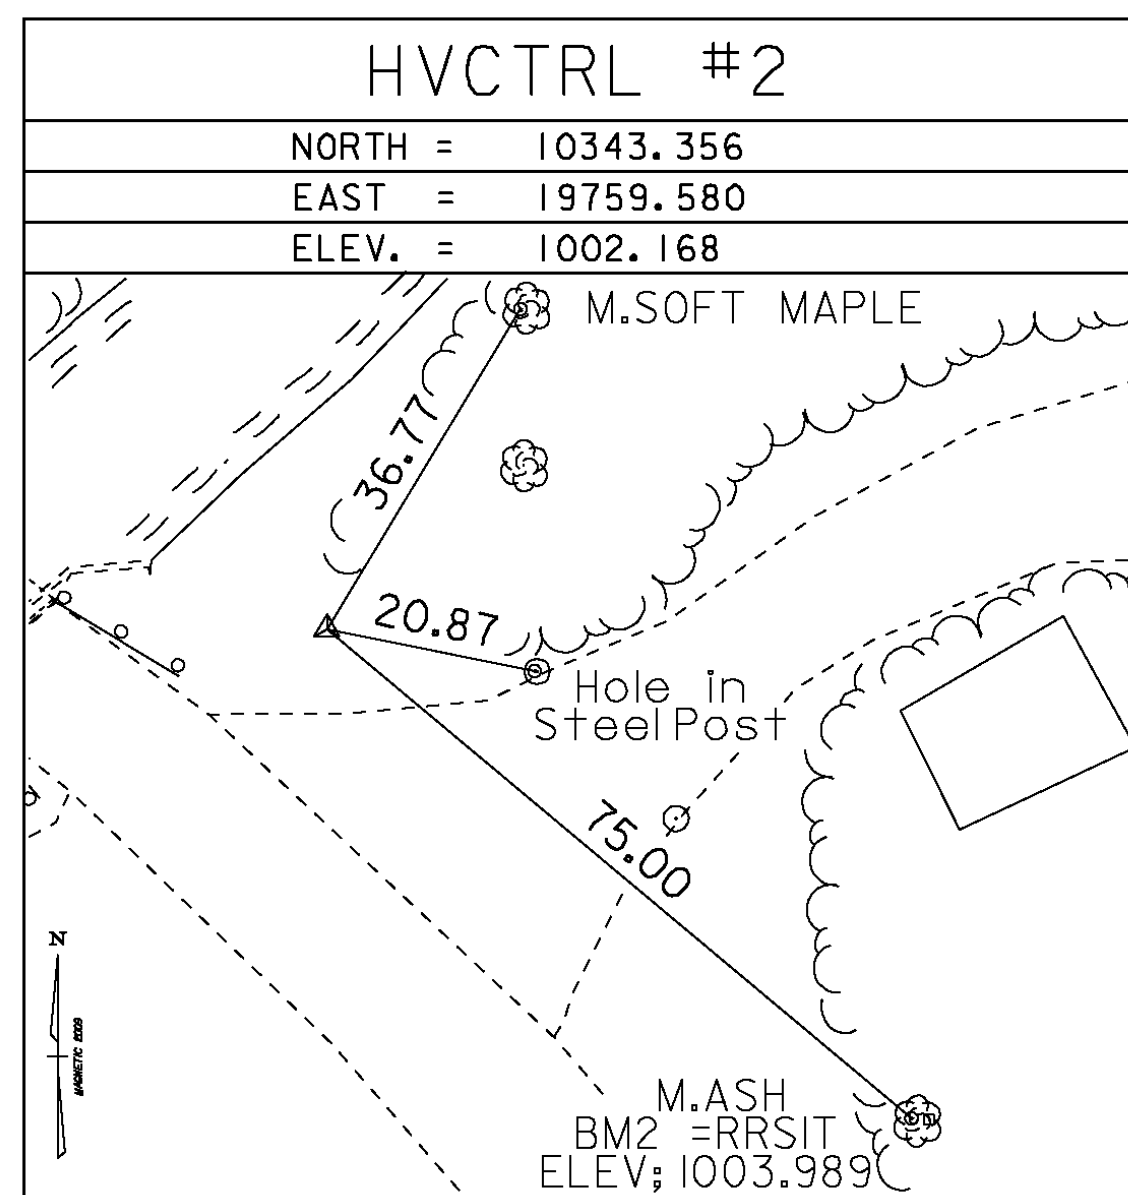


GPS CONTROL POINTS






ASSUMED HORIZONTAL and VERTICAL DATUMS

TRAVERSE TIES

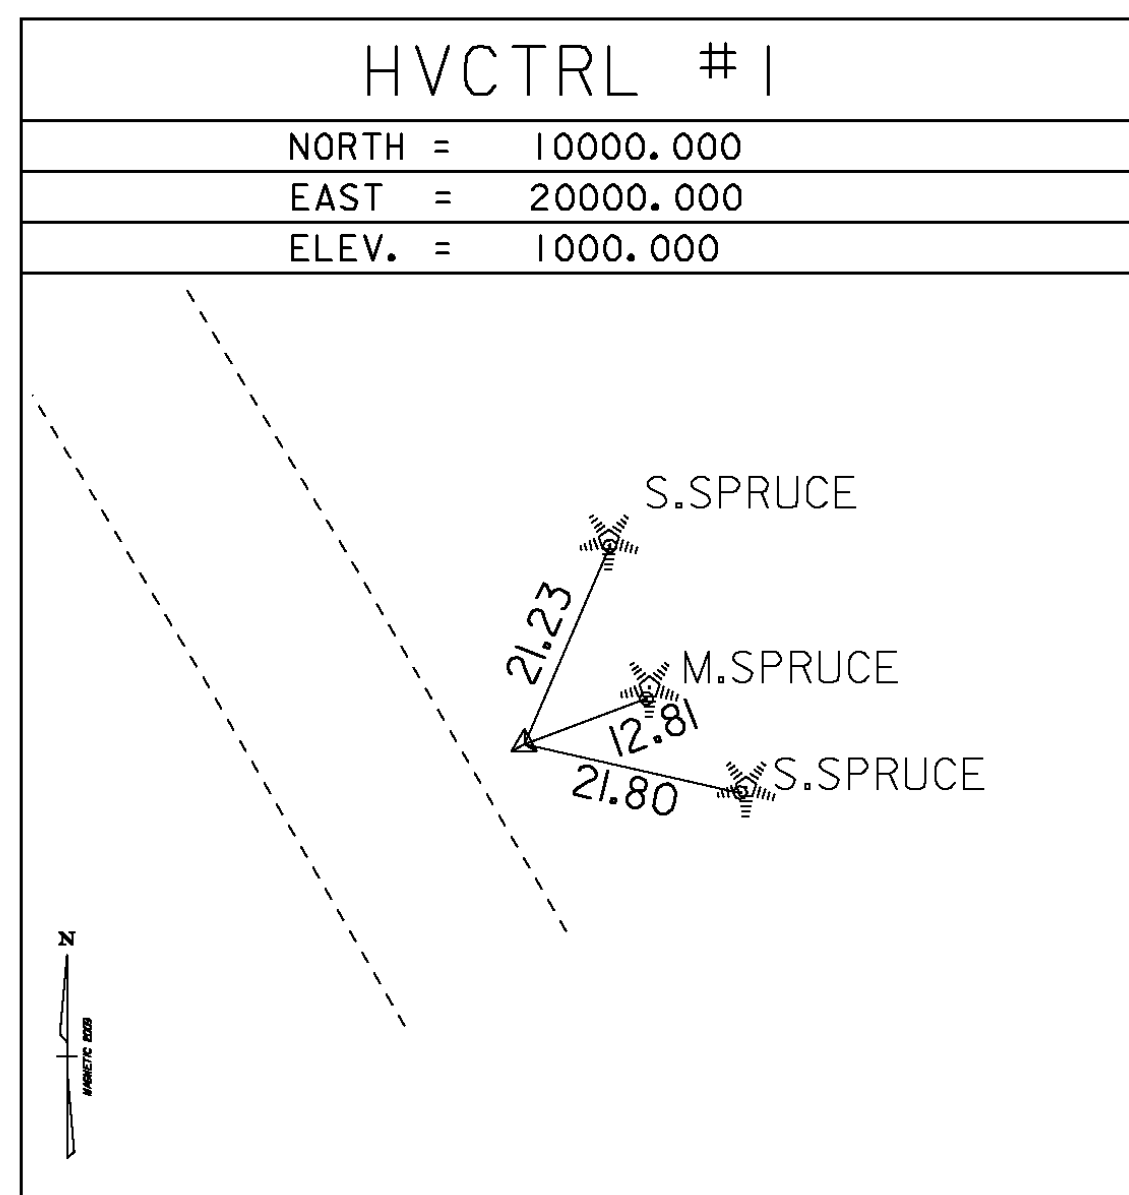

* Main Traverse Complete 2/4/2009 by L.Orvis P.C. & R.Bockus

ALIGNMENT COORD

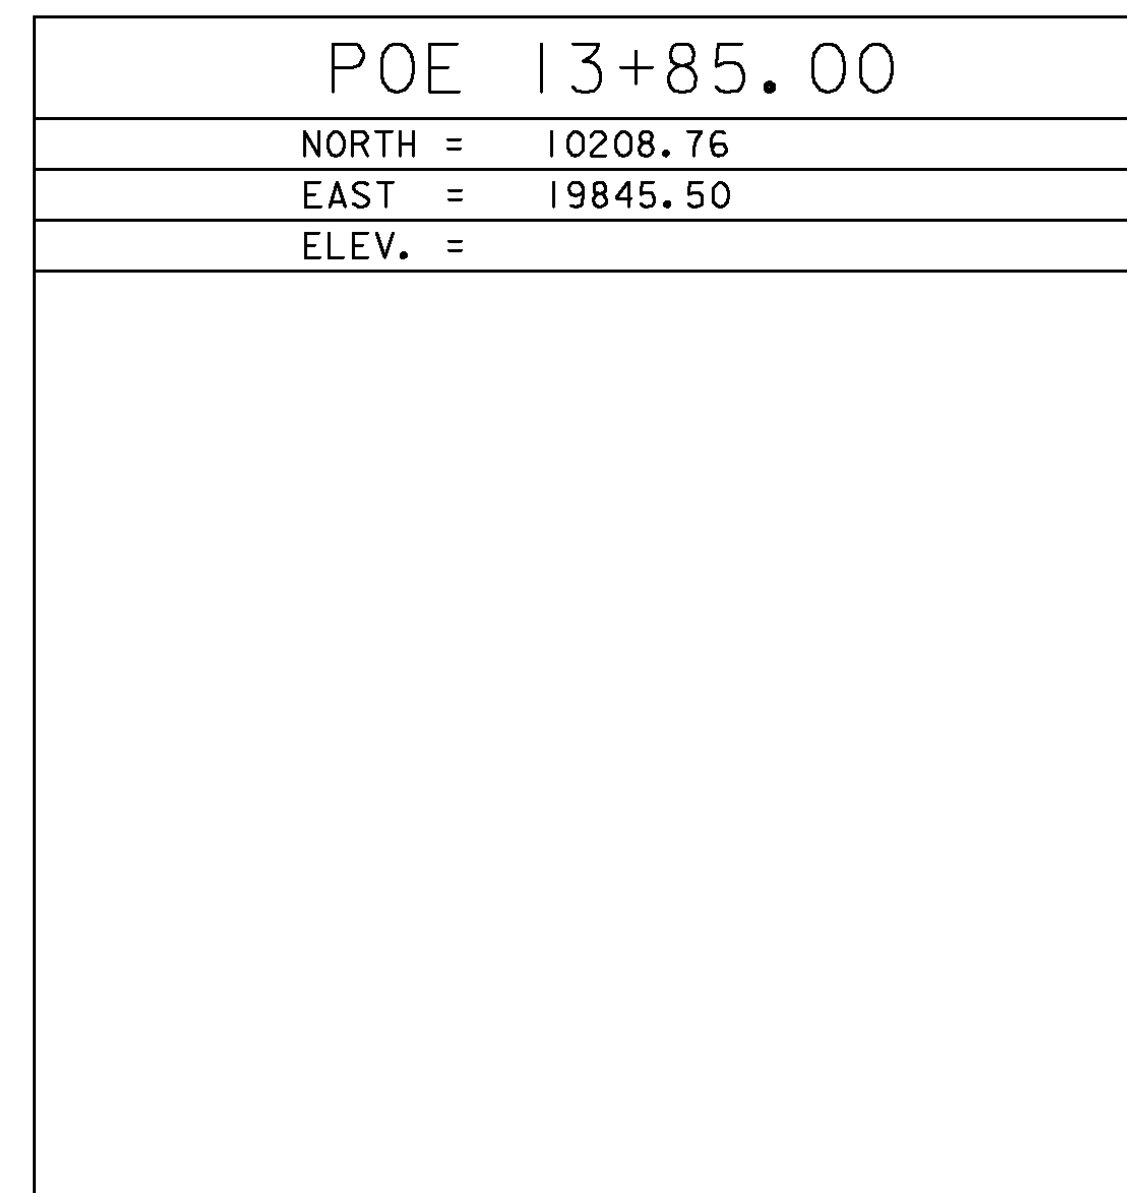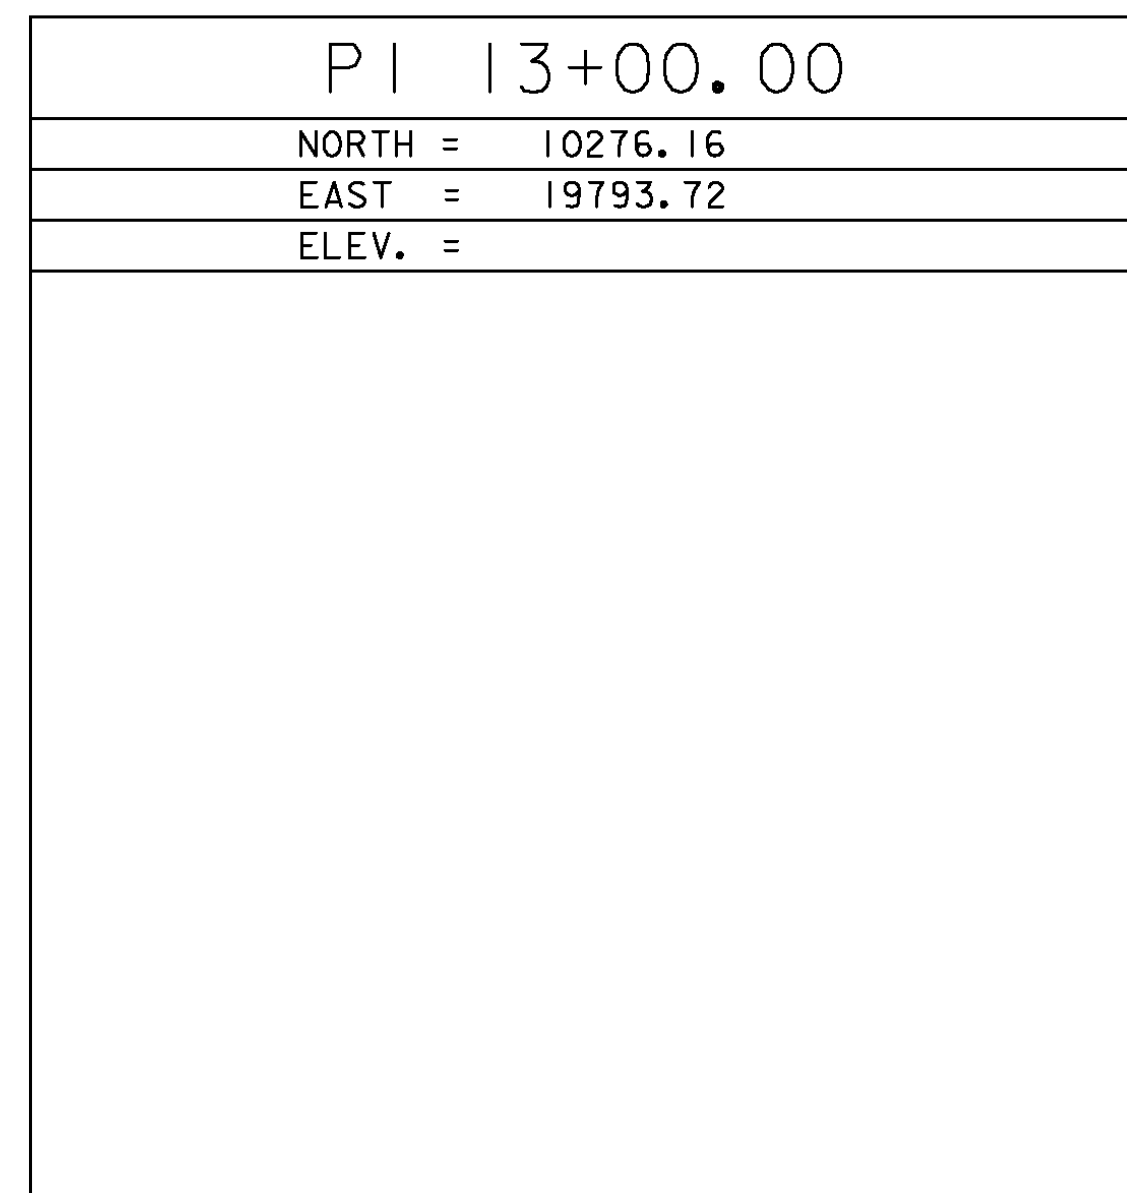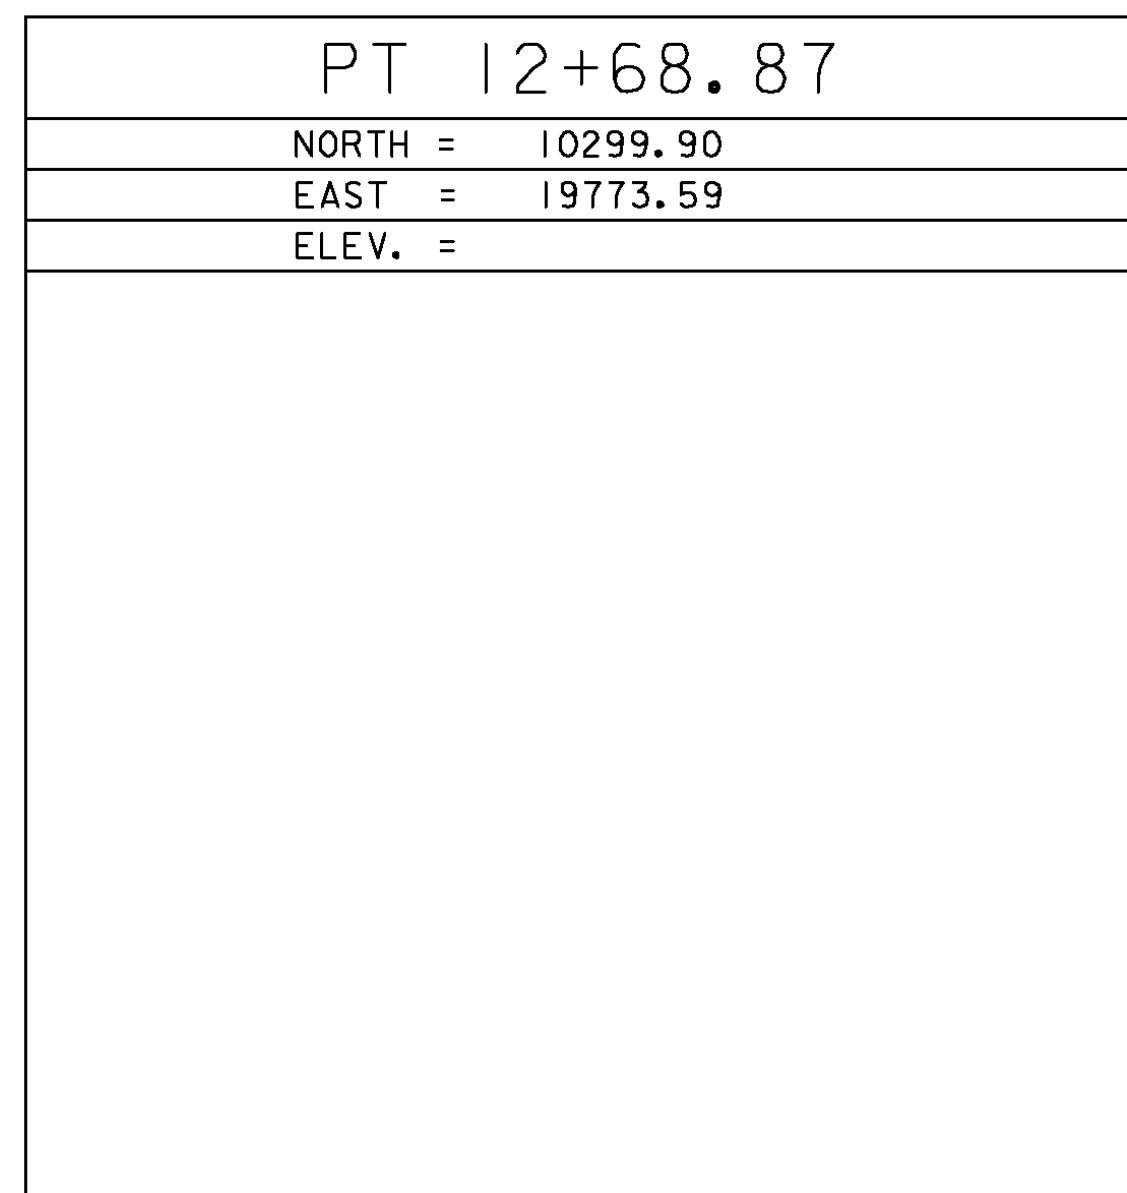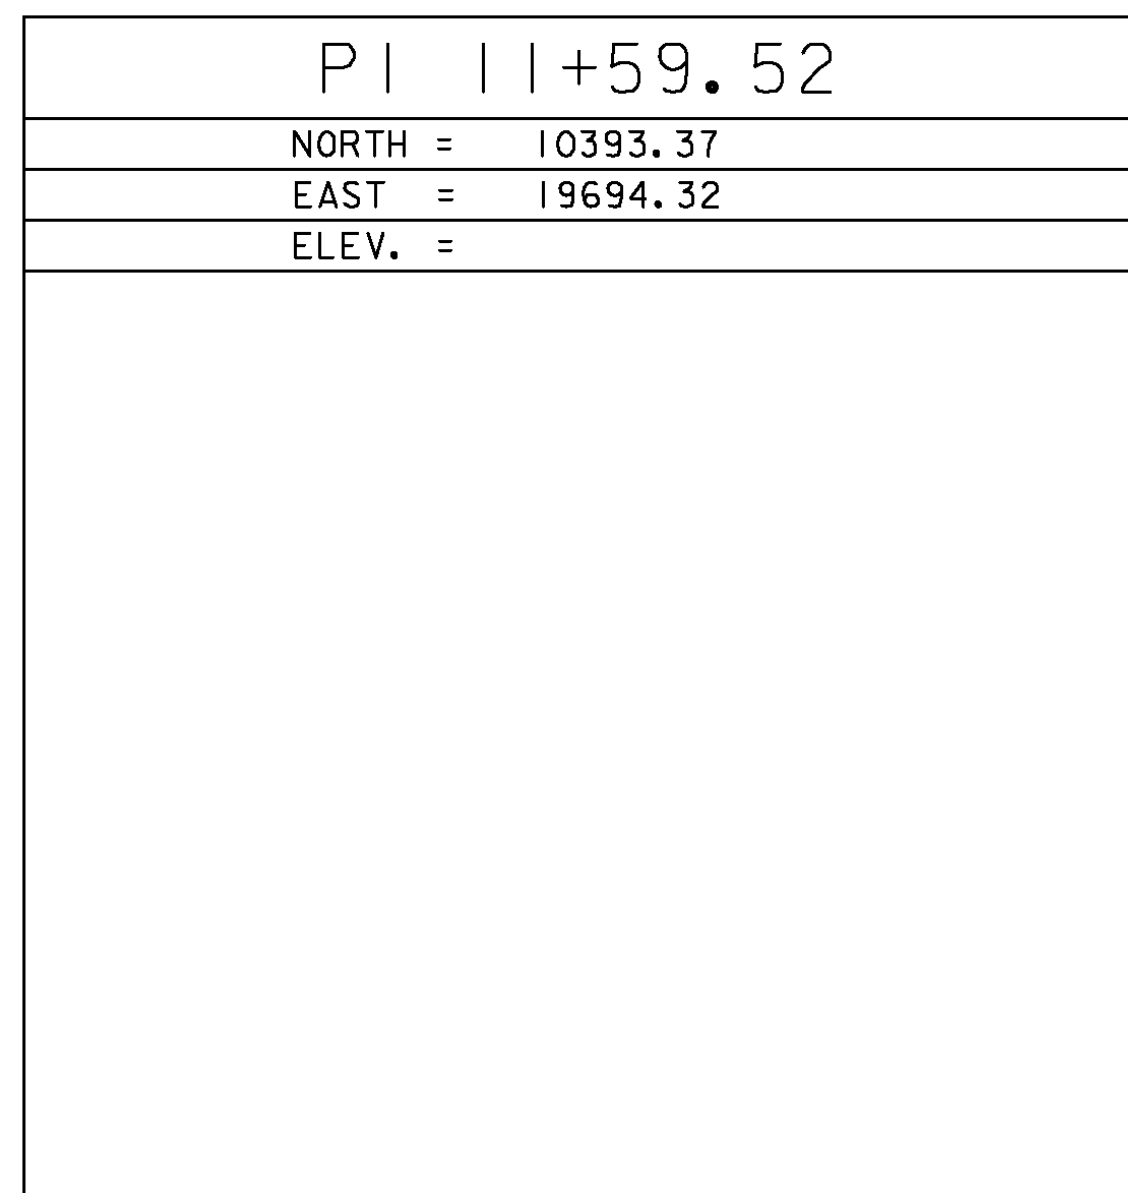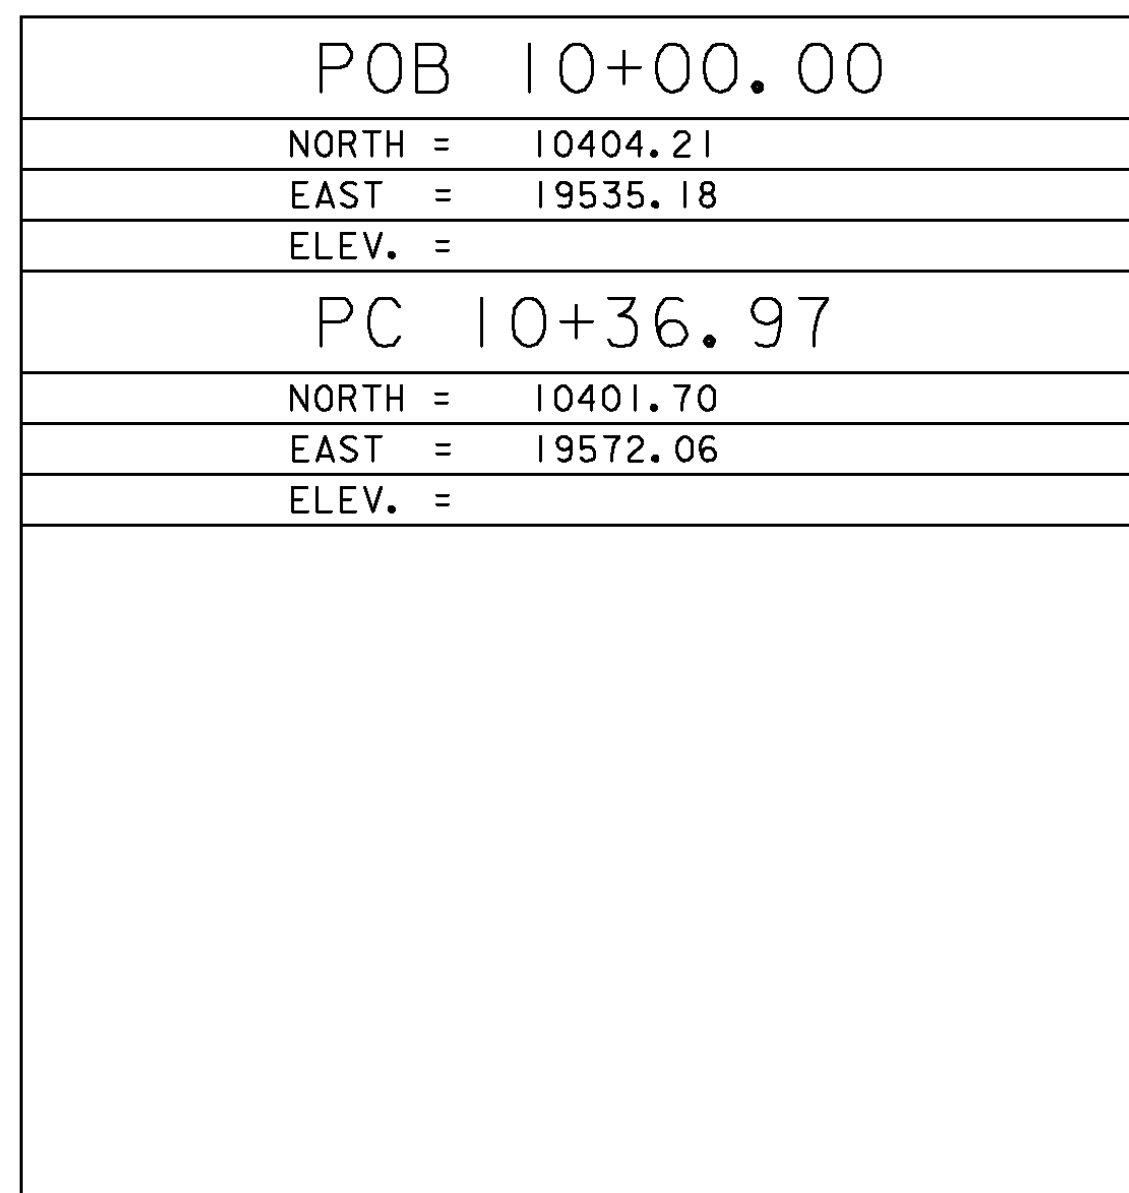

DATUM	
VERTICAL	Assumed
HORIZONTAL	Assumed
ADJUSTMENT	Compass

PROJECT NAME: Mendon	
PROJECT NUMBER: BRO 1443 (43)	
FILE NAME: 01J272\survey\01J272+1.dgn	PLOT DATE: 07-SEP-2010
PROJECT LEADER: K. HIGGINS	DRAWN BY: R. Bullock
DESIGNED BY: J. SALAVATORI	CHECKED BY: J. SALAVATORI
TIE SHEET	SHEET 7 OF 32