


**GUARDRAIL LAYOUT**

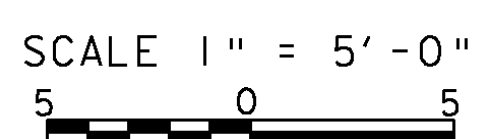

- NOTES:
1. FOLLOW STANDARD DRAWING SB-R7-90 TRANSITION POST SPACING FOR WW1, WW3, AND WW4. WW2 WILL HAVE A TRANSITION POST SPACING OF 1'-3"
  2. SEE STANDARD DRAWING SB-R6-82 FOR GUARDRAIL PAYMENT SCHEDULE ONLY.

PROJECT NAME: MENDON	PLOT DATE: 16-SEP-2010
PROJECT NUMBER: BRO 1443(43)	DRAWN BY: K. PATTERSON
FILE NAME: s01j27r01a.dgn	CHECKED BY: J. SALVATORI
PROJECT LEADER: K. HIGGINS	SHEET 10 OF 32
DESIGNED BY: G. LAROCHE	
GUARDRAIL LAYOUT	