




11+25

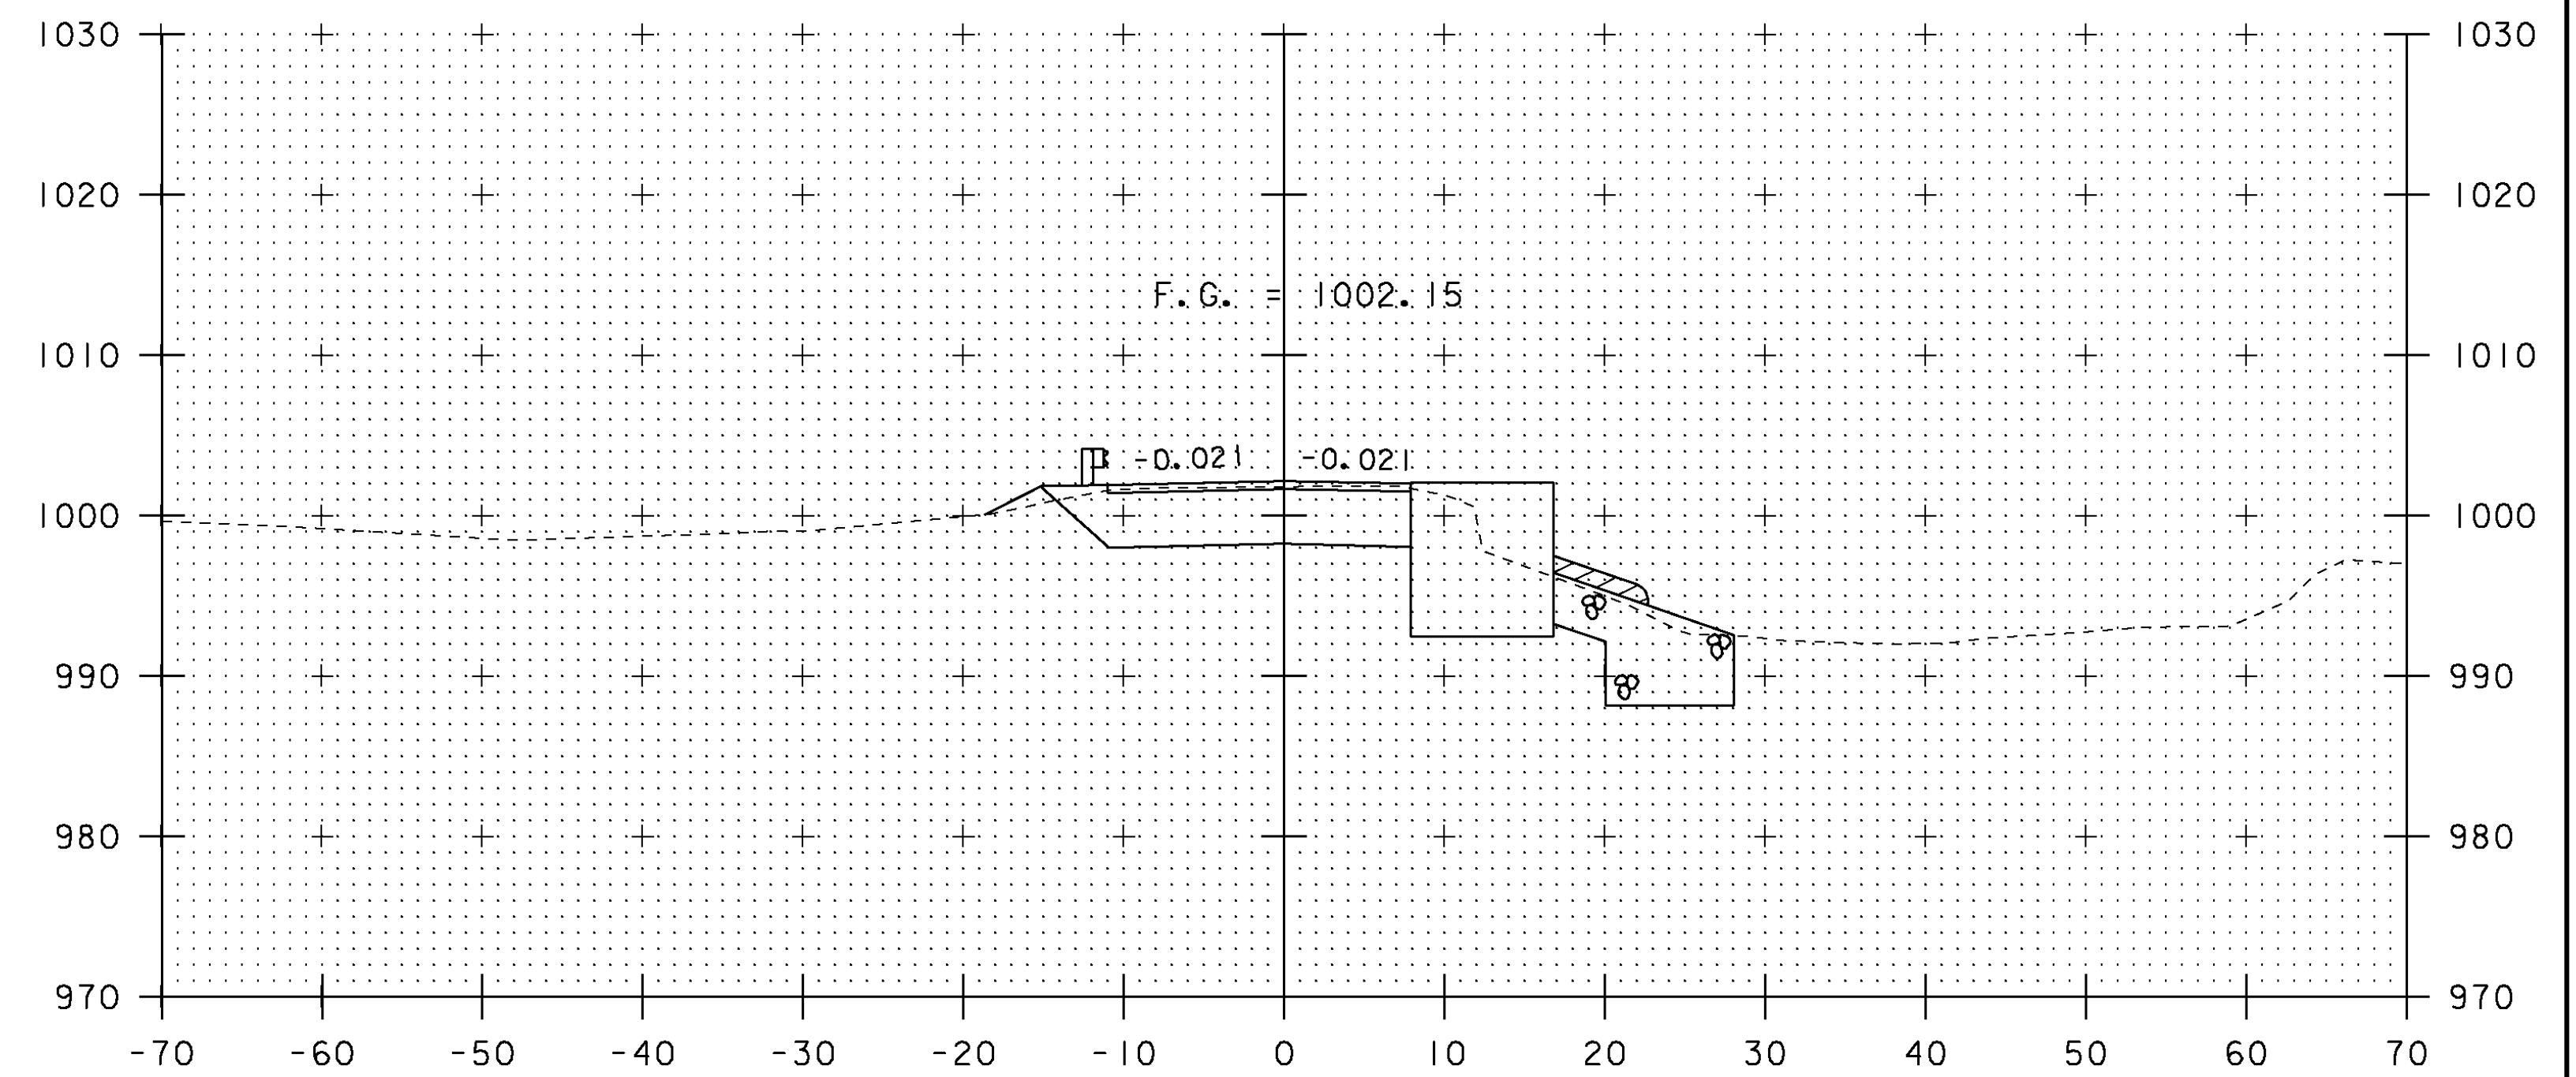


11+75

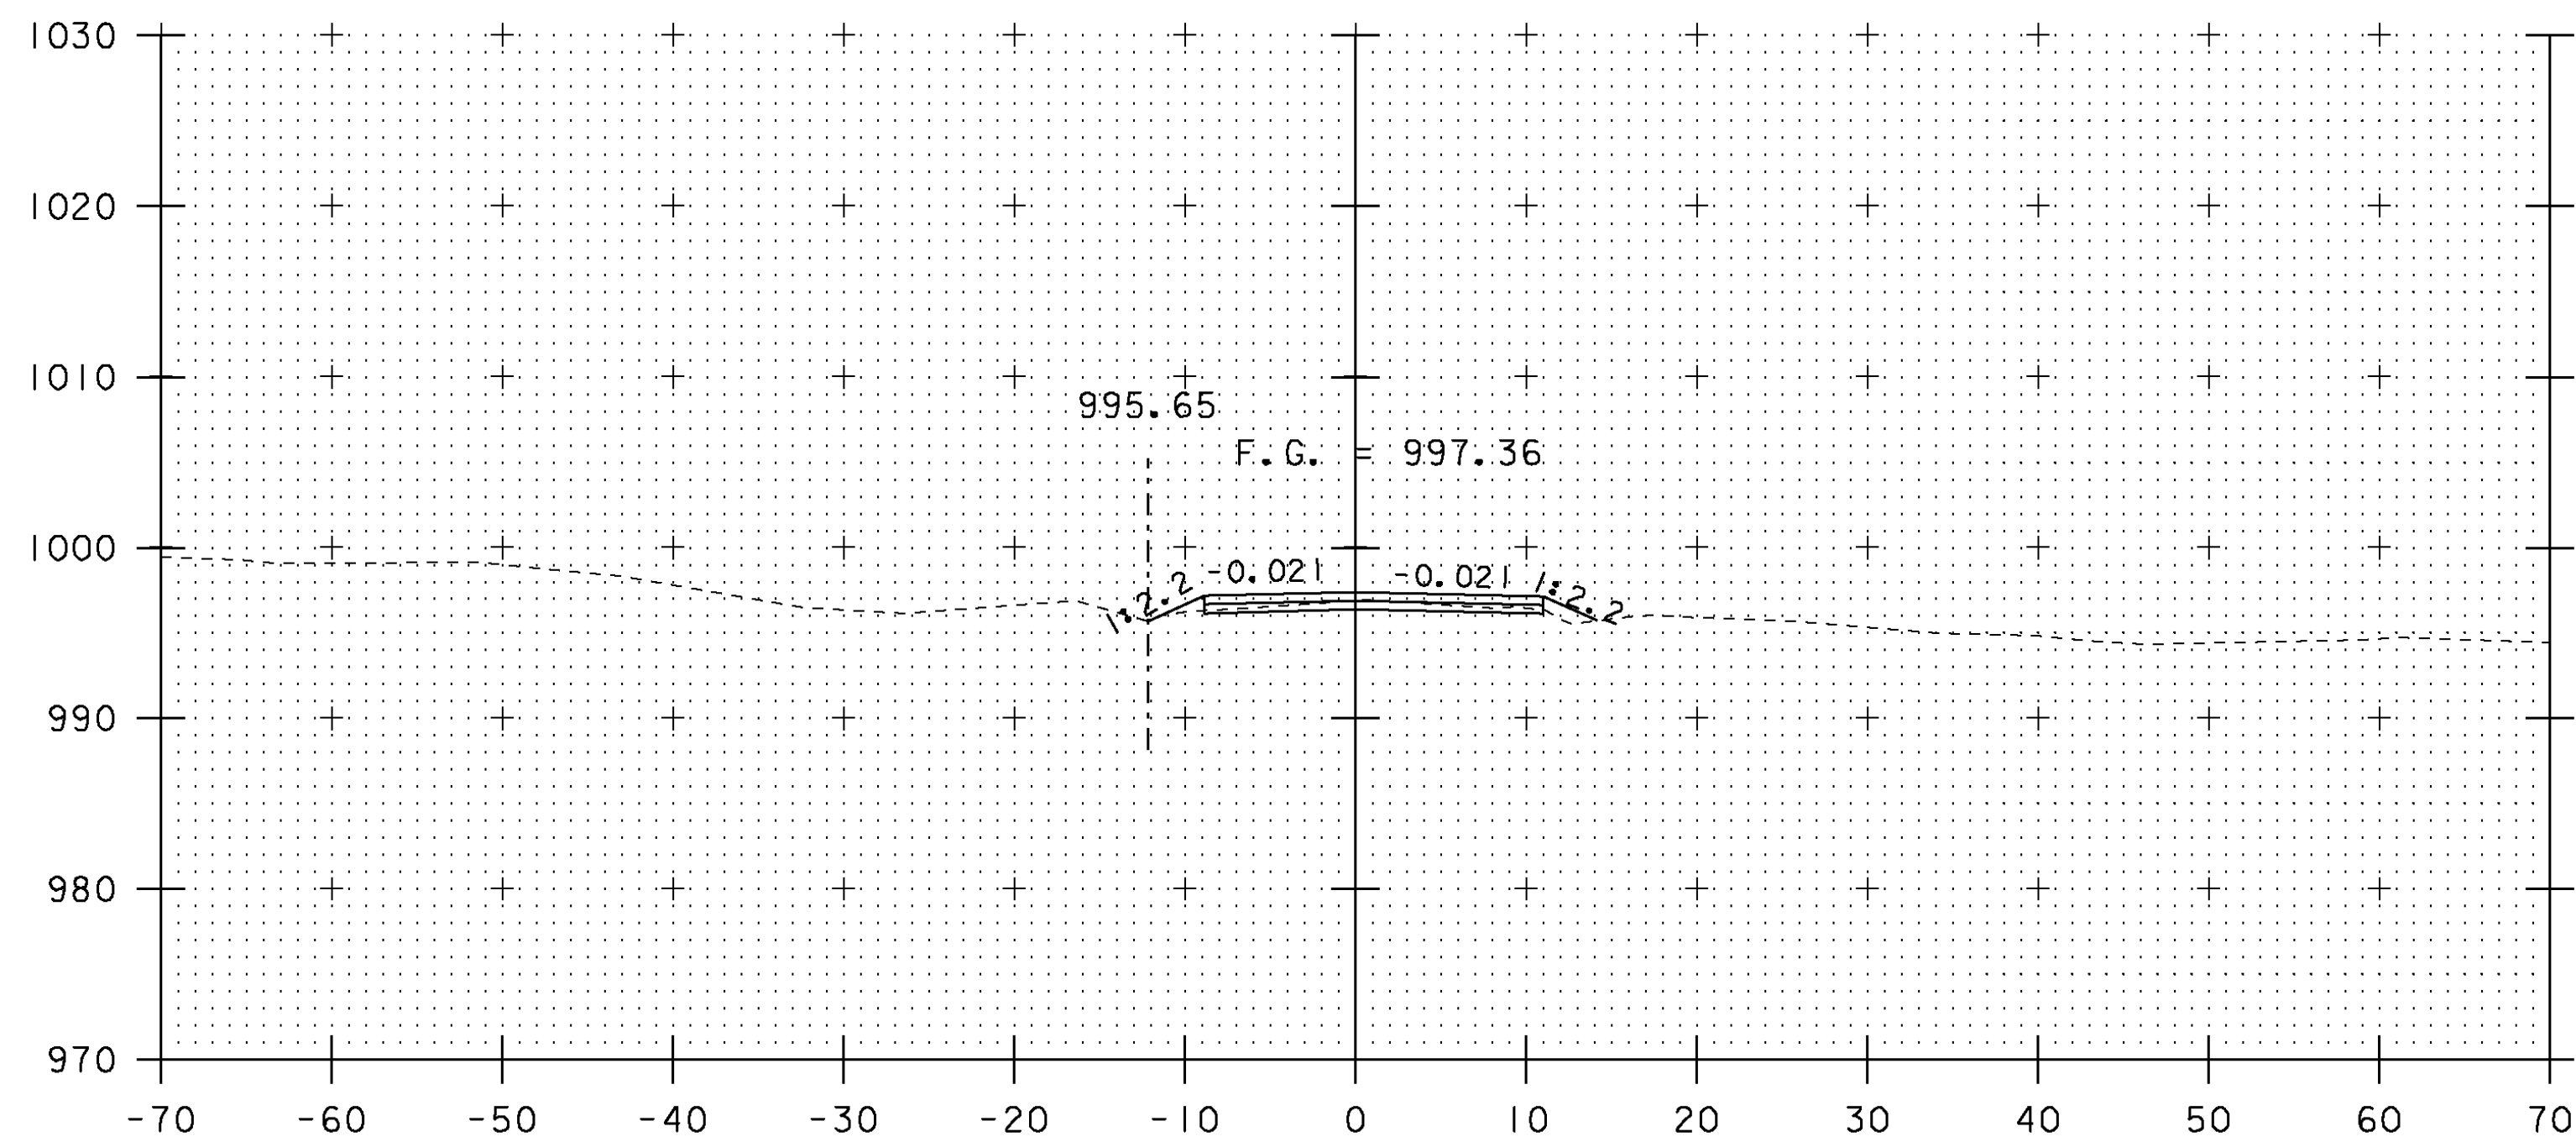

11+00

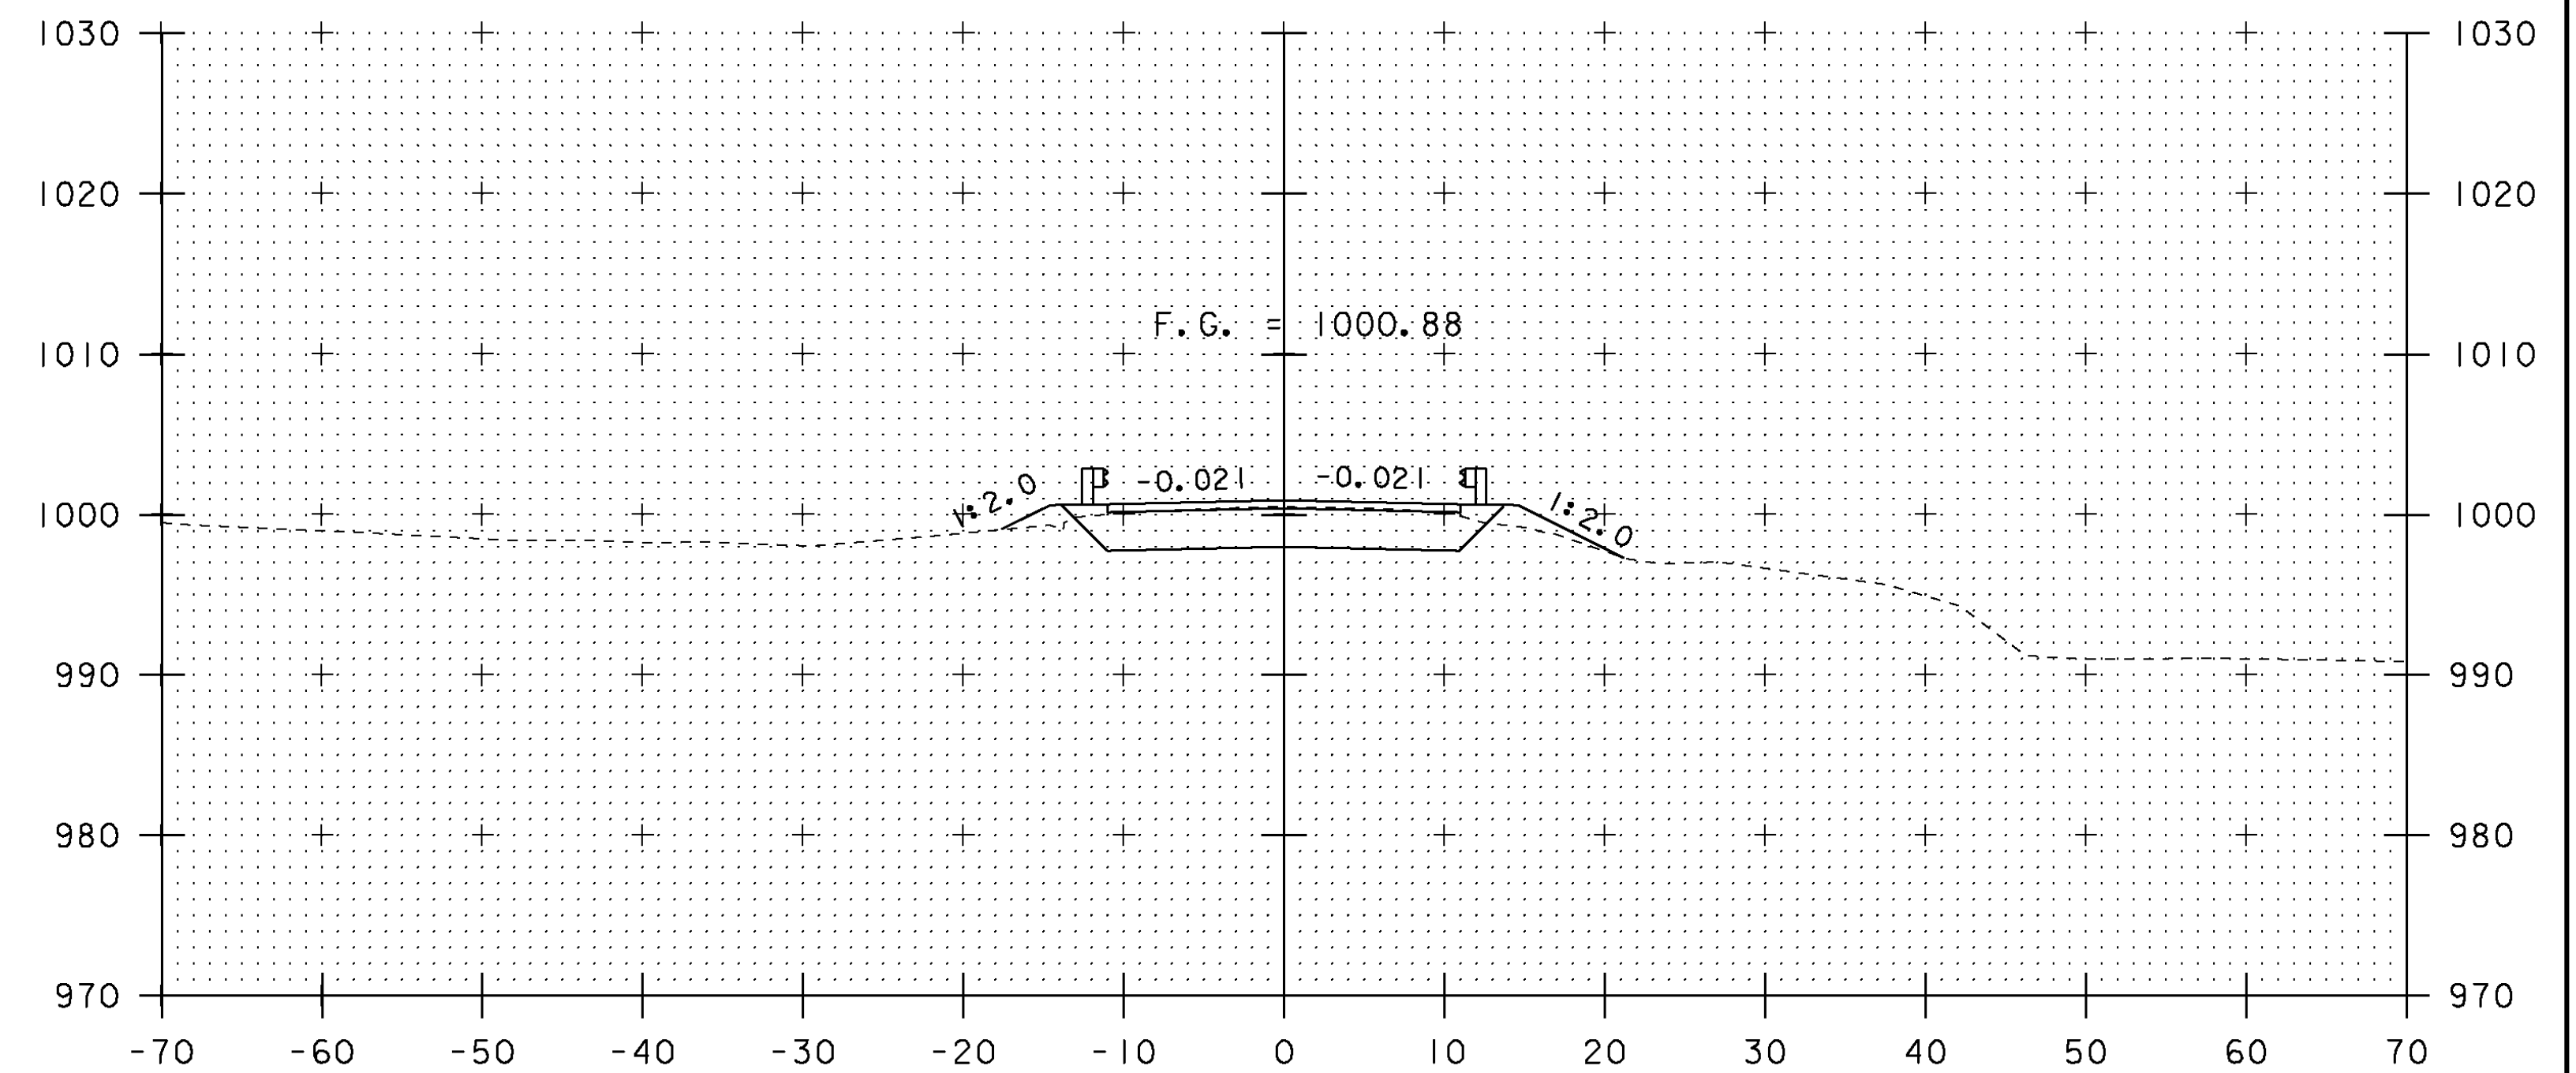

BEGIN PROJECT
11+50

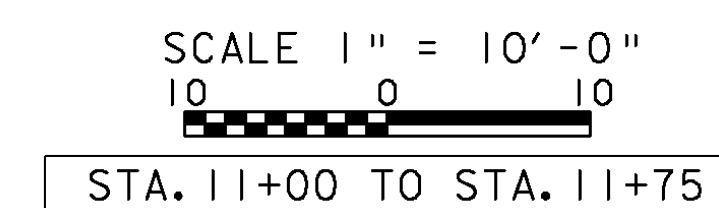

STA. 11+00 TO STA. 11+75

PROJECT NAME: MENDON	PLOT DATE: 07-SEP-2010
PROJECT NUMBER: BRO 1443 (43)	DRAWN BY: G. LAROCHE
FILE NAME: s01j272xs.dgn	CHECKED BY: J. SALVATORI
PROJECT LEADER: K. HIGGINS	SHEET 28 OF 32
DESIGNED BY: G. LAROCHE	
MAINLINE SECTIONS #2	