




12+25  
END BRIDGE STA 12+16.00

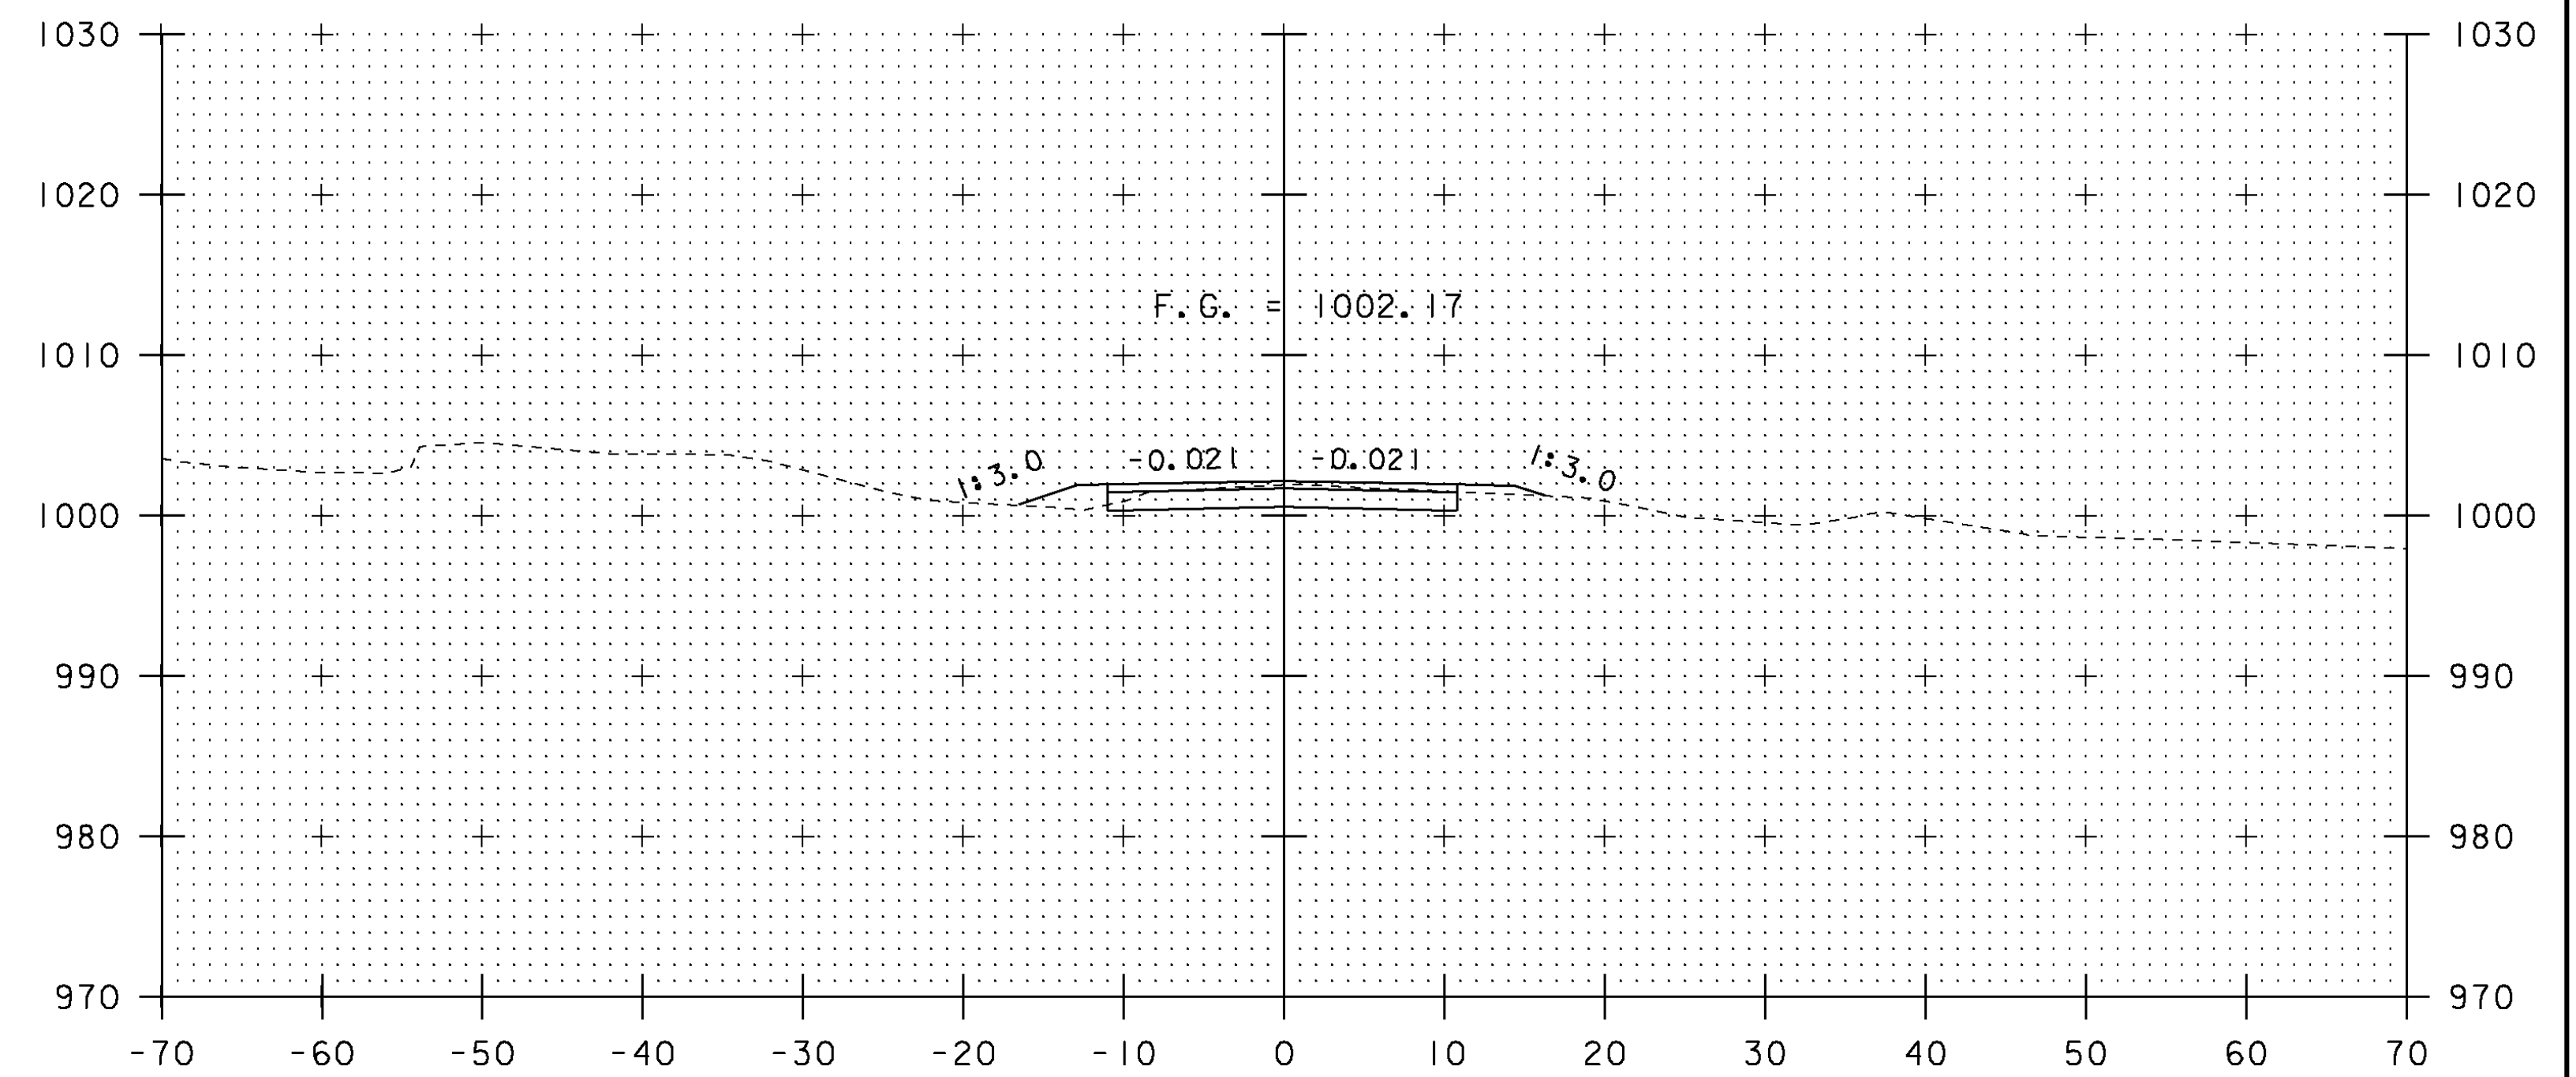

12+75

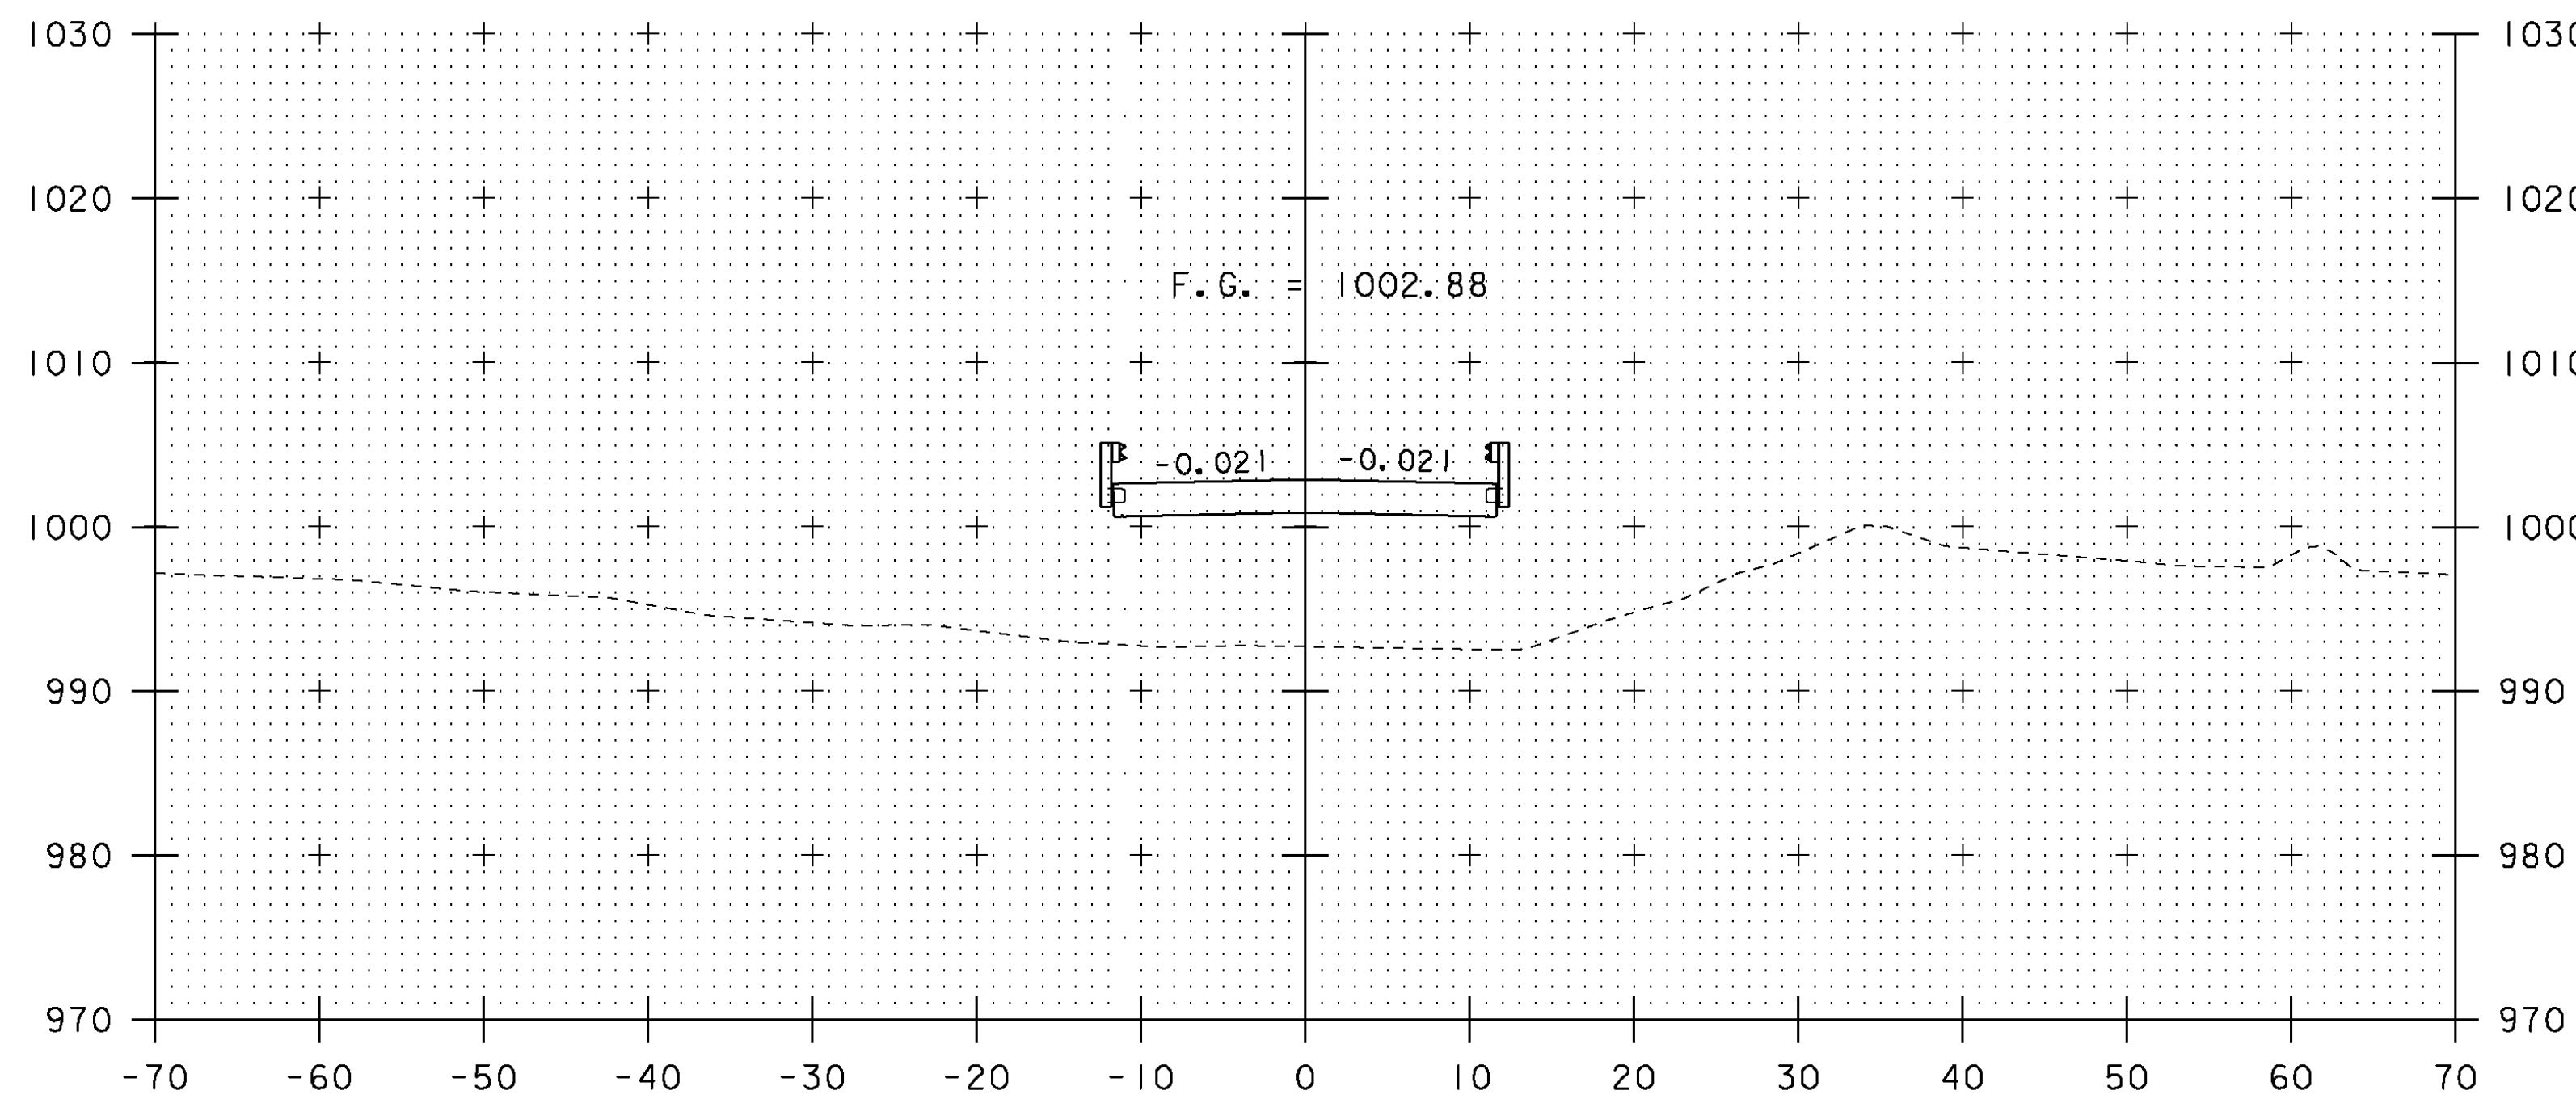

12+00  
BEGIN BRIDGE STA 11+77.00

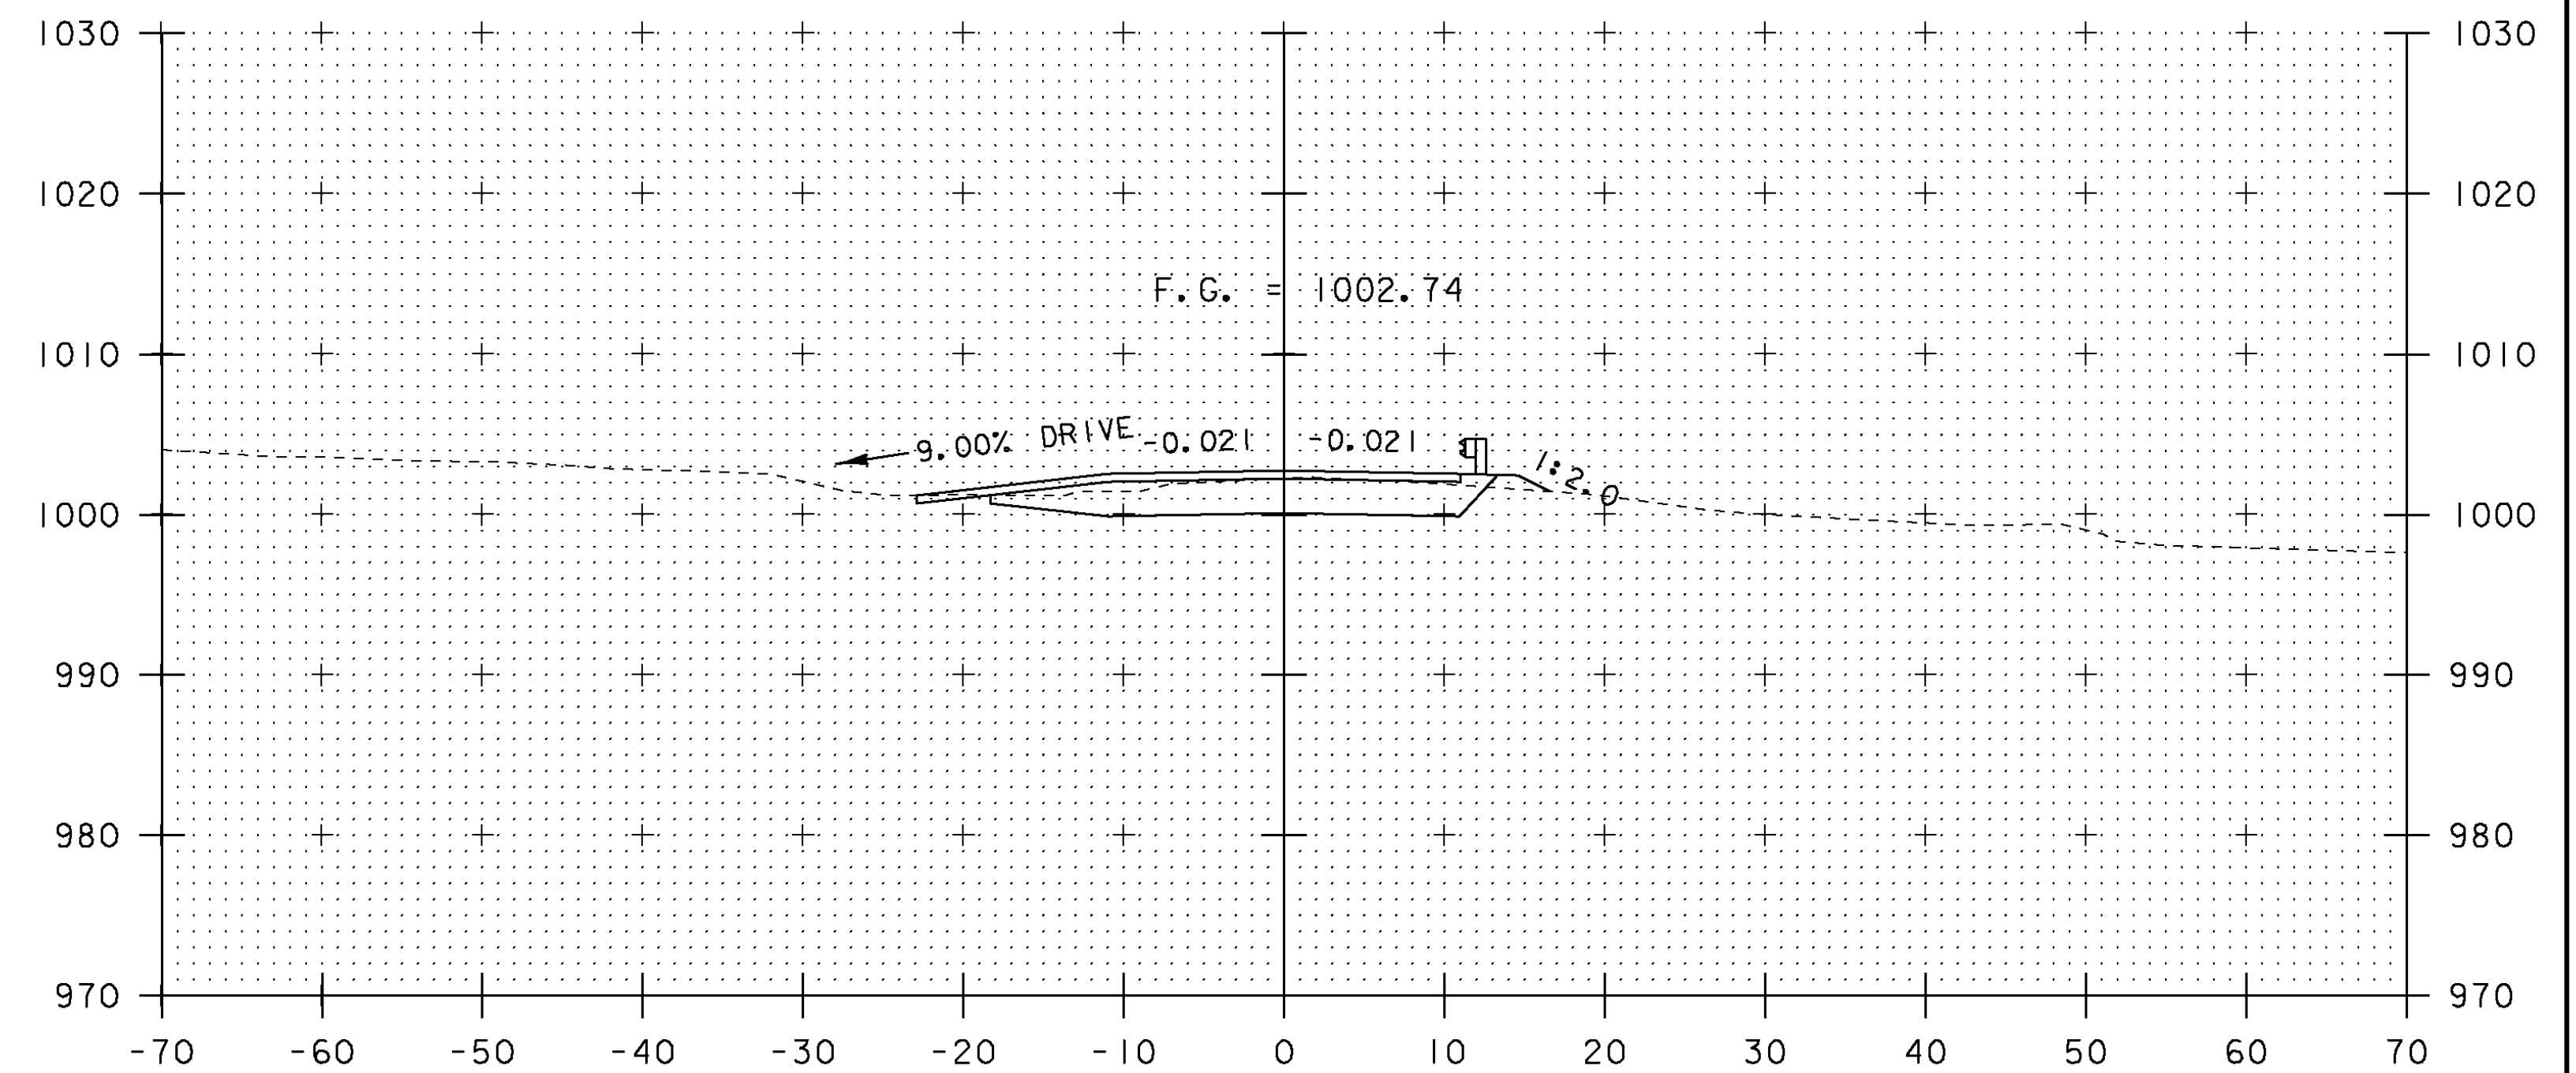

END PROJECT  
12+50

SCALE 1" = 10'-0"  
10 0 10  
STA. 12+00 TO STA. 12+75

PROJECT NAME: MENDON  
PROJECT NUMBER: BRO 1443 (43)

FILE NAME: s01j272xs.dgn  
PROJECT LEADER: K. HIGGINS  
DESIGNED BY: G. LAROCHE  
MAINLINE SECTIONS #3

PLOT DATE: 07-SEP-2010  
DRAWN BY: G. LAROCHE  
CHECKED BY: J. SALVATORI  
SHEET 29 OF 32