




END APPROACH
13+25

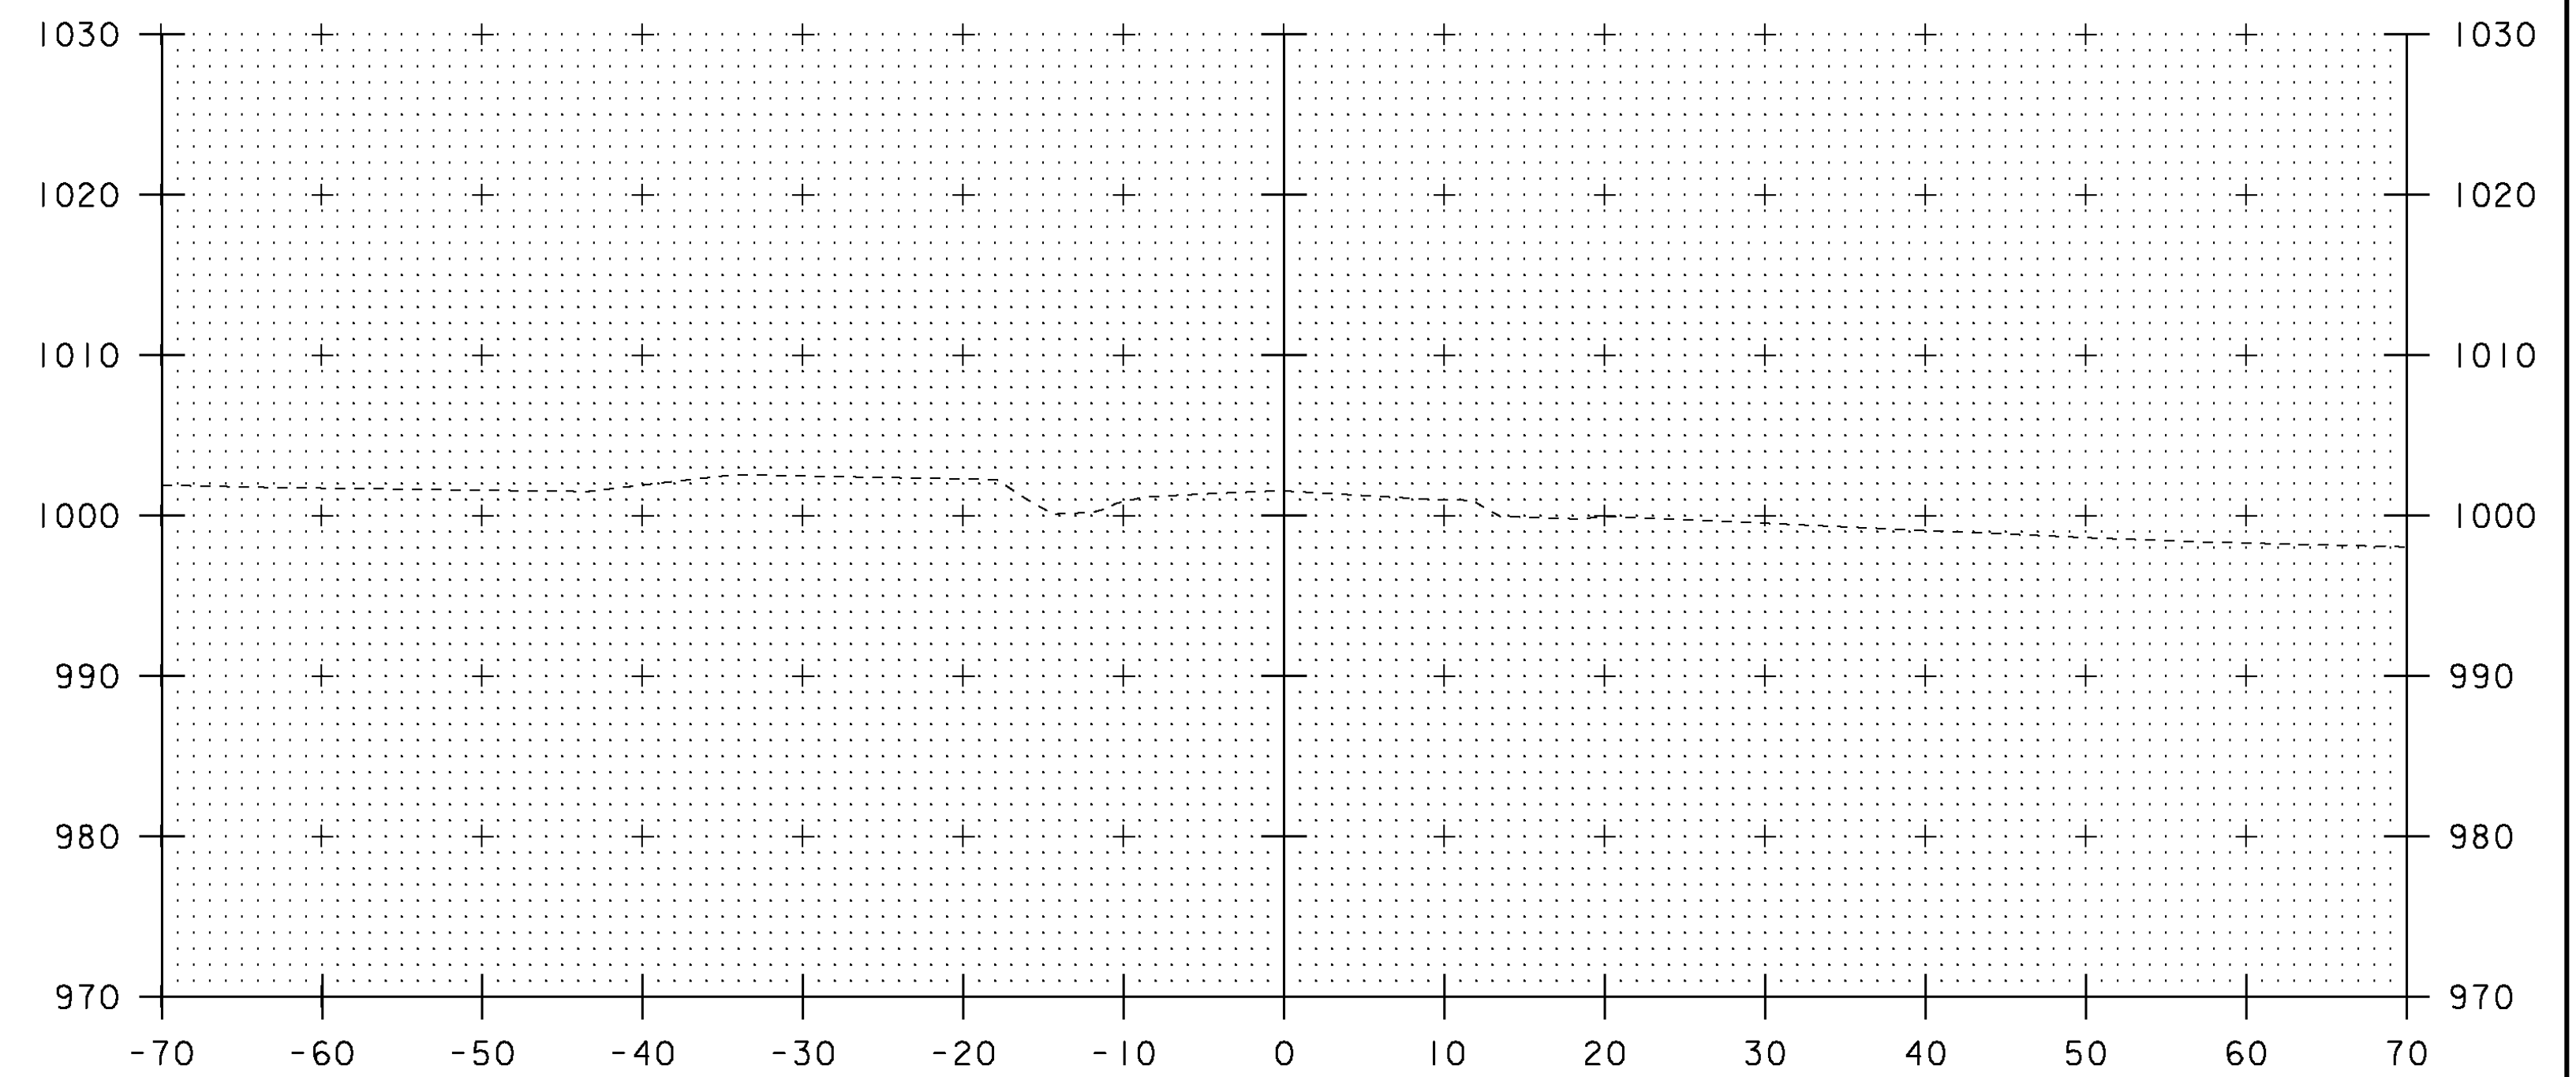


13+75

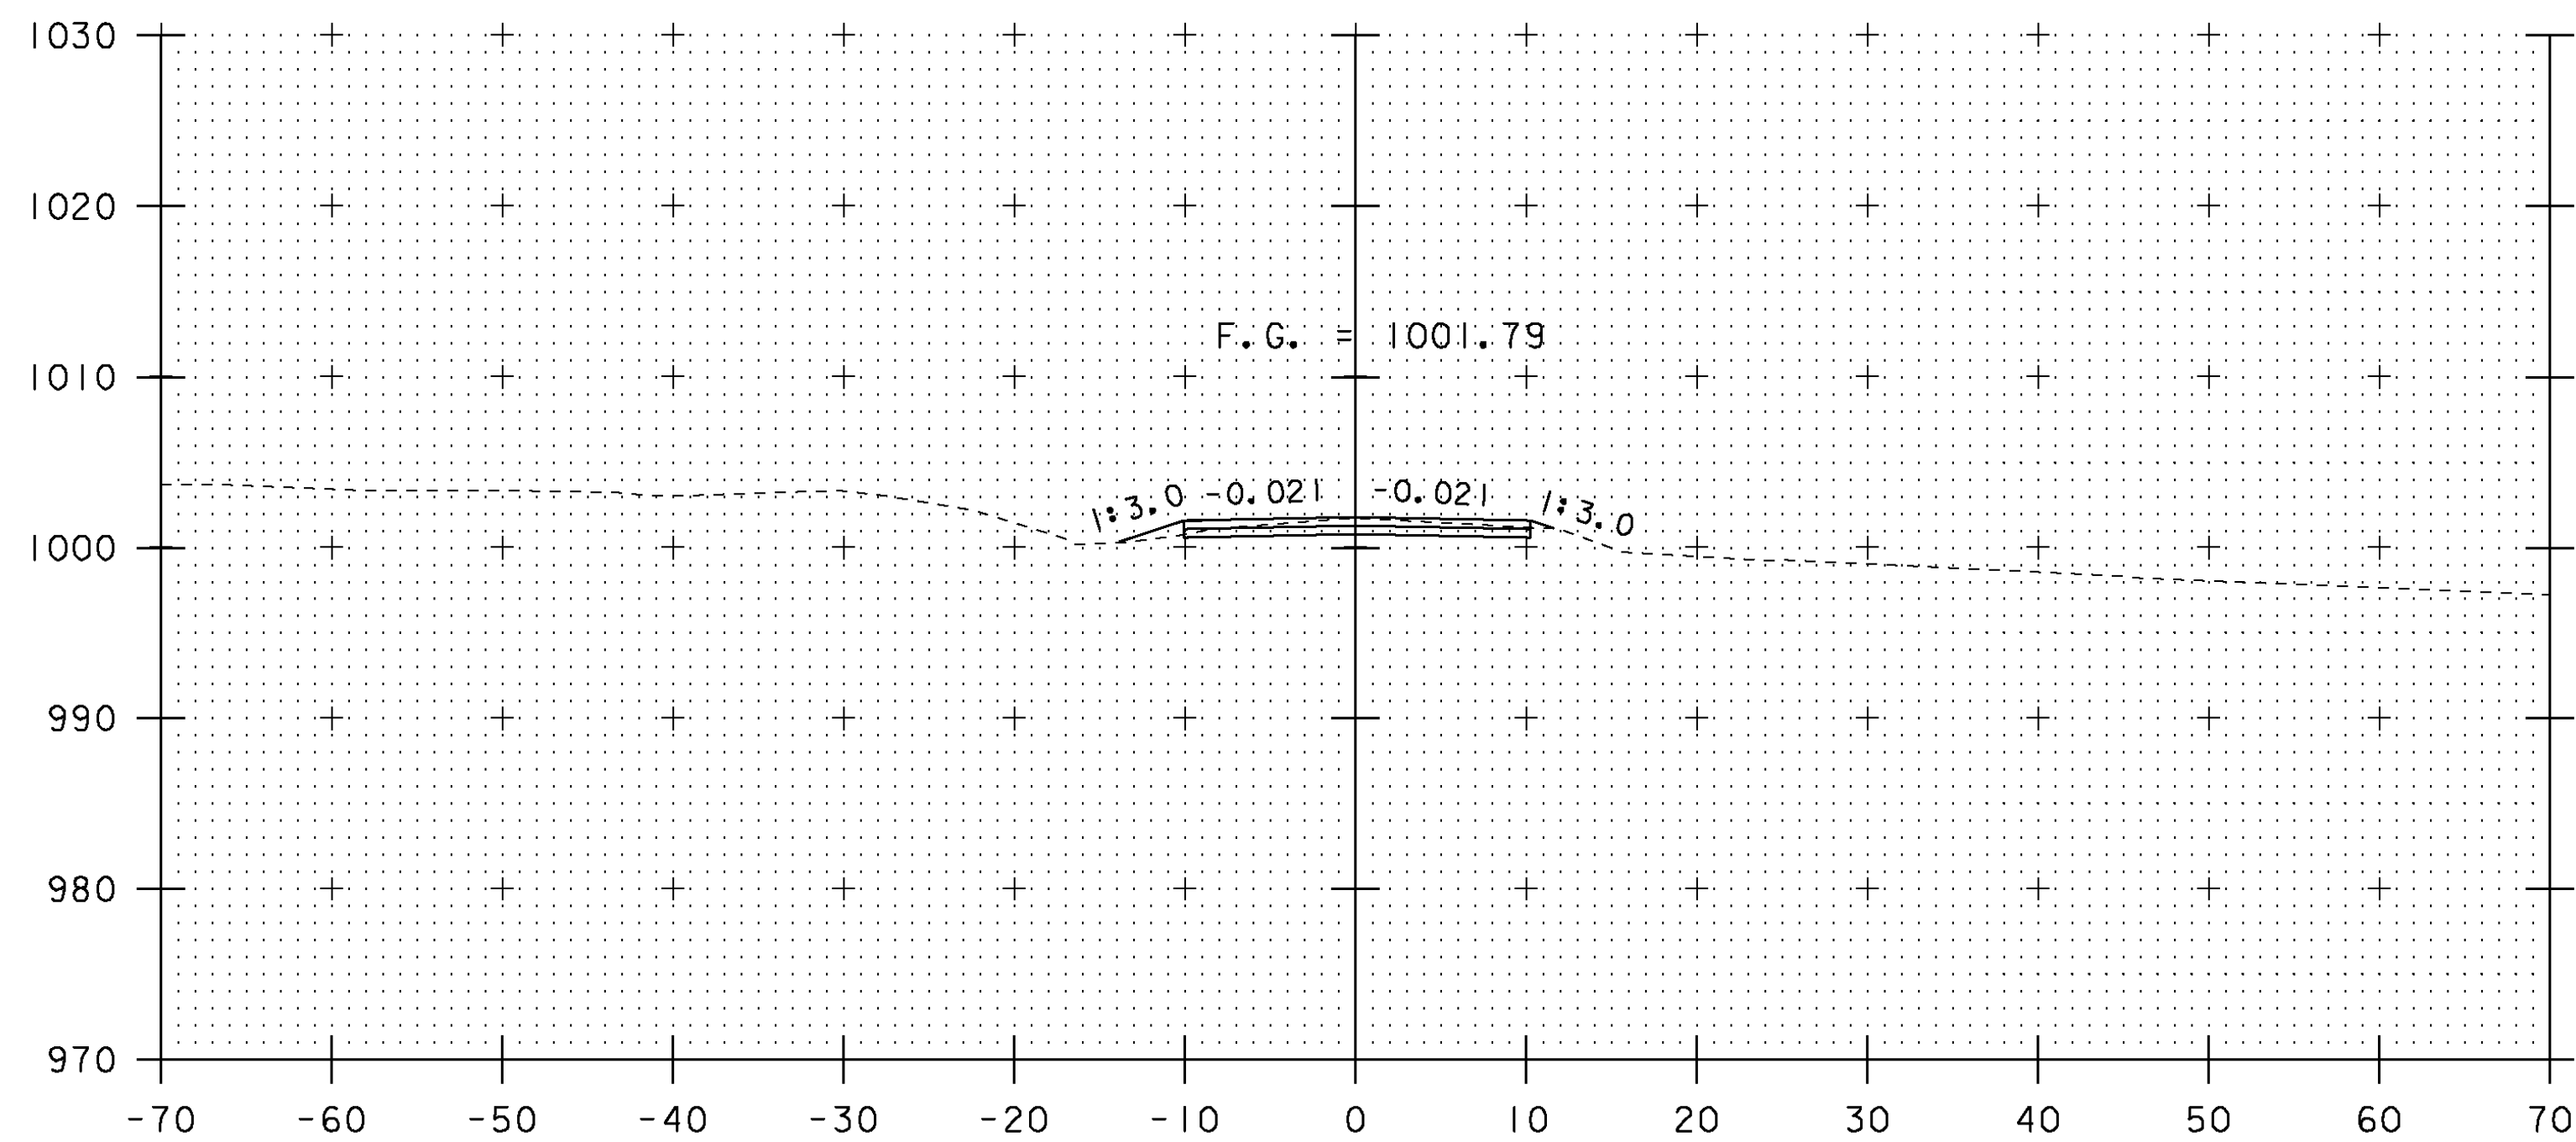

13+00

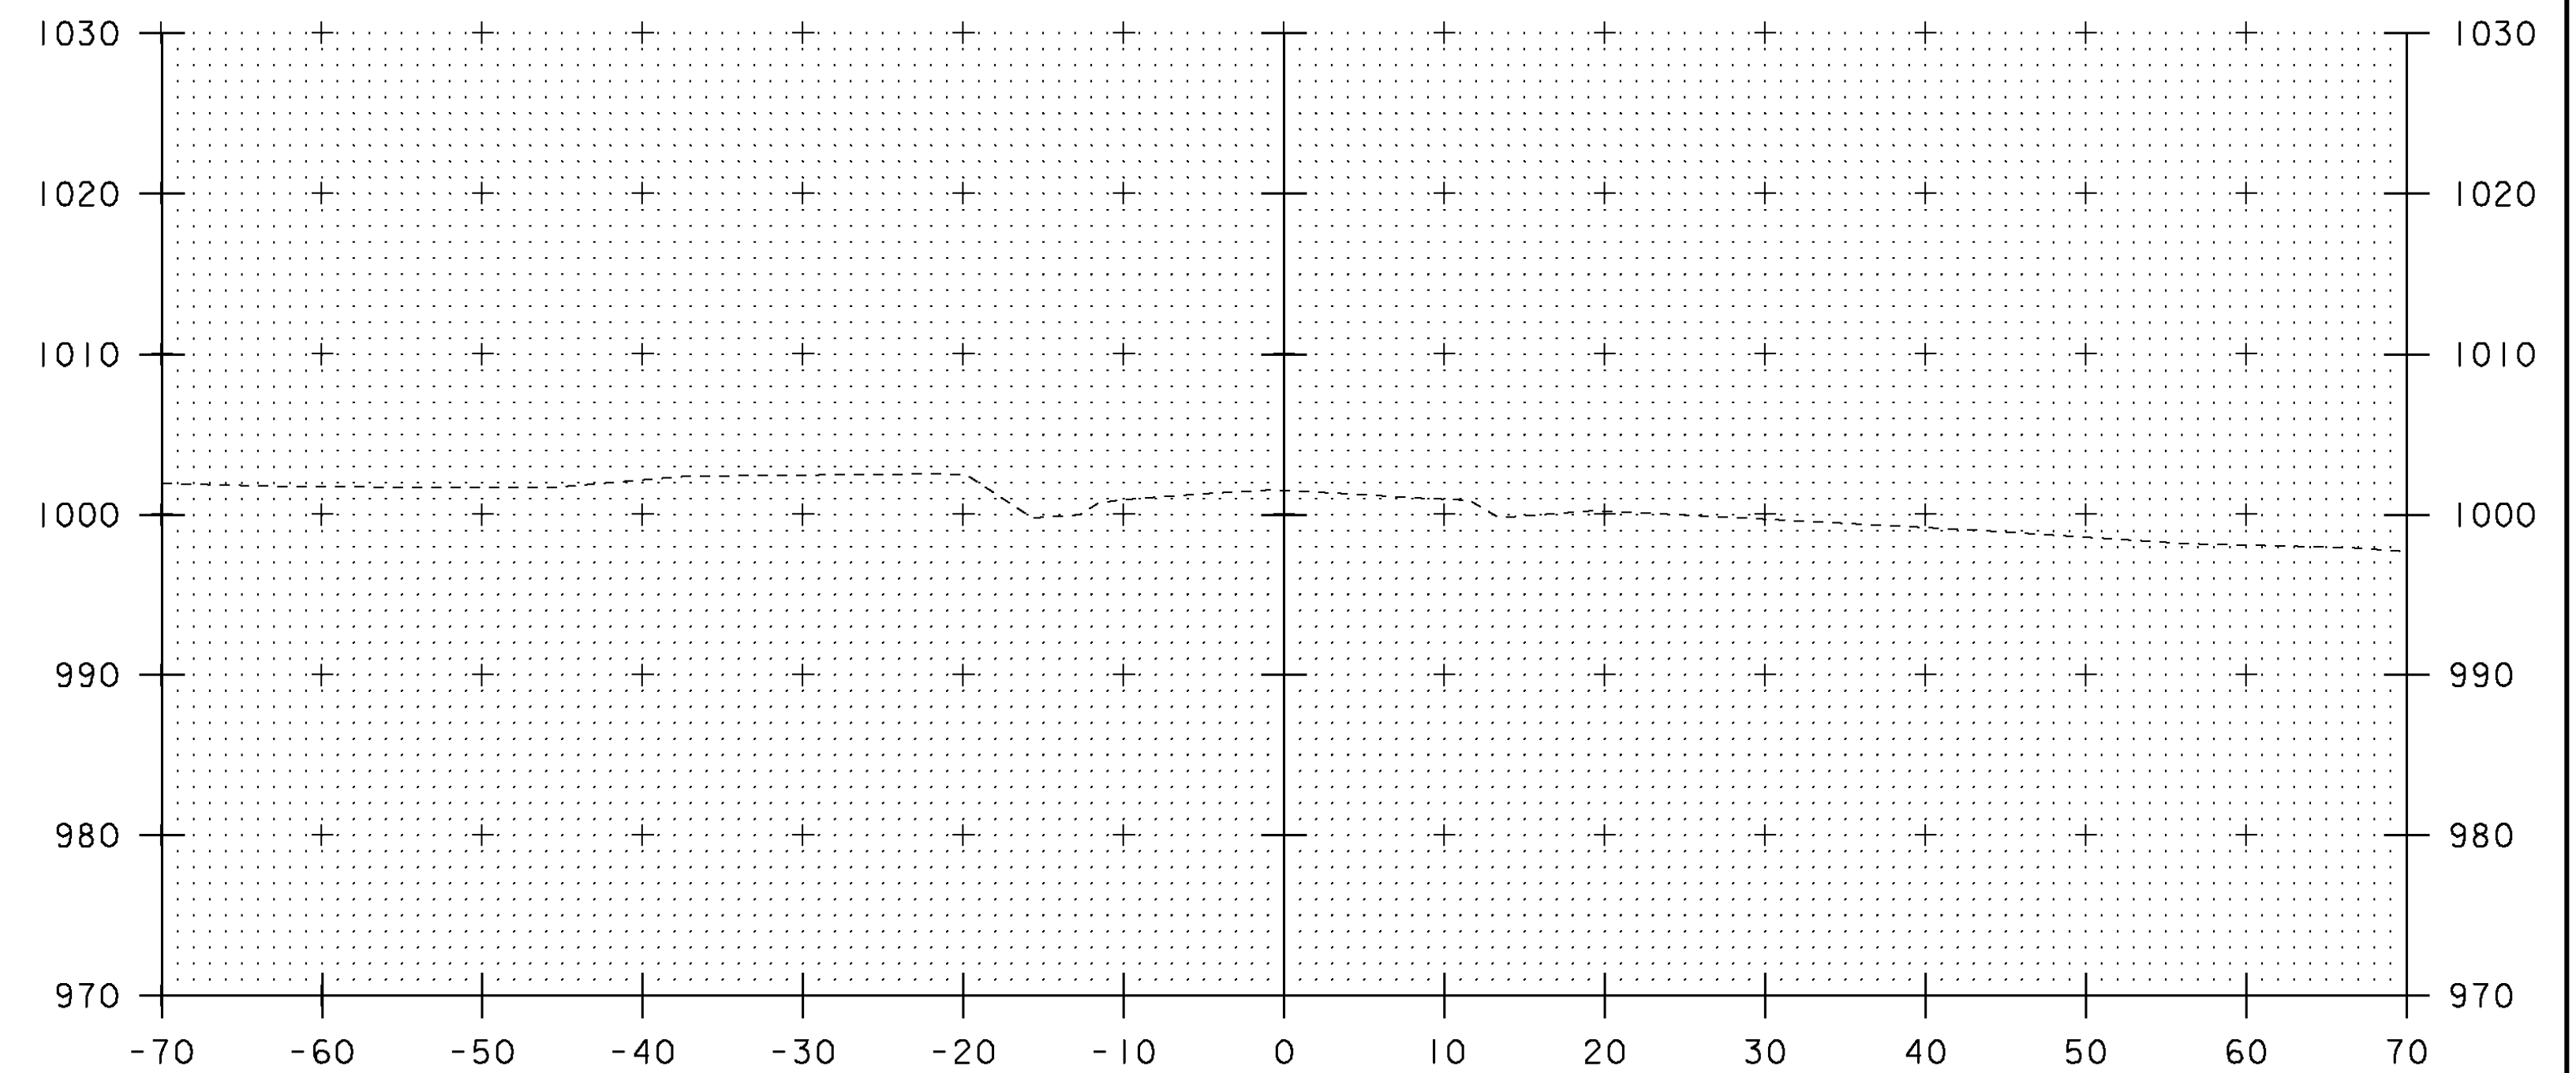

13+50

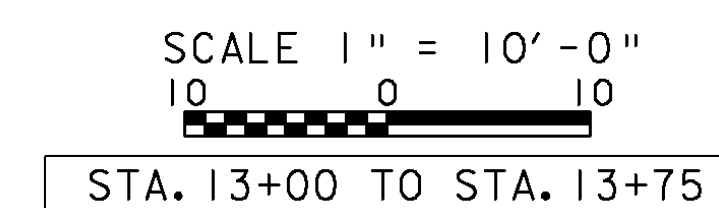

STA. 13+00 TO STA. 13+75

PROJECT NAME: MENDON
PROJECT NUMBER: BRO 1443 (43)

FILE NAME: s01j272xs.dgn
PROJECT LEADER: K. HIGGINS
DESIGNED BY: G. LAROCHE
MAINLINE SECTIONS #4

PLOT DATE: 07-SEP-2010
DRAWN BY: G. LAROCHE
CHECKED BY: J. SALVATORI
SHEET 30 OF 32