




EXISTING GROUND NO LONGER VALID SINCE IRENE 8-28-II.
NEW SURVEY REQUIRED FOR CHANNEL SECTIONS
(TYP ALL SHEETS 31 & 32).

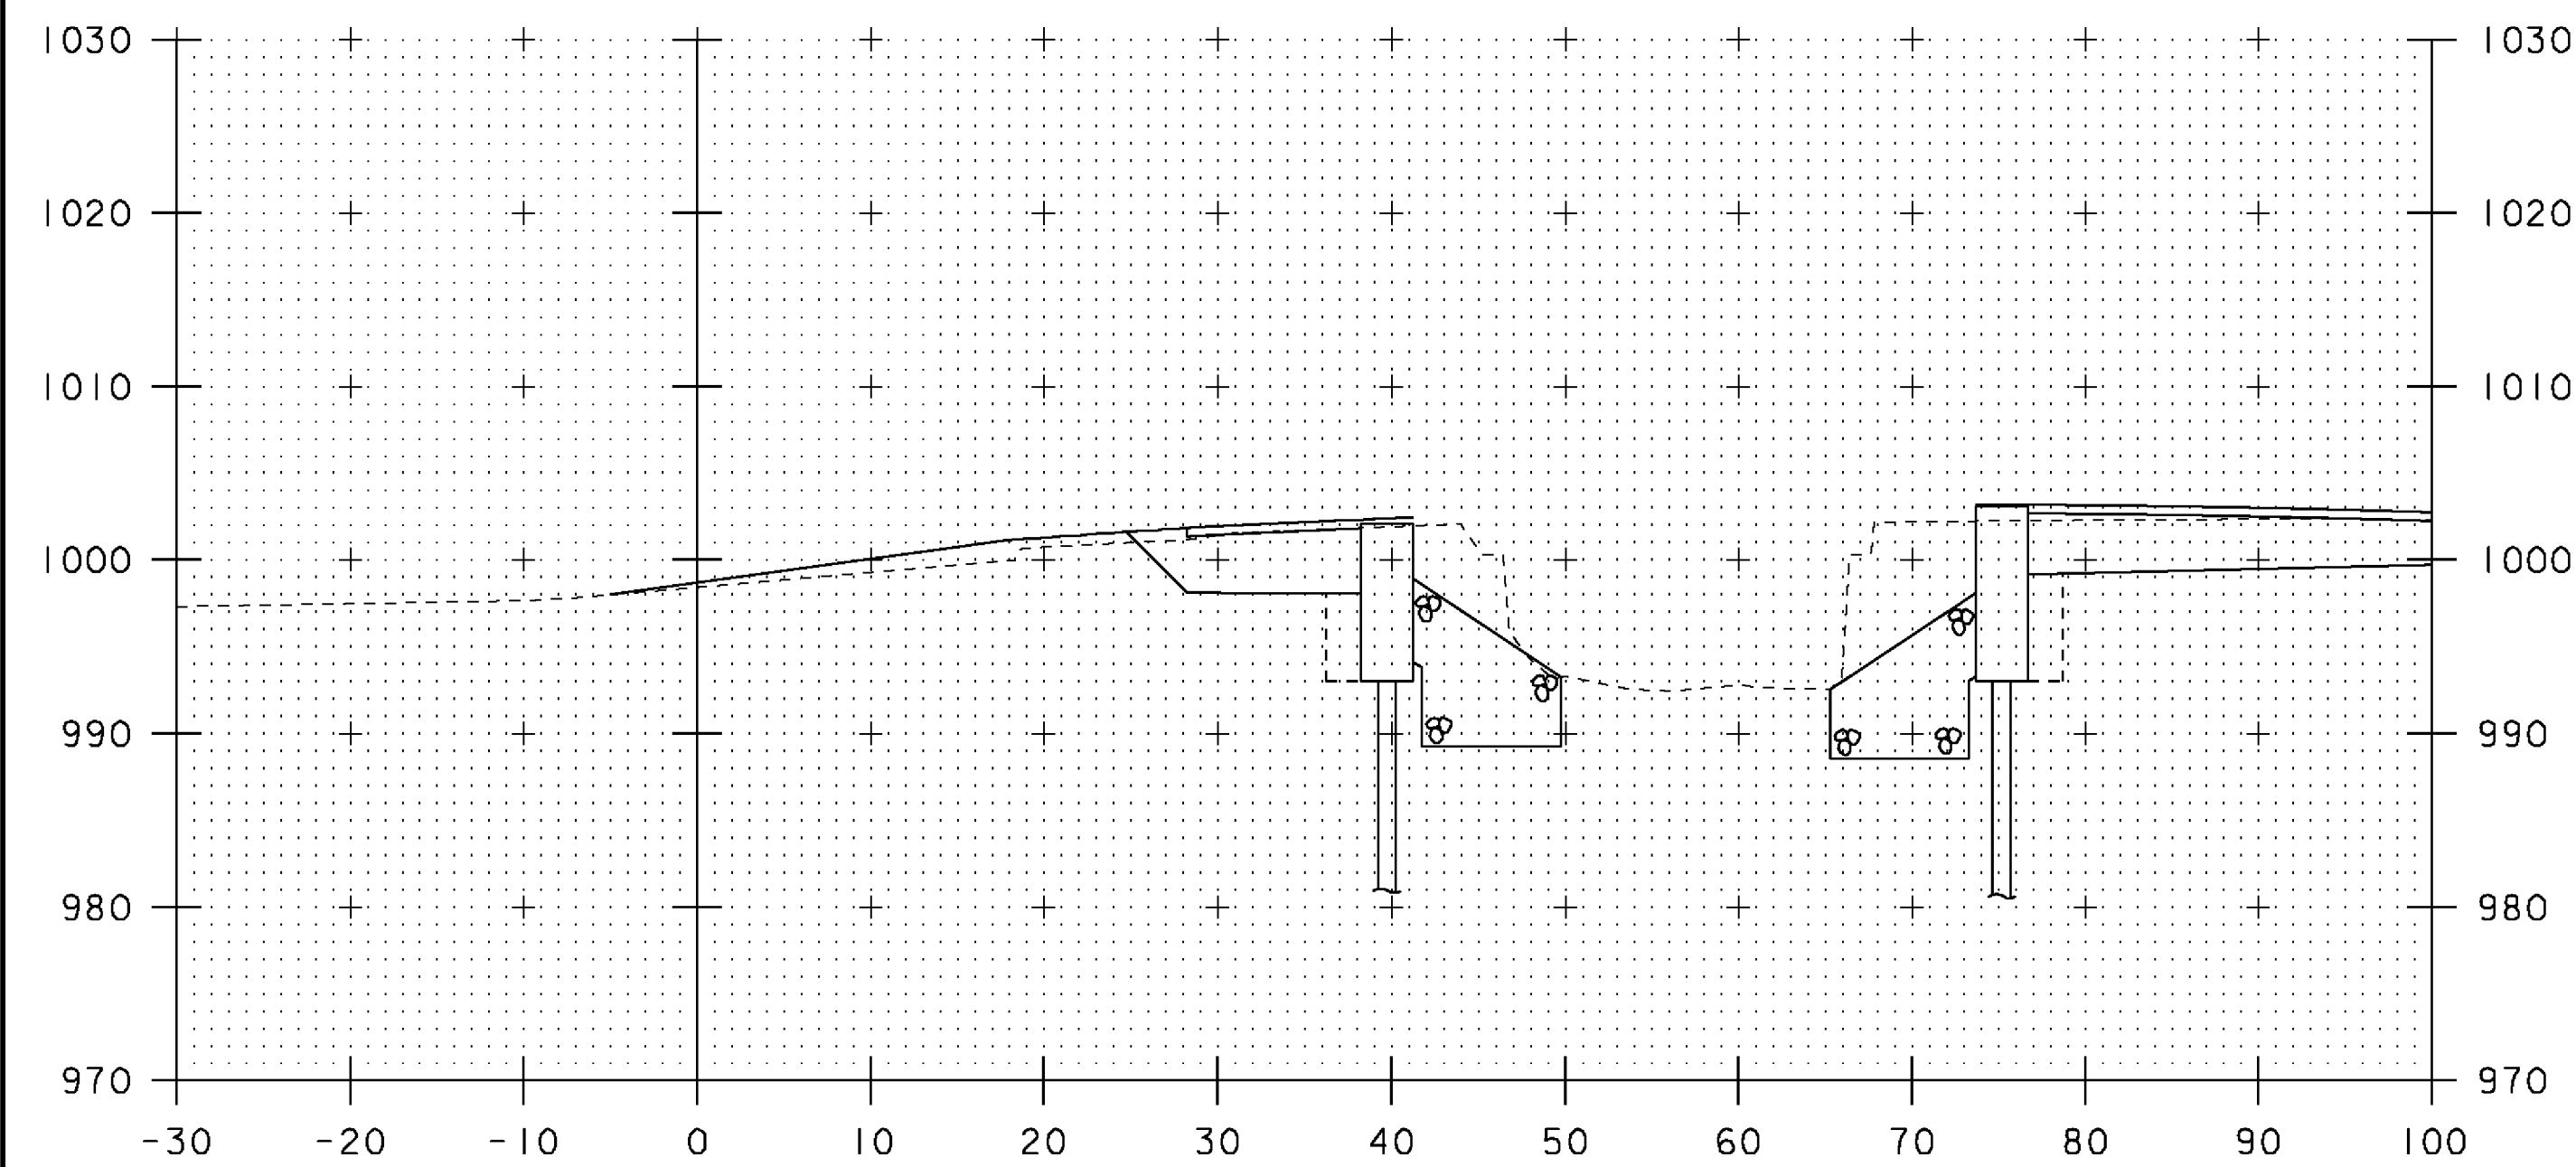


51+75

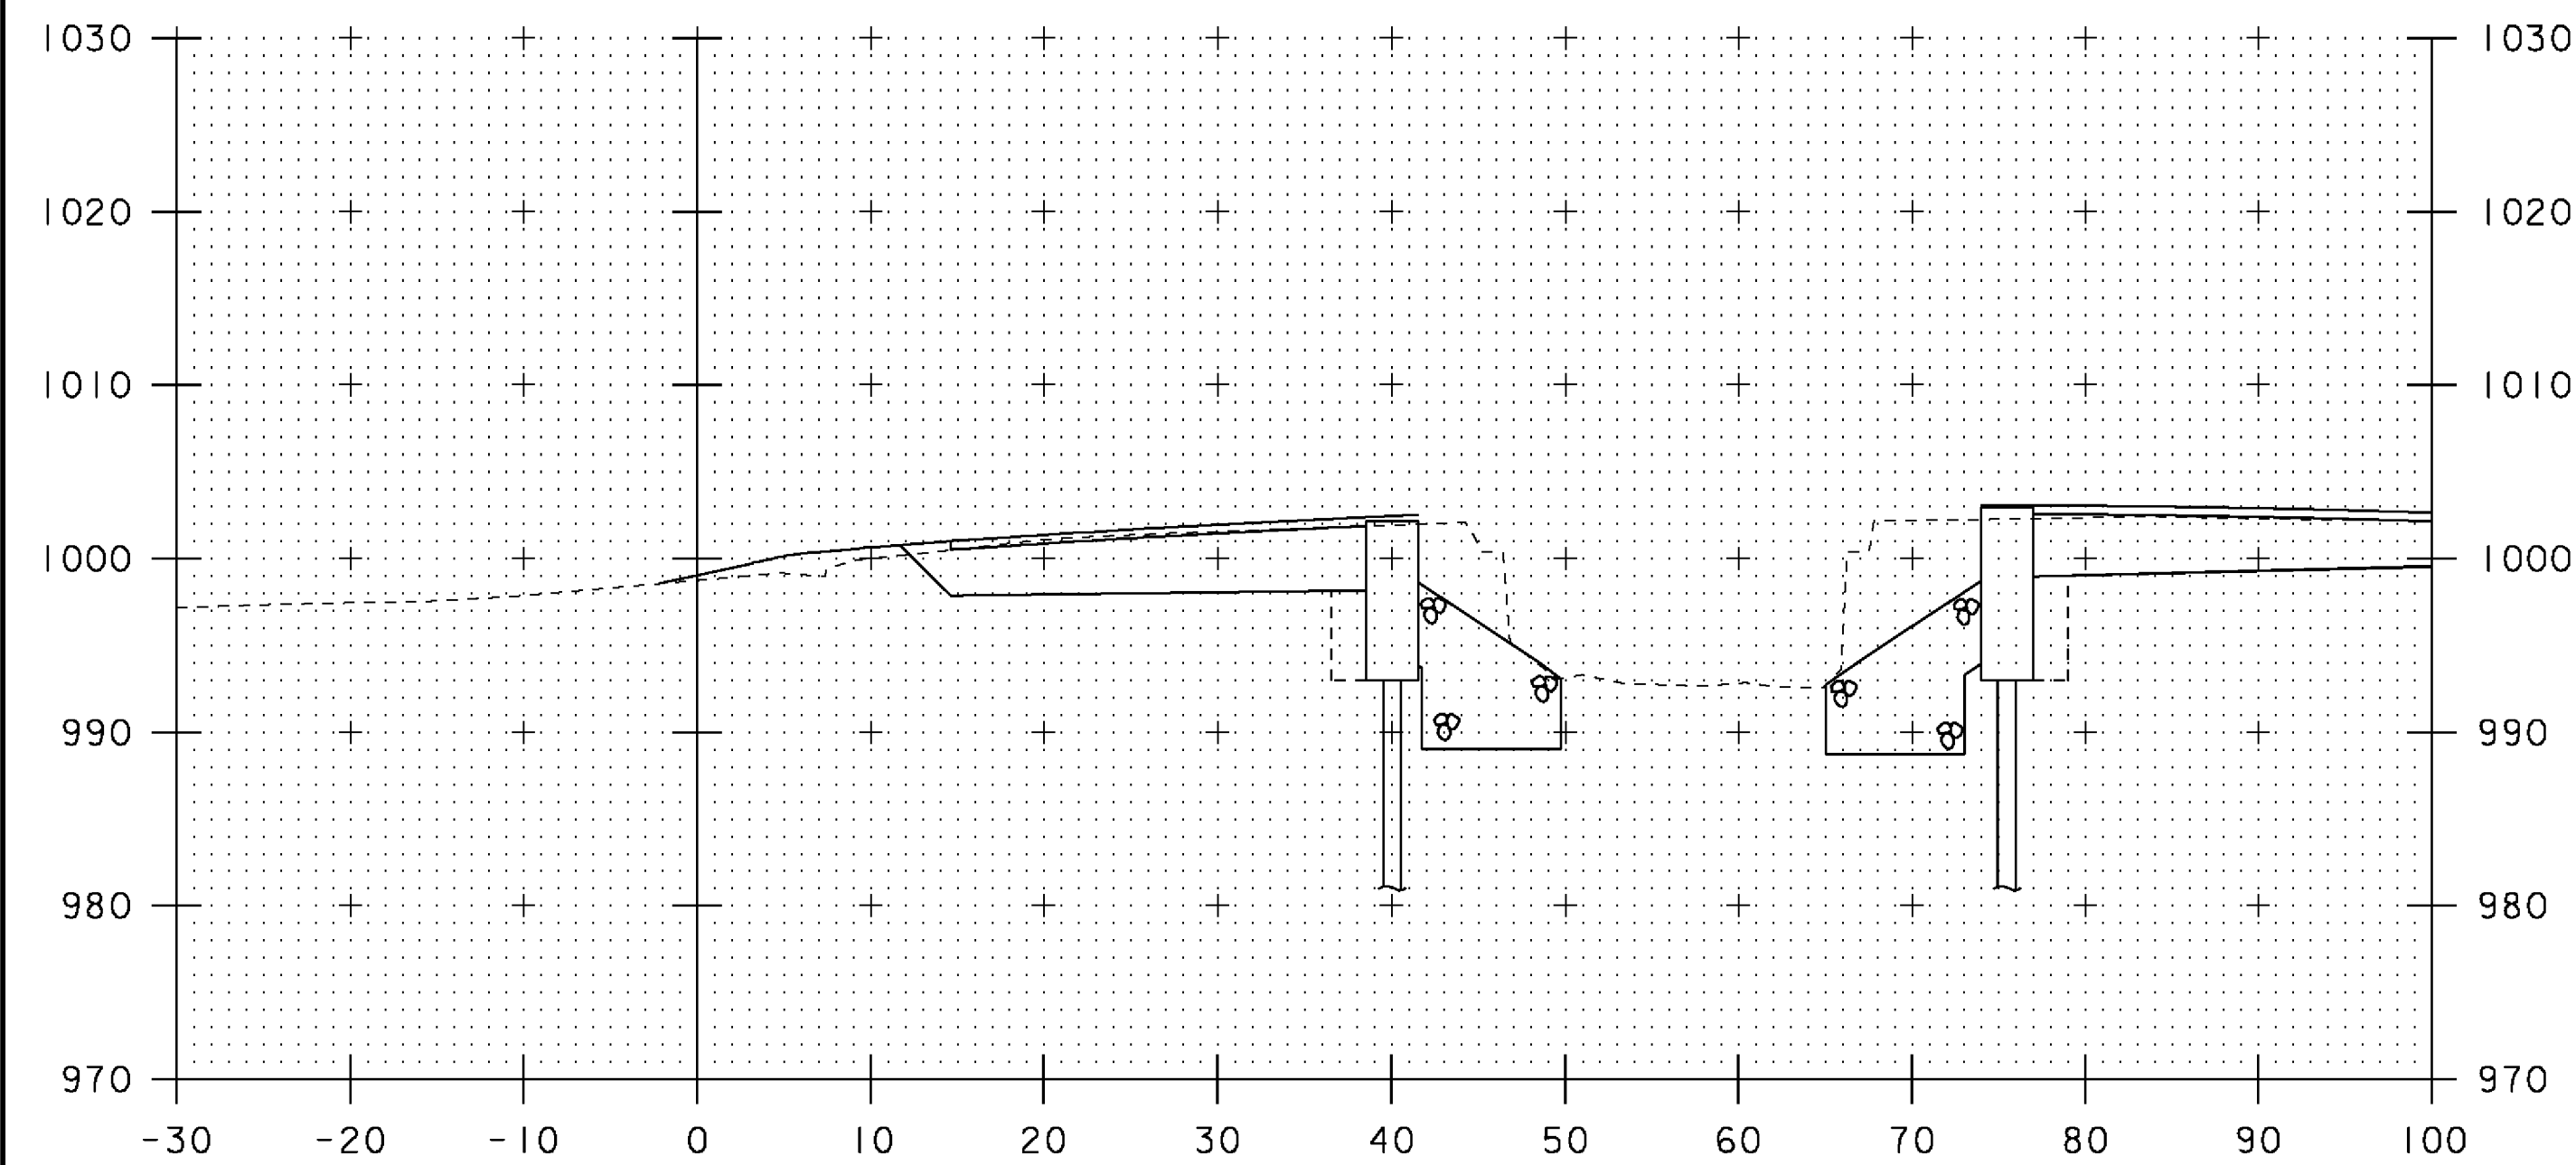

51+70

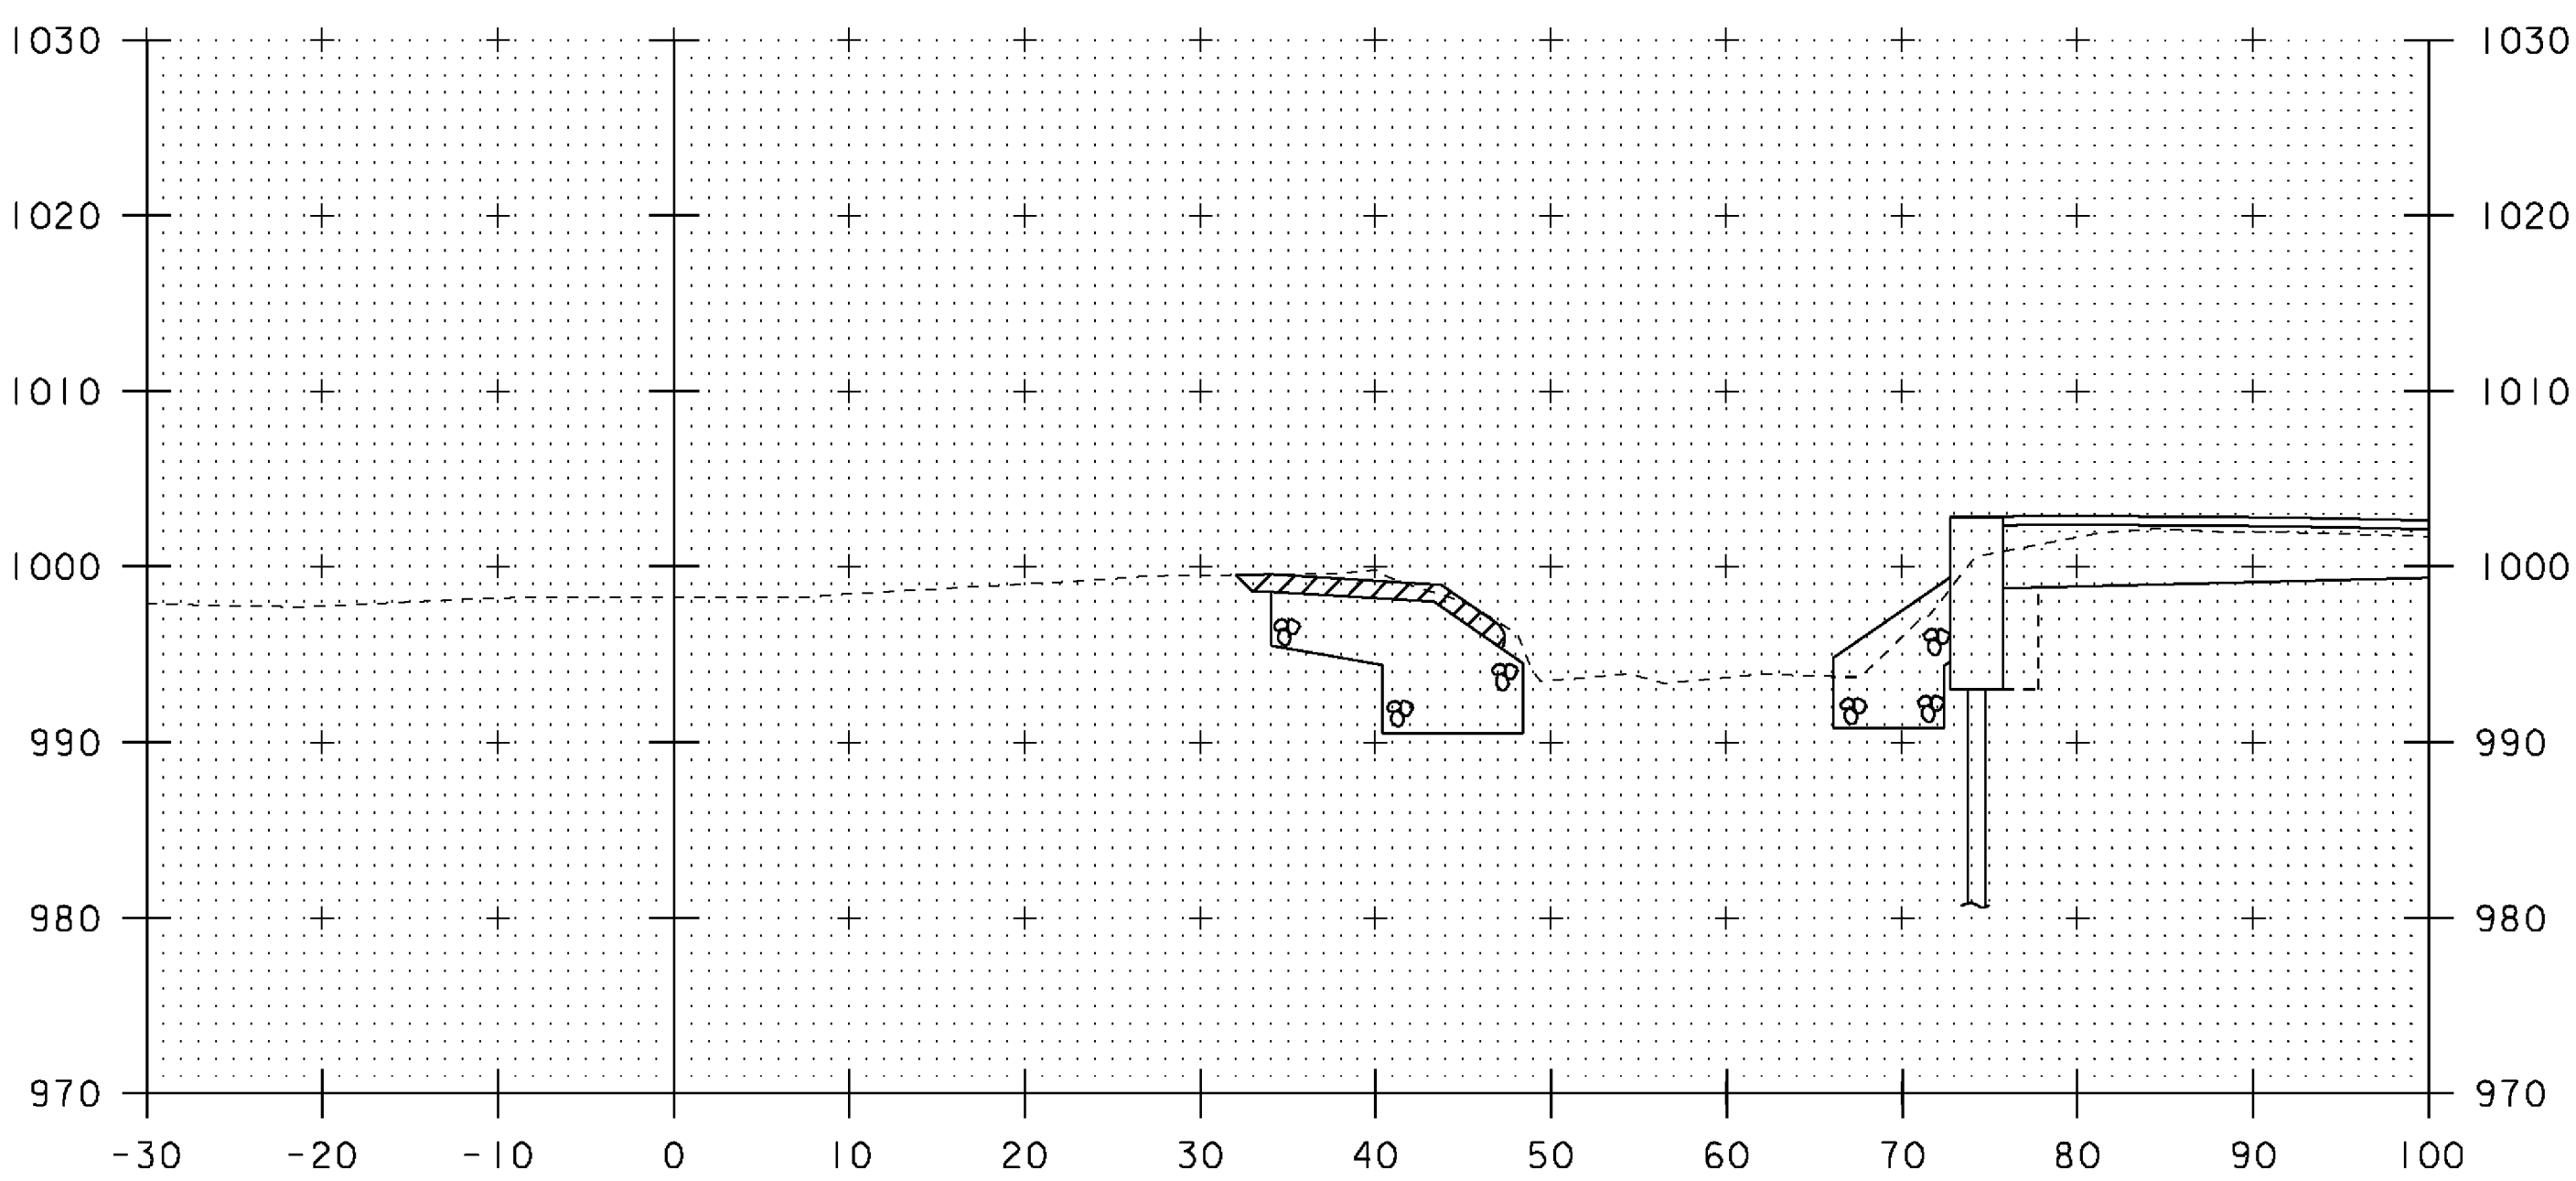

51+90

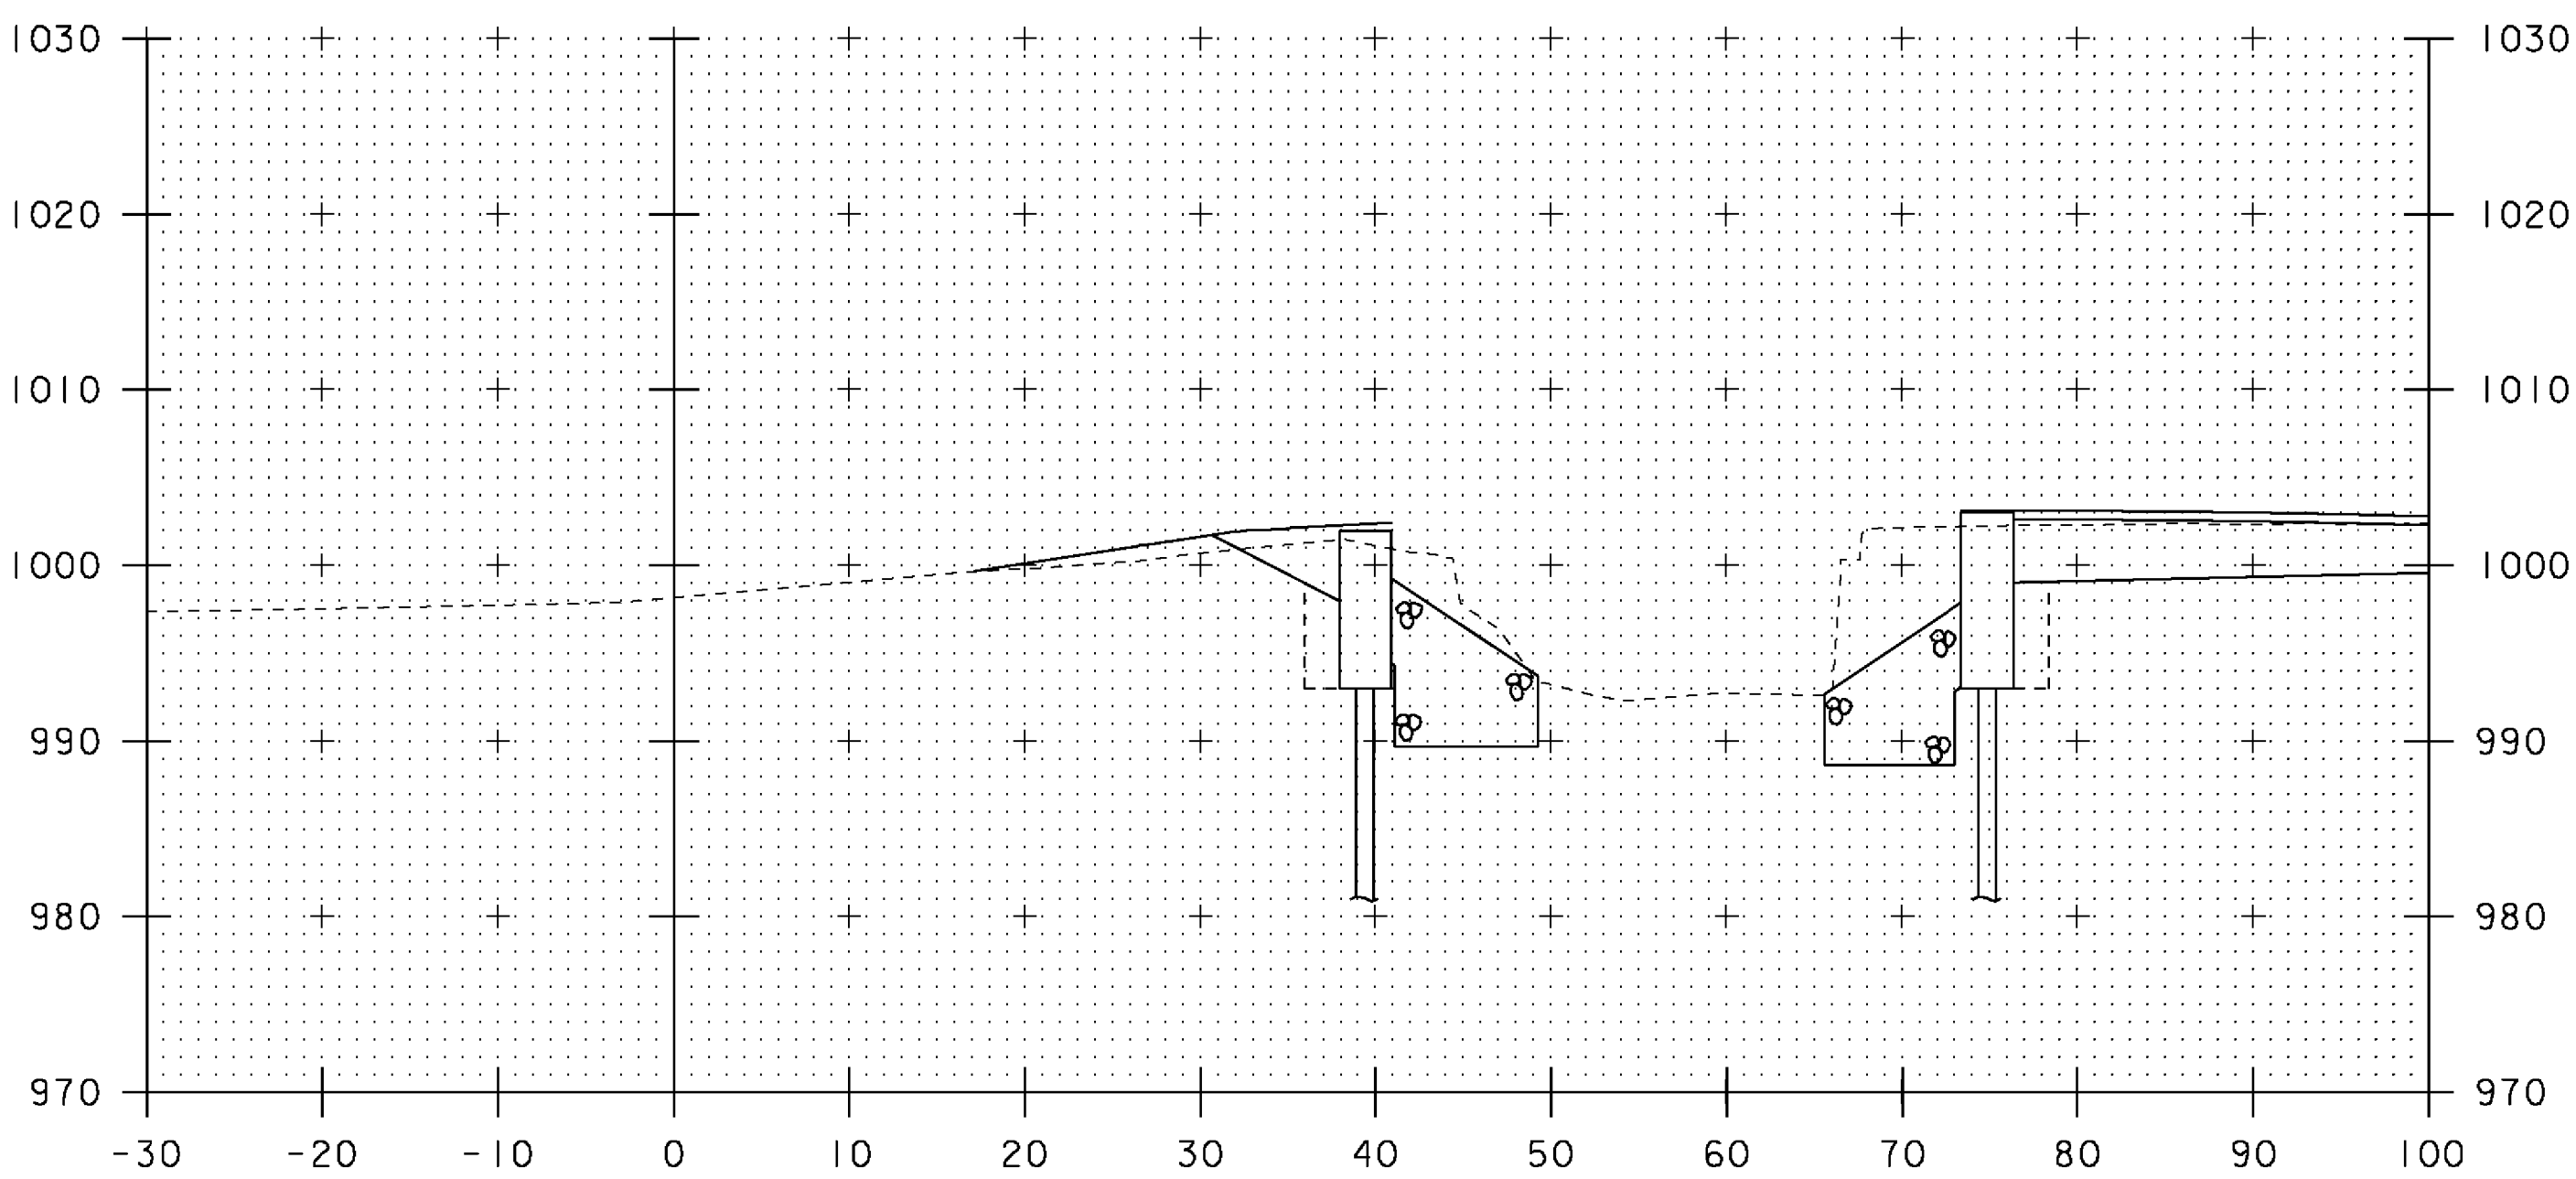

51+80

STA 51+94 RT. (ABUT #1)
END UNCLASSIFIED CHANNEL EXCAVATION
END STONE FILL, TYPE IV
END GEOTEXTILE UNDER STONE FILL
END GRUBBING MATERIAL

STA 51+99 RT. (ABUT #2)
END UNCLASSIFIED CHANNEL EXCAVATION
END STONE FILL, TYPE IV
END GEOTEXTILE UNDER STONE FILL
END GRUBBING MATERIAL

RT. (ABUT #1)
BEGIN GRUBBING MATERIAL 51+82 RT.

RT. (ABUT #2)
BEGIN GRUBBING MATERIAL 51+87 RT.

SCALE 1" = 10' - 0"

STA. 51+70 TO STA. 51+90

PROJECT NAME: MENDON
PROJECT NUMBER: BRO 1443 (43)

FILE NAME: s01j272xs.dgn
PROJECT LEADER: K. HIGGINS
DESIGNED BY: G. LAROCHE
CHANNEL SECTIONS #2

PLOT DATE: 07-SEP-2010
DRAWN BY: G. LAROCHE
CHECKED BY: J. SALVATORI
SHEET 32 OF 32