 

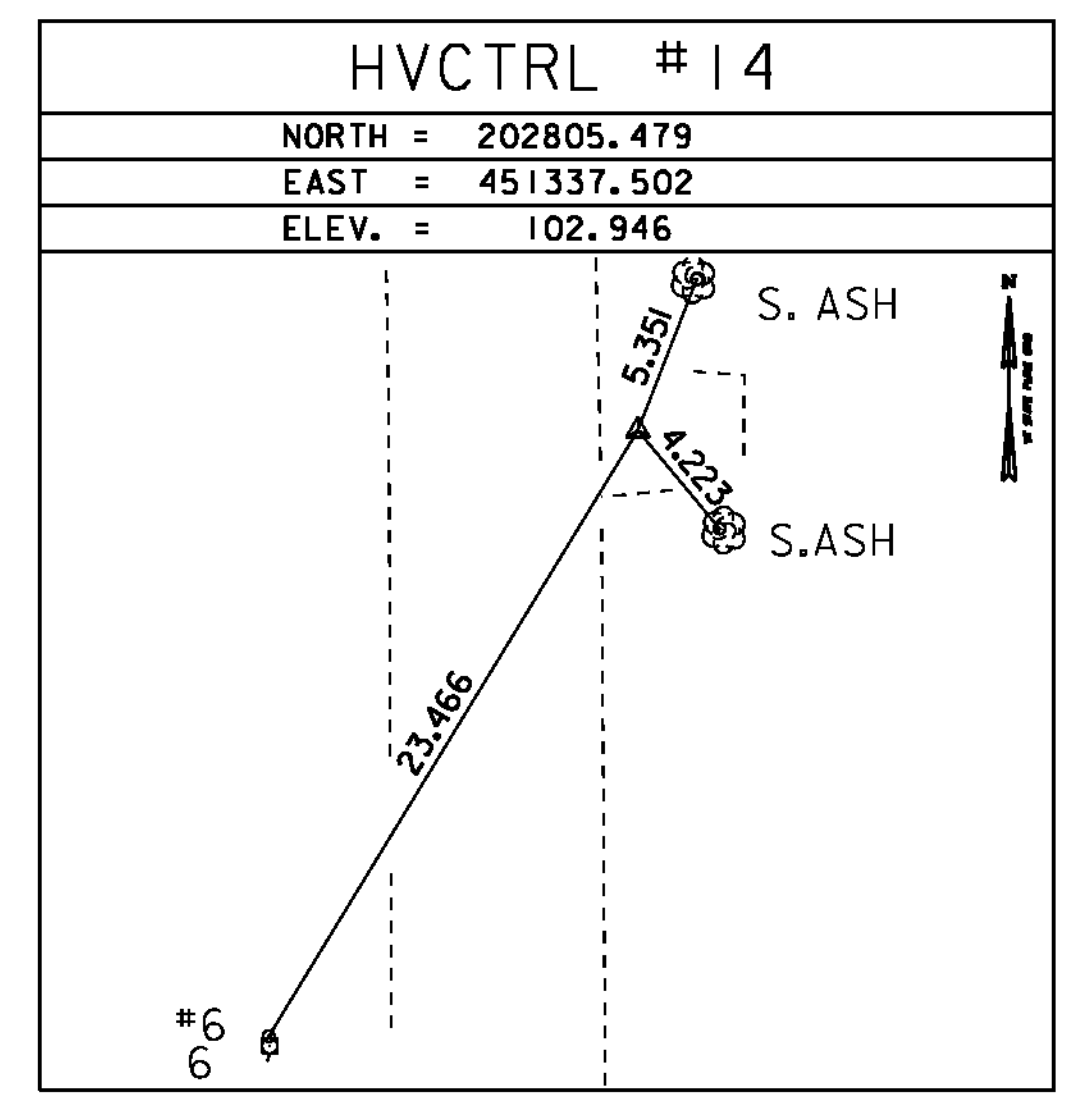
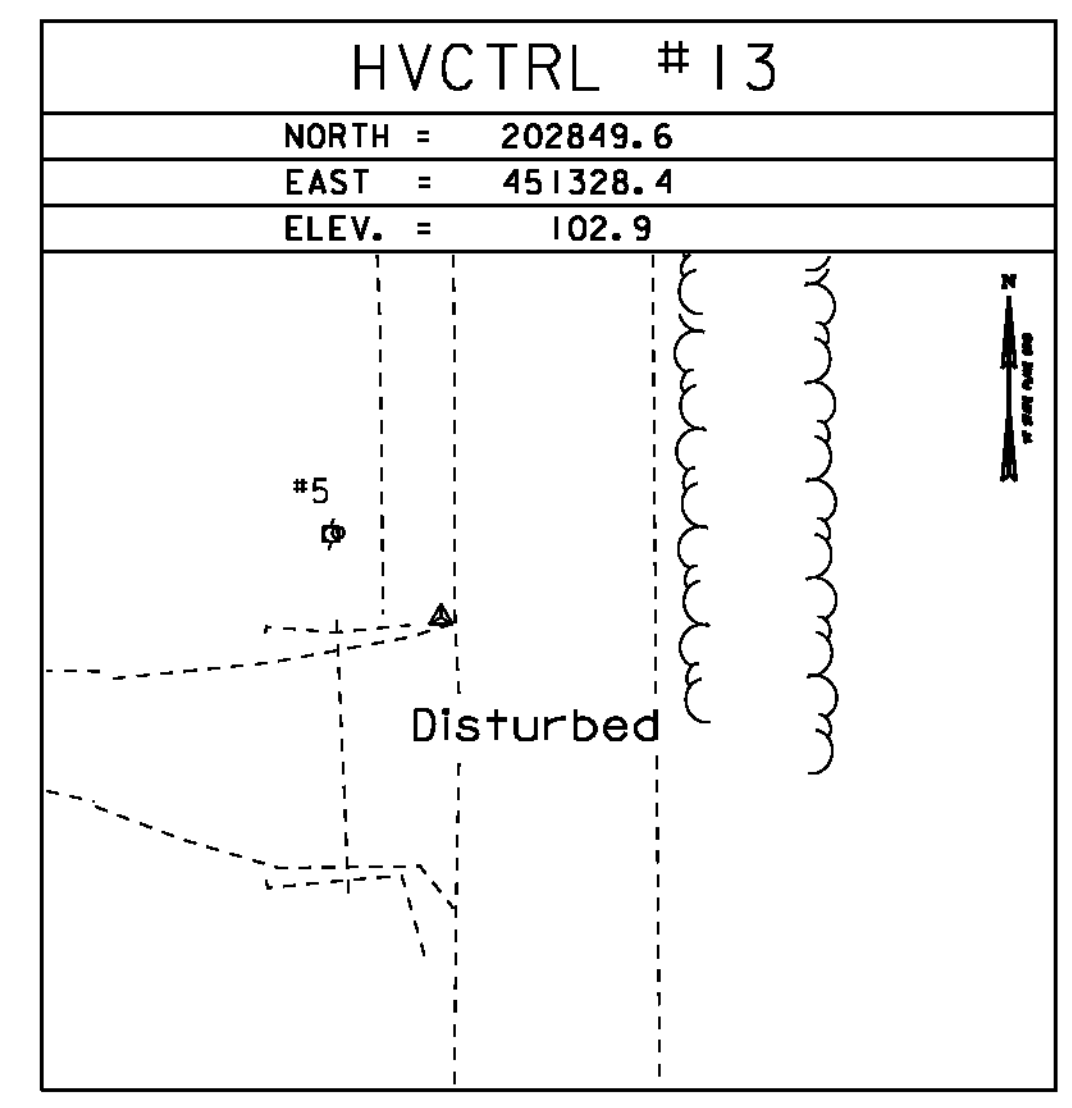
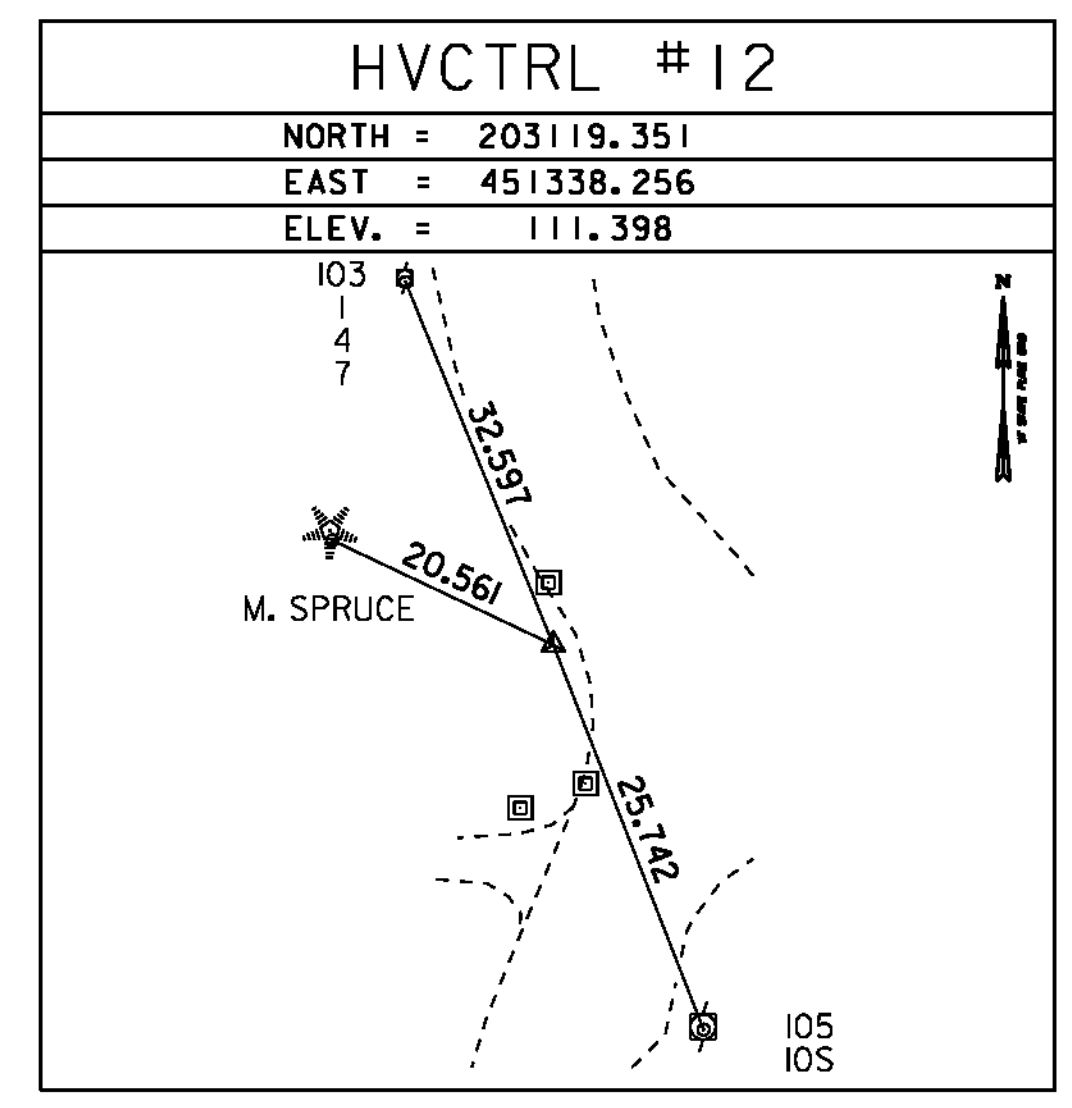


GPS CONTROL POINTS

 




Surveyed Dubois & King Unknown Origin

TRAVERSE TIES

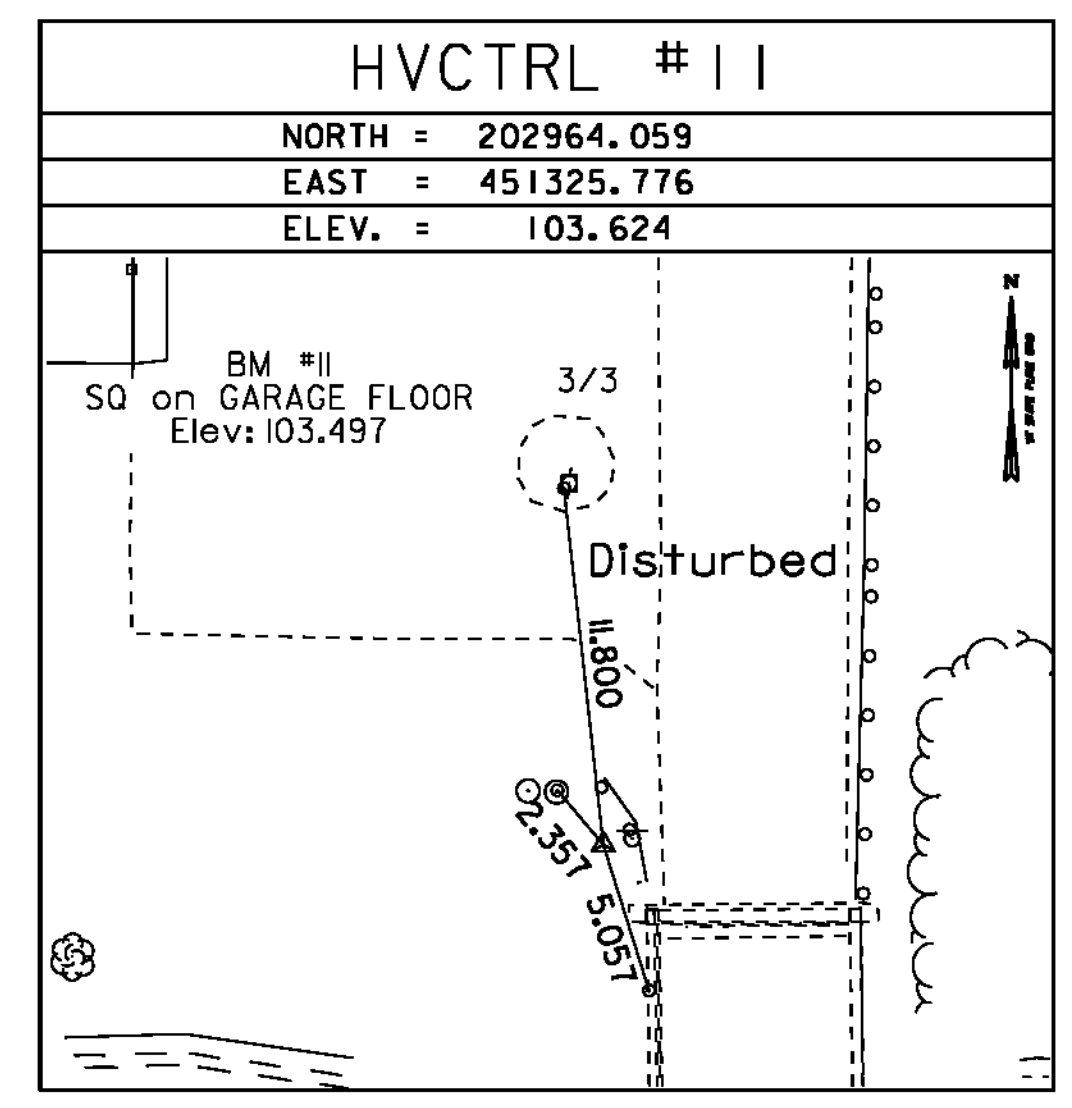

• Main Traverse DuBois & King date unknown

ALIGNMENT TIES

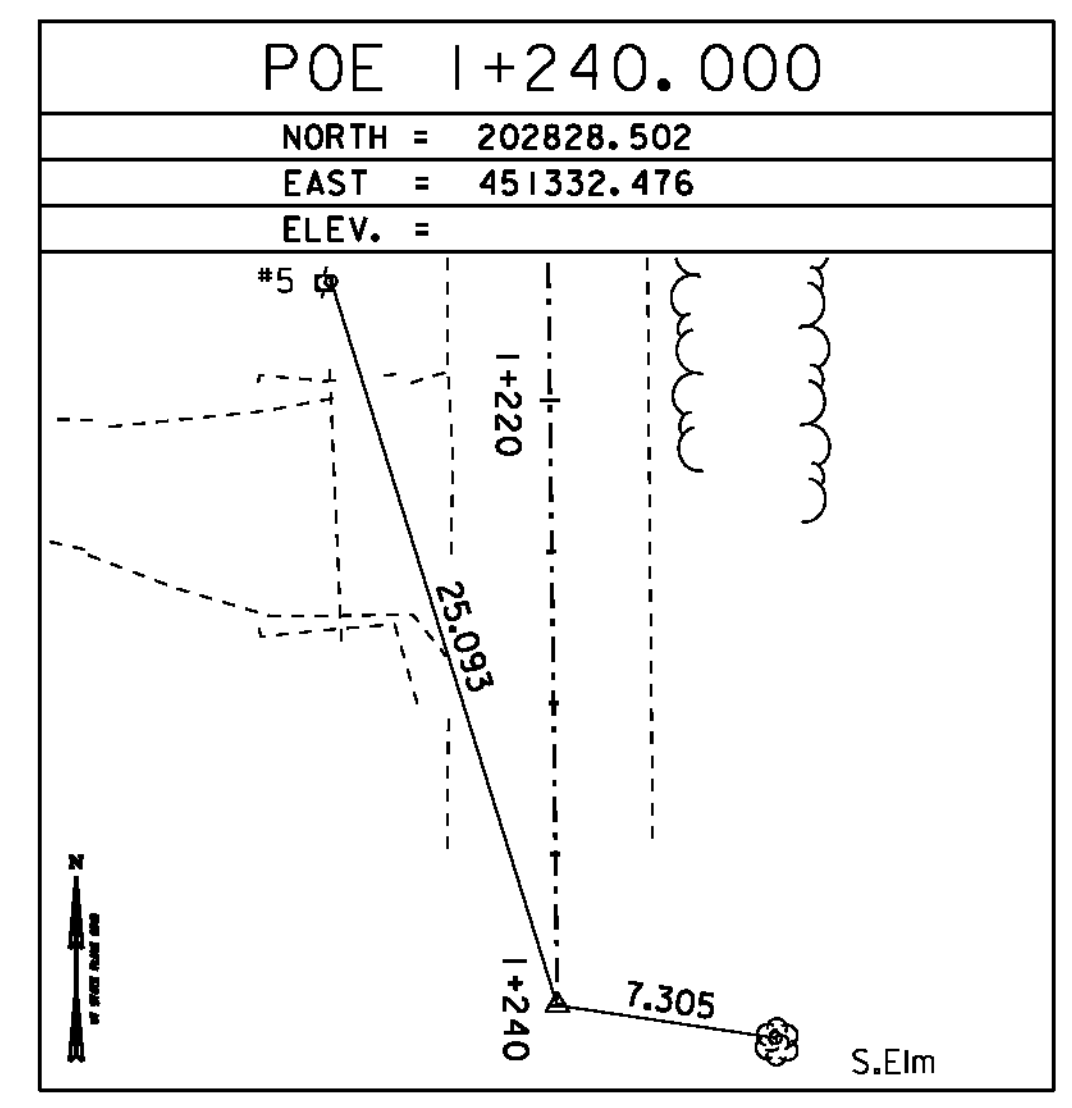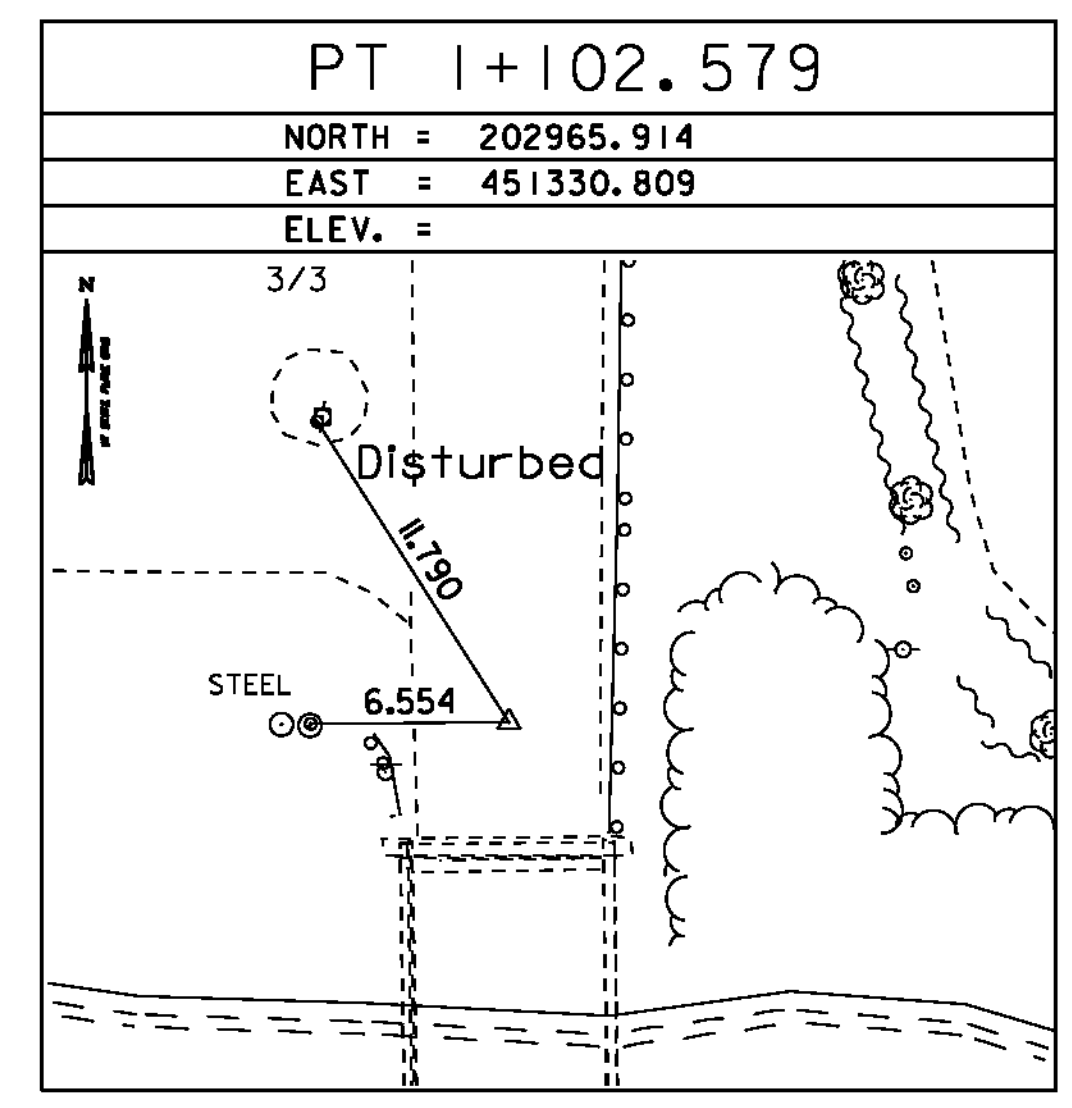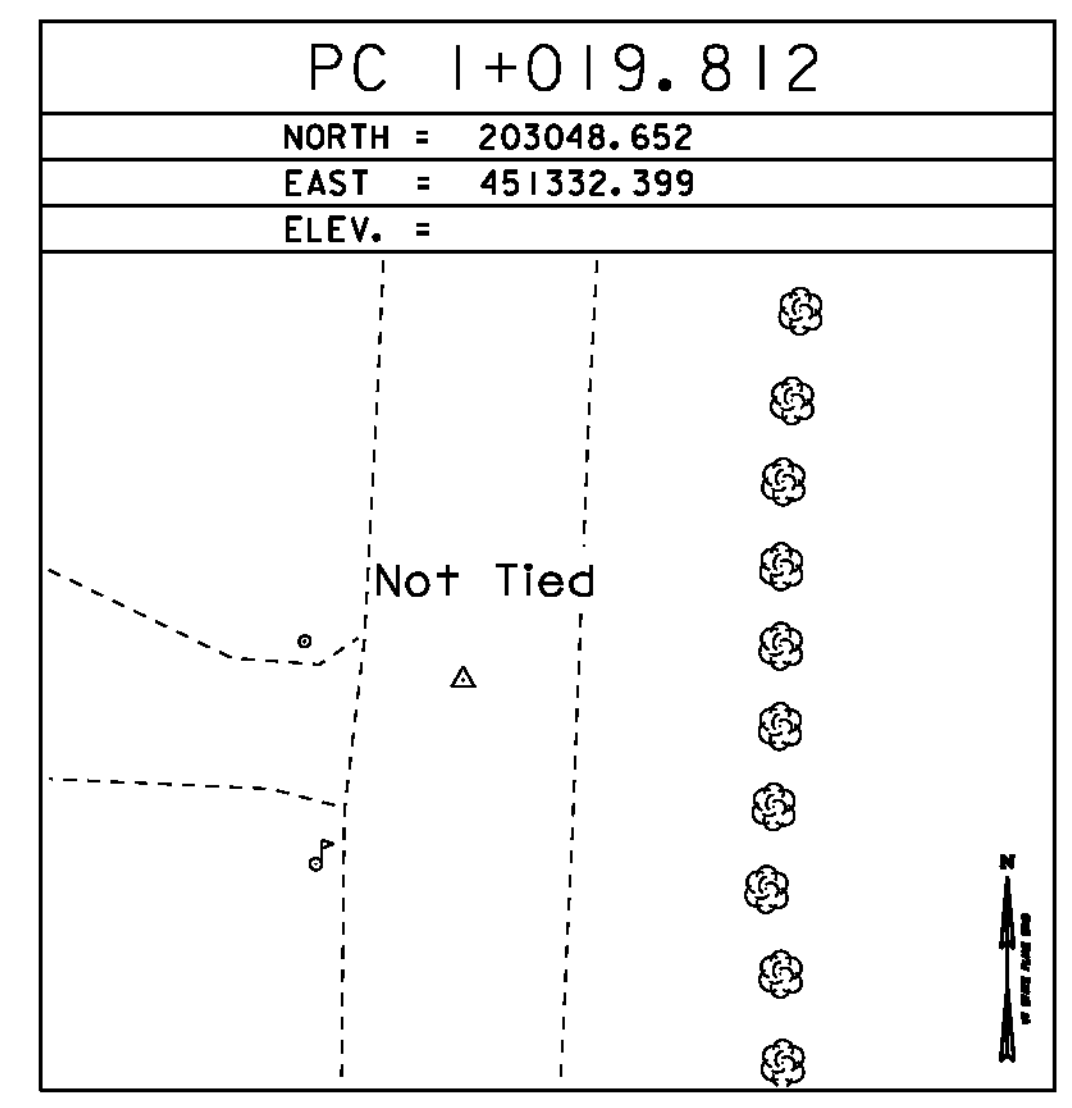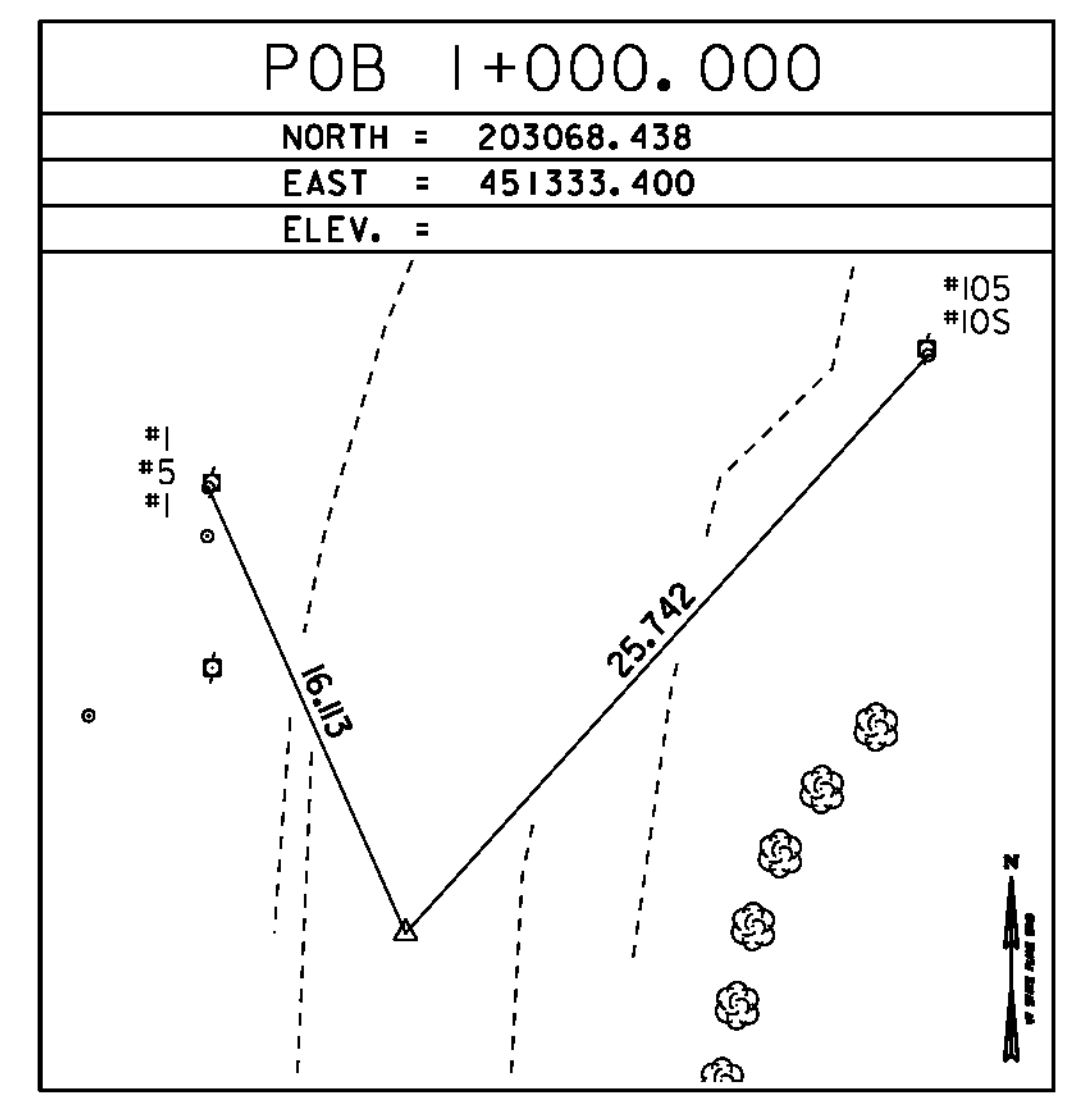

• Alignment Tied & Staked July 7, 2009 by L. ORVIS P.C. & C. CYR

DATUM
 VERTICAL Assumed
 HORIZONTAL NAD 83

PROJECT NAME: HINESBURG	
PROJECT NUMBER: STP 0199(2)	
FILE NAME: O:\282\str\s012821e.dgn	PLOT DATE: 02-MAR-2011
PROJECT LEADER: C. CARLSON	DRAWN BY: C. MOONEY
DESIGNED BY: W. LAMMER	CHECKED BY: C. CARLSON
TIE SHEET	SHEET 9 OF 56