

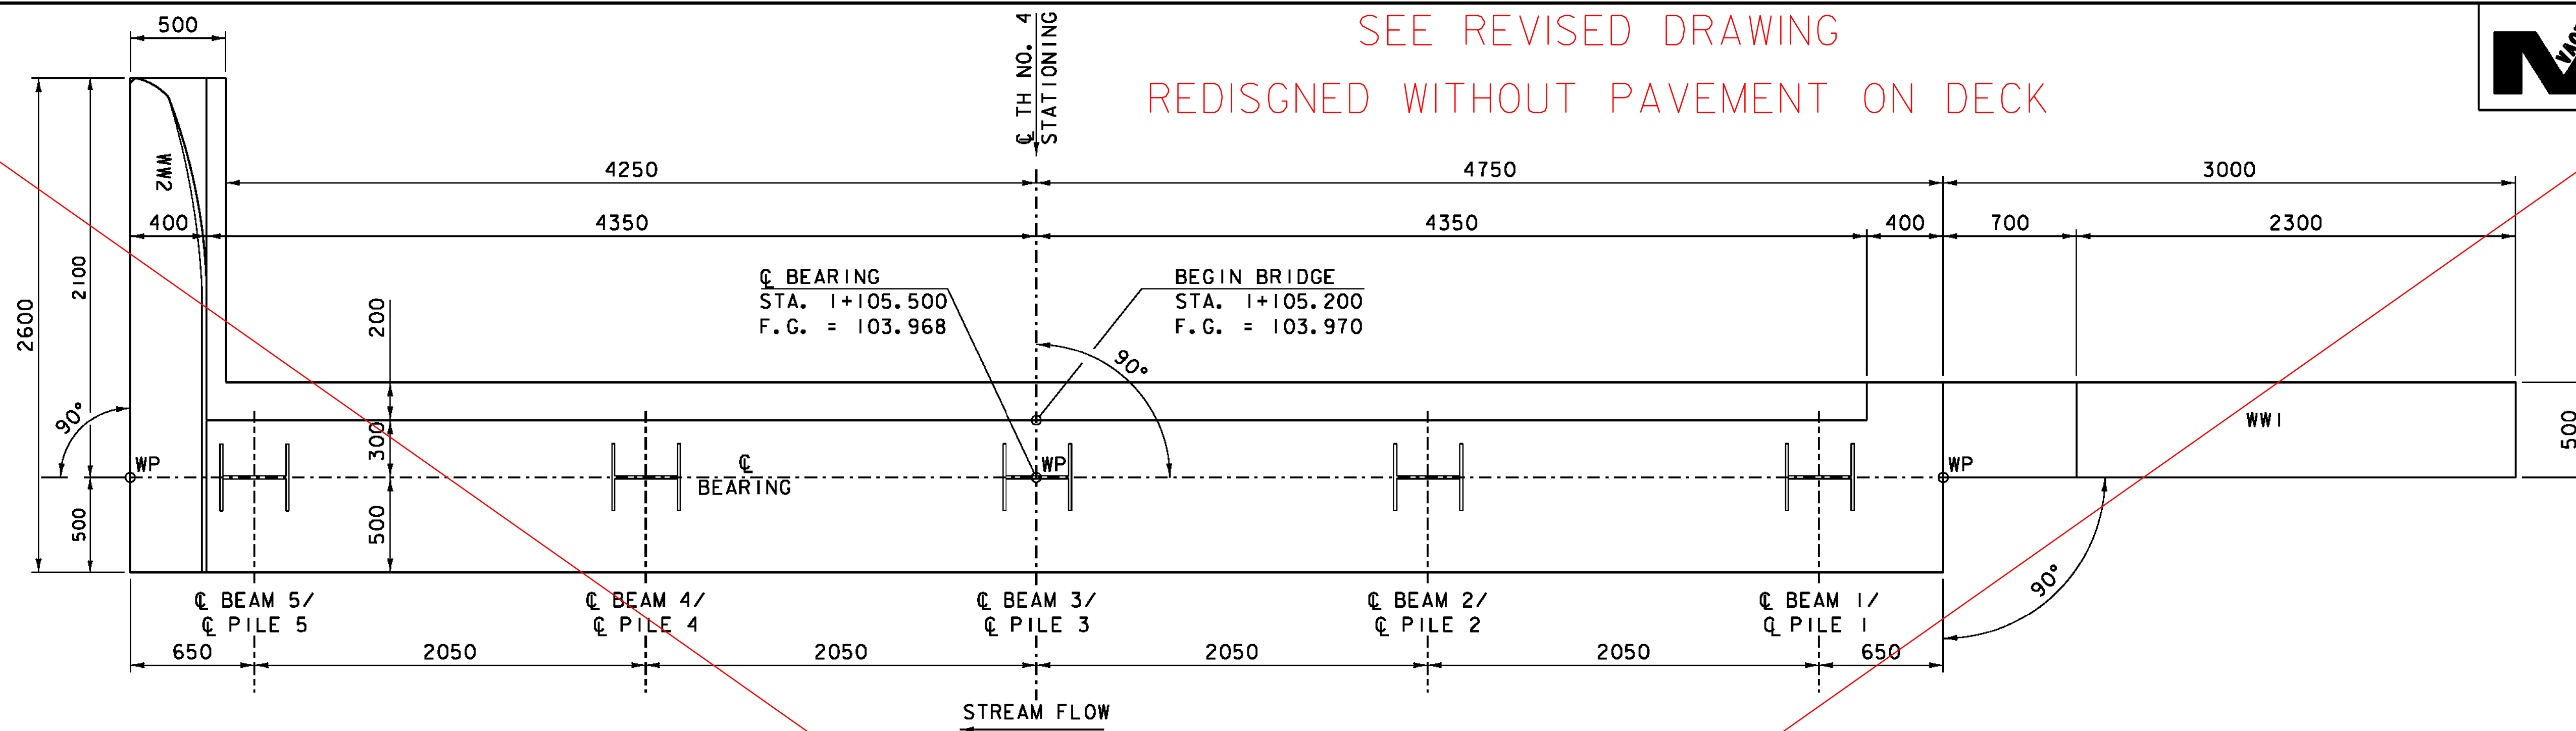



SEE REVISED DRAWING
 REDISIGNED WITHOUT PAVEMENT ON DECK

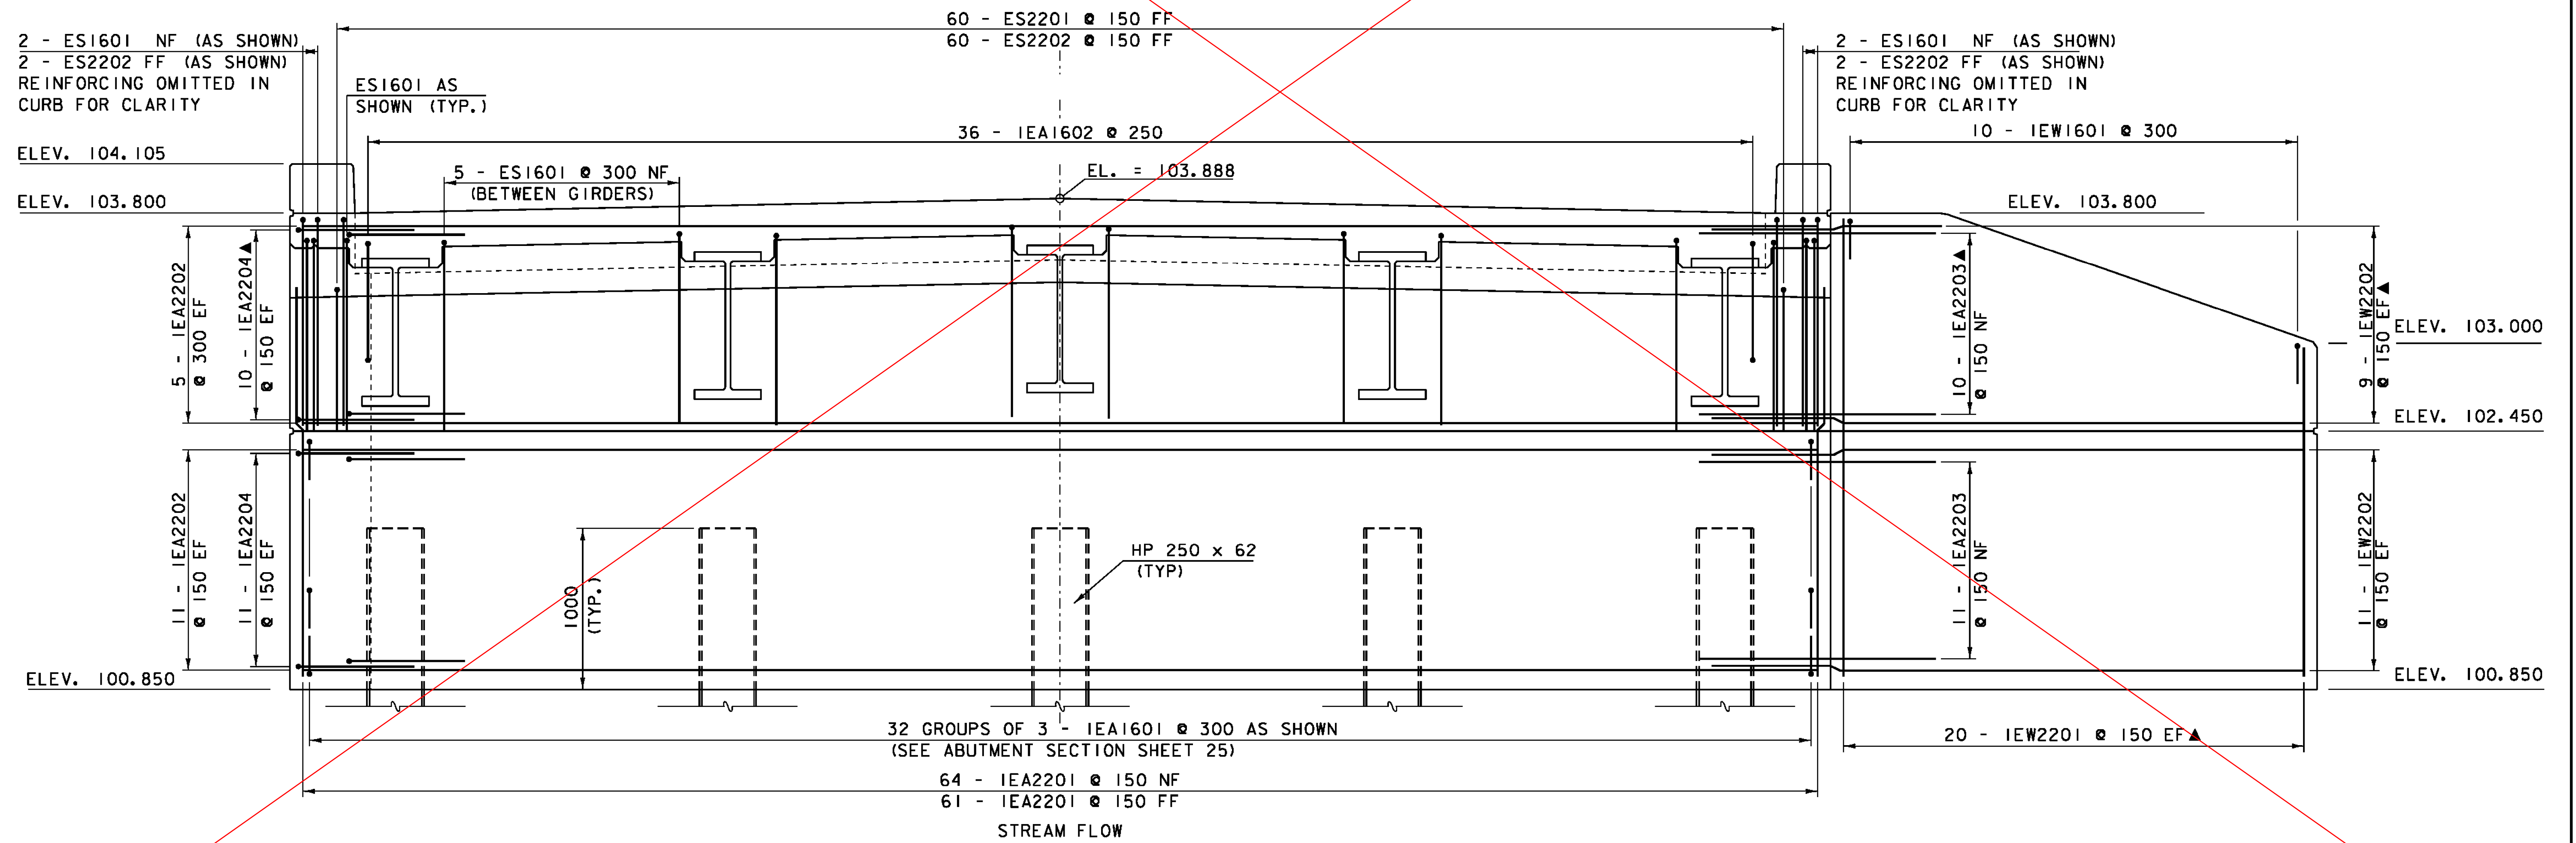

ABUTMENT NO. 1 PLAN

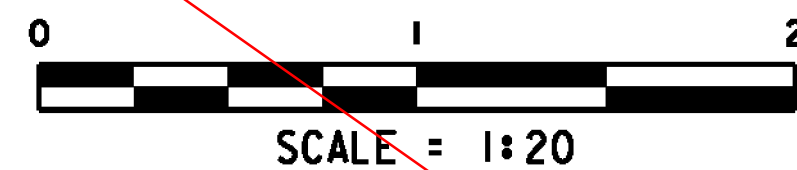

ABUTMENT NO. 1 ELEVATION

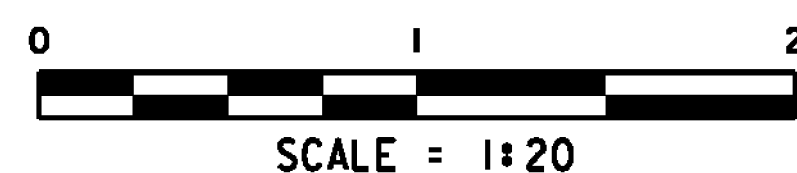

NOTES:

- NF = NEAR FACE
- FF = FAR FACE
- EF = EACH FACE
- ▲ = CUT TO FIT IN FIELD
- 80 CLR. UNLESS OTHERWISE SPECIFIED ON THE PLANS

PROJECT NAME: HINESBURG	PLOT DATE: 02-MAR-2011
PROJECT NUMBER: STP 0199(2)	DRAWN BY: C. MOONEY
FILE NAME: 01J282/str/01J282str.dgn	CHECKED BY: C. CARLSON
DESIGNED BY: W. LAMMER	ABUTMENT NO. 1 DETAILS
	SHEET 26 OF 56