



ABUTMENT NO. 1 PLAN

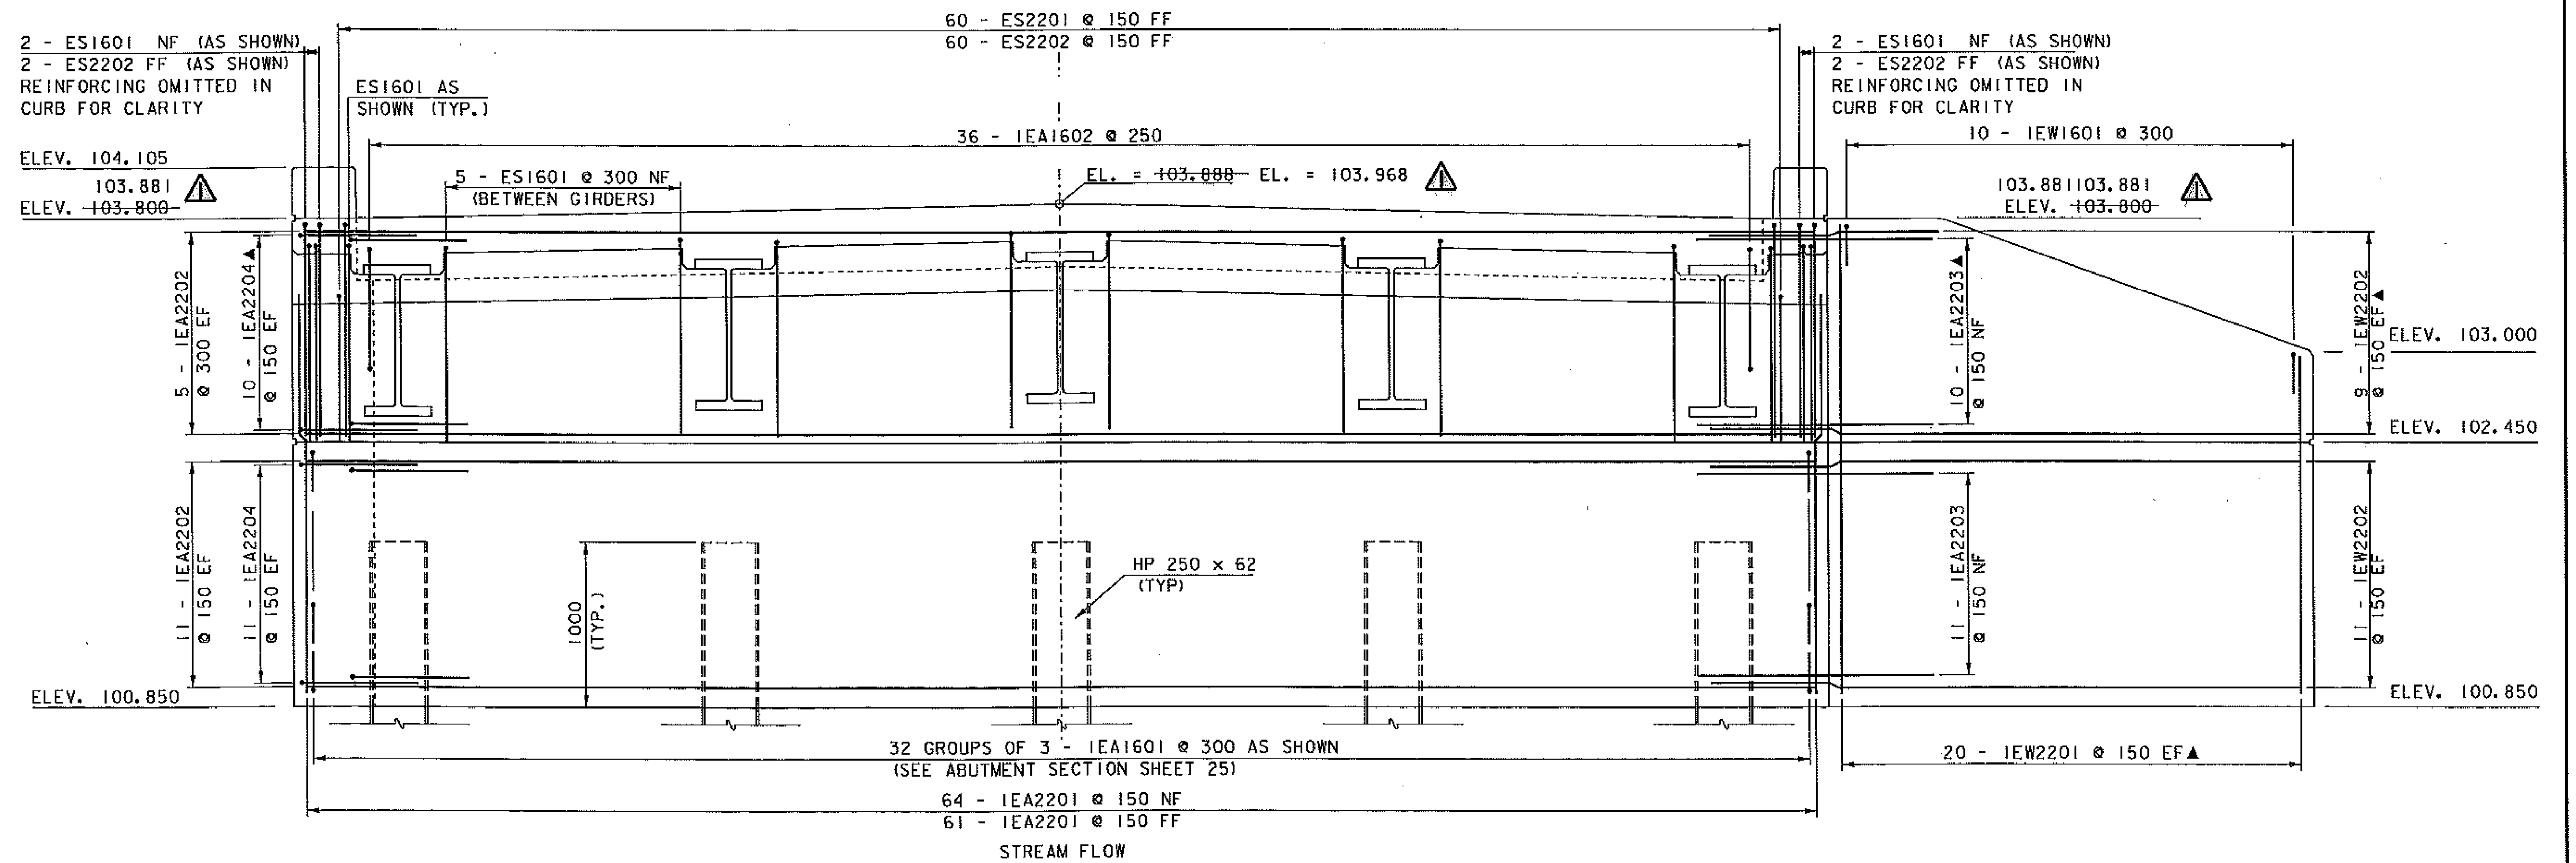

ABUTMENT NO. 1 ELEVATION

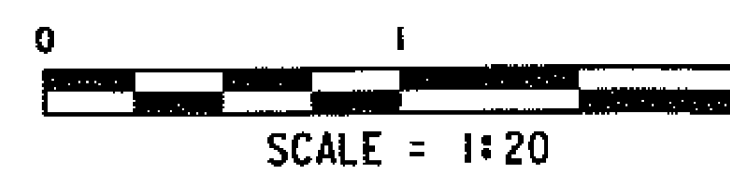

REVISION	DATE
▲	REMOVED PAVEMENT FROM DECK 9-5-2011

NOTES:
 NF = NEAR FACE
 FF = FAR FACE
 EF = EACH FACE
 ▲ = CUT TO FIT IN FIELD
 80 CLR. UNLESS OTHERWISE SPECIFIED ON THE PLANS

PROJECT NAME: HINESBURG
 PROJECT NUMBER: STP 0199(2)
 FILE NAME: 01J282/str/01J282str.dgn
 PROJECT LEADER: C. CARLSON
 DESIGNED BY: W. LAMMER
 ABUTMENT NO. 1 DETAILS

PLOT DATE: 06-SEP-2011
 DRAWN BY: C. MOONEY
 CHECKED BY: C. CARLSON
 SHEET 26 R OF 56