

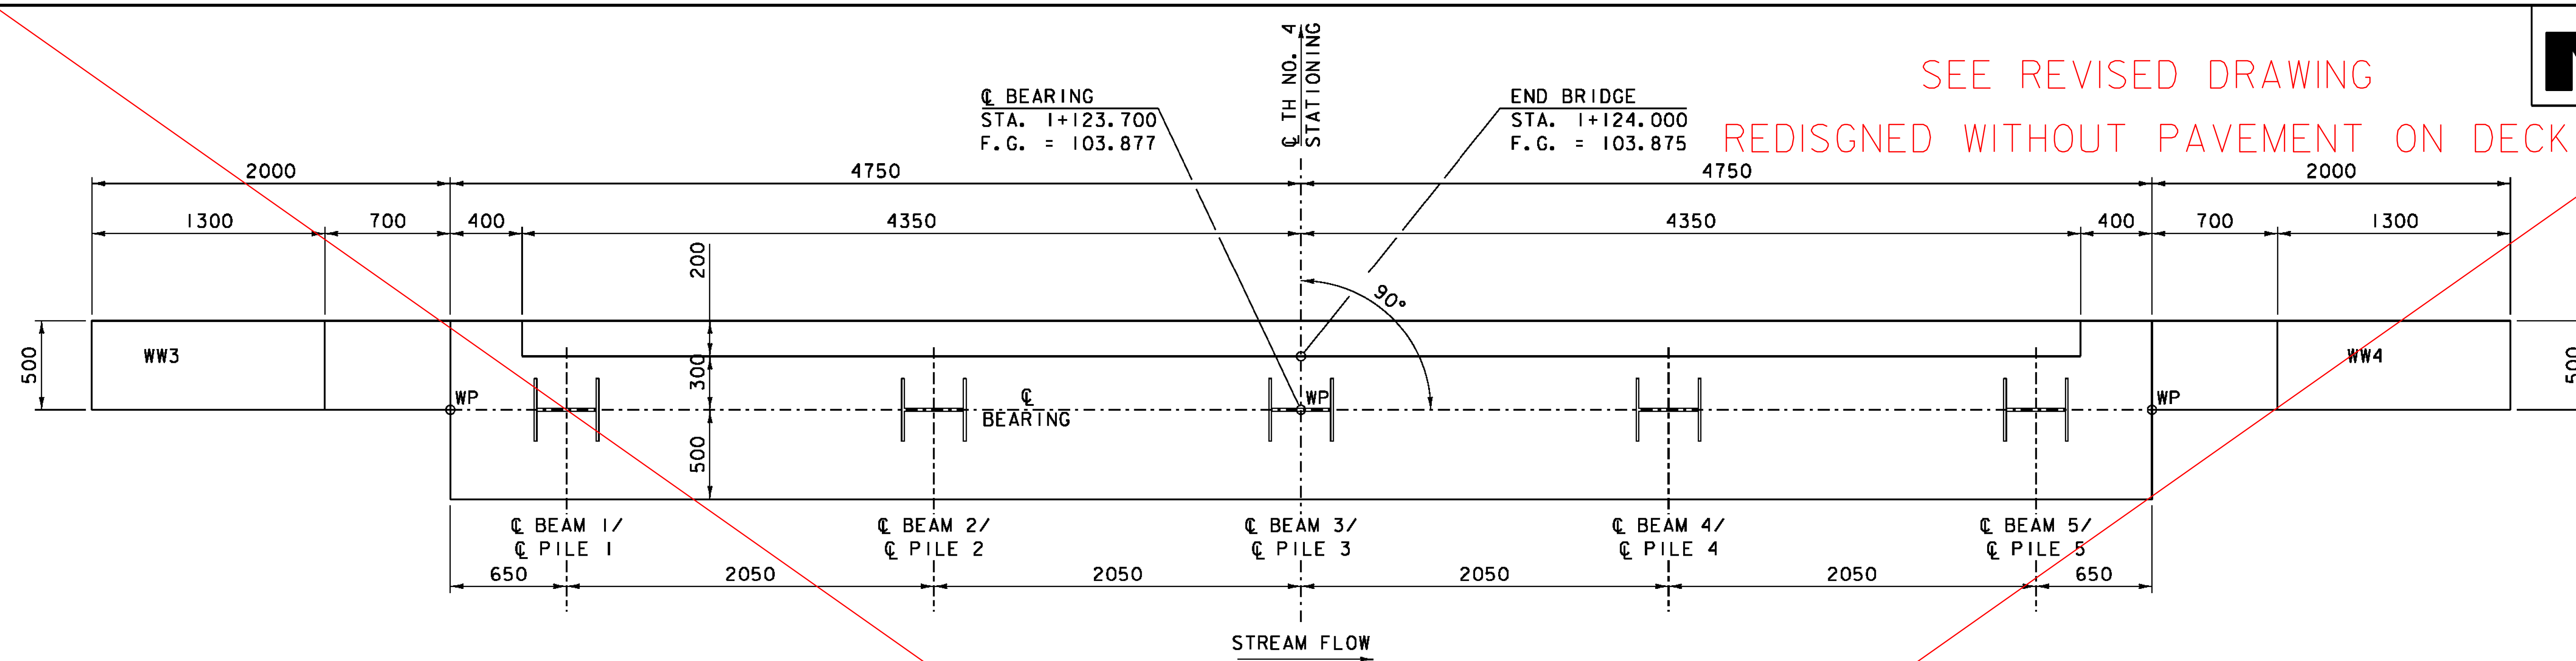



SEE REVISED DRAWING
 REDISIGNED WITHOUT PAVEMENT ON DECK

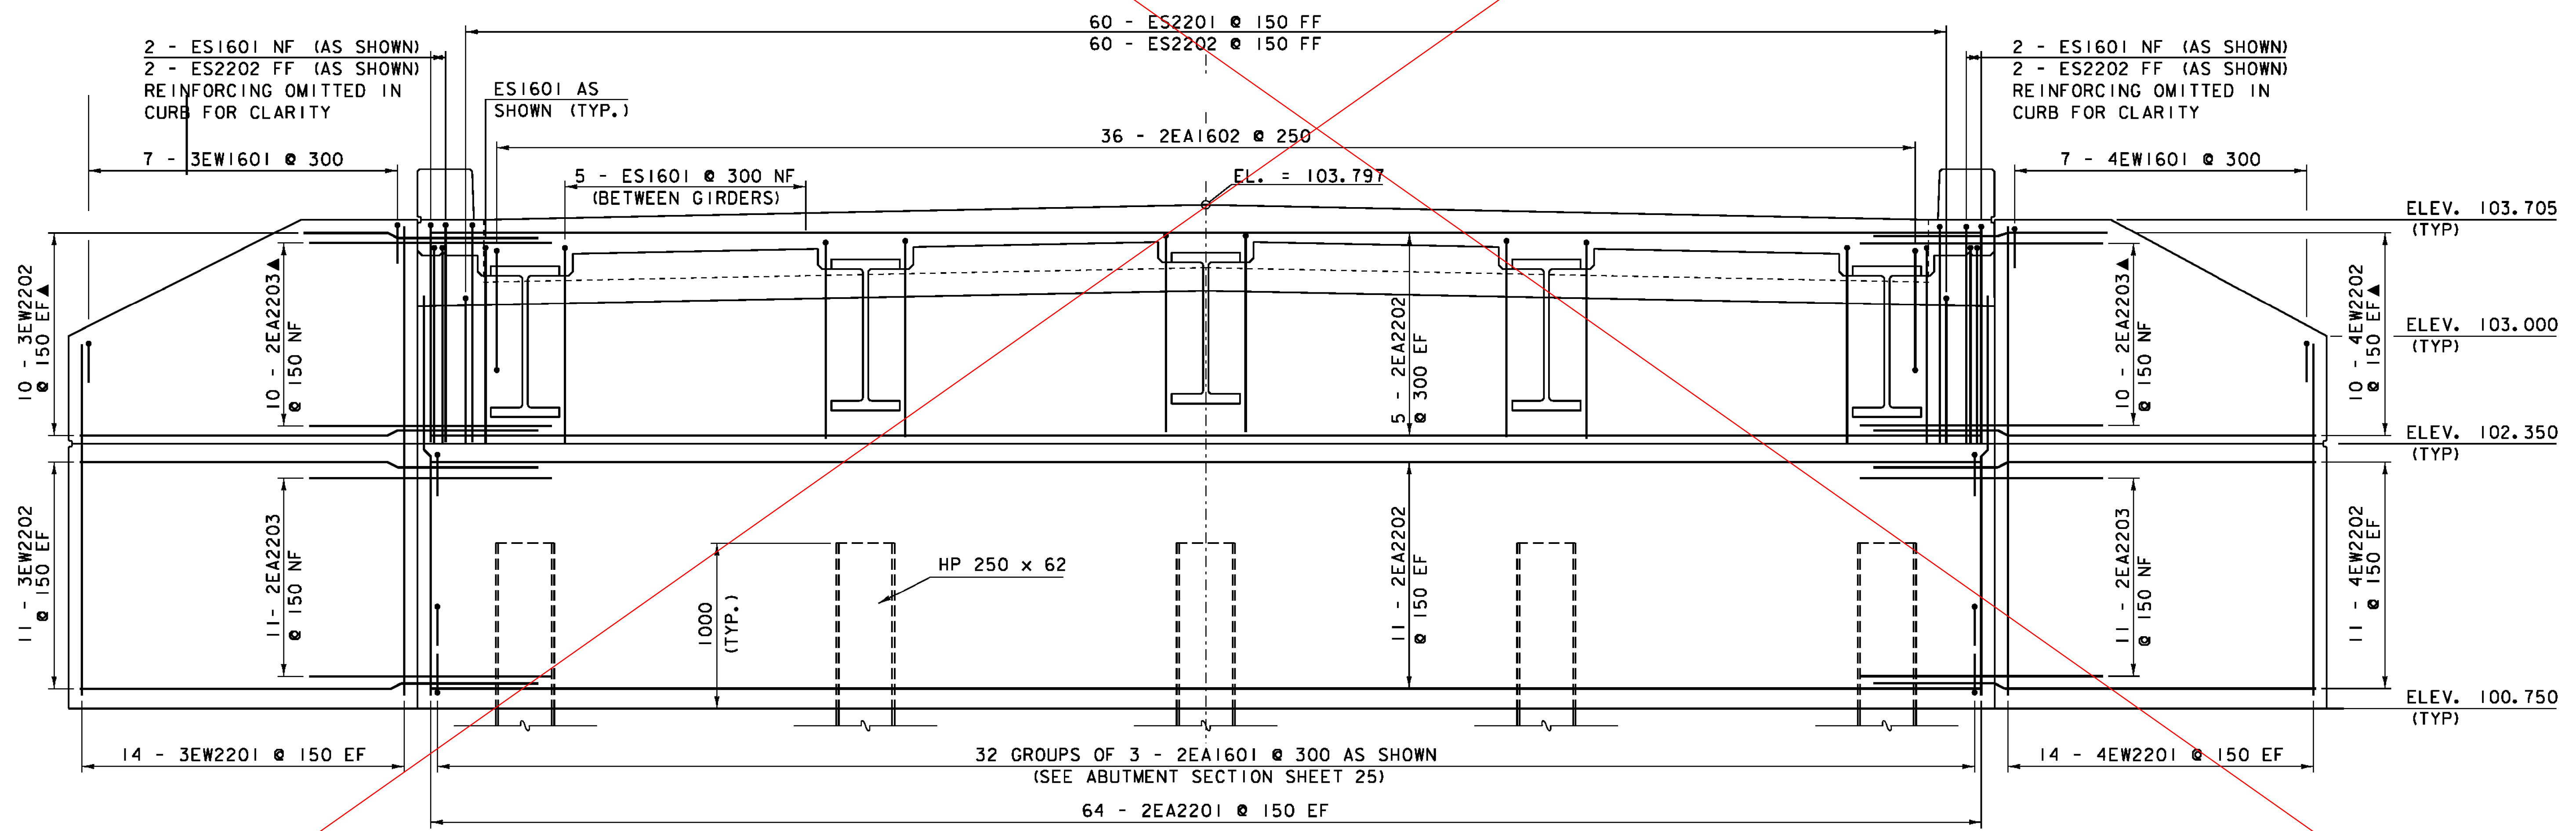

ABUTMENT NO. 2 PLAN

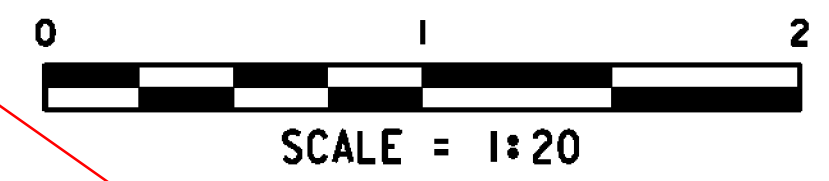

ABUTMENT NO. 2 ELEVATION

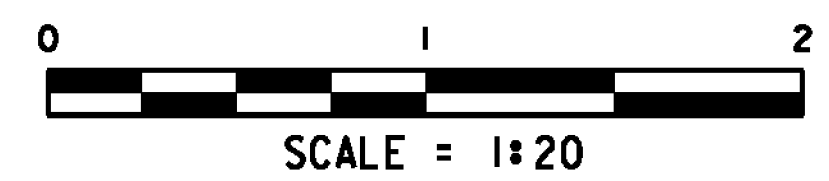

NOTES:
 NF = NEAR FACE
 FF = FAR FACE
 EF = EACH FACE
 ▲ = CUT TO FIT IN FIELD
 80 CLR. UNLESS OTHERWISE SPECIFIED ON THE PLANS

PROJECT NAME: HINESBURG	PLOT DATE: 02-MAR-2011
PROJECT NUMBER: STP 0199(2)	DRAWN BY: C. MOONEY
FILE NAME: 01J282/str/s01J282str.dgn	CHECKED BY: C. CARLSON
PROJECT LEADER: C. CARLSON	DESIGNED BY: W. LAMMER
ABUTMENT NO. 2 DETAILS	SHEET 27 OF 56