


ABUTMENT NO. 2 PLAN



SCALE = 1:20

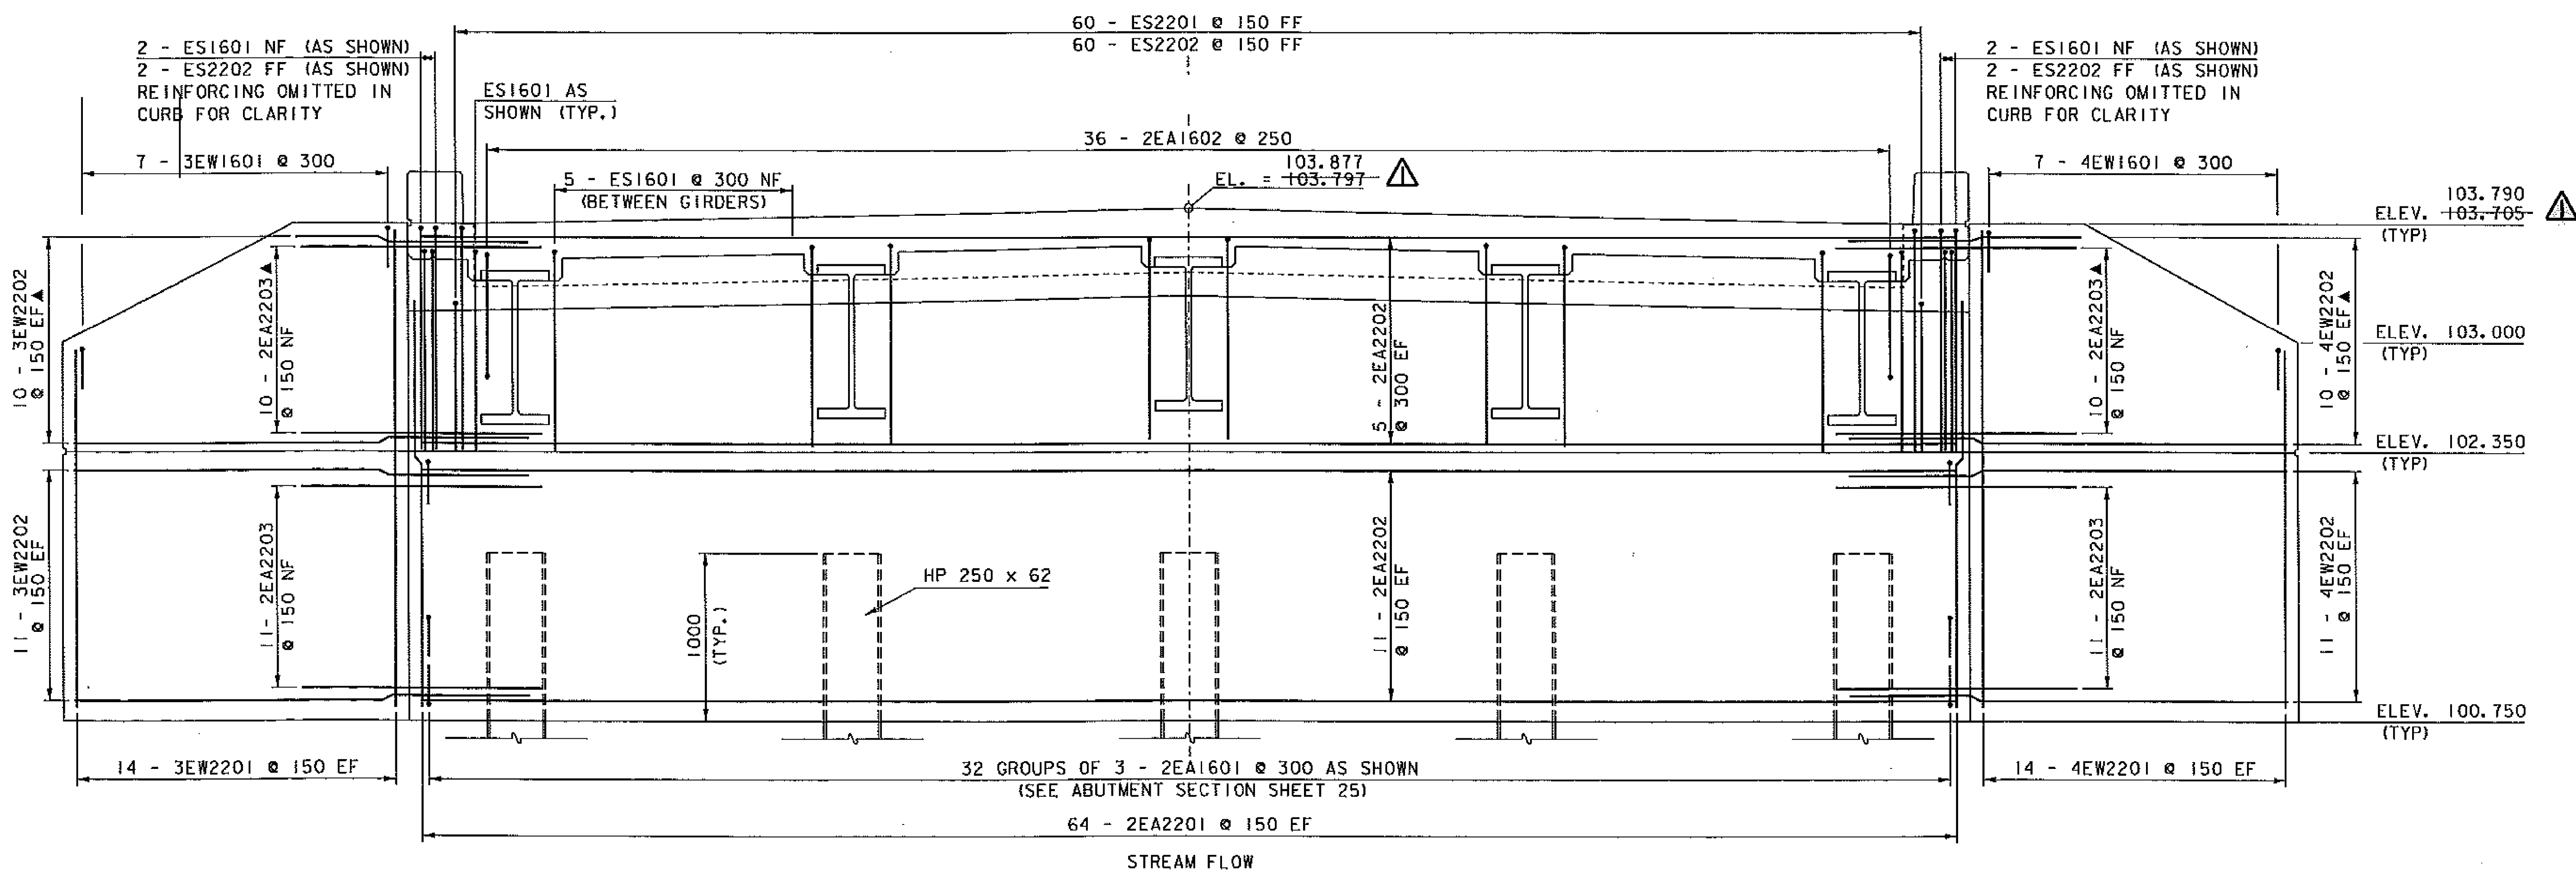

ABUTMENT NO. 2 ELEVATION



SCALE = 1:20

REVISION	DATE
△	REMOVED PAVEMENT FROM DECK 9-5-2011

NOTES:

NF = NEAR FACE
 FF = FAR FACE
 EF = EACH FACE
 ▲ = CUT TO FIT IN FIELD
 80 CLR. UNLESS OTHERWISE SPECIFIED ON THE PLANS

PROJECT NAME: HINESBURG
 PROJECT NUMBER: STP 0199(2)

FILE NAME: 01J282/str/s01J282str.dgn
 PROJECT LEADER: C. CARLSON
 DESIGNED BY: W. LAMMER
 ABUTMENT NO. 2 DETAILS
 PLOT DATE: 06-SEP-2011
 DRAWN BY: C. MOONEY
 CHECKED BY: C. CARLSON
 SHEET 27 R OF 56