




NOTE:  
EXISTING CULVERT TYPES, SIZES,  
AND FLOW LINE ELEVATIONS TO BE  
VERIFIED IN THE FIELD

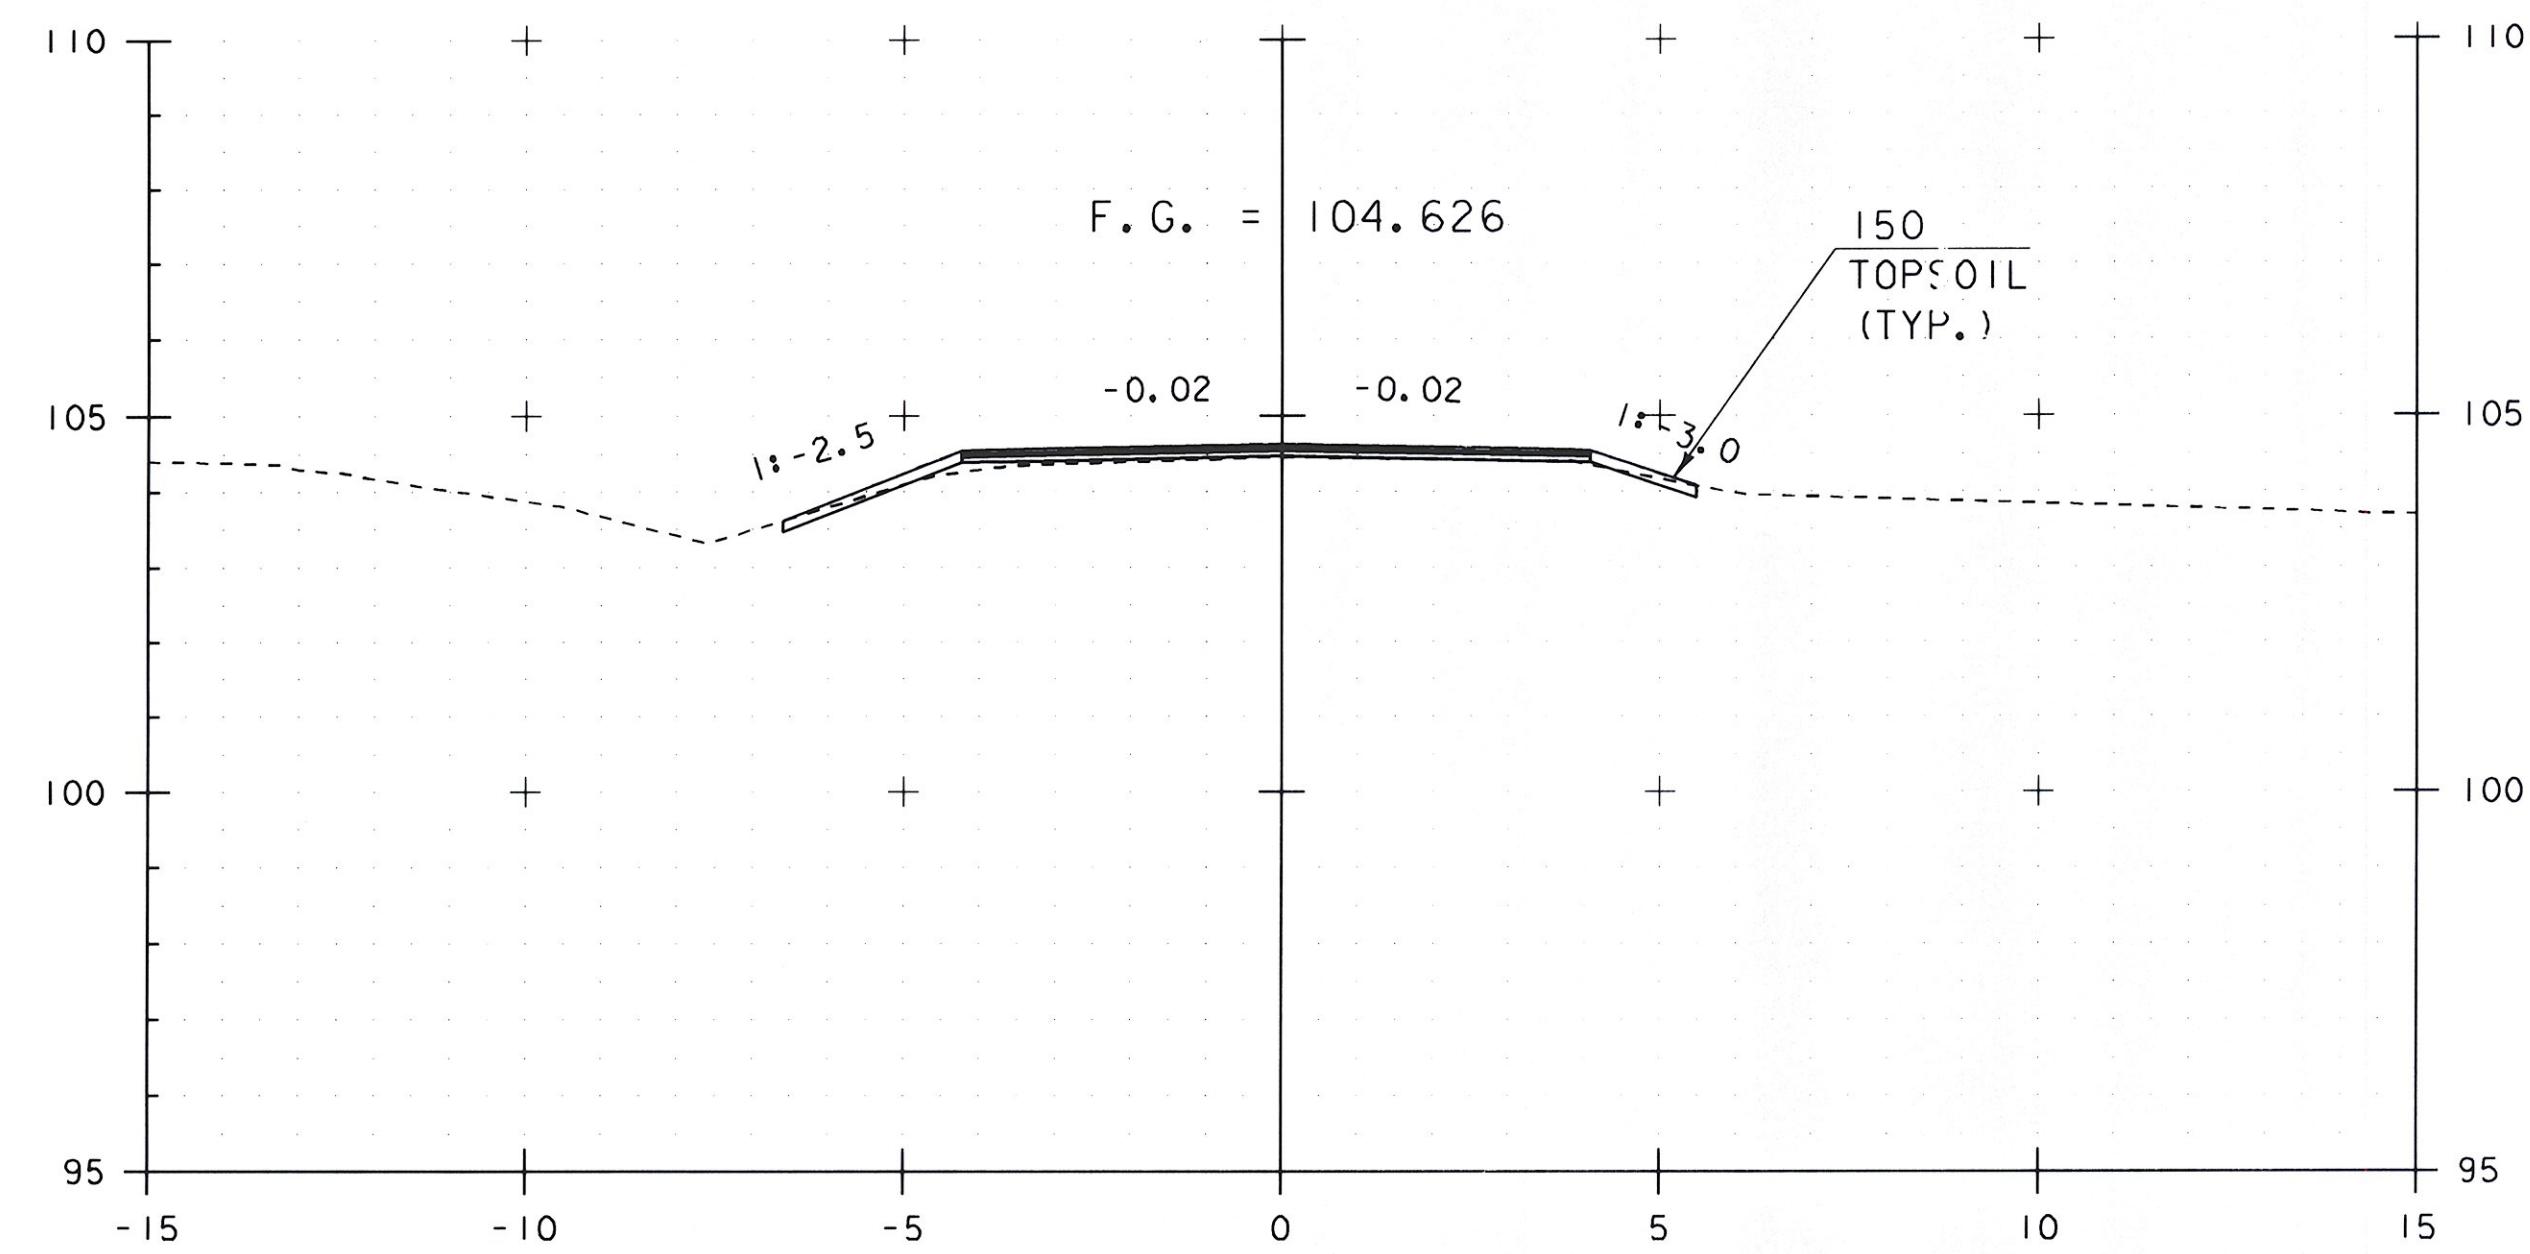

1+060.00

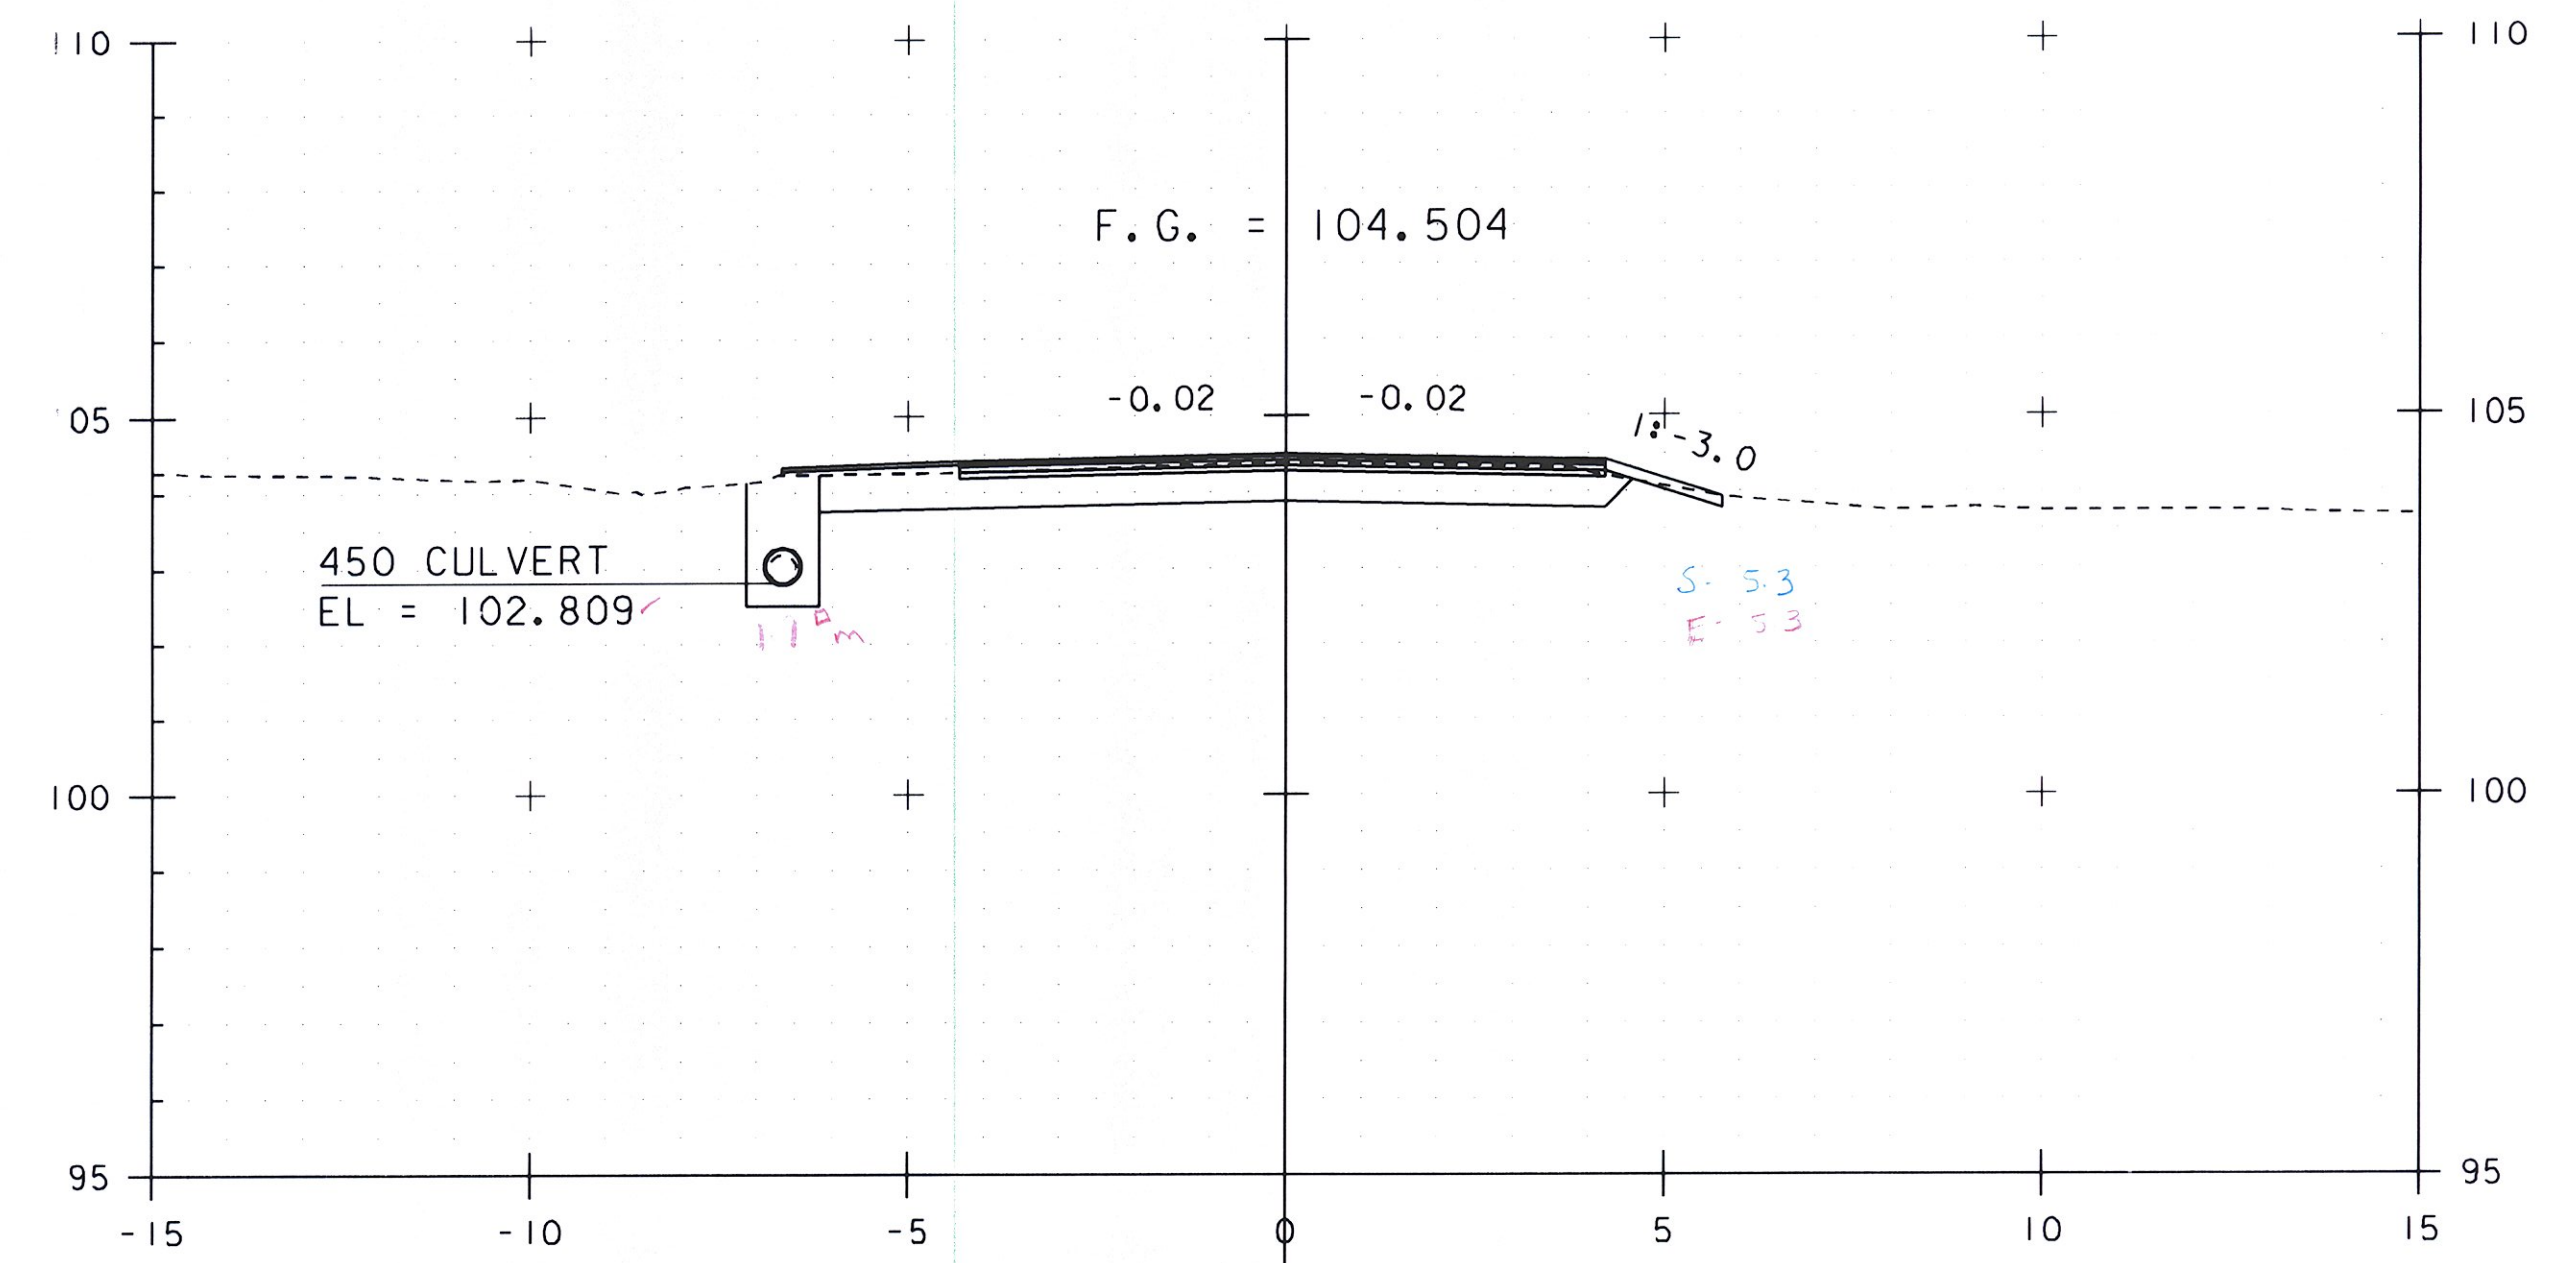


1+065.00

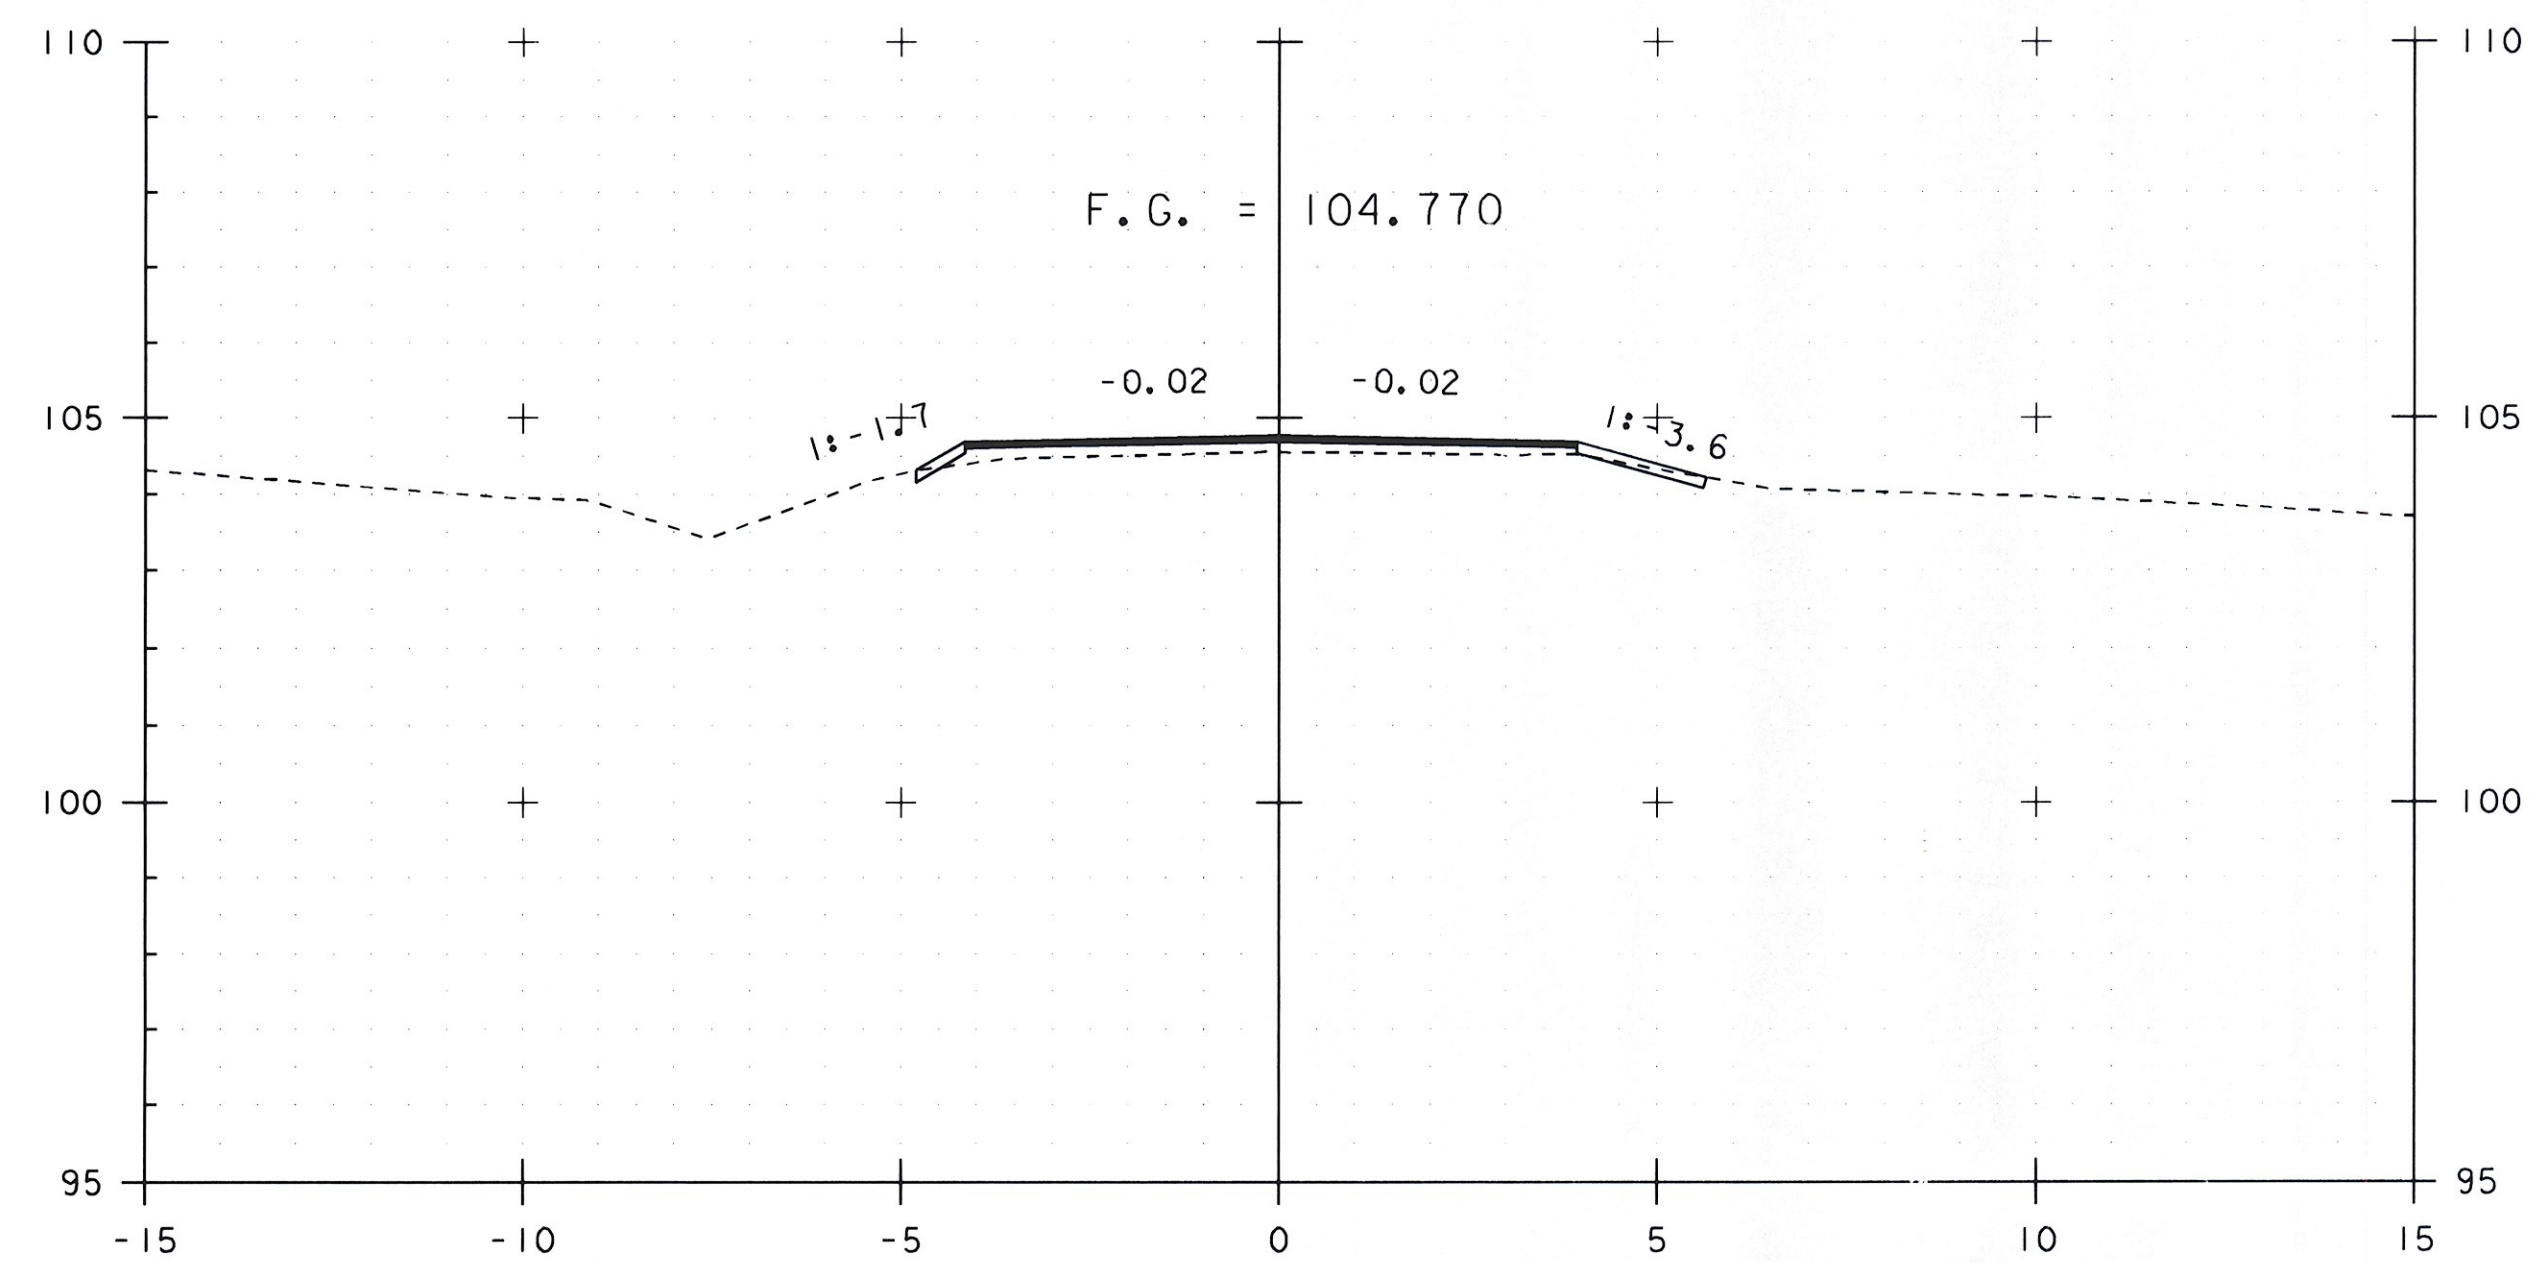


1+055.00

STA 1+050.000  
BEGIN APPROACH  
MATCH EXISTING

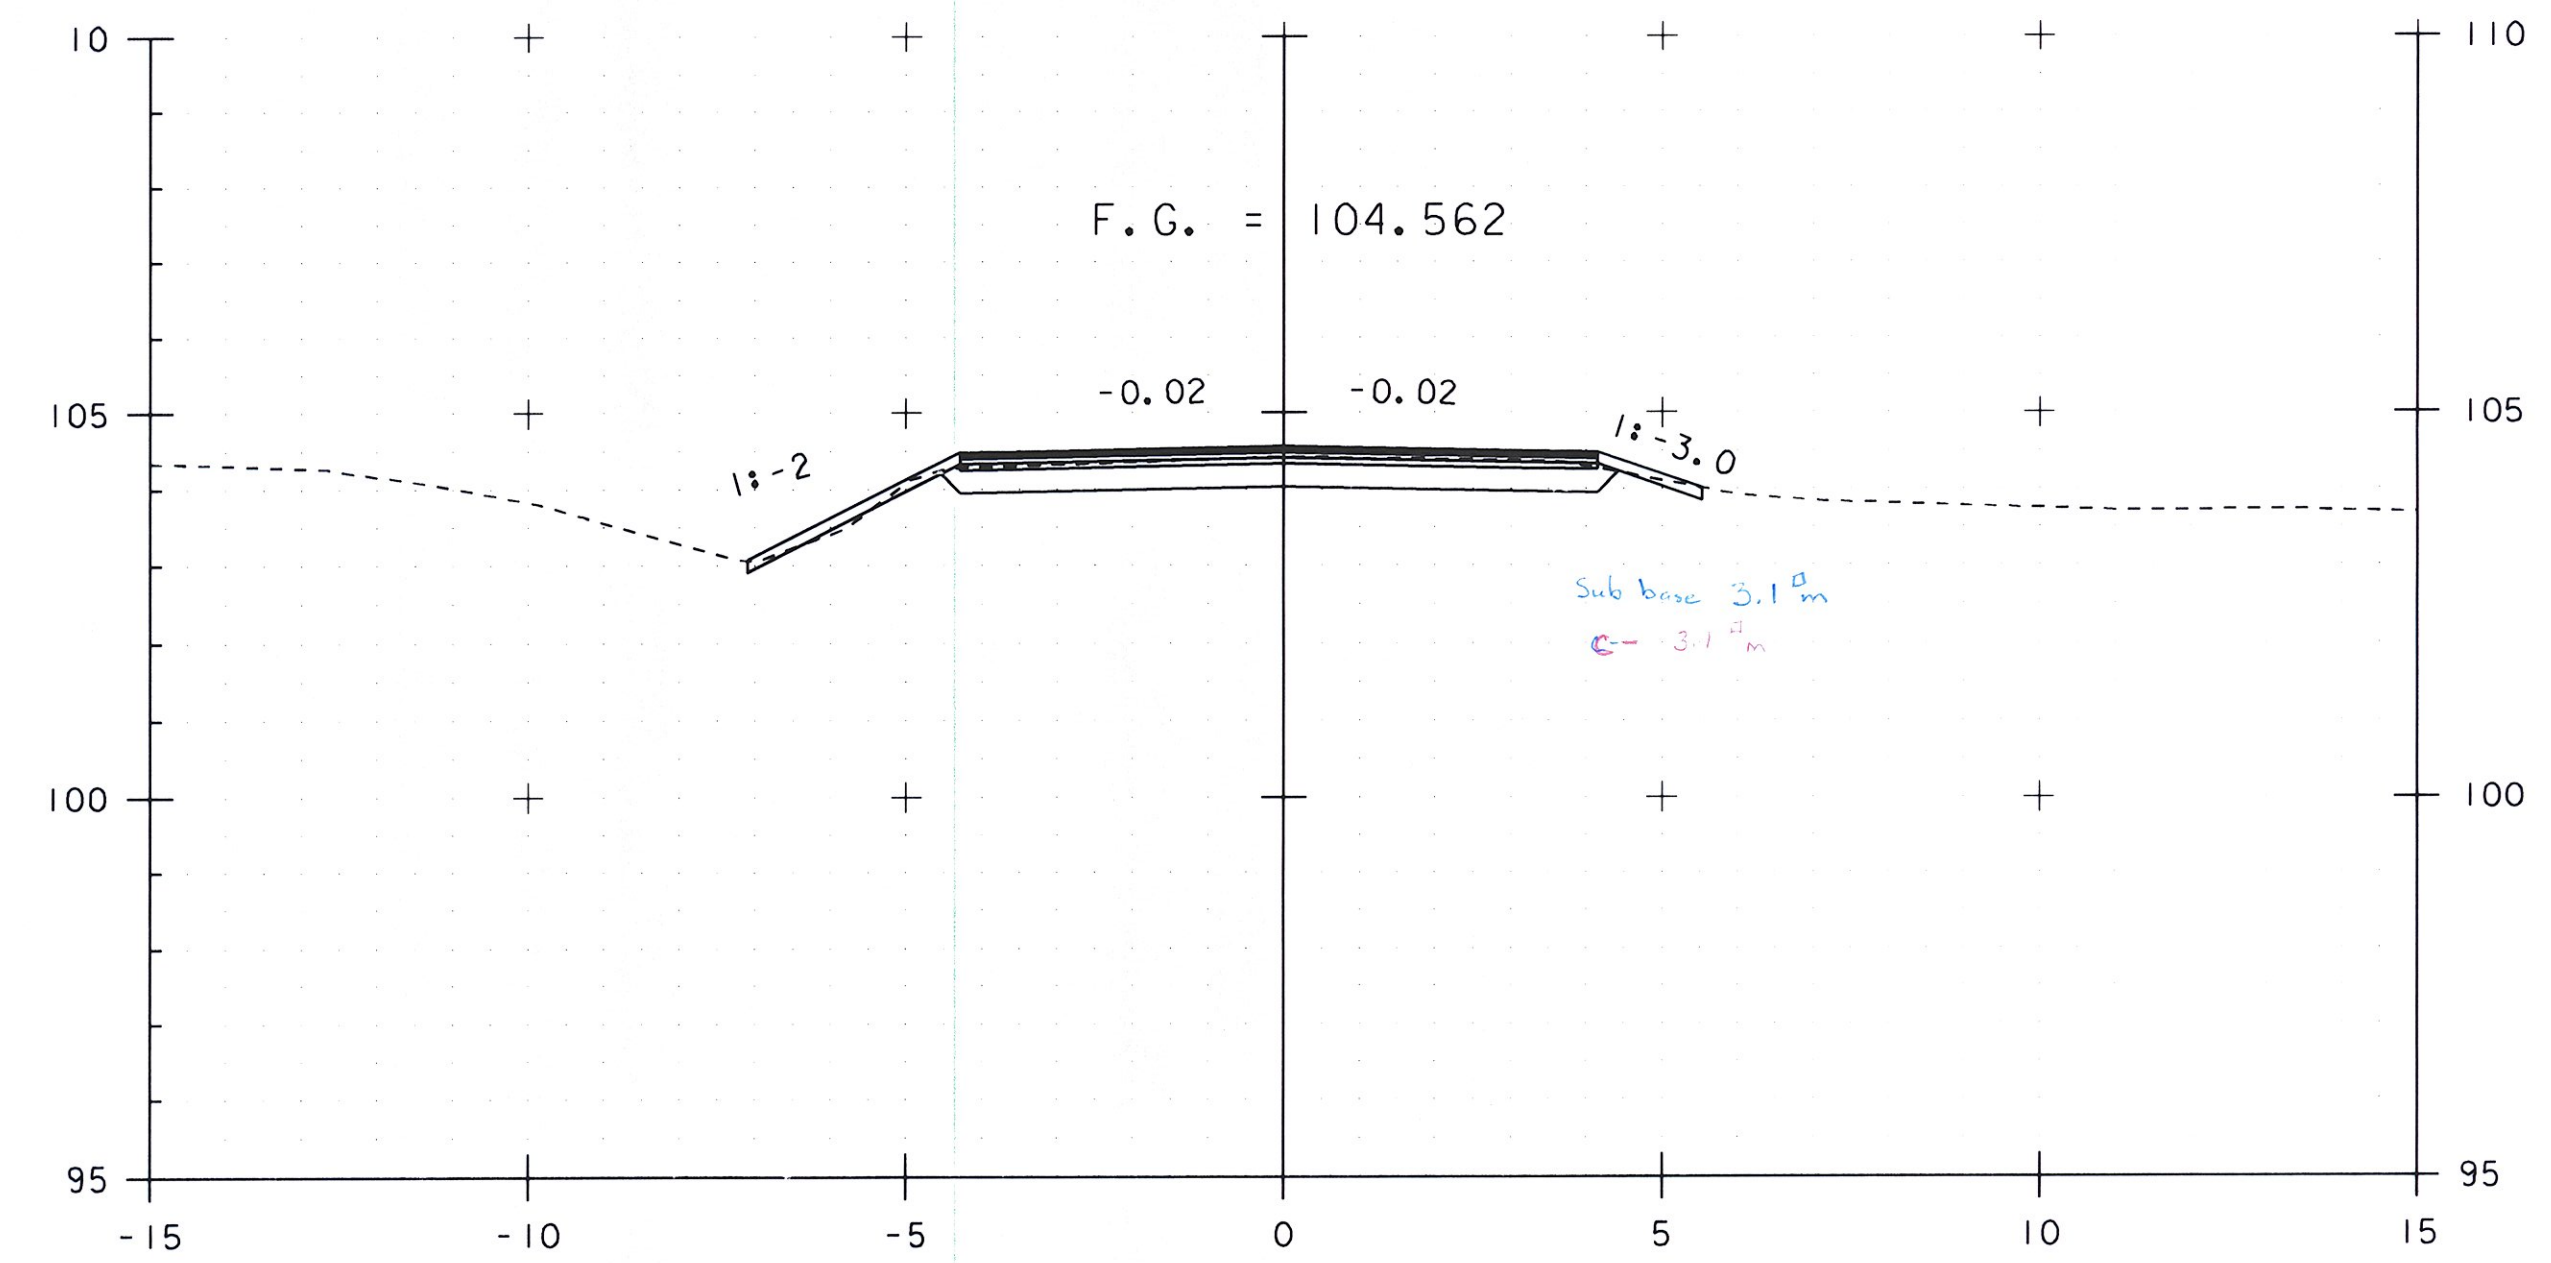

1+062.50

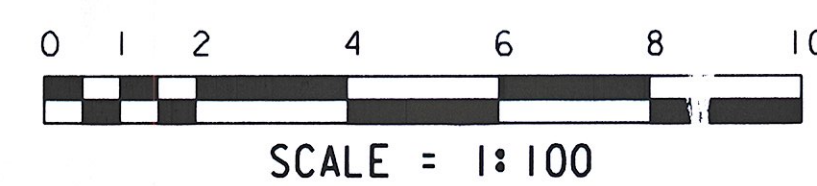

STA. 1+055 TO STA. 1+065

PROJECT NAME: HINESBURG  
PROJECT NUMBER: STP 0199(2)

FILE NAME: 01J282/str/s01J282xsl.dgn  
PROJECT LEADER: C. CARLSON  
DESIGNED BY: W. LAMMER  
MAINLINE SECTIONS SHEET 1

PLOT DATE: 02-MAR-2011  
DRAWN BY: C. MOONEY  
CHECKED BY: C. CARLSON  
SHEET 35 OF 56