




1+177.50

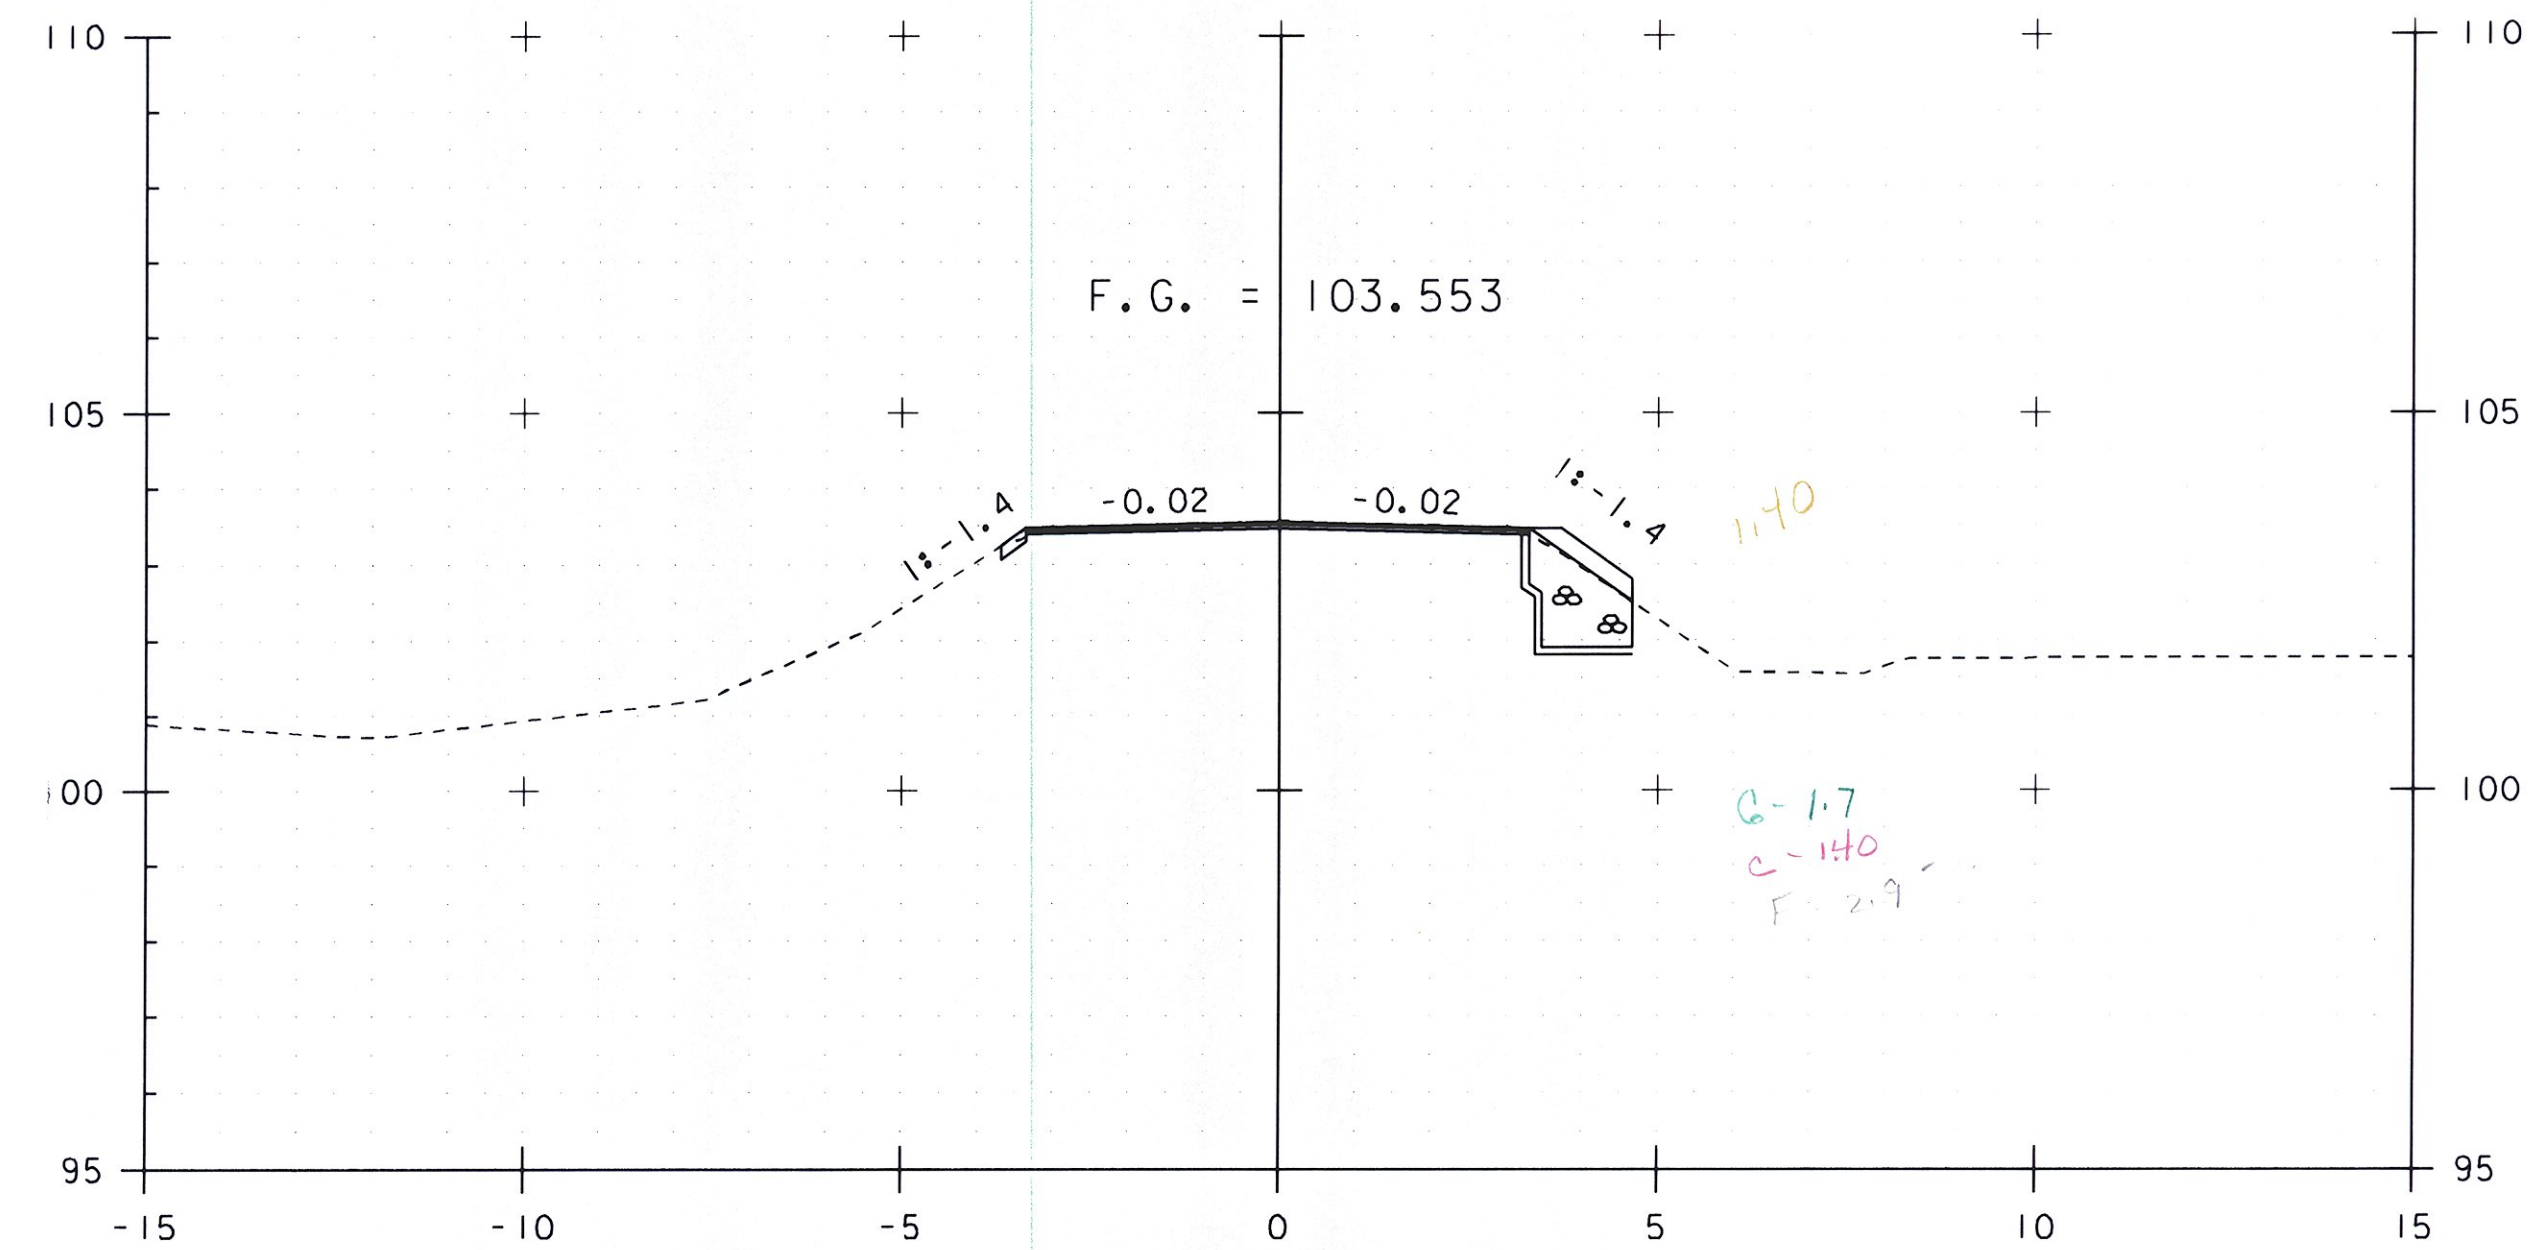


1+185.00

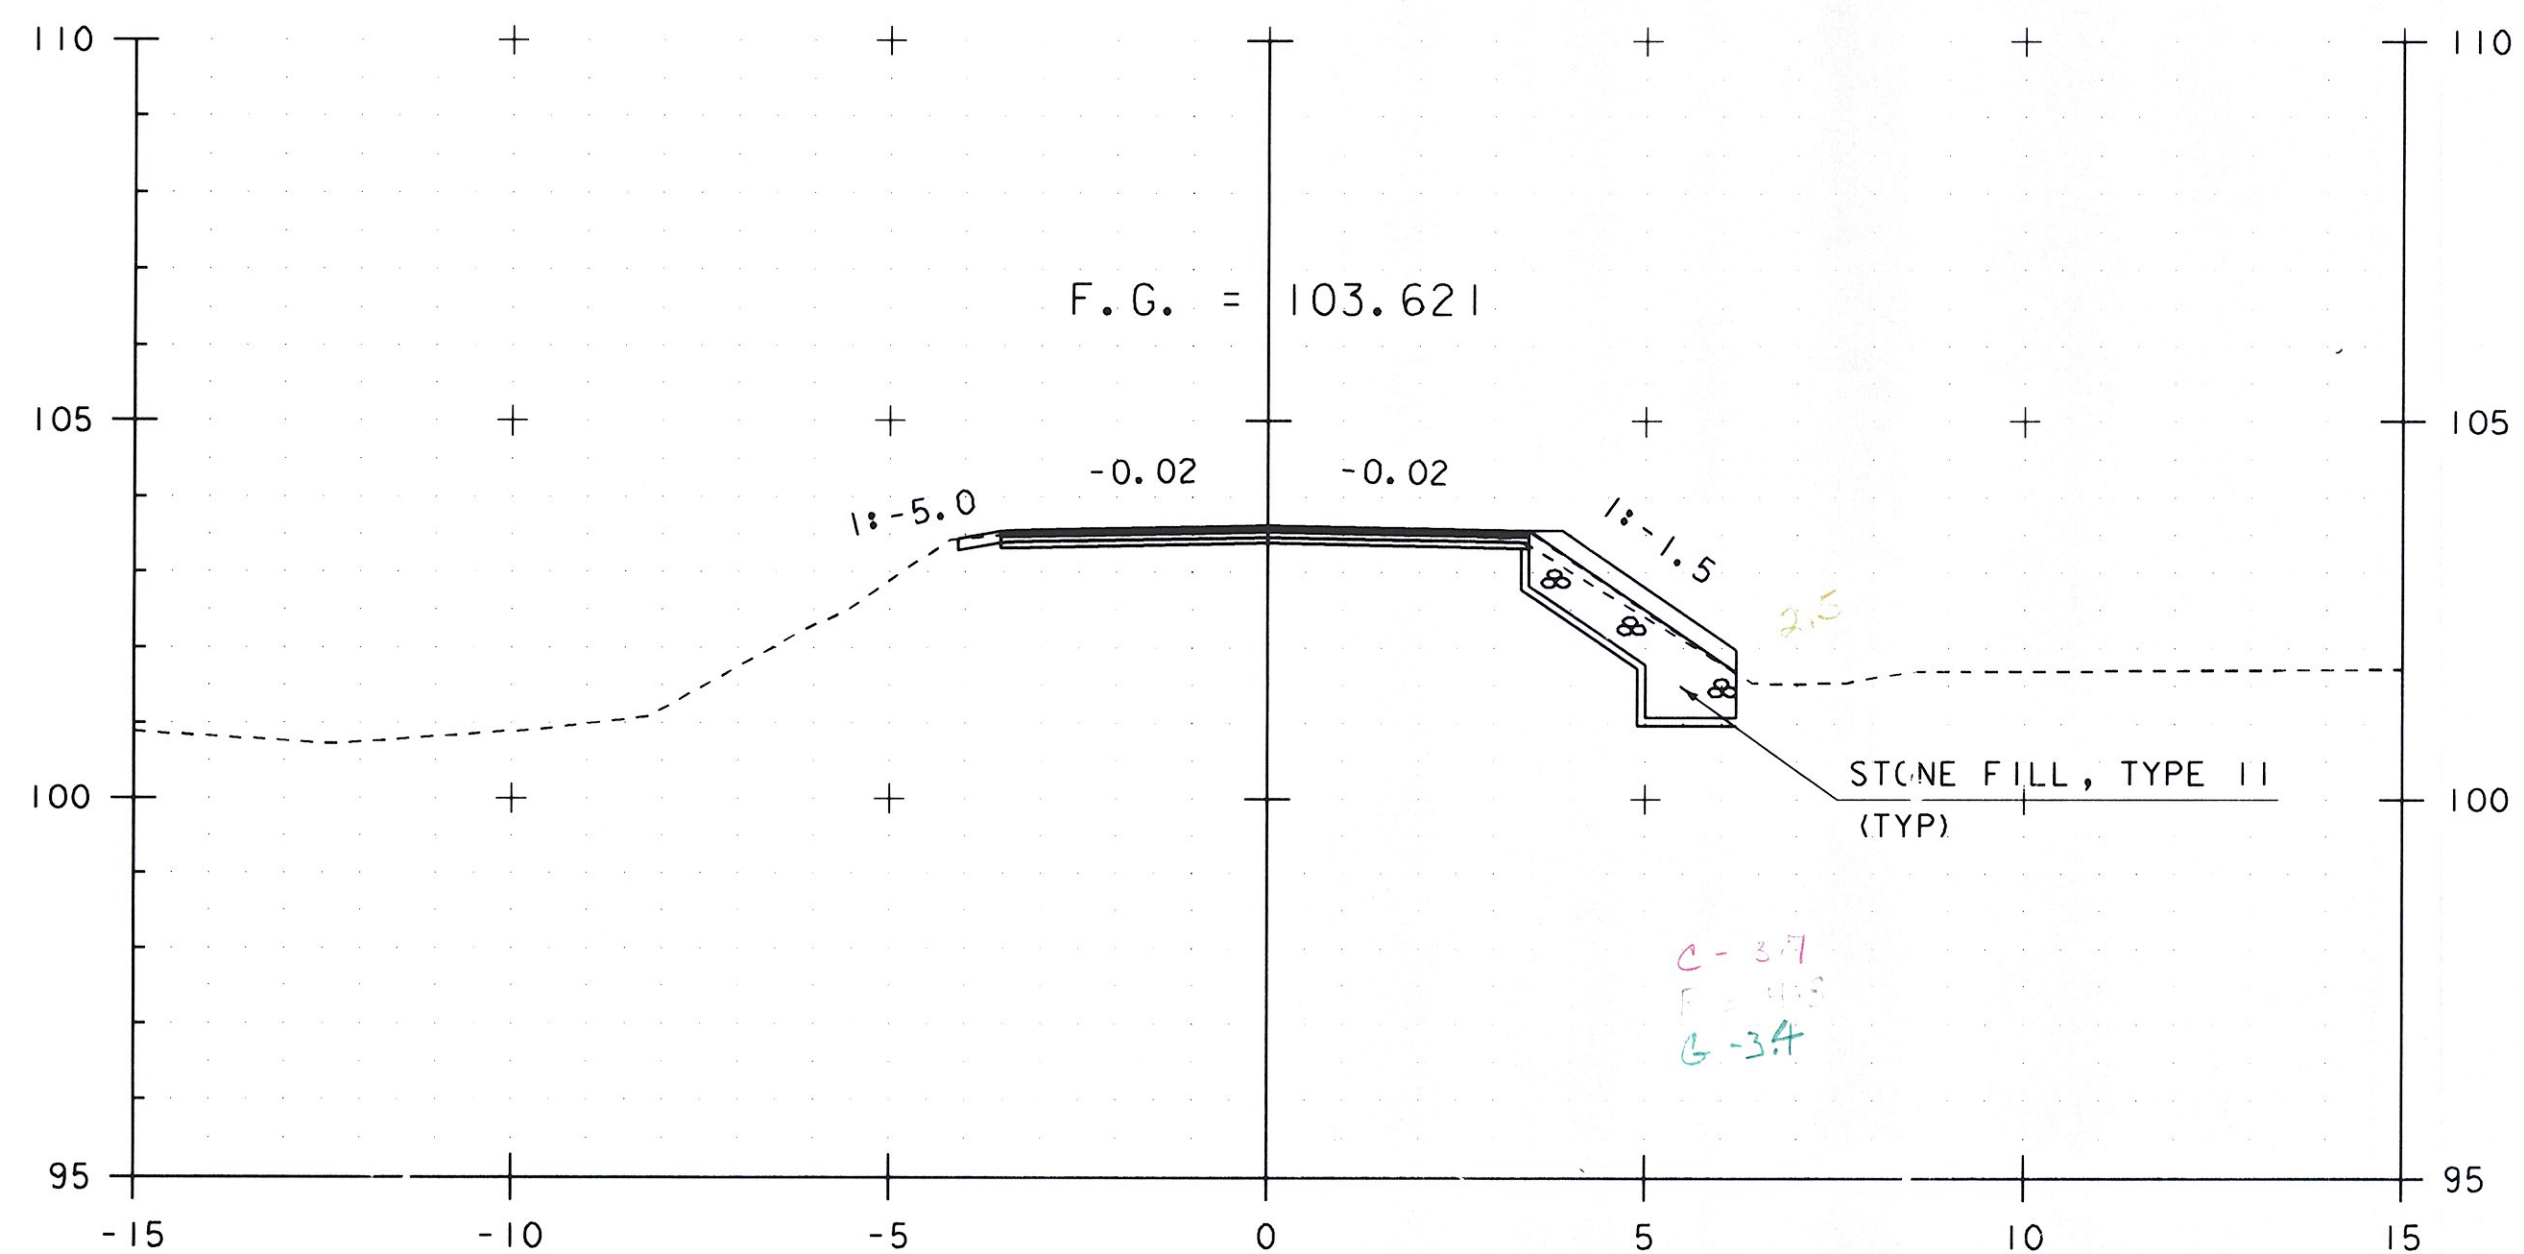

1+175.00

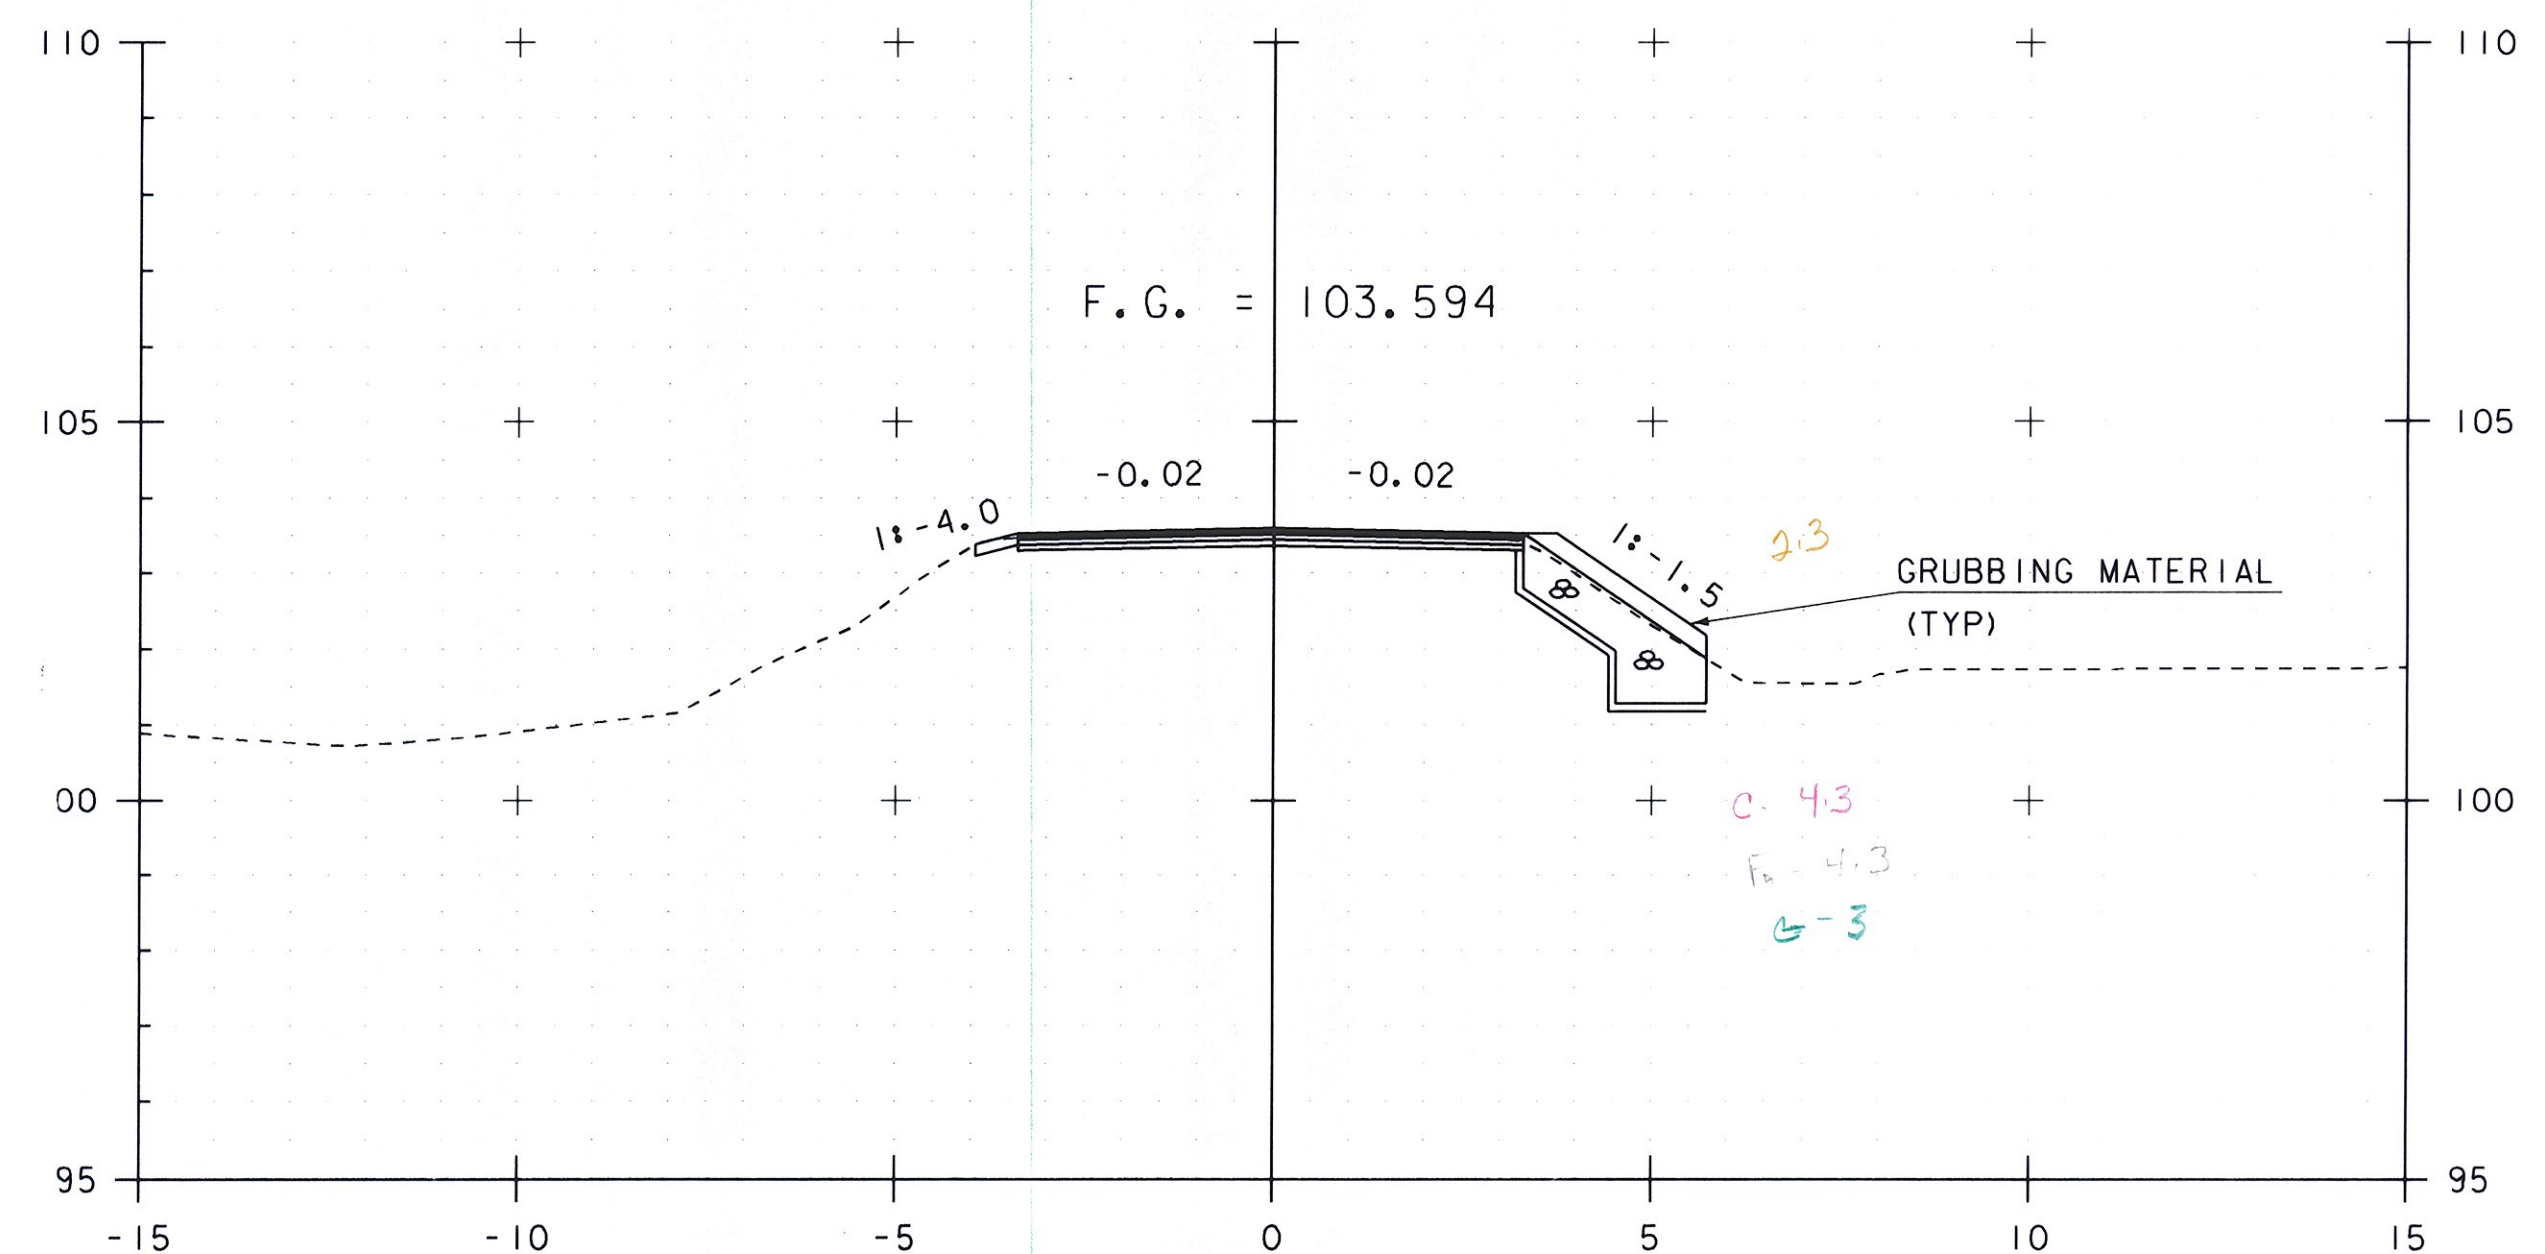

1+180.00

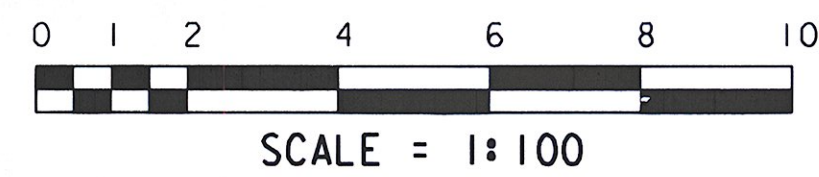

STA. 1+175 TO STA. 1+185

PROJECT NAME:	HINESBURG	PLOT DATE:	02-MAR-2011
PROJECT NUMBER:	STP 0199(2)	DRAWN BY:	C. MOONEY
FILE NAME:	01282/str/s01282xsl.dgn	CHECKED BY:	C. CARLSON
PROJECT LEADER:	C. CARLSON	SHEET	43 OF 56
DESIGNED BY:	W. LAMMER		
MAINLINE SECTIONS SHEET 9			