


FOR CLARITY, AREAS TO BE SEEDED AND MULCHED HAVE NOT BEEN INDICATED; HOWEVER, ALL DISTURBED AREAS SHALL BE SEEDED AND MULCHED AS APPLICABLE.

LEGEND	
	ORDINARY HIGH WATER
	WETLAND CLASS II
	50' WETLAND BUFFER
	50' RIPARIAN ZONE

FINAL CONDITIONS SITE PLAN

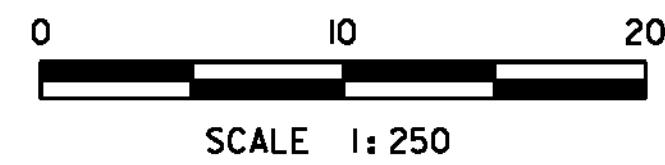

PROJECT NAME:	HINESBURG	PLOT DATE:	02-MAR-2011
PROJECT NUMBER:	STP 0199(2)	DRAWN BY:	C. MOONEY
FILE NAME:	01J282/str/s01J282erpFinal.dgn	CHECKED BY:	C. CARLSON
PROJECT LEADER:	C. CARLSON	DESIGNED BY:	W. LAMMER
DESIGNED BY:	W. LAMMER	FINAL CONDITIONS SITE PLAN	SHEET 49 OF 56