




DETAIL OF "X1A" ~ 20 REQ'D

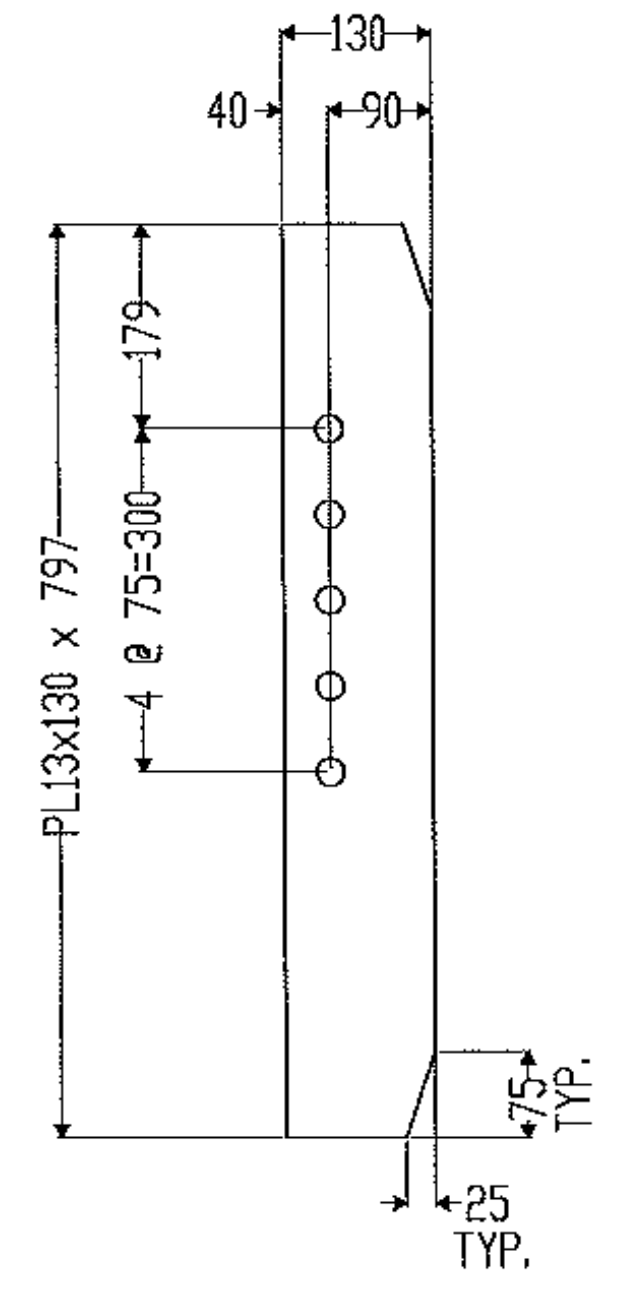

DETAIL OF "X1B" ~ 12 REQ'D

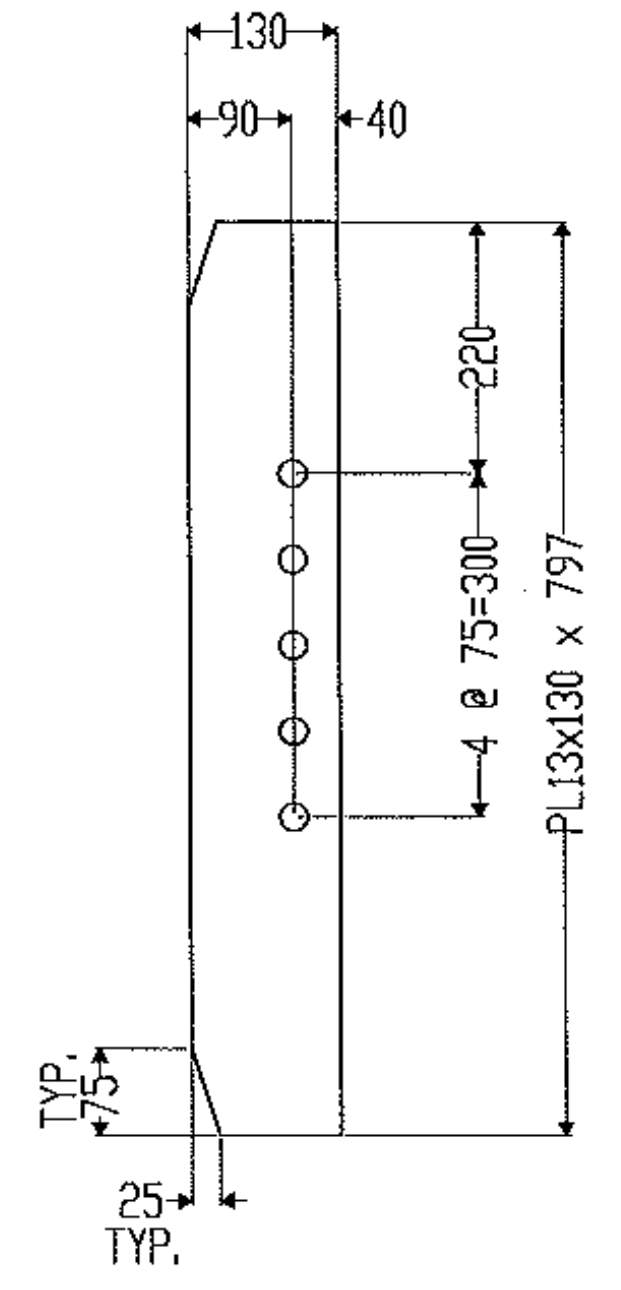

DETAIL OF "X1C" ~ 12 REQ'D

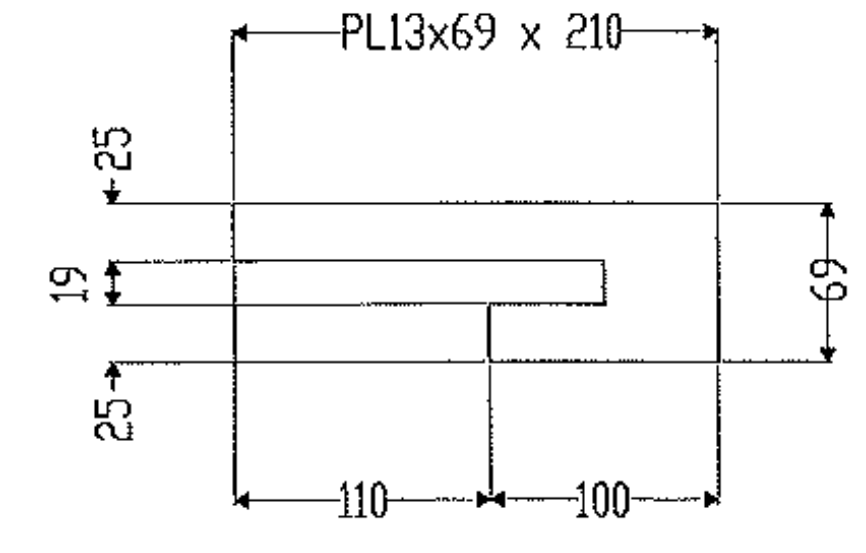

DETAIL OF "X1D" ~ 2 REQ'D

Vermont Agency of Transportation  
**RECEIVED**

CK'D BY WDL OK'D BY GS  
8:02 am, Jul 25, 2011  
RESUBMIT APPROVED X  
BY CWC DATE 07/25/11

SHOP NOTE: DIM'S SHOWN  
ARE IN METRIC (mm)

SHOP NOTES  
HOLES: 24Ø UDN  
BOLTS: PER GNI  
PAINT: PER GNI  
WELDS: N.A.  
MATERIAL: M270 GR.50

3		
2		
1	-	-
REV. NO.	DATE	REVISION
DIAPHRAGM DETAIL		
SILVER ST. BRDG - HINESBURG STATE OF VERMONT PROJECT No. STP 0199(2)		
PRECISE STRUCTURAL PRODUCTS		
3 FARM LANE GEORGETOWN, MA 01833 978-352-2591		
OWNER: VT AGENCY OF TRANSPORTATION CONTRACTOR: A.L. ST.ONGE CONTRACTORS, INC		
DRAWN BY	CHECKED BY	APP. SHOP DIST. CONTRACT NO. SHEET NO.
KC	WL	
06/24/11	06/28/11	3578 X1