


H = HOLE SIDE  
 SS = SHORT SLOTTED SIDE  
 LS = LONG SLOTTED SIDE

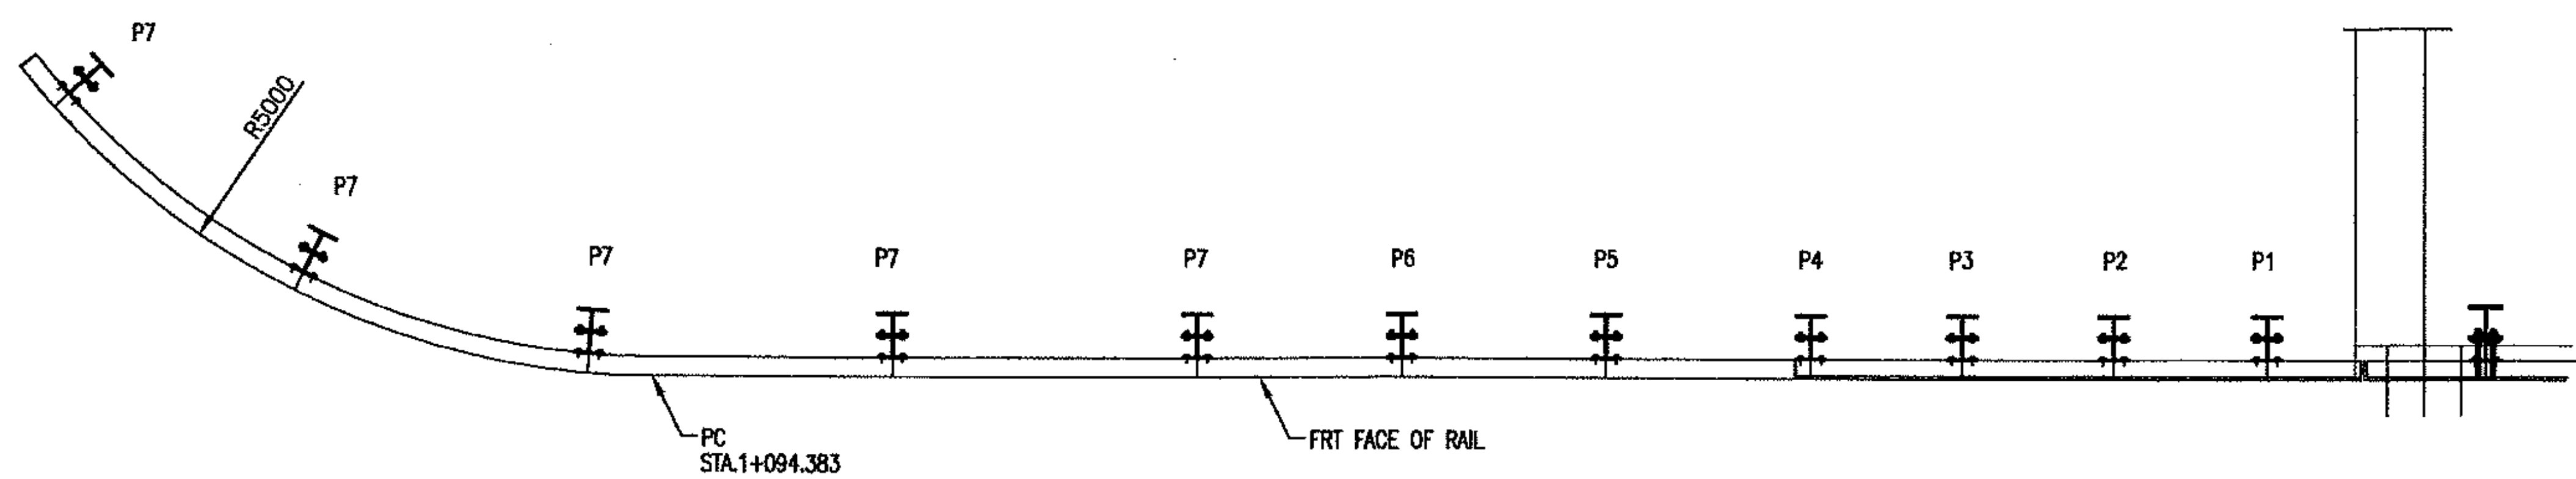


PLAN VIEW

- NOTE:
- RAIL LENGTHS DO NOT INCLUDE END CAPS AND/OR GAPS.
  - LENGTH OF APPROACH RAILING ON THIS SHEET IS 15.2 M (50 LF) PAY LENGTH.
  - METRIC DIMENSIONS ARE IN MILLIMETERS (mm), UNLESS NOTED.

Vermont Agency of Transportation  
**RECEIVED**  
 CK'D BY WDL OK'D BY GS

7:54 am, Jul 13, 2011

RESUBMIT APPROVED X  
 BY CWC, Proj. Mgr. DATE 07/13/11

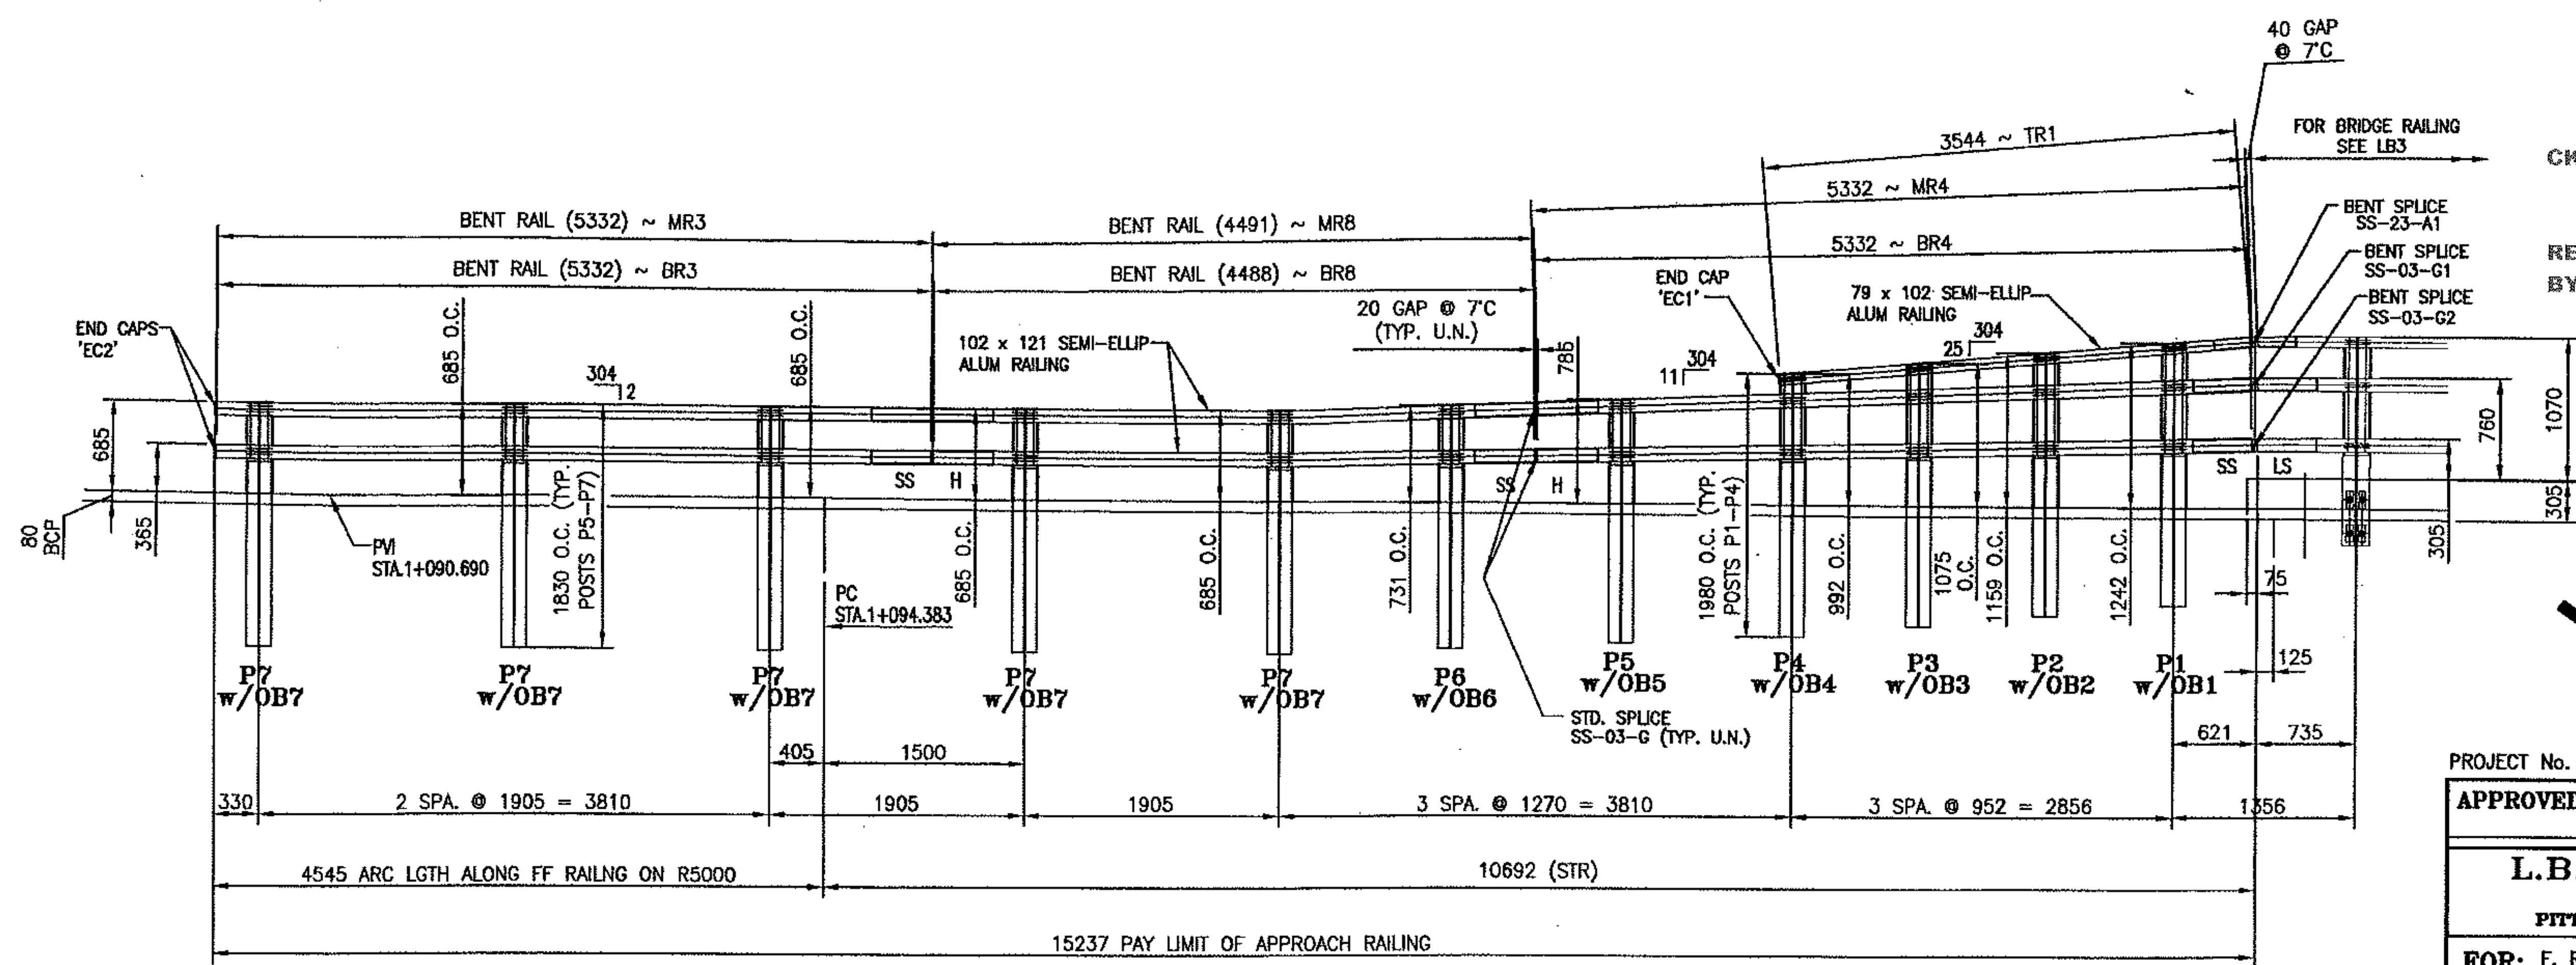

INSIDE ELEVATION OF NE APPROACH RAIL

**ANODIZED**  
 (SEE LB1 FOR SPECIFICATIONS)

PROJECT No. STP 0199 (2) ITEM No: 621.74

APPROVED: \_\_\_\_\_ REC'D APPROVAL \_\_\_\_\_  
 DRAWING \_\_\_\_\_

**L.B. FOSTER COMPANY**  
 1016 GREENTREE ROAD  
 PITTSBURGH, PENNSYLVANIA 15220

FOR: F. R. LAFAYETTE, INCORPORATED  
 VERMONT AGENCY OF TRANSPORTATION  
 TOWN OF HINESBURG, COUNTY OF CHITTENDEN, VT  
 APPROACH RAILING FOR BRIDGE #10, TOWN HIGHWAY 4 (MAJ. COLLECTOR) CLASS 2  
 3L ALUMINUM NE APPROACH RAIL ELEVATIONS

MADE CMS DATE 06/17/11 JOB No. ARO689 CUST. No. \_\_\_\_\_  
 CHECK Dd DATE 06/28/11 DRAWING LB6 KEY. No. \_\_\_\_\_

REV.	DESCRIPTION	BY	DATE