



BRIDGE RAILING 95

- NOTE:
- RAIL LENGTHS DO NOT INCLUDE END CAPS AND/OR GAPS.
 - LENGTH OF APPROACH RAILING ON THIS SHEET IS 17.1 M (56.24 LF) PAY LENGTH.
 - METRIC DIMENSIONS ARE IN MILLIMETERS (mm), UNLESS NOTED.

H = HOLE SIDE
 SS = SHORT SLOTTED SIDE
 LS = LONG SLOTTED SIDE

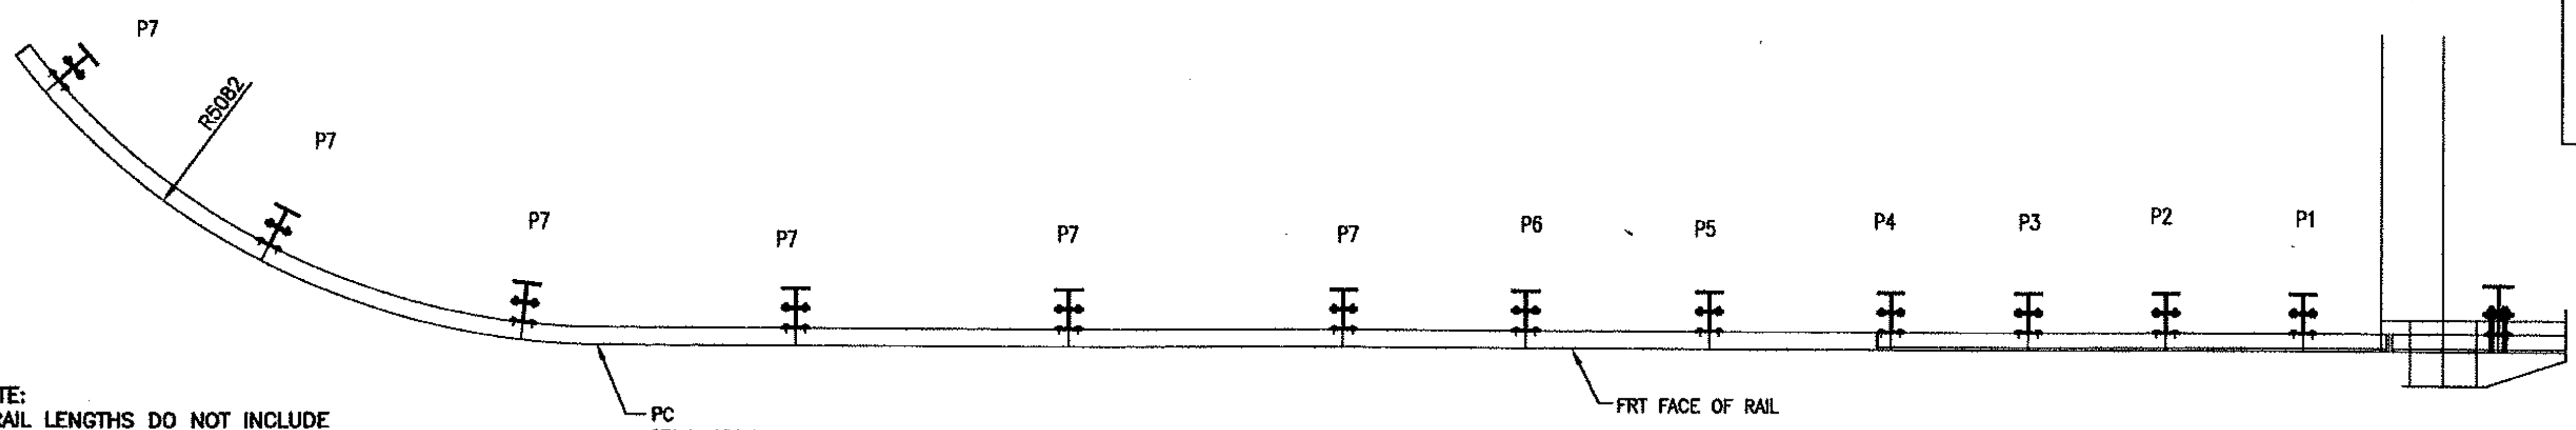

PLAN VIEW

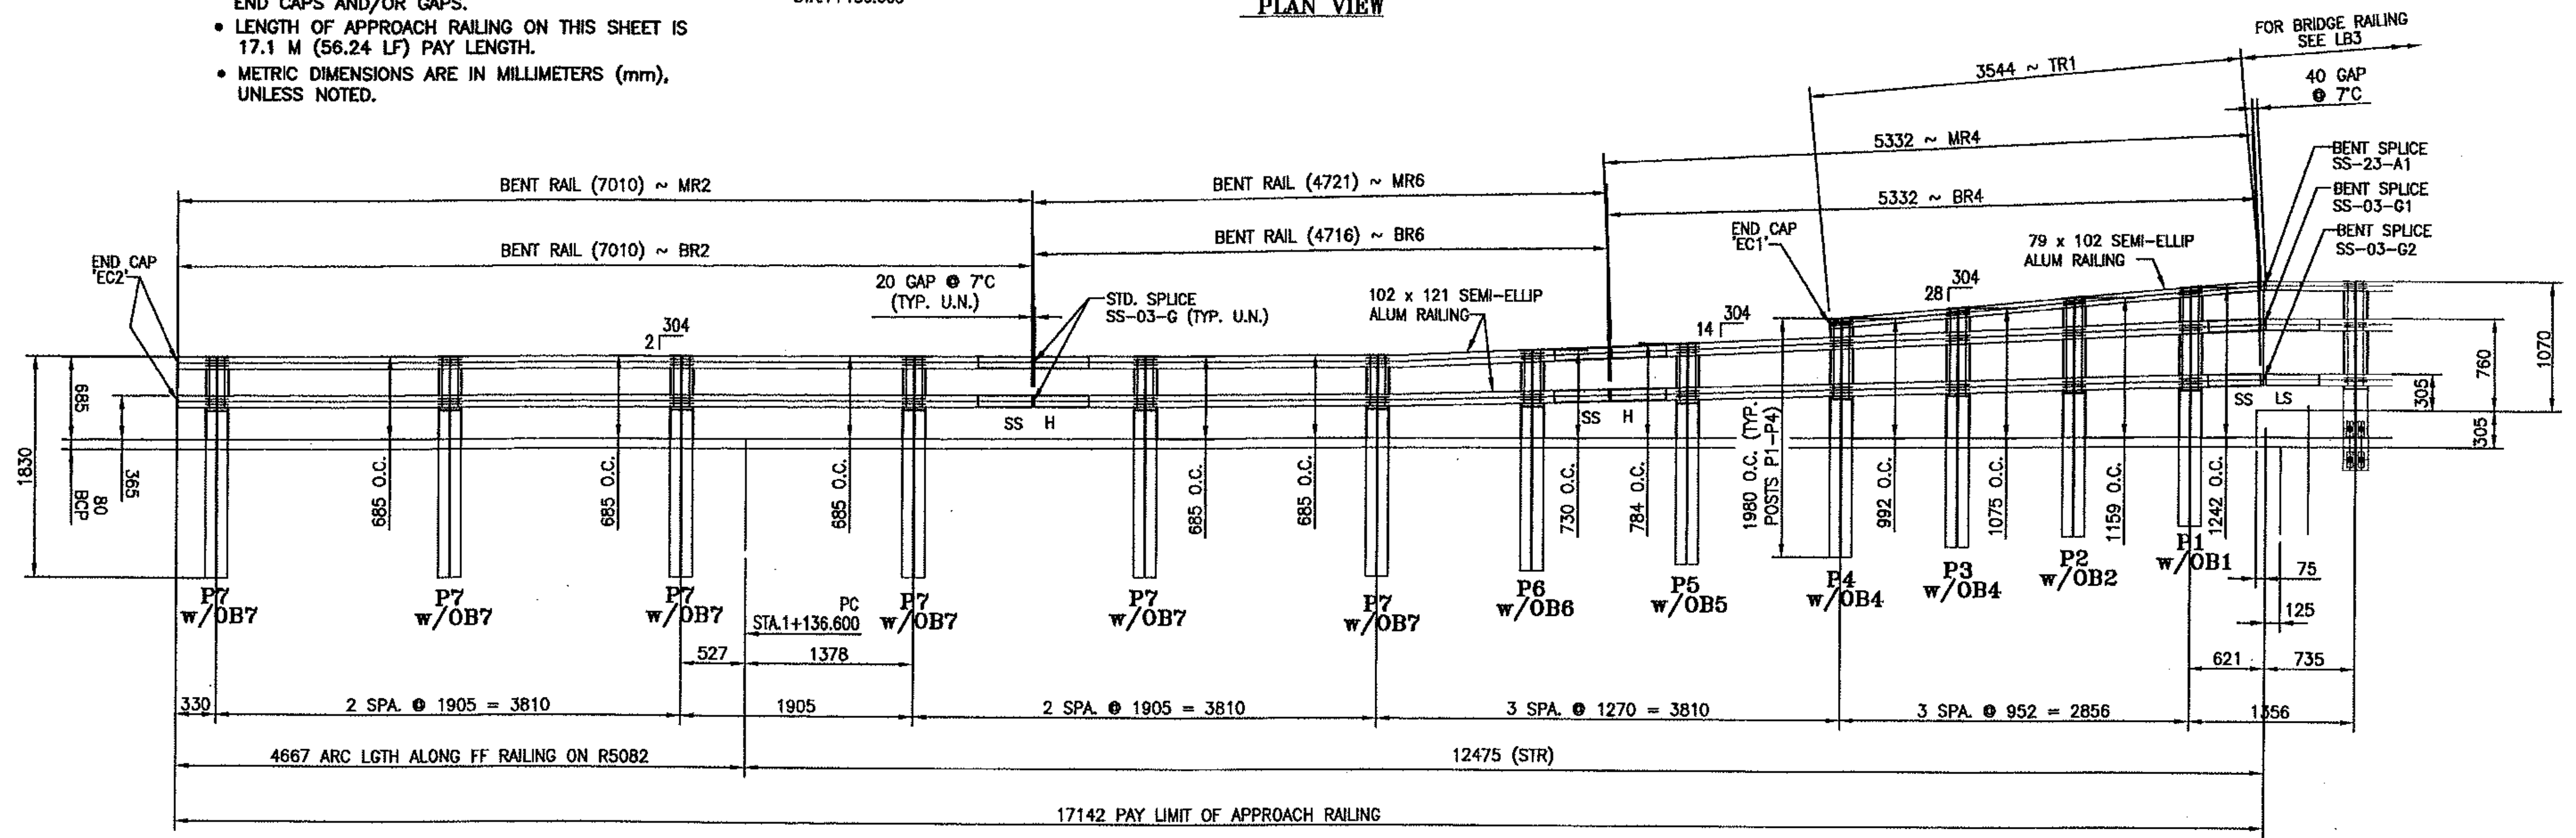

INSIDE ELEVATION OF SW APPROACH RAIL

Vermont Agency of Transportation
RECEIVED
 CK'D BY WDL OK'D BY GS
 7:54 am, Jul 13, 2011
 RESUBMIT _____ APPROVED **X**
 BYCWC, Proj. Mgr. DATE 07/13/11

ANODIZED
 (SEE LB1 FOR SPECIFICATIONS)

REV.	DESCRIPTION	BY	DATE

PROJECT No. STP 0199 (2) ITEM No: 621.74

APPROVED: _____ REC'D APPROVAL _____
 DRAWING _____

L.B. FOSTER COMPANY
 1016 GREENTREE ROAD
 PITTSBURGH, PENNSYLVANIA 15220

FOR: F. R. LAFAYETTE, INCORPORATED
 VERMONT AGENCY OF TRANSPORTATION
 TOWN OF HINESBURG, COUNTY OF CHITTENDEN, VT
 APPROACH RAILING FOR BRIDGE #10, TOWN HIGHWAY 4 (MAJ. COLLECTOR) CLASS 2
 3L ALUMINUM SW APPROACH RAIL ELEVATIONS

MADE CMS DATE 06/17/11 JOB No. ARO689 CUST. No. _____
 CHECK Dd DATE 06/28/11 DRAWING LB9 REV. No. _____