

STATE OF VERMONT AGENCY OF TRANSPORTATION




PROPOSED IMPROVEMENT

BRIDGE PROJECT

TOWN OF CORINTH
COUNTY OF ORANGE

CHICKEN FARM ROAD (T.H.16) CLASS 3 LOCAL ROAD BRIDGE NO.36


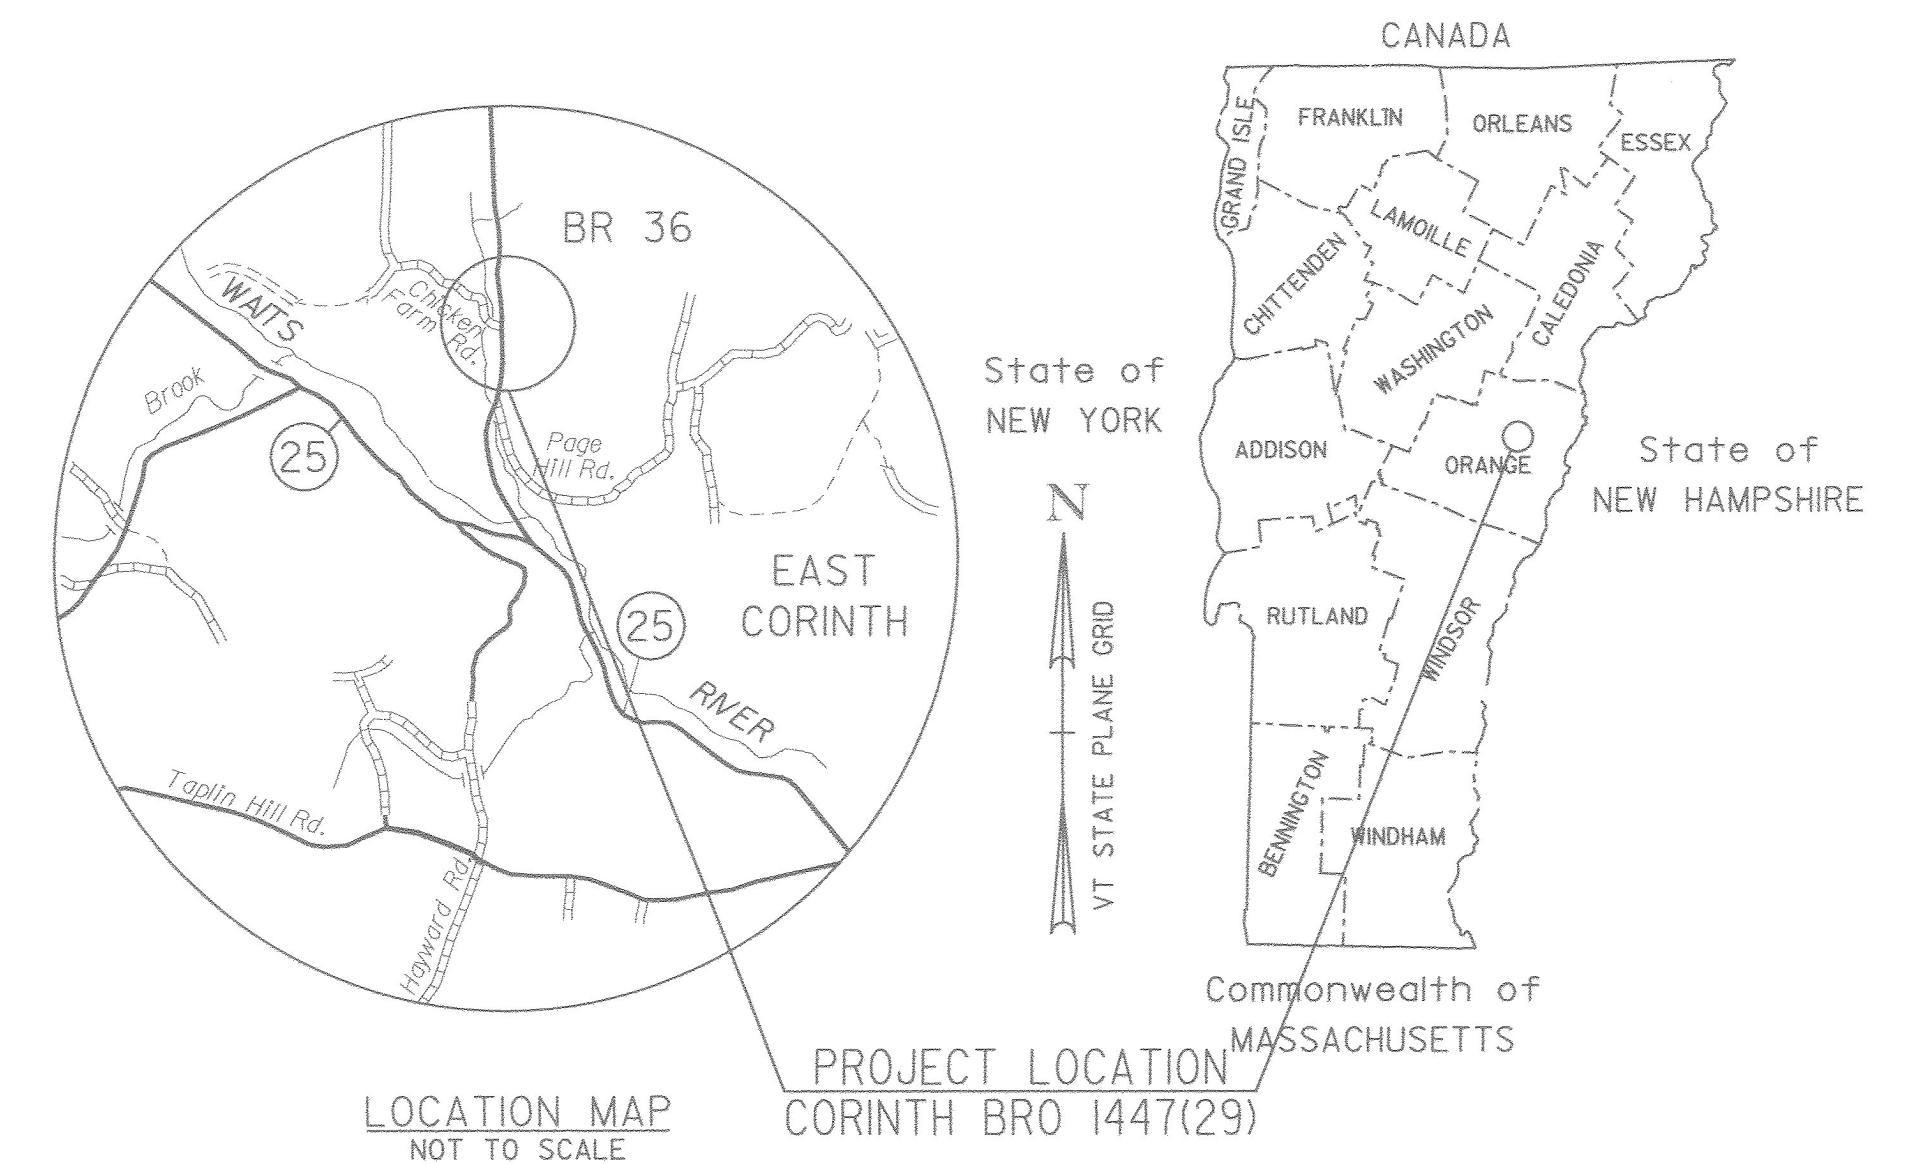


PROJECT LOCATION: BEGINNING AT A POINT ON (T.H.16) CHICKEN FARM ROAD APPROXIMATELY 0.065 MILES WEST OF THE INTERSECTION OF (T.H.16) CHICKEN FARM ROAD AND (T.H.#1) VILLAGE ROAD AND EXTENDING EASTERLY ALONG (T.H.16) CHICKEN FARM ROAD FOR 0.065 MILES.

PROJECT DESCRIPTION: REPLACEMENT OF EXISTING BRIDGE WITH A PRECAST CONCRETE NEXT BEAM SUPERSTRUCTURE AND CONCRETE SUBSTRUCTURE, WITH ROADWAY APPROACH WIDENING WORK.

LENGTH OF BRIDGE: 65.20 FEET = 0.012 MILES
 LENGTH OF ROADWAY: 277.74 FEET = 0.053 MILES
 LENGTH OF PROJECT: 342.94 FEET = 0.065 MILES

RECORD PLANS	
CONTRACTOR:	AUSTIN CONSTRUCTION, INC. - CONCORD, VT
RESIDENT ENGINEER:	PETE HODGSON
CONSTRUCTION BEGAN:	NOVEMBER 25, 2014
CONSTRUCTION COMPLETE:	DECEMBER 09, 2015
RECORD PLANS BY:	PETE HODGSON & JESSE IVES
I HEREBY CERTIFY THAT ALL THE CONSTRUCTION REQUIRED BY THIS SET OF DRAWINGS HAS BEEN ACCOMPLISHED AS INDICATED HEREIN.	
BY <i>Pete Hodgson</i>	RESIDENT ENGINEER
DATE <i>April 12, 2018</i>	
NOTE: Any further information concerning final quantities, amounts or other details relative to this project may be found at Central Files in the electronic archives.	

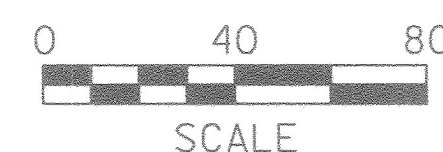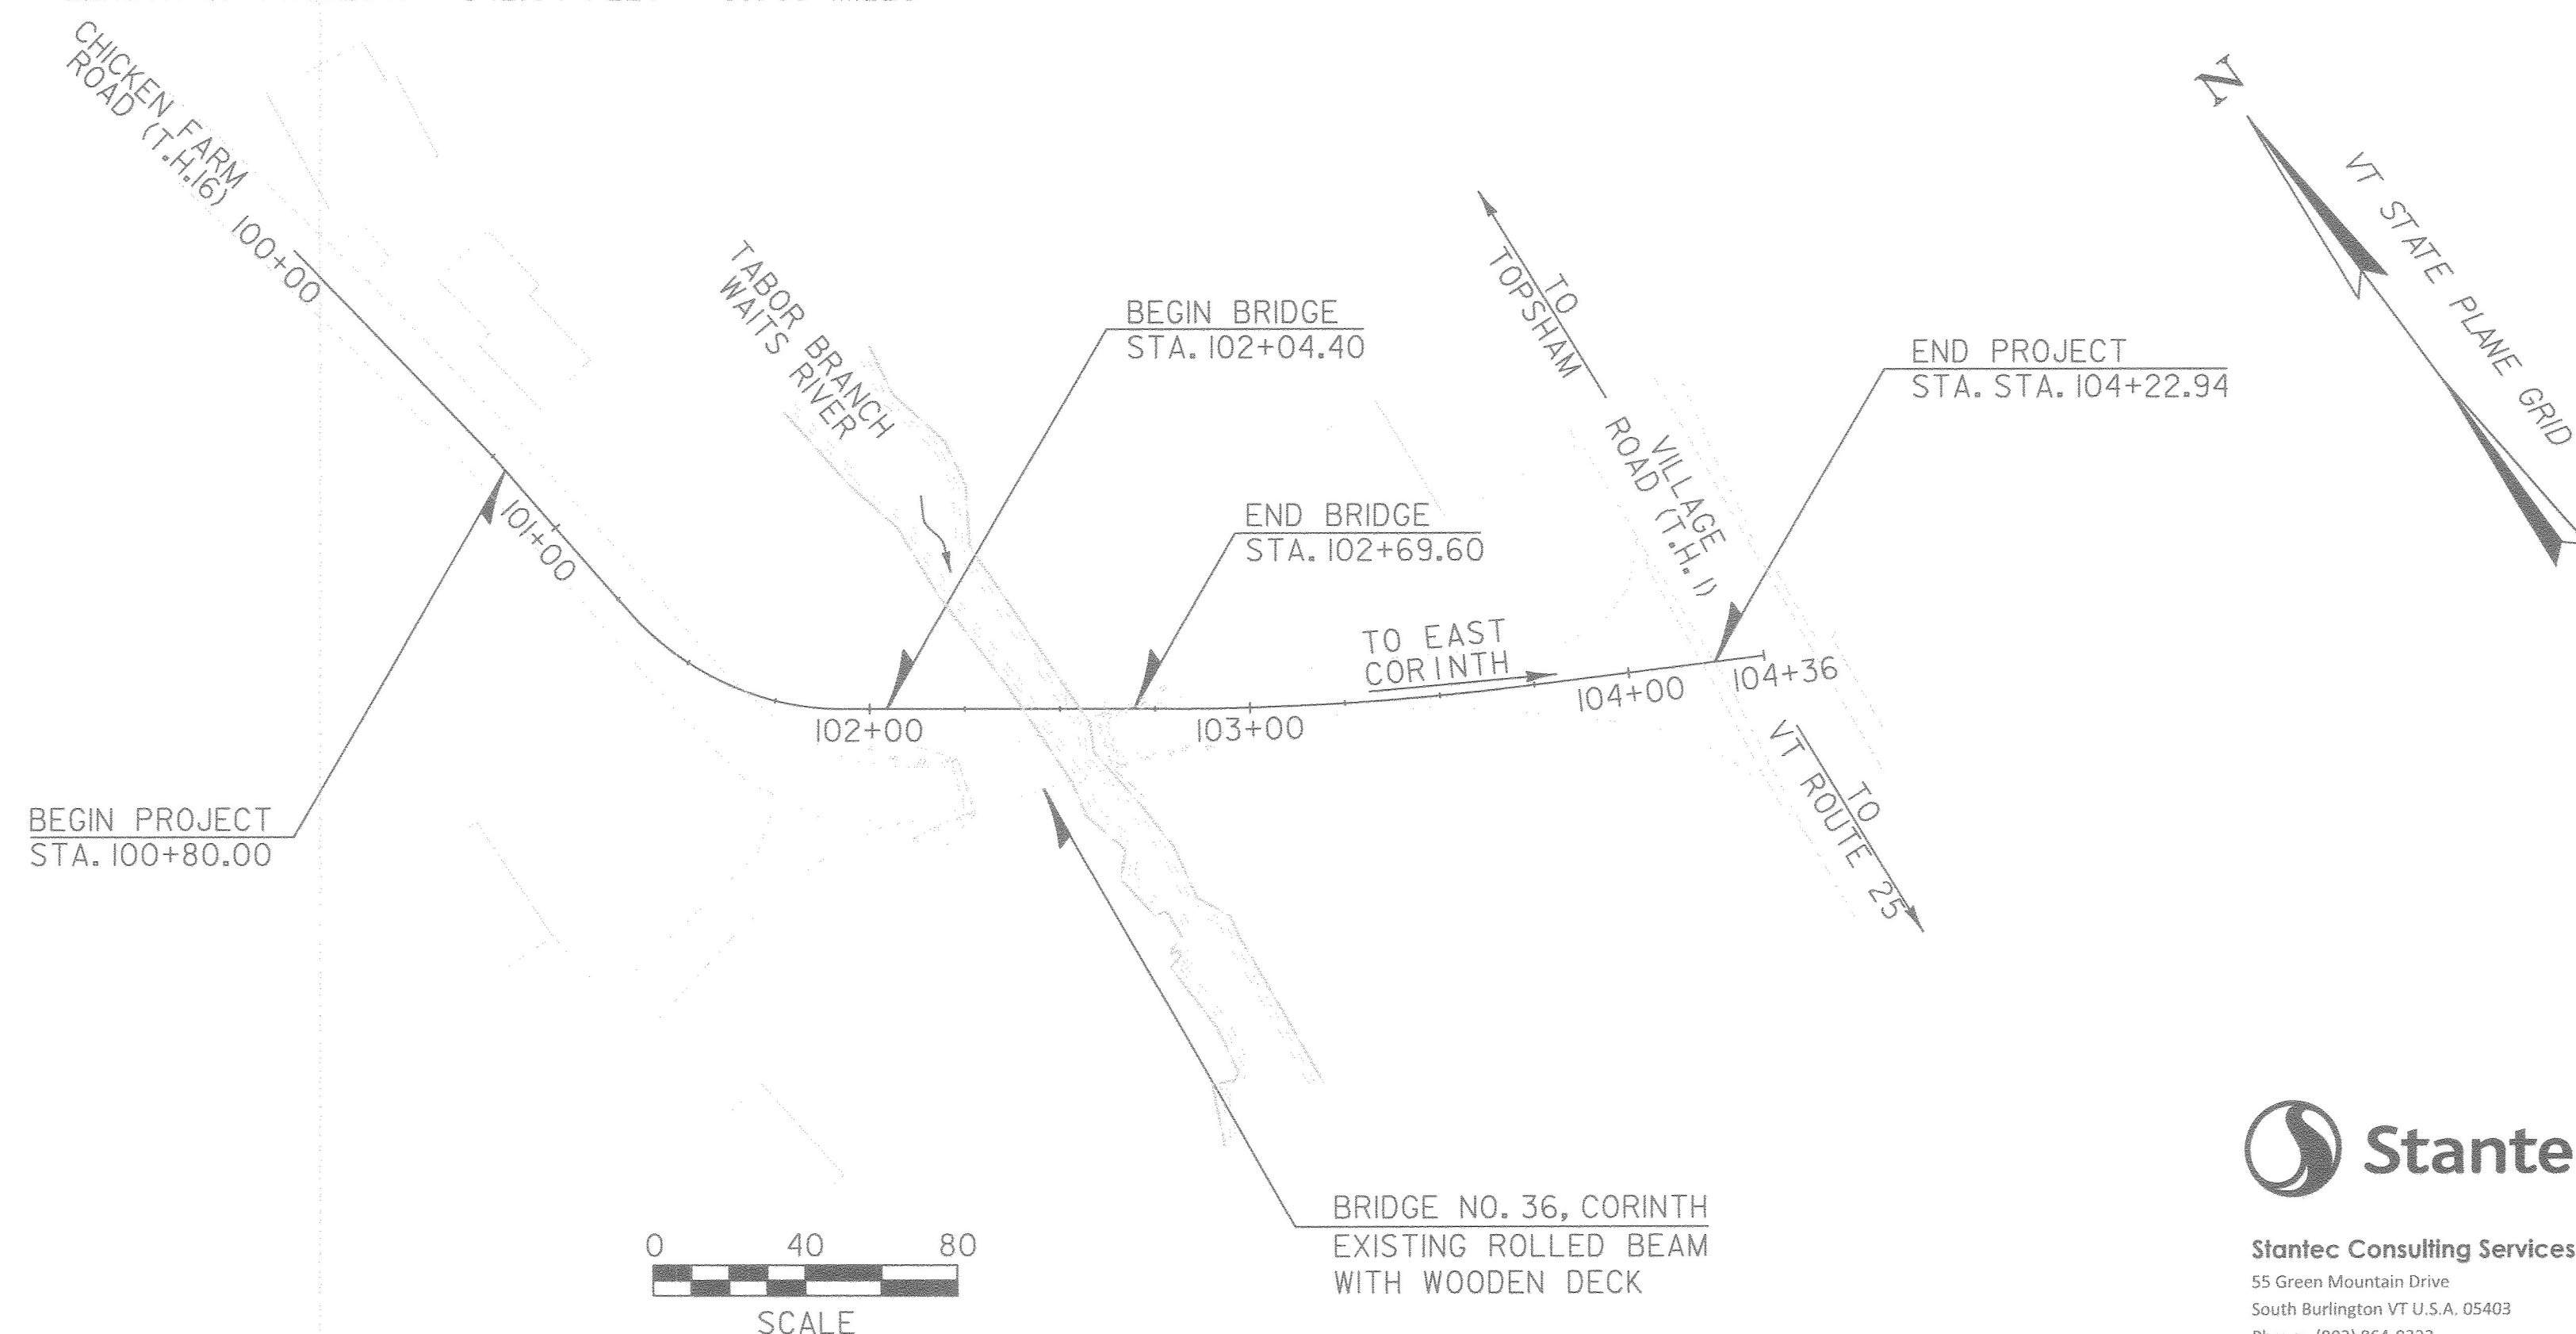

CONSTRUCTION IS TO BE CARRIED ON IN ACCORDANCE WITH THESE PLANS AND THE STANDARD SPECIFICATIONS FOR CONSTRUCTION DATED 2011, AS APPROVED BY THE FEDERAL HIGHWAY ADMINISTRATION ON JULY 20, 2011 FOR USE ON THIS PROJECT, INCLUDING ALL SUBSEQUENT REVISIONS AND SUCH REVISED SPECIFICATIONS AND SPECIAL PROVISIONS AS ARE INCORPORATED IN THESE PLANS.

QUALITY ASSURANCE PROGRAM : LEVEL 2	
SURVEYED BY : VSE	
SURVEYED DATE : 11/05/2012	
DATUM	
VERTICAL	NAVD 88
HORIZONTAL	NAD 83 (2011)

Stantec
 Stantec Consulting Services Inc.
 55 Green Mountain Drive
 South Burlington VT U.S.A. 05403
 Phone: (802) 864-0223
 Fax: (802) 864-0165
 www.stantec.com

DIRECTOR OF PROJECT DELIVERY	APPROVED _____ DATE _____
PROJECT MANAGER : DANNY LANDRY	
PROJECT NAME : CORINTH	
PROJECT NUMBER : BRO 1447 (29)	
SHEET 1 OF 57 SHEETS	