


**ABUTMENT 1 REINFORCEMENT**  
 SCALE  $\frac{3}{8}$ " = 1'-0"

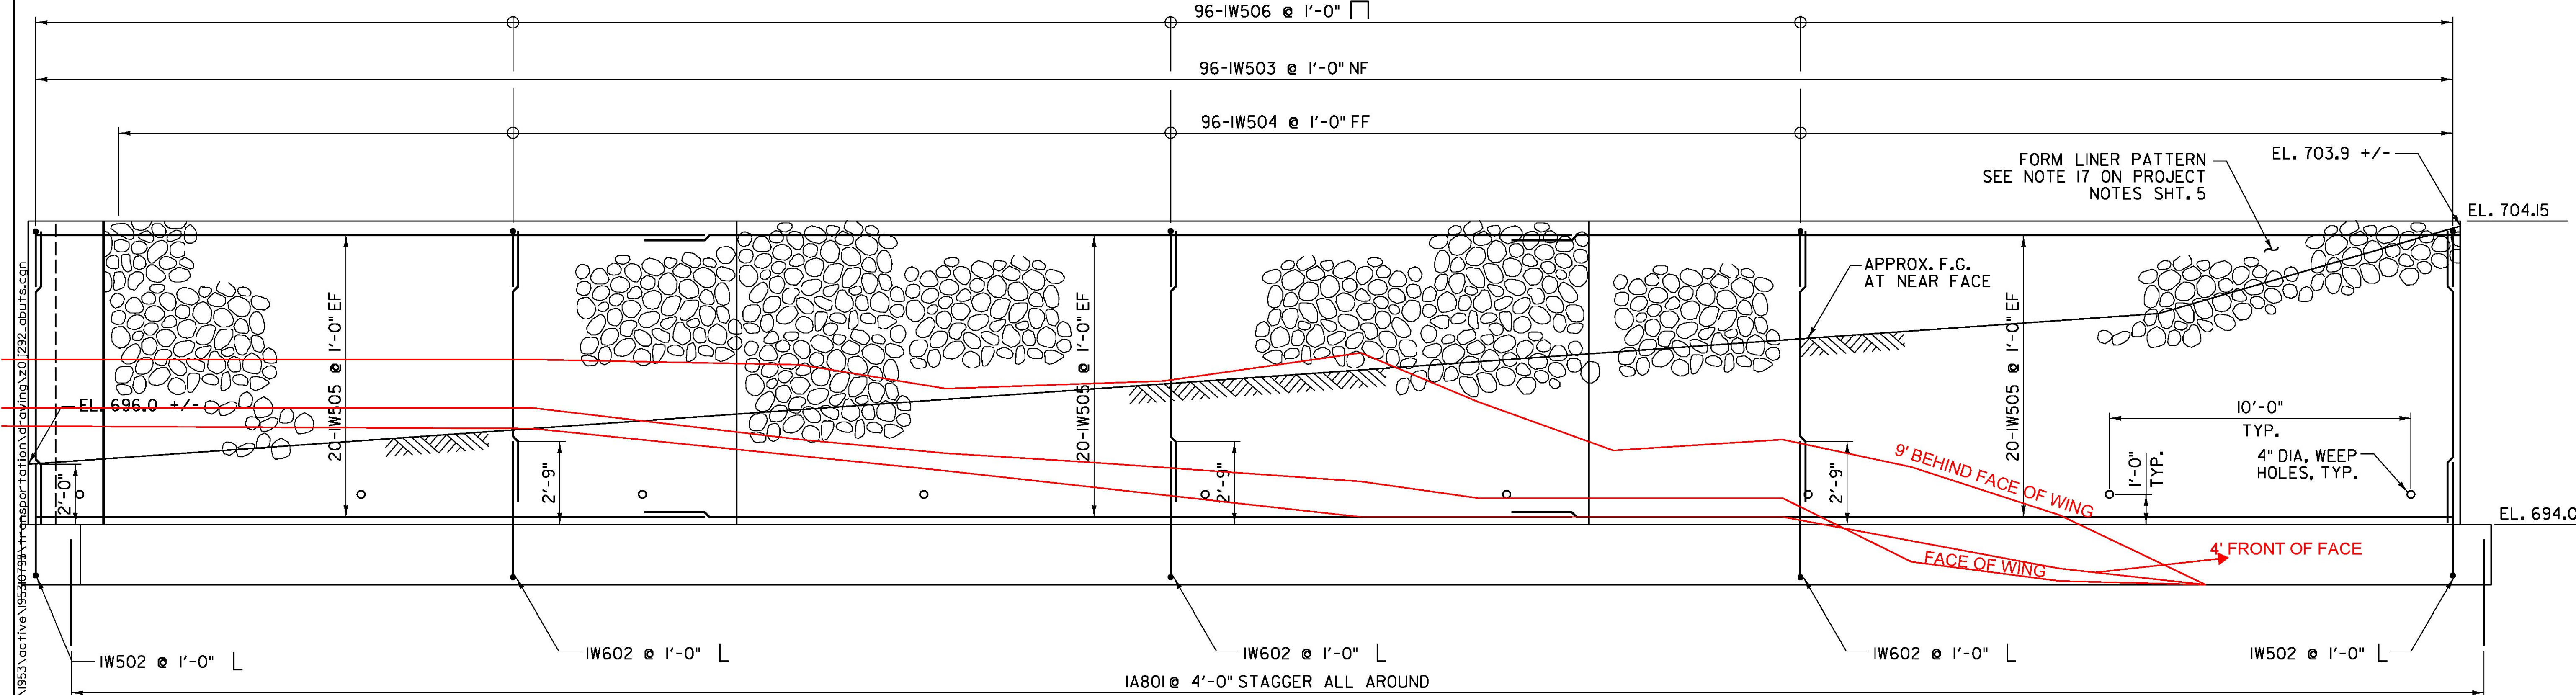

**WINGWALL 1 ELEVATION (CURVED)**  
 SCALE  $\frac{3}{8}$ " = 1'-0"

8/4/2014 12:44:04 PM I:\19533\oc-1\ve\19533\19533\transportation\01292\_abuts.dgn

PROJECT NAME: CORINTH	
PROJECT NUMBER: BRO 1447(29)	
FILE NAME: ...drawing\01292_abuts.dgn	PLOT DATE: 8/4/2014
PROJECT LEADER: G. BOGUE	DRAWN BY: L. BUXTON
DESIGNED BY: J. HUNGERFORD	CHECKED BY: G. BOGUE
<b>ABUTMENT 1 &amp; WW1 REINFORCEMENT</b>	
SHEET 34 OF 57	

