




8/4/2014 12:44:06 PM V:\9533\active\95330795\transportation\drawing\201292.abuts.dgn

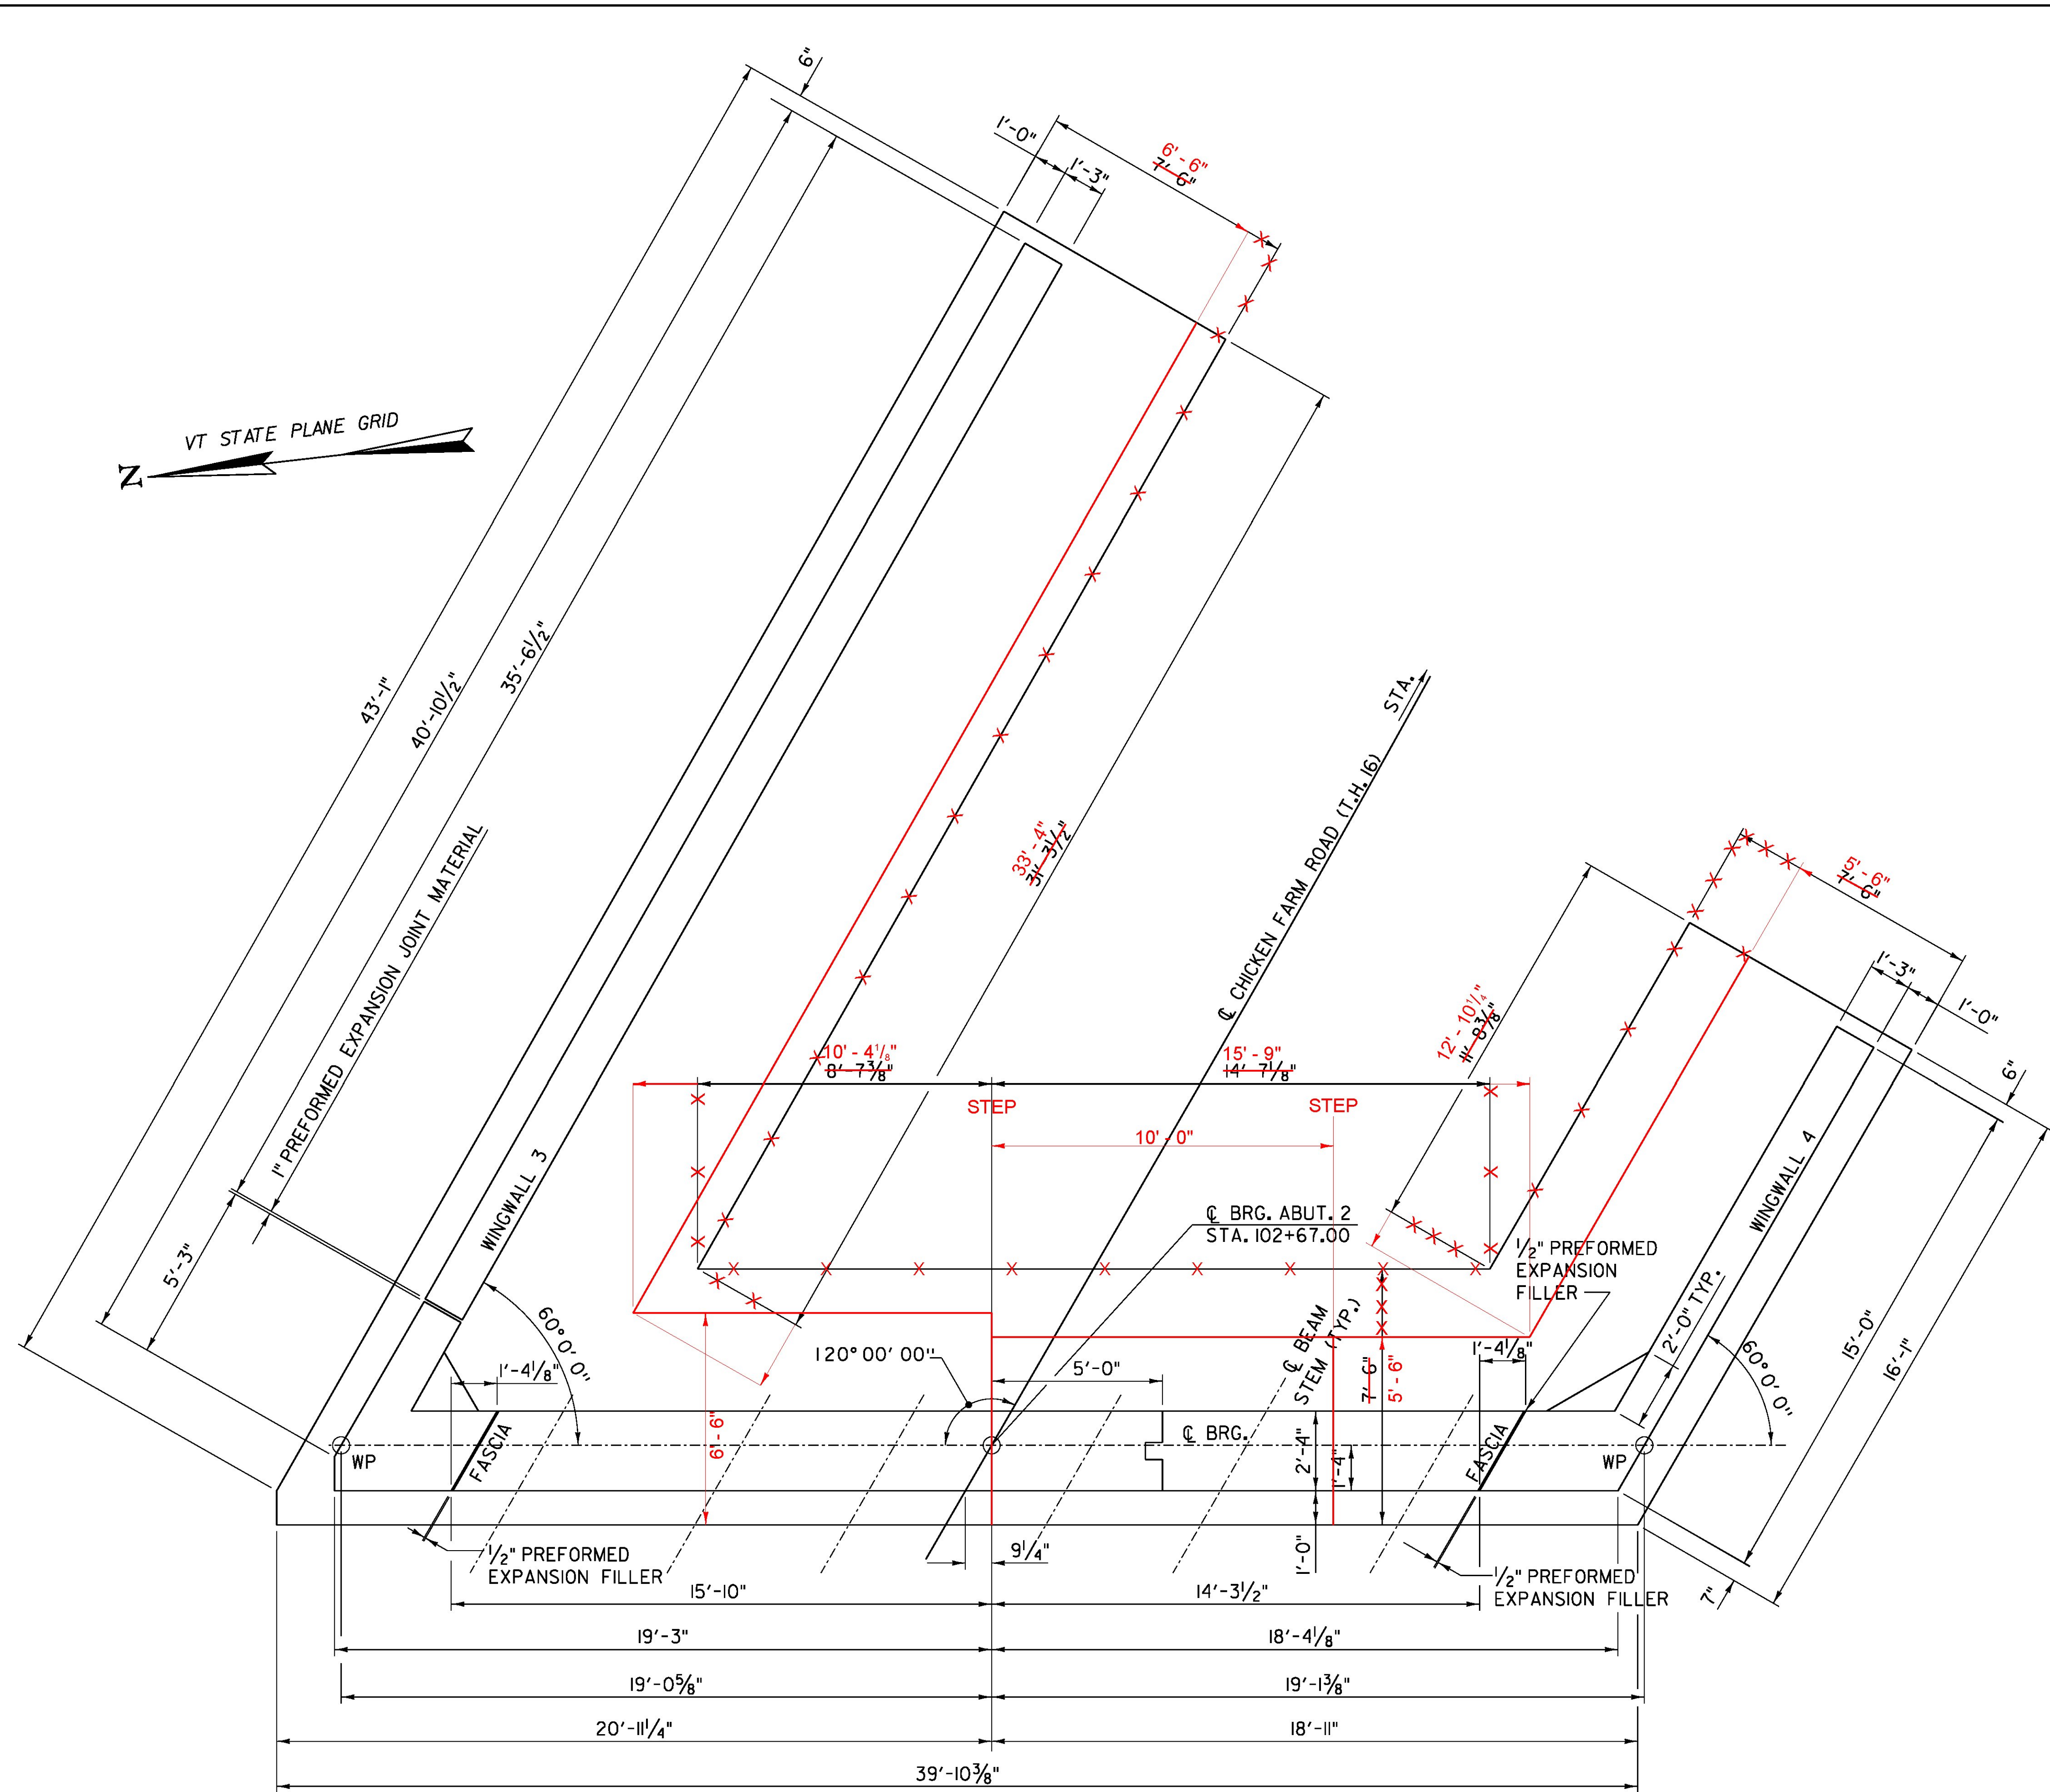

**ABUTMENT 2 PLAN**  
 SCALE 3/8" = 1' - 0"

PROJECT NAME:	CORINTH
PROJECT NUMBER:	BRO 1447(29)
FILE NAME: ...drawing\201292.abuts.dgn	PLOT DATE: 8/4/2014
PROJECT LEADER: G. BOGUE	DRAWN BY: L. BUXTON
DESIGNED BY: J. HUNGERFORD	CHECKED BY: G. BOGUE
<b>ABUTMENT 2 MASONRY</b>	SHEET 35 OF 57

