


STA. 102+75.00 TO STA. 103+75.00

PROJECT NAME:	CORINTH	PLOT DATE:	8/4/2014
PROJECT NUMBER:	BRO 1447(29)	DRAWN BY:	E. ALLING
FILE NAME:	...drawing\z01j292.xsdgn	DESIGNED BY:	M. CHENETTE
DESIGNED BY:	M. CHENETTE	CHECKED BY:	G. BOGUE
ROADWAY CROSS SECTIONS - RXS 4		SHEET 46 OF 57	

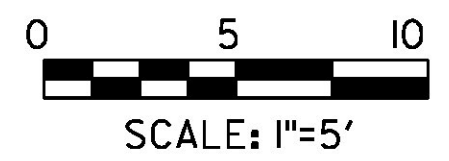

8/4/2014 12:44:41PM V:\95310795\Transportation\drawing\z01j292.xsdgn