




51+00

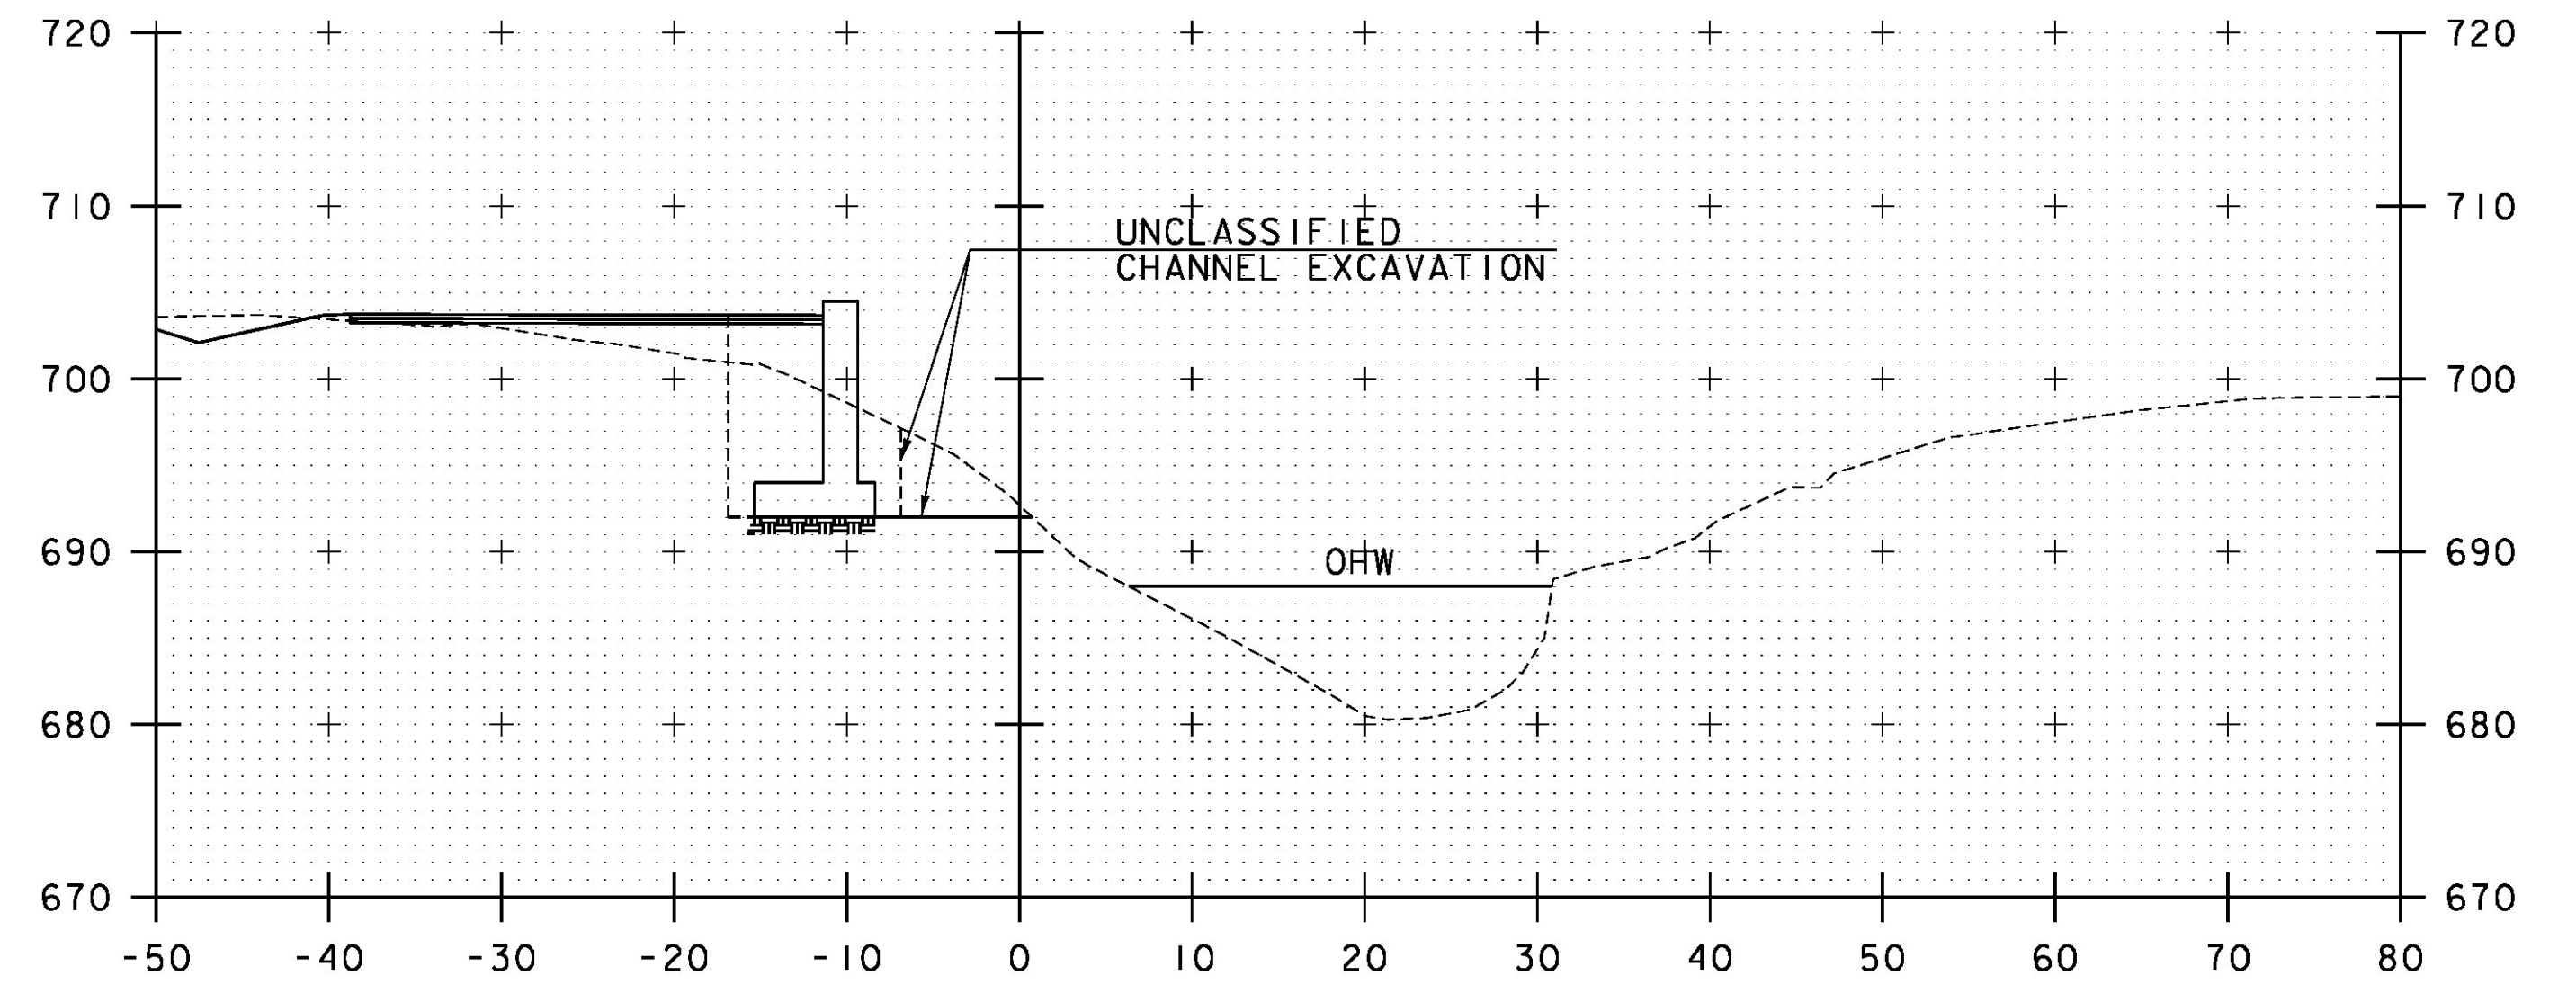

51+20

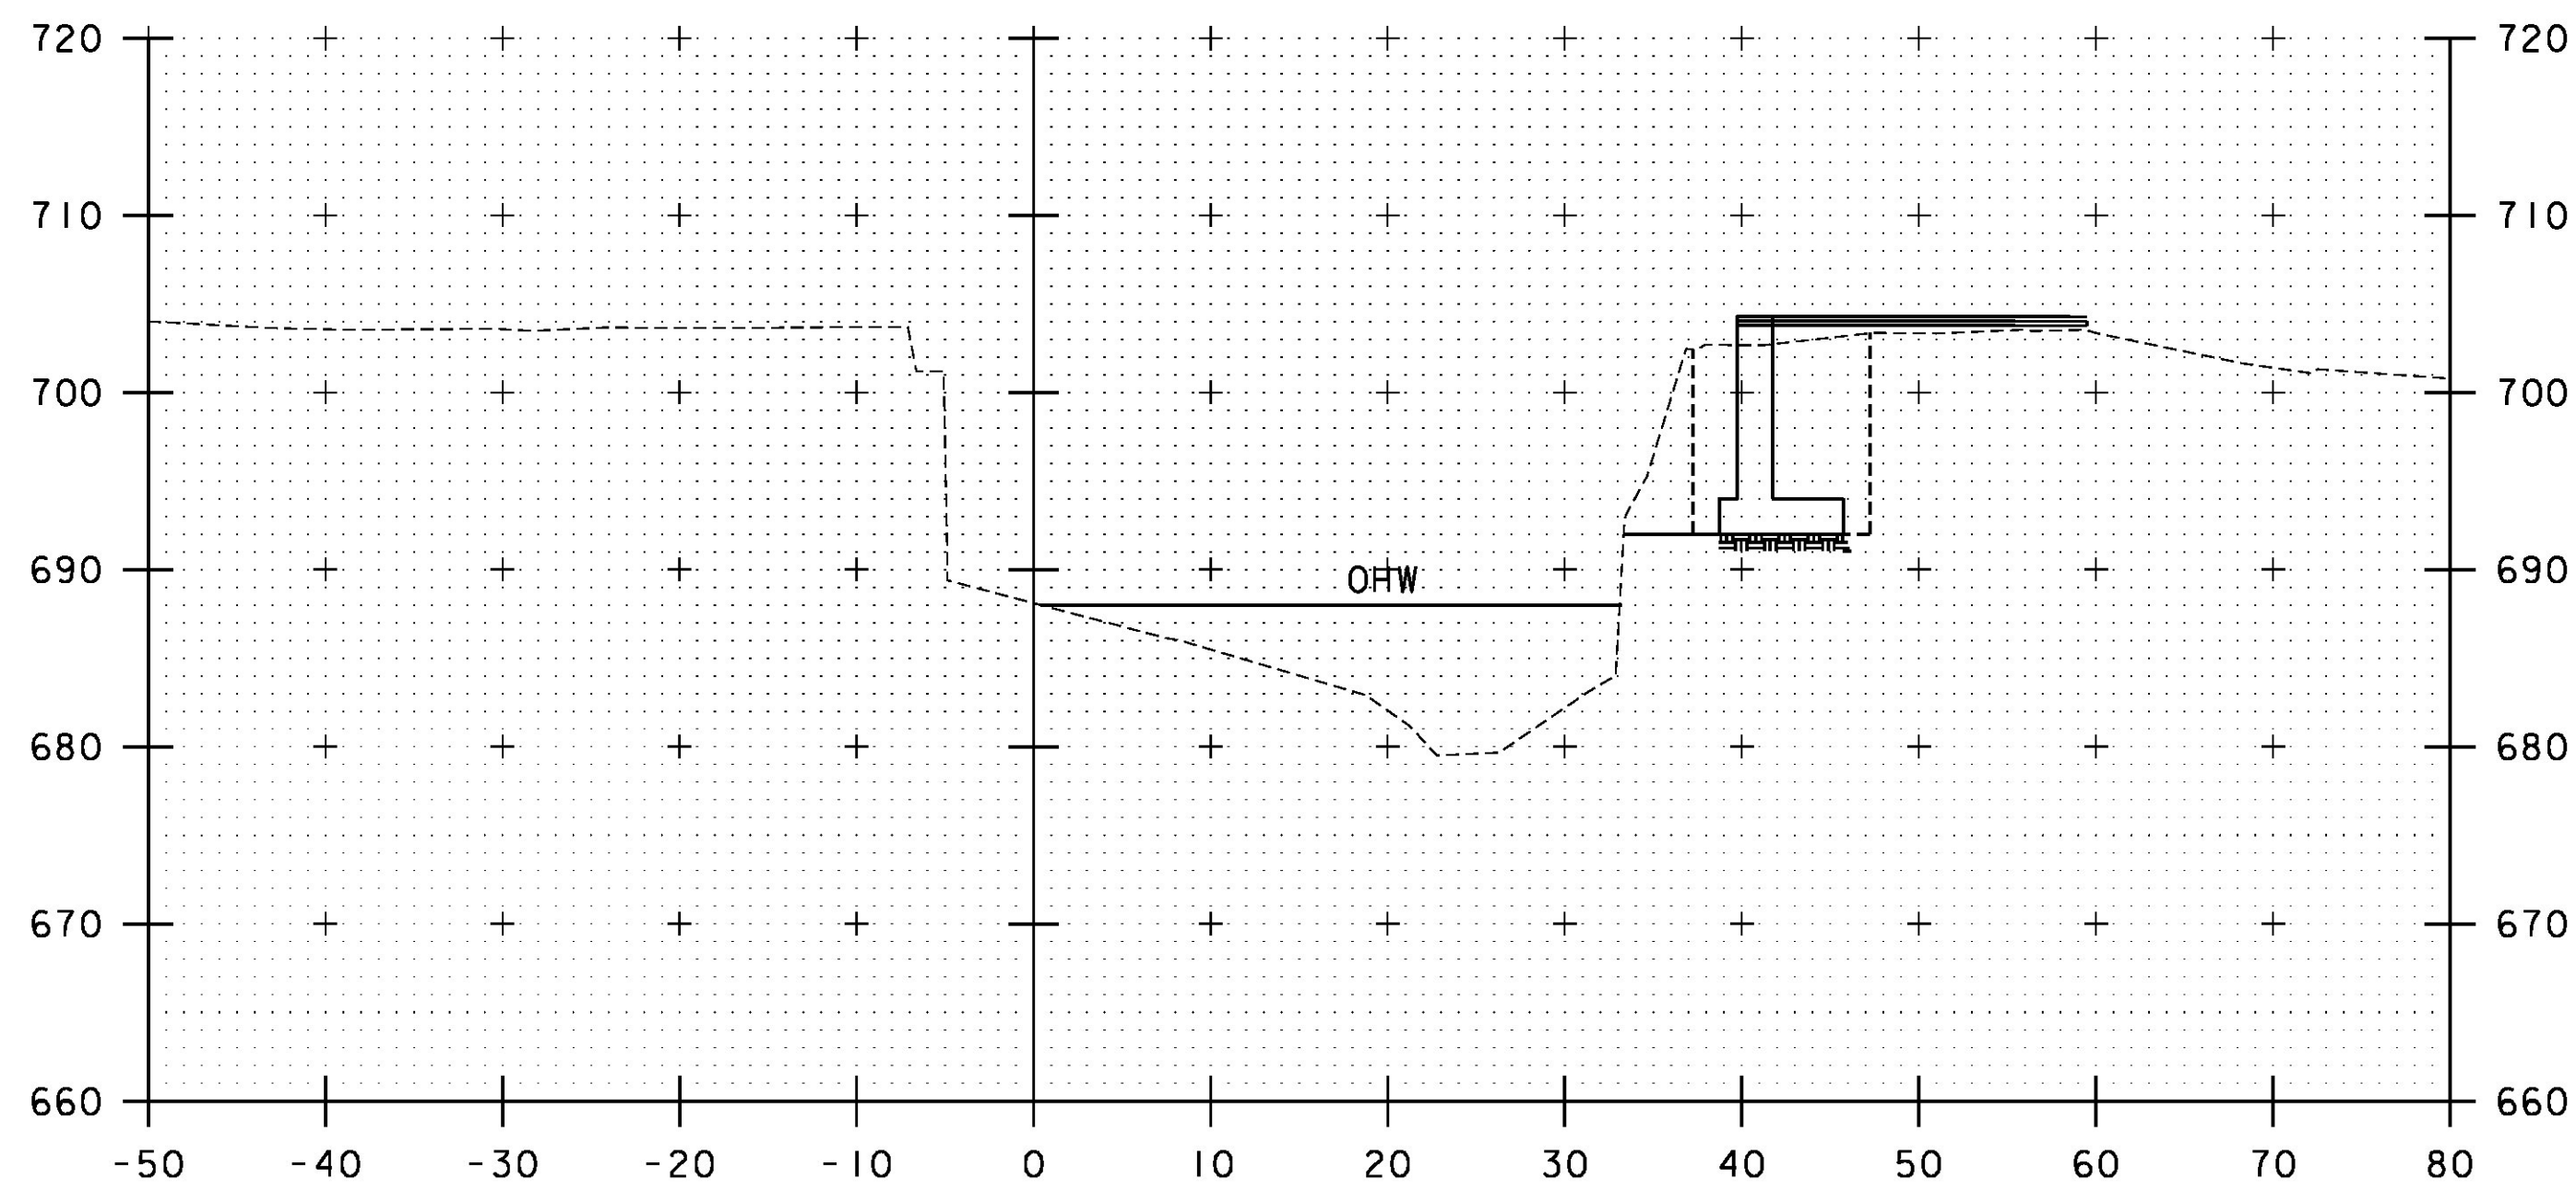


50+90

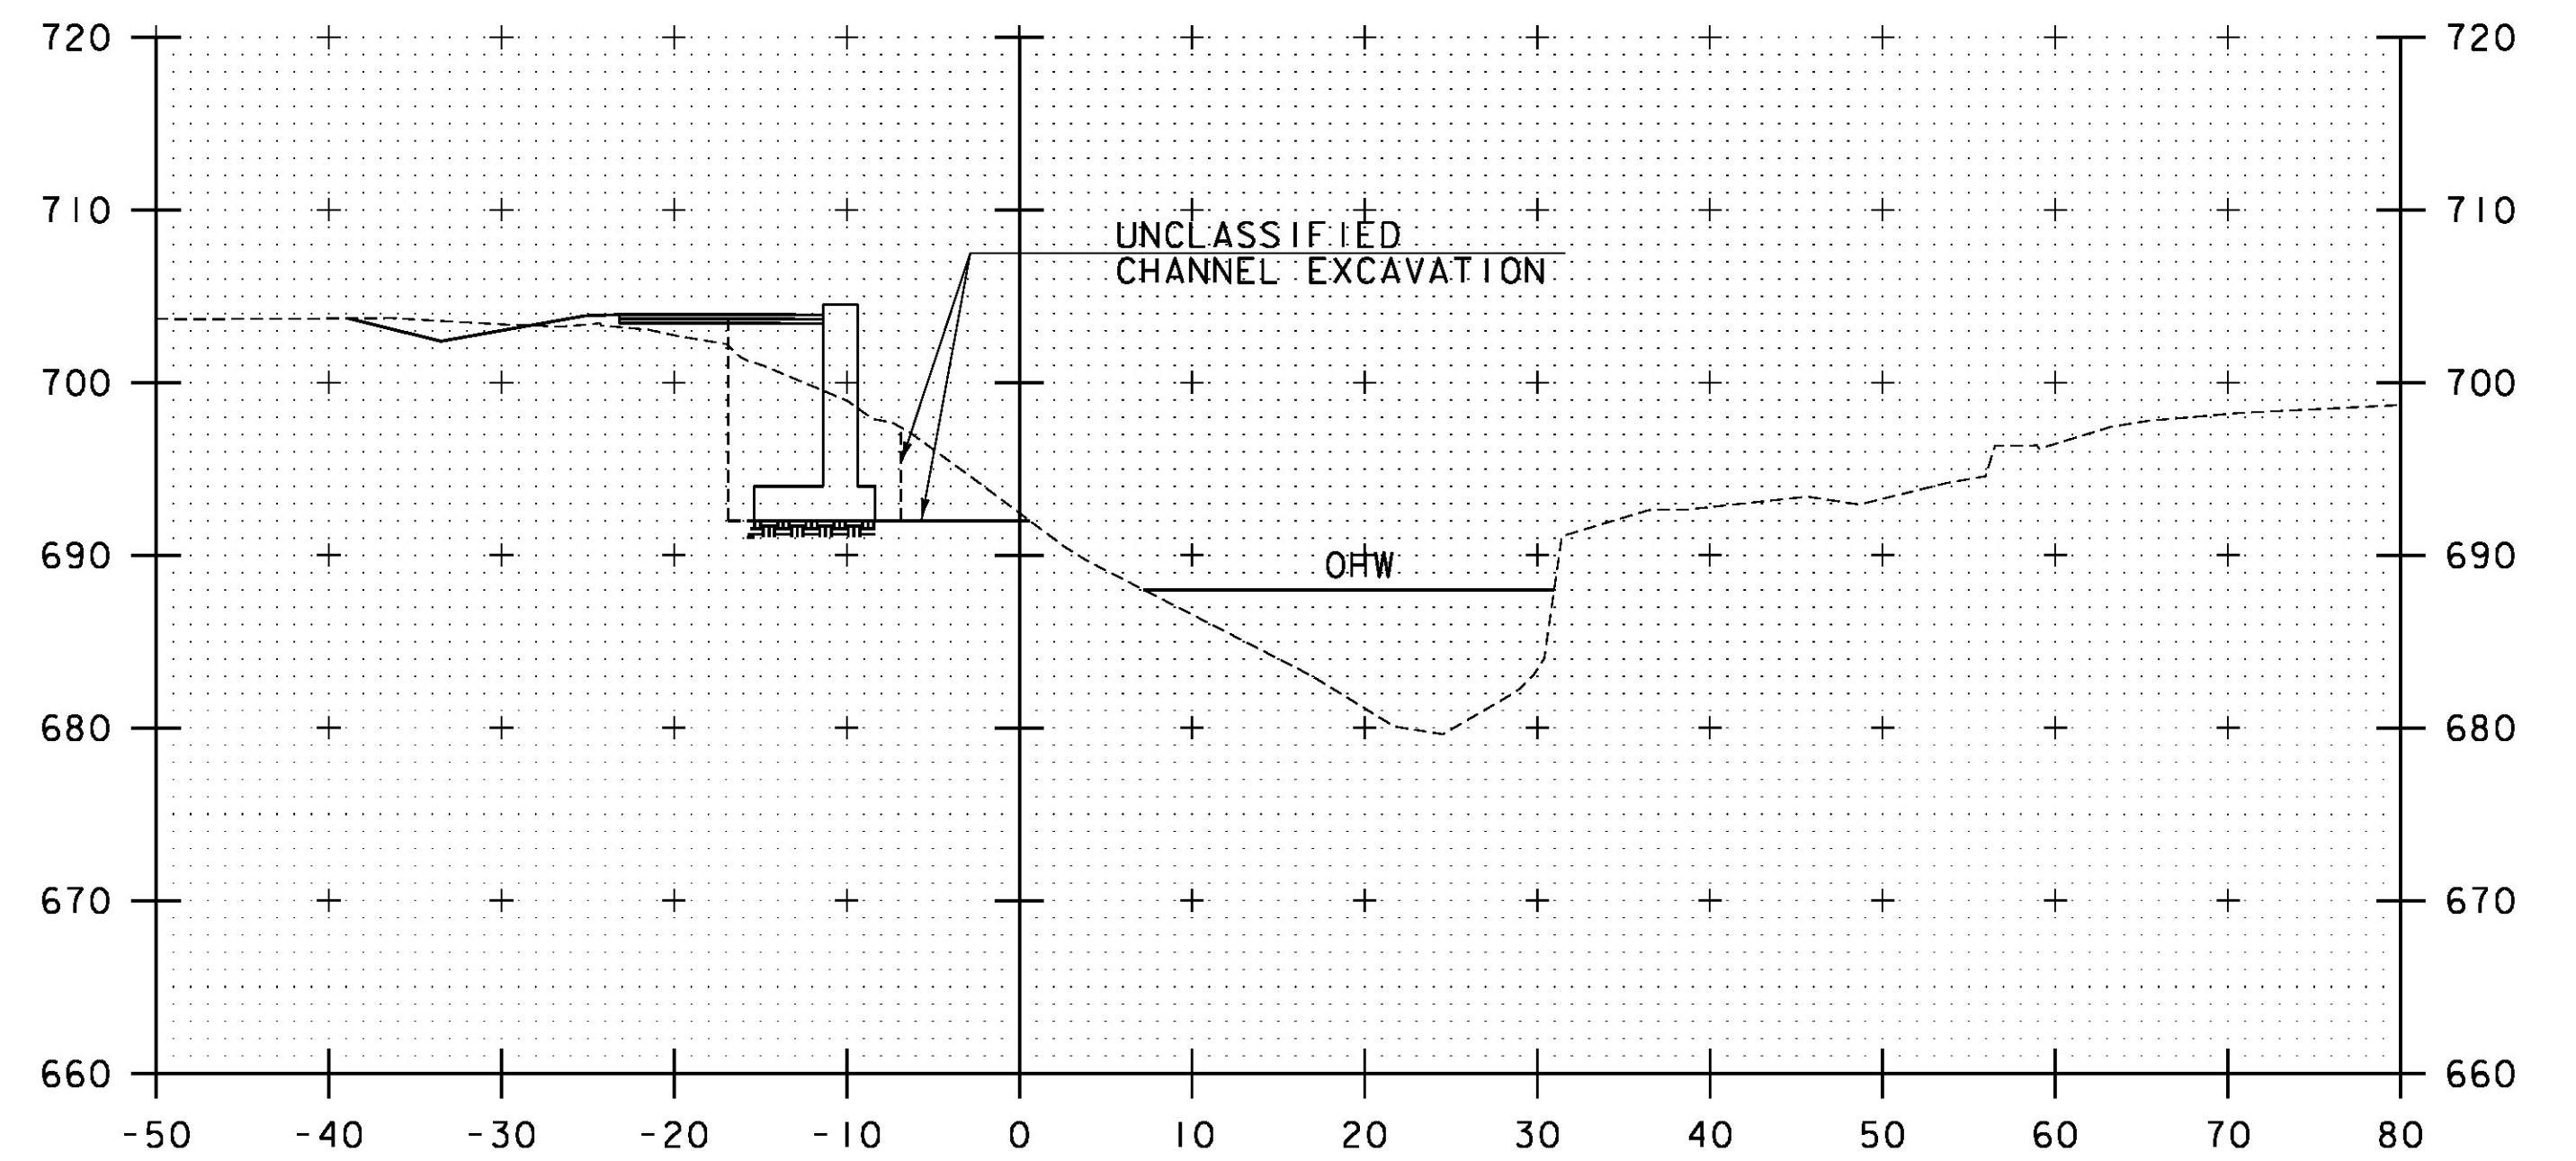

51+10

STA. 50+90 TO STA. 51+20

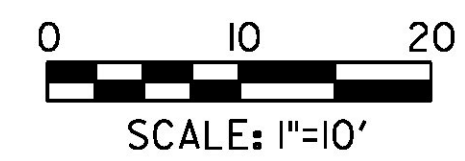

PROJECT NAME:	CORINTH
PROJECT NUMBER:	BRO 1447(29)
FILE NAME: ...drawing\z01j292_xs_channel.dgn	PLOT DATE: 8/4/2014
PROJECT LEADER: G. BOGUE	DRAWN BY: E. ALLING
DESIGNED BY: M. CHENETTE	CHECKED BY: G. BOGUE
CHANNEL CROSS SECTIONS - CXS 2	SHEET 49 OF 57

8/4/2014 12:44:44 PM V:\9533\active\95310795\Transportation\drawing\z01j292_xs_channel.dgn