




A PROJECTING STRAND & PROJECTING BAR BEND DETAIL
NB1.1 3/4" = 1'-0"

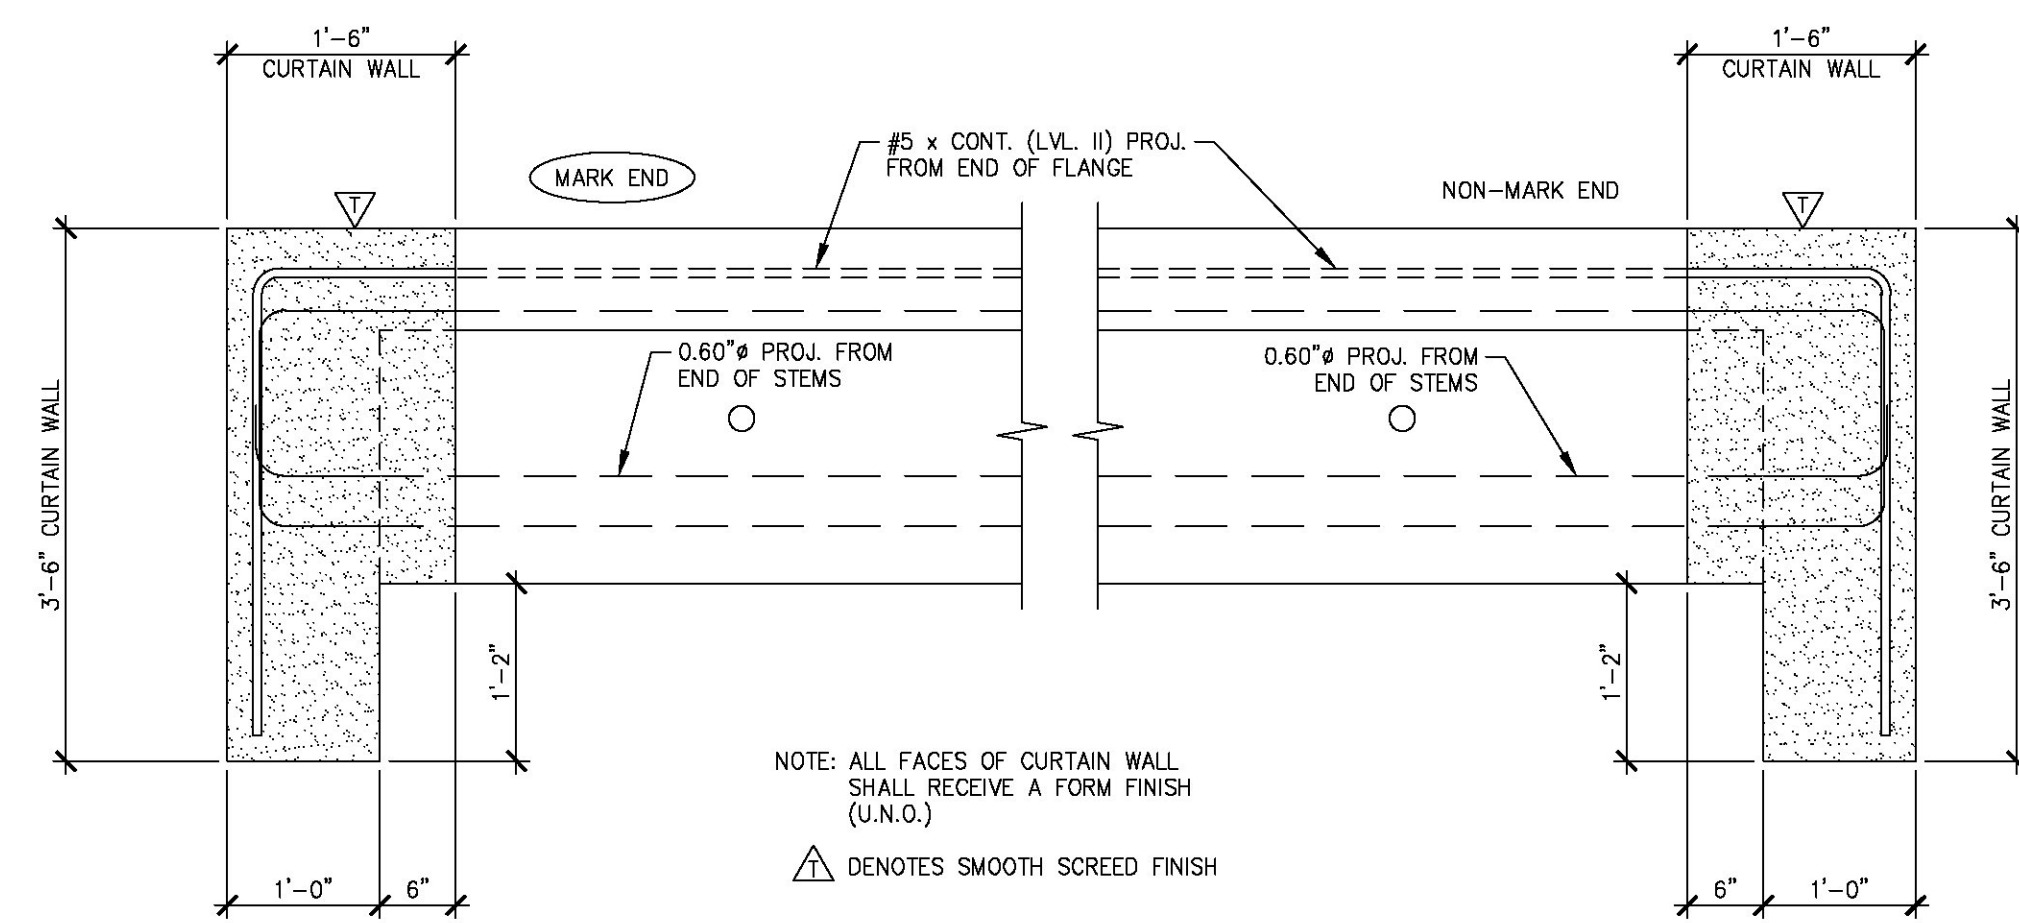

B CURTAIN WALL DIMENSIONAL SECTIONS
NB1.1 3/4" = 1'-0"

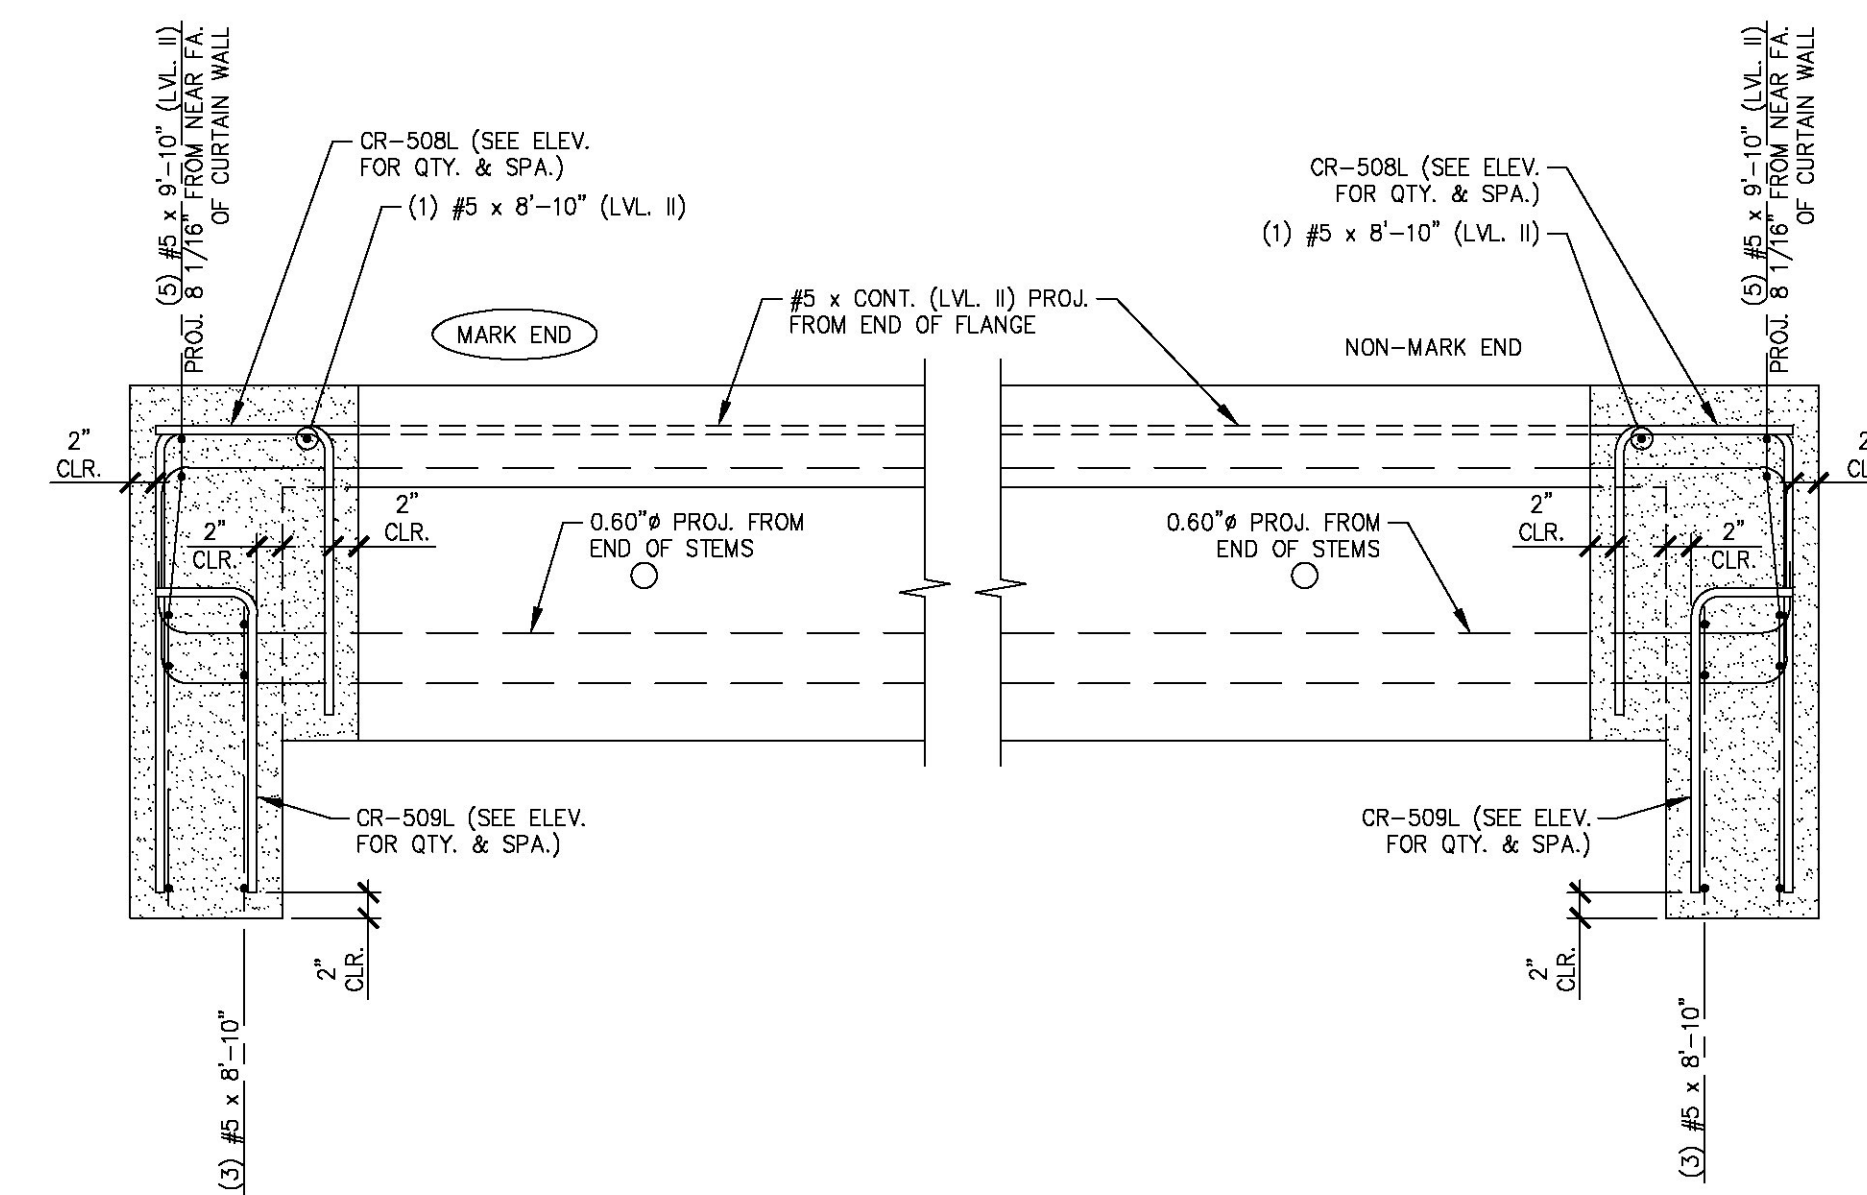

C CURTAIN WALL REINFORCING SECTIONS
NB1.1 SEE CURTAIN WALL ELEVATIONS FOR LONGITUDINAL BAR LENGTH CHANGES 3/4" = 1'-0"

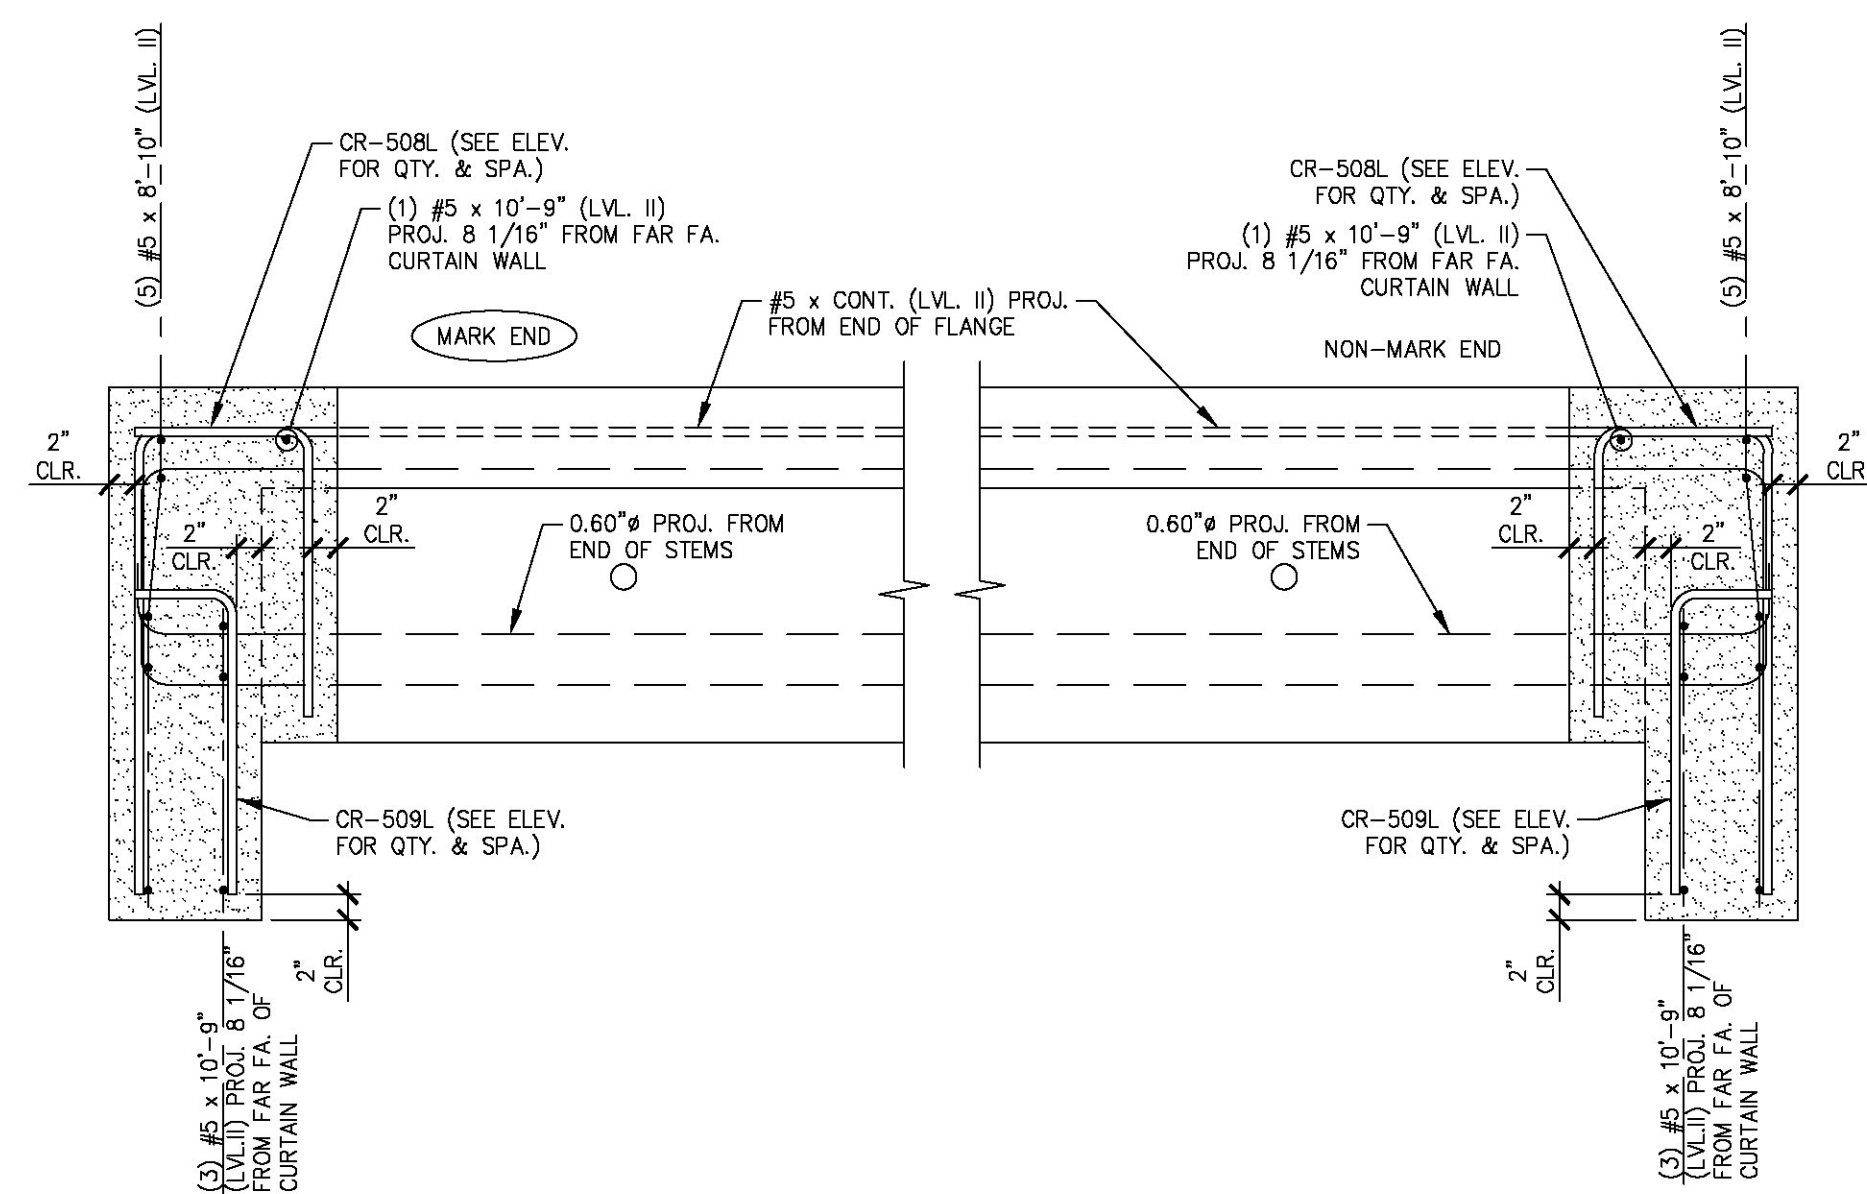

D CURTAIN WALL REINFORCING SECTIONS
NB1.1 SEE CURTAIN WALL ELEVATIONS FOR LONGITUDINAL BAR LENGTH CHANGES 3/4" = 1'-0"

APPROVED: Approval of drawings and/or procedures indicates concurrence with the information presented and does not relieve the Contractor or Fabricator of compliance with all specifications and code requirements.	
APPROVED AS NOTED	
REVISE AND RESUBMIT	
NOT REVIEWED	
Date: 3/27/2015	
By: Michael J. Chenette	
<small>This review by Stantec Consulting Services Inc. is for the sole purpose of ascertaining conformance with the general design concept. This review shall not mean that Stantec Consulting Services Inc. approves the detail design inherent in the shop drawings, responsibility for which shall remain with the Contractor. Submitting same, and such review shall not relieve the Contractor of his responsibility for errors or omissions in the shop drawing or of his responsibility for meeting all requirements of the Contract Documents. The contractor is responsible for dimensions to be confirmed and correlated at the job site, for information that pertains solely to the fabricator's processes or to techniques of construction and installation and for coordination of the work of all subcontractors.</small>	

APPROVAL STAMP:

J.P. CARRARA & SONS INC. Precast & Prestress Manufacturer <small>2464 CASE STR., MIDDLEBURY, VERMONT 05753 Phone:(802)388-6361 Fax:(802)388-9010</small>		AUSTIN CONSTRUCTION, INC. CONTRACTOR CONCORD, VERMONT	
STATE OF VERMONT AGENCY OF TRANSPORTATION COUNTY OF ORANGE		DATE: MAR. 13, 2015 SCALE: NOTED	
TOWN OF CORINTH CHICKEN FARM ROAD T.H.16 CLASS 3 LOCAL ROAD BRIDGE NO.: 36 PROJECT NO.: BRO 1447 (29)		CHKD: RM	DFTM: PSS
PRECAST CURTAIN WALL DETAILS		JOB NO: 23448-014 DWG. NO: NB1.1	