

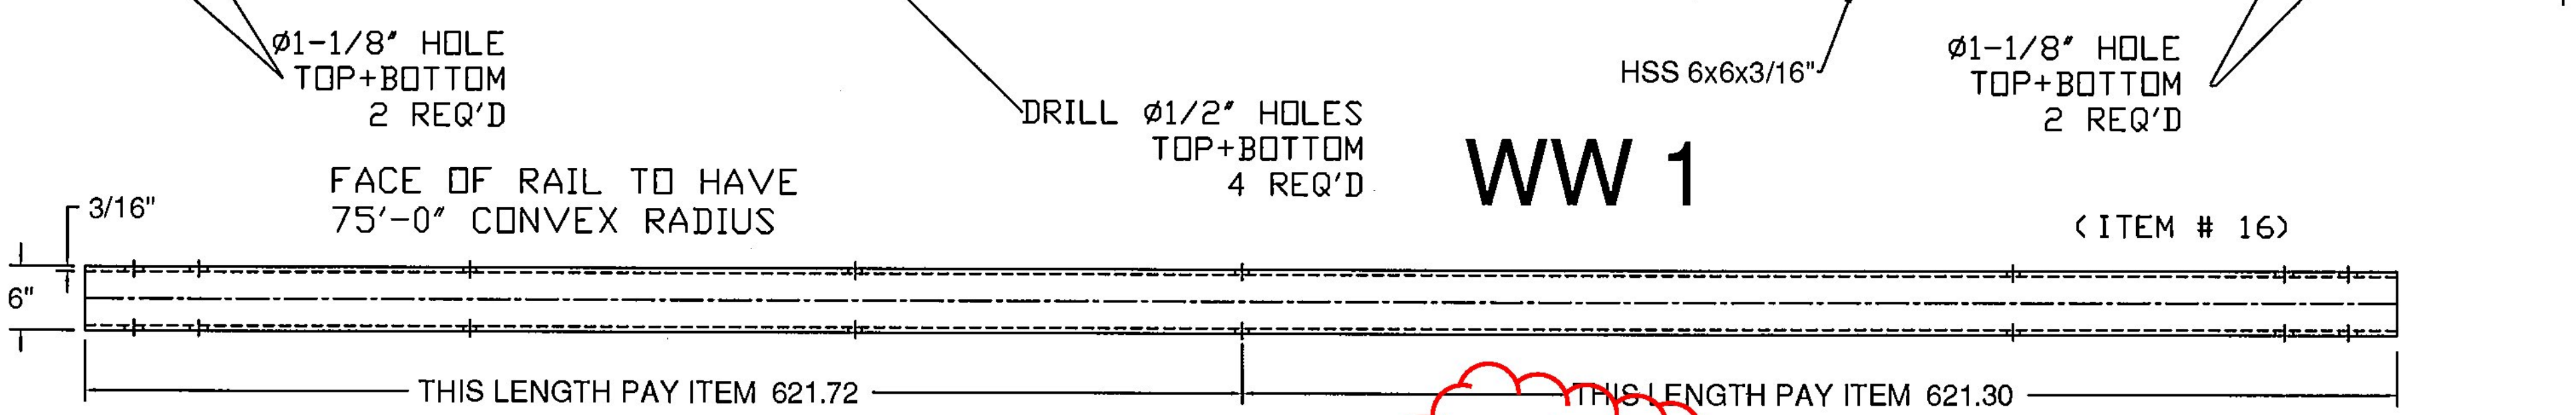
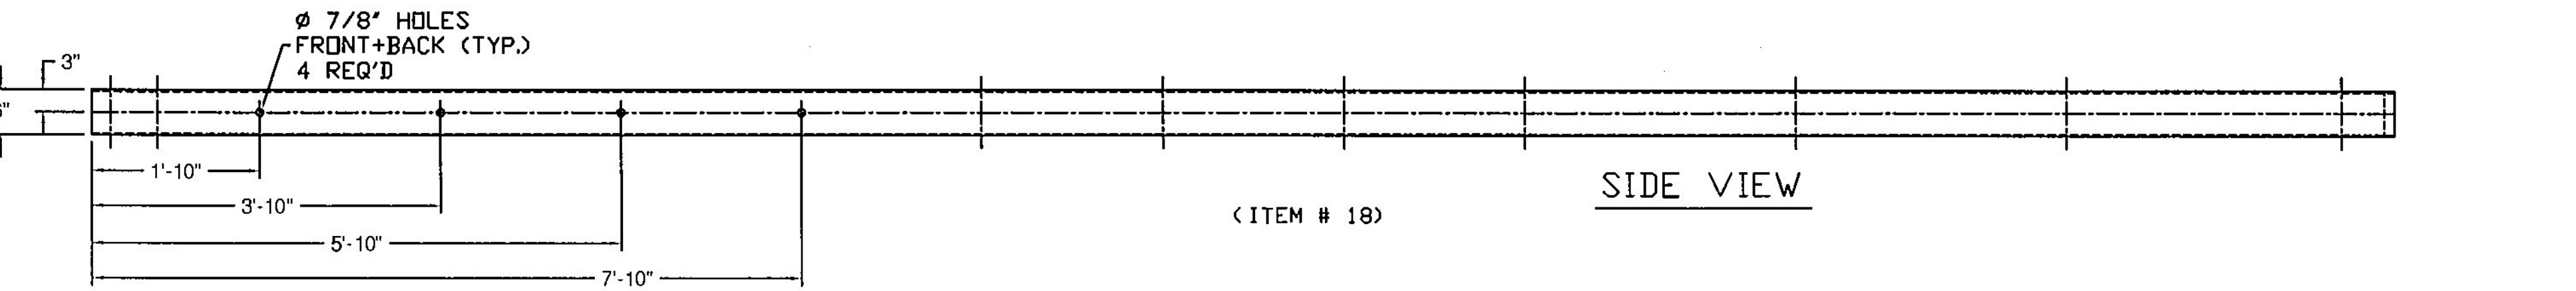
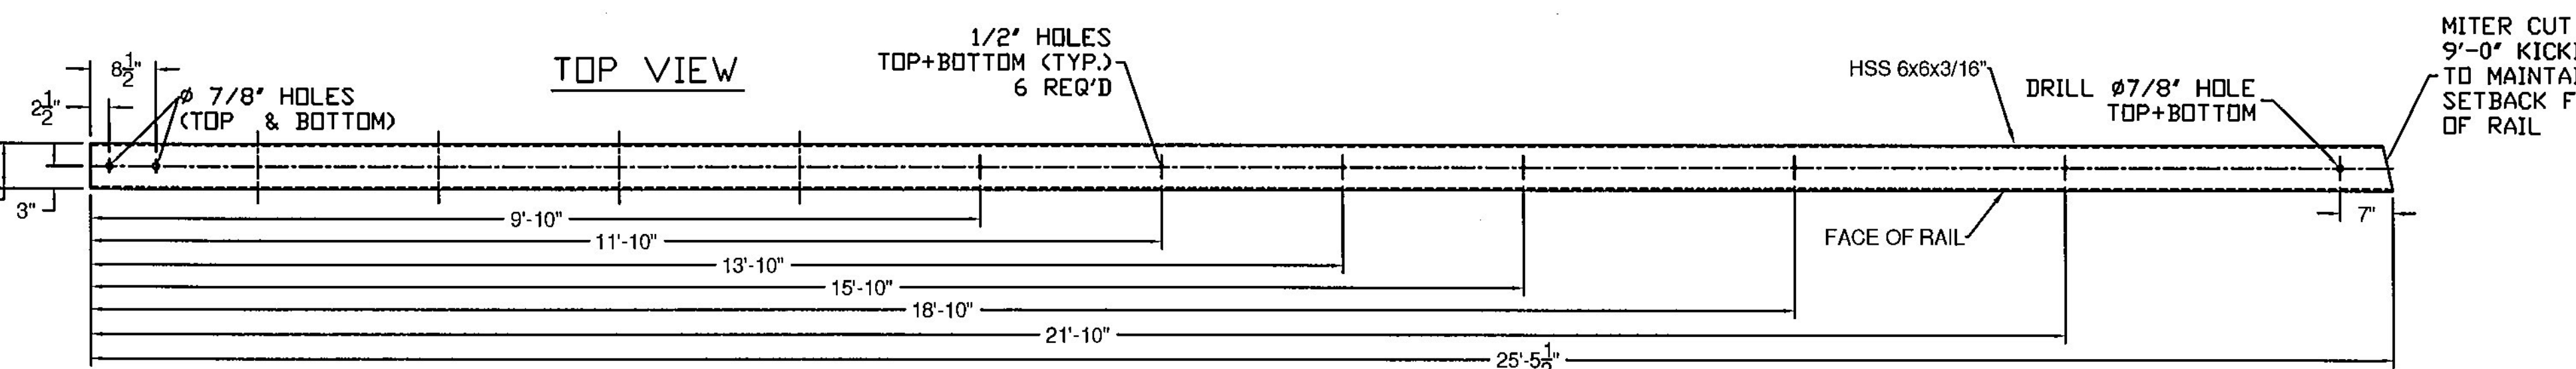


WW 1

(ITEM # 16)

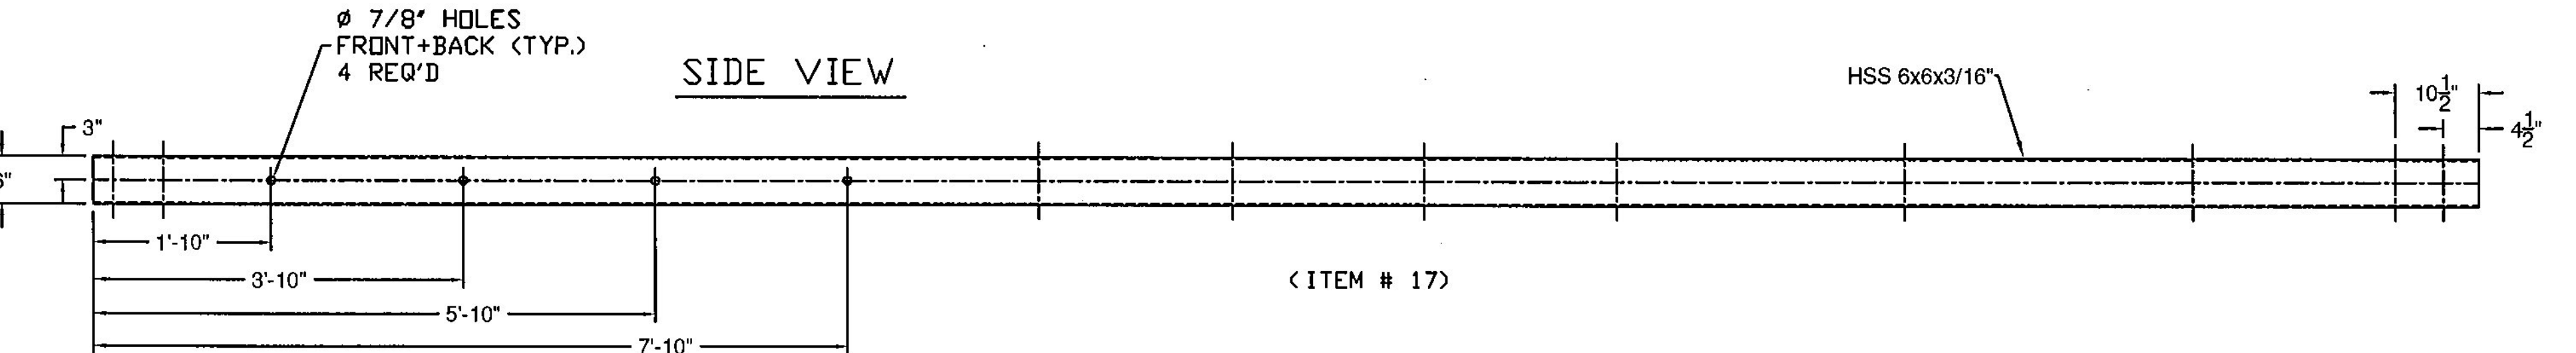

WW 1 - FACE OF RAIL TO HAVE 75'-0" CONVEX RADIUS.
 WW 2 - FACE OF RAIL TO HAVE 20'-0" CONVEX RADIUS.

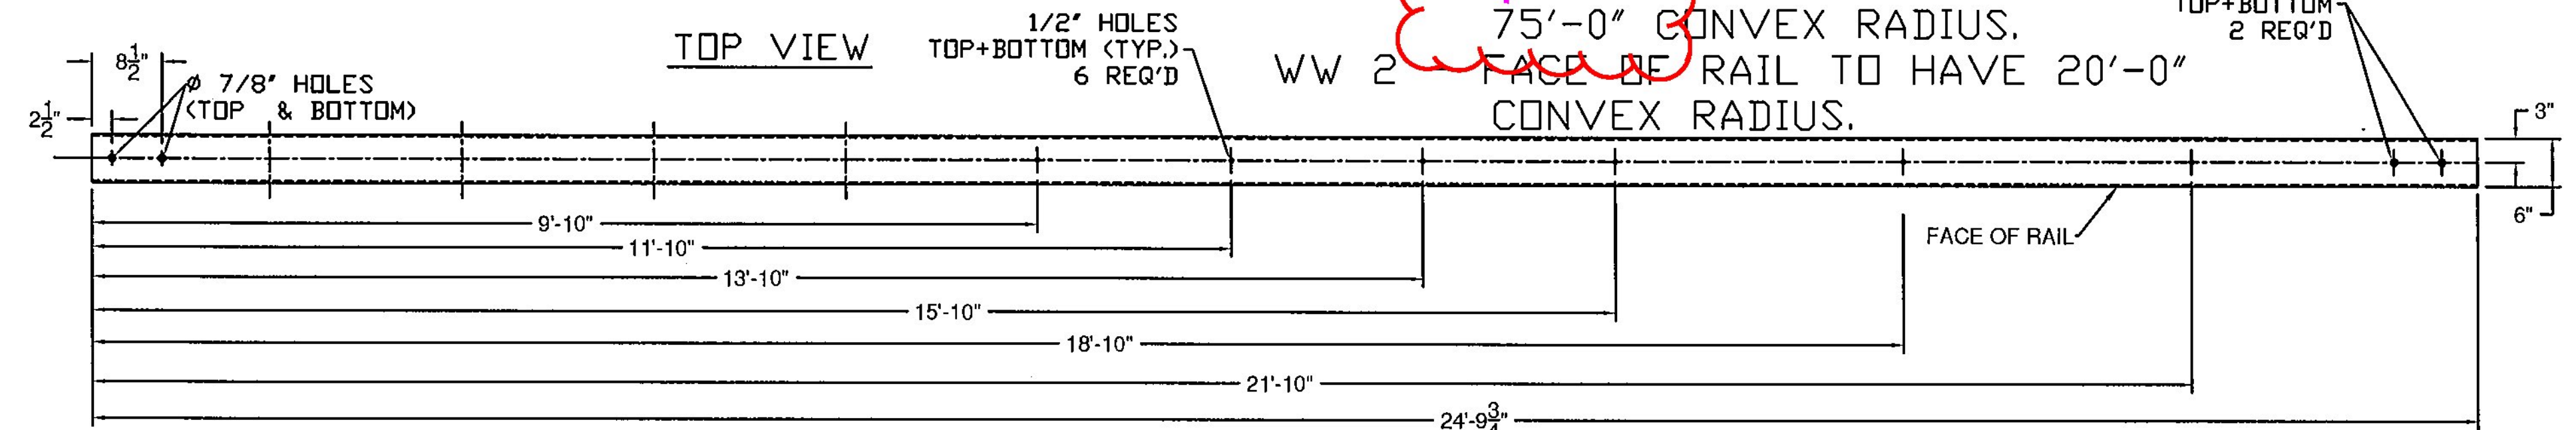

APPROVED: Approval of drawings and/or procedures indicates concurrence with the information presented and does not relieve the Contractor or Fabricator of compliance with all specifications and code requirements		
APPROVED AS NOTED	X	
REVISE AND RESUBMIT		
NOT REVIEWED		
Date: 3/10/2015		
By: Michael J. Chenette		
<p>This review by Stantec Consulting Services Inc. is for the sole purpose of ascertaining conformance with the general design concept. This review shall not mean that Stantec Consulting Services Inc approves the detail design inherent in the shop drawings, responsibility for which shall remain with the Contractor. Submitting same, and such review shall not relieve the Contractor of his responsibility for errors or omissions in the shop drawing or of his responsibility for meeting all requirements of the Contract Documents. The contractor is responsible for dimensions to be confirmed and correlated at the job site, for information that pertains solely to the fabrication processes or to techniques of construction and installation and for coordination of the work of all subtrades.</p>		

ITEM #: 900.620 SHEET 5 OF 5

STRUCTURAL STEEL TO COMPLY W/ ASTM A6

Galvanized 2-Rail Box Beam Guardrail Approach Section

EM14-202, CHICKEN FARM ROAD (T.H.16) CLASS 3 LOCAL ROAD, BRIDGE NO : 36
 PROJECT: 618 CORINTH BRO 1447(29), TOWN OF CORINTH, ORANGE COUNTY, VT

R NO.	DATE	DESCRIPTION	BY	R NO.	DATE	DESCRIPTION	BY
E 1	3/5/15	REVISED PER 3/4/15 MARK-UP	E.P.				

TOLERANCE UNLESS OTHERWISE NOTED:
 FRACTIONS = ± 1/16"
 ANGLES = ± 1/2"
 DIAMETERS = ± 1/32"

ELDERLEE, INC.
 OAKS CORNERS, NEW YORK 14578
 E-Mail: dlong@elderlee.com / epeek@elderlee.com
 Tel: 315-789-6670 Fax: 315-789-6615

DRAWN	E.P.	12/15/14
CHECKED	D.L.	12/16/14
APPROVED	M.V.	
SCALE	SCHEMATIC	
DRAWING NO. FR L - CORINTH-T		