

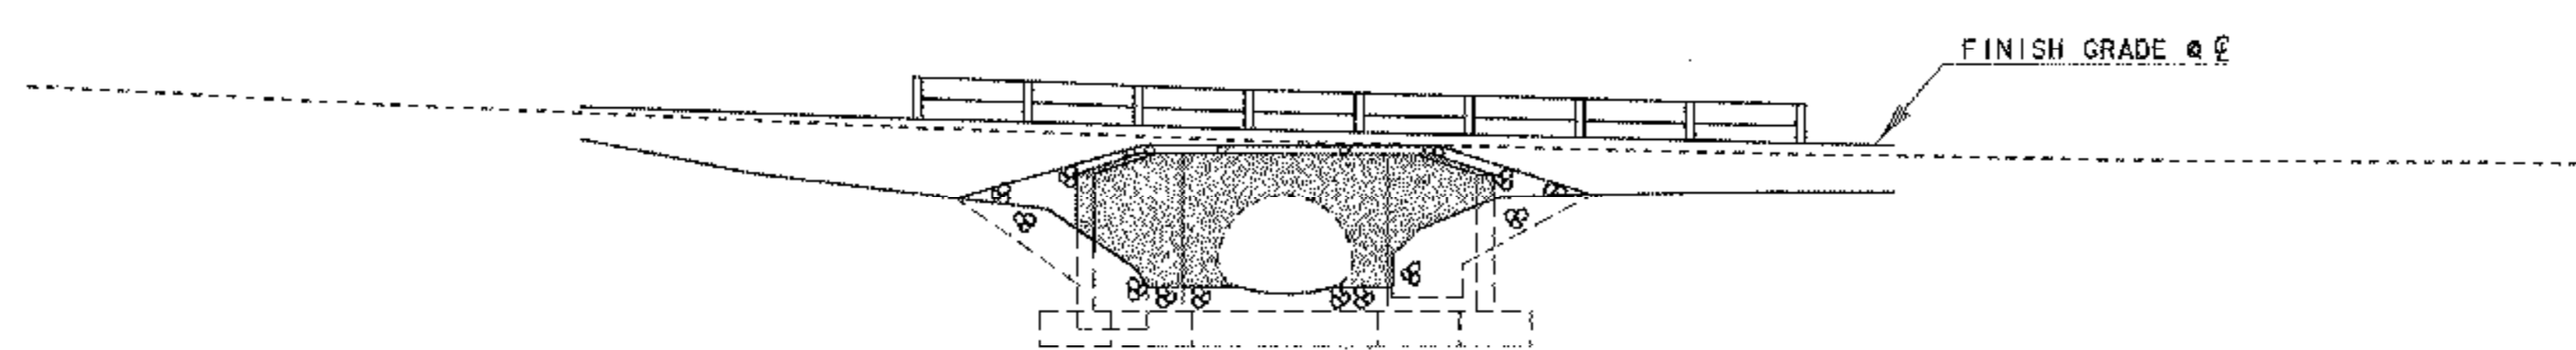
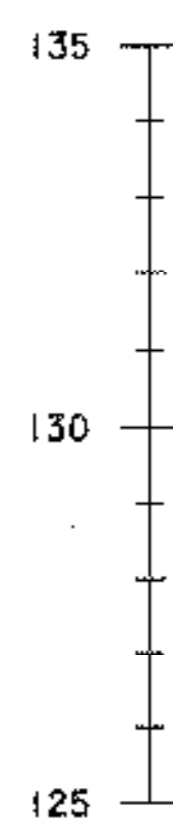


MAINLINE STA. $ah\ 15+282.18$
 CHANNEL LINE STA. $110+000.00$
 ASKEW $85^{\circ}-18'-53''$ FROM
 TANGENT TO CURVE

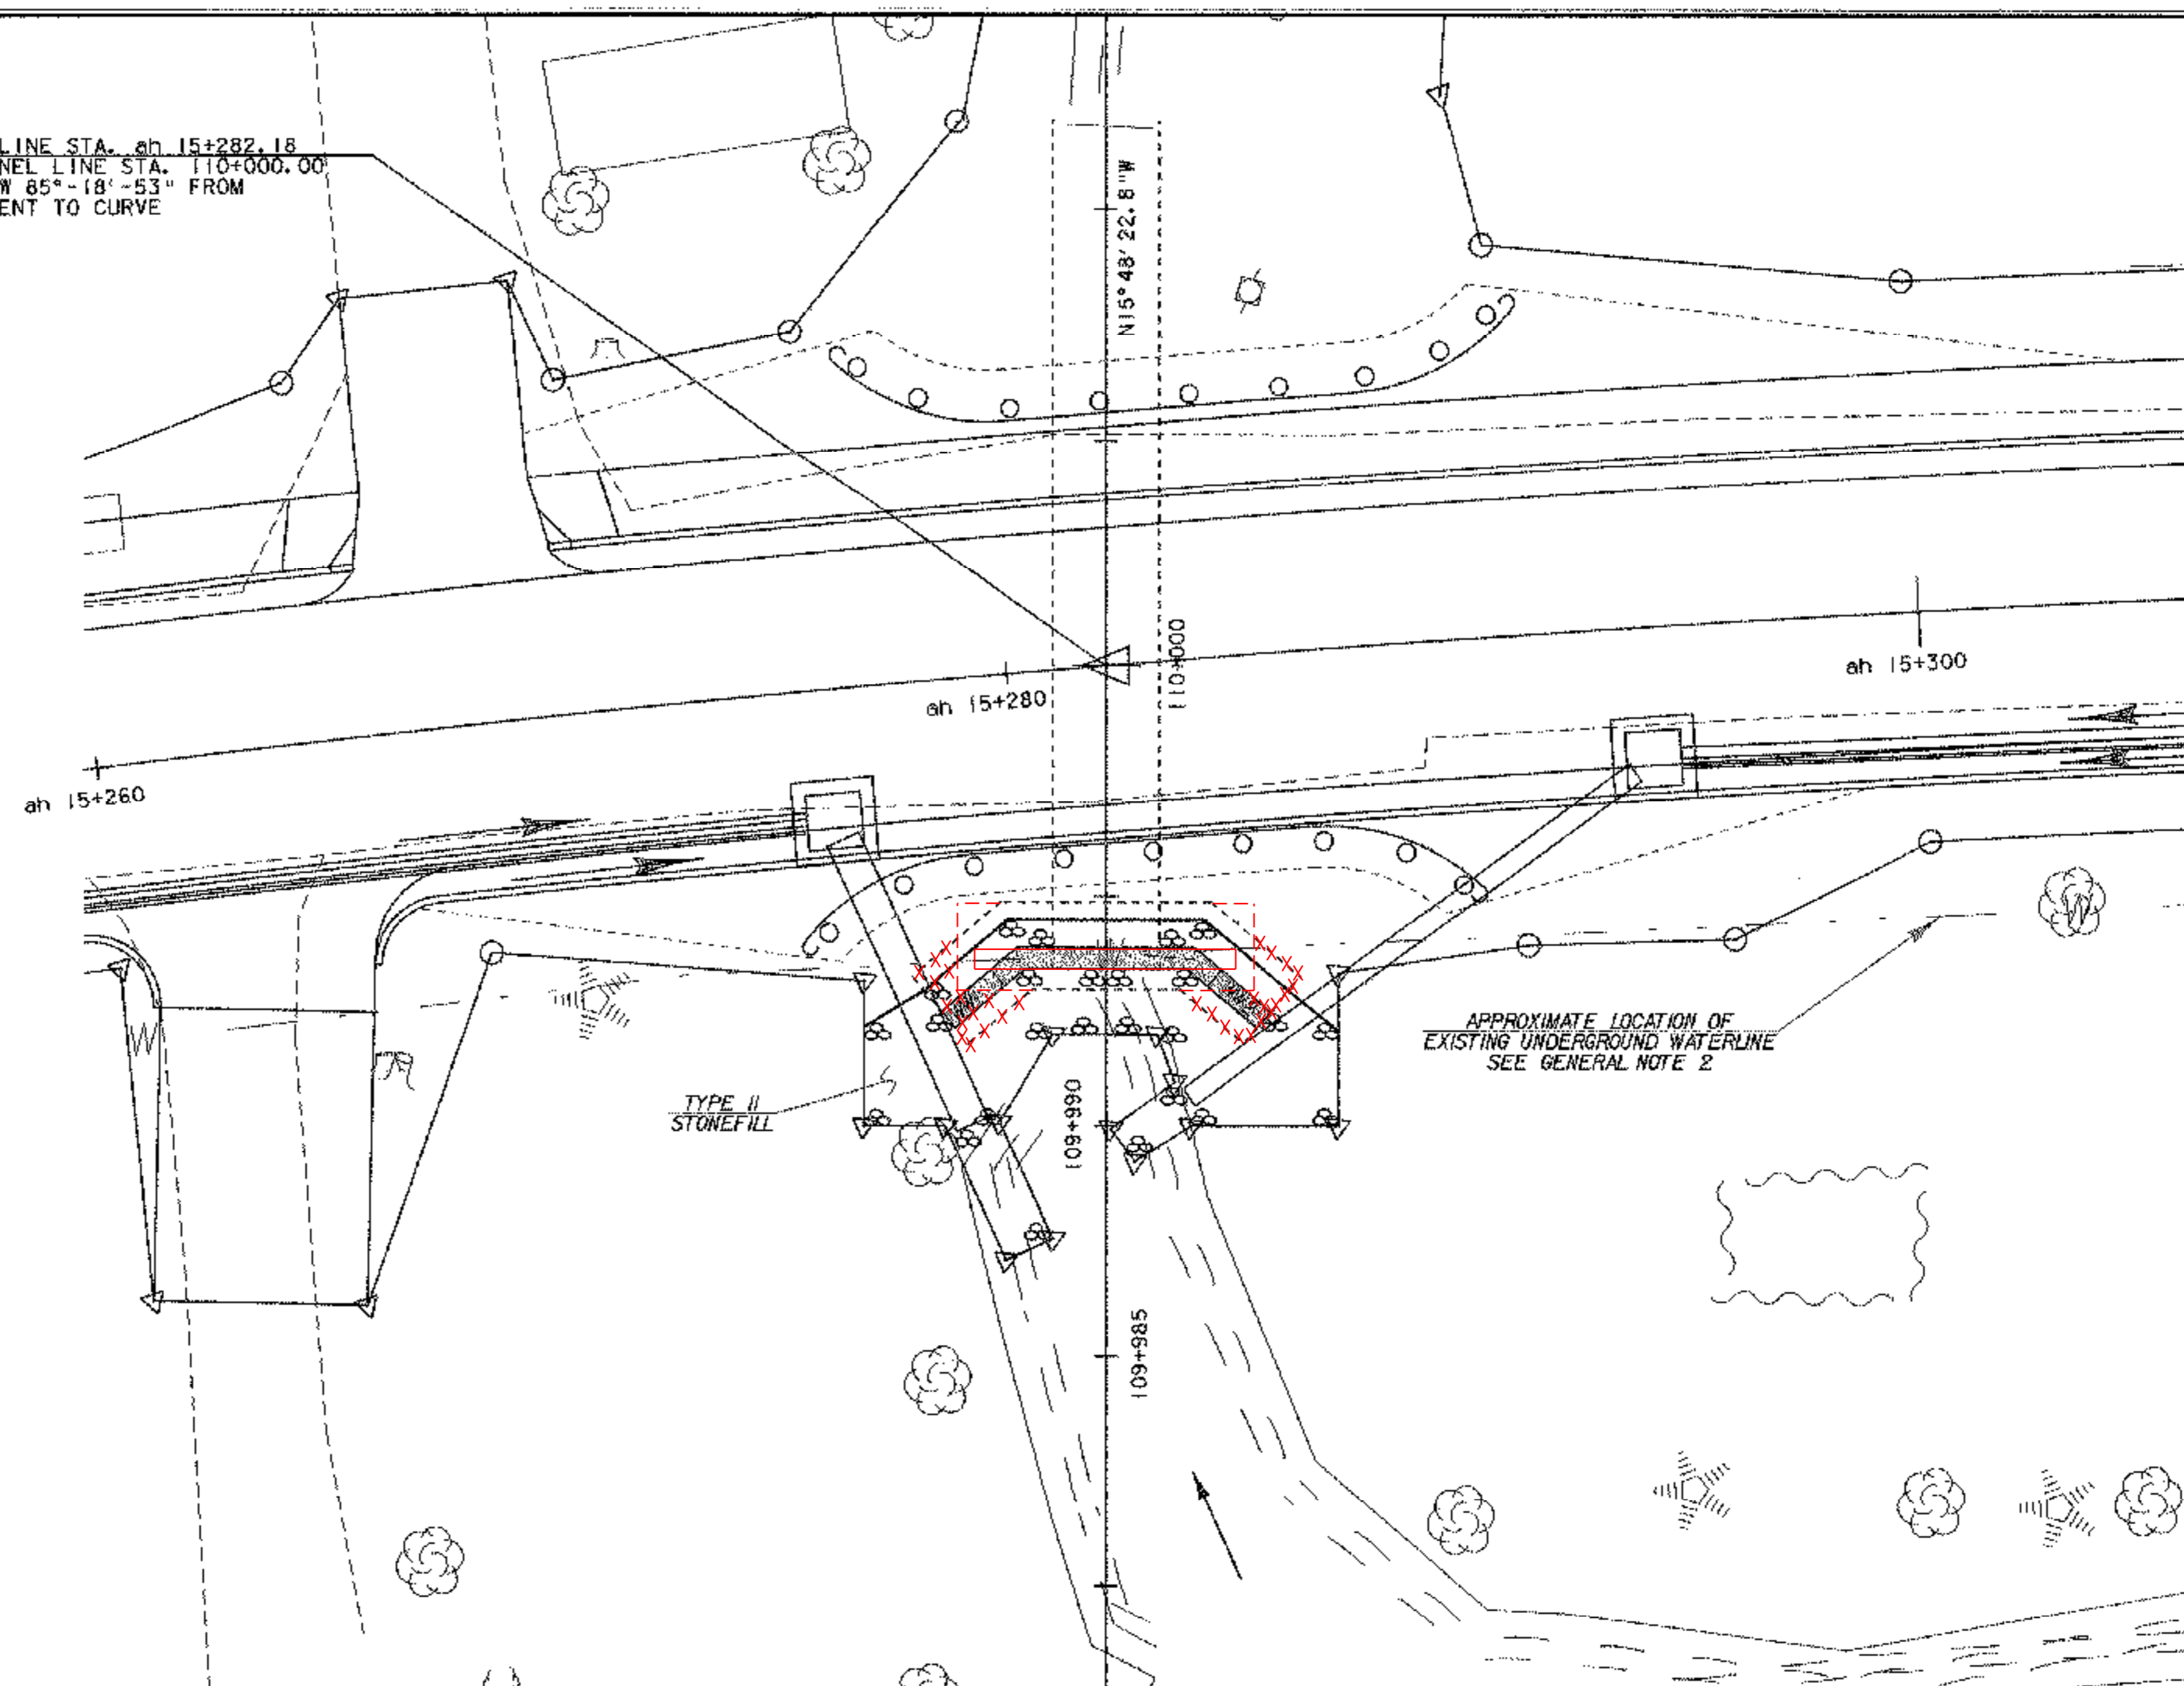

ELEVATION VIEW

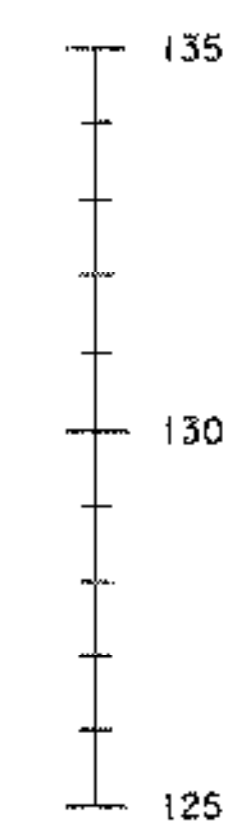

PLAN AND ELEVATION SHEET

PROJECT NAME: FRANKLIN
 PROJECT NUMBER: STP 030(K18)

FILE NAME: /85c060/str/sc85c060bdr.dg PLOT DATE: 21-MAR-2003
 PROJECT LEADER: S. FARNSWORTH DRAWN BY: R. PELLETT
 DESIGNED BY: M. FOWLER CHECKED BY: C. SPILAK
 sc060pel5282.j SHEET 24 OF 60

