

PAVMENT MARKING & TRAFFIC SIGNING LAYOUT




TEMPORARY 100mm WHITE LINE
M/L ah 15+120 LT ~ SL 26+060 LT. EDGE LINE-SOLID
S/L 26+060 RT ~ ah 15+300 LT. EDGE LINE-SOLID
M/L ah 15+120 ~ ah 15+300 RT. EDGE LINE-SOLID

DURABLE 100mm WHITE LINE
M/L ah 15+120 LT ~ SL 26+060 LT. EDGE LINE-SOLID
S/L 26+060 RT ~ ah 15+300 LT. EDGE LINE-SOLID
M/L ah 15+120 ~ ah 15+300 RT. EDGE LINE-SOLID


TEMPORARY 100mm YELLOW LINE
M/L ah 15+120 C/L ~ 15+198 C/L DBL. LINE-SOLID
M/L ah 15+210 C/L ~ ah 15+300 C/L DBL. LINE-SOLID
S/L 26+010 C/L ~ 26+060 C/L DBL. LINE-SOLID

DURABLE 100mm YELLOW LINE
M/L ah 15+120 C/L ~ ah 15+198 C/L DBL. LINE-SOLID
M/L ah 15+210 C/L ~ ah 15+300 C/L DBL. LINE-SOLID
S/L 26+010 C/L ~ 26+060 C/L DBL. LINE-SOLID

REMOVING SIGNS
ah 15+212 C/L LT (2) 3
S/L 26+045 S/L RT.
15+199 LT

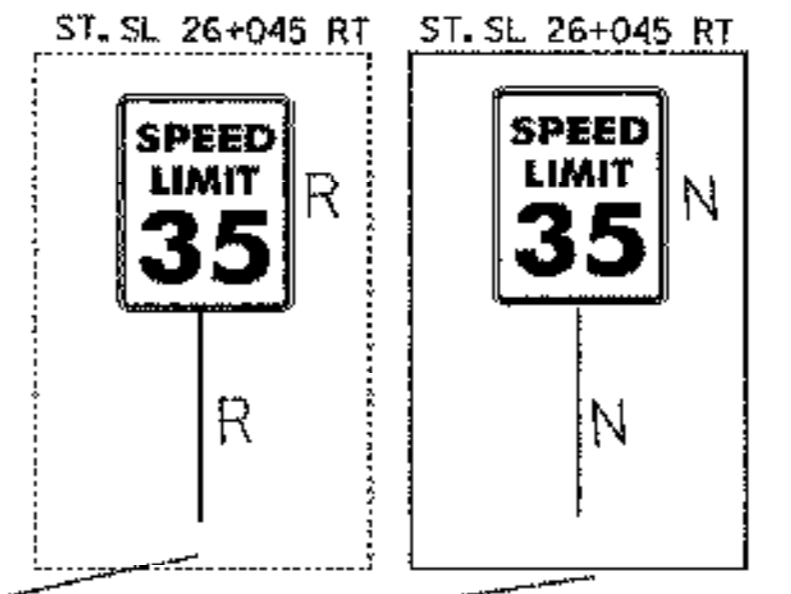


DURABLE 24" STOP BAR
S/L 26+004 C/L ~ 26+04.5 C/L LT (7M)
DURABLE LETTER OR SYMBOL
S/L 26+013.5 C/L ~ 26+015.9 C/L LT (STOP)

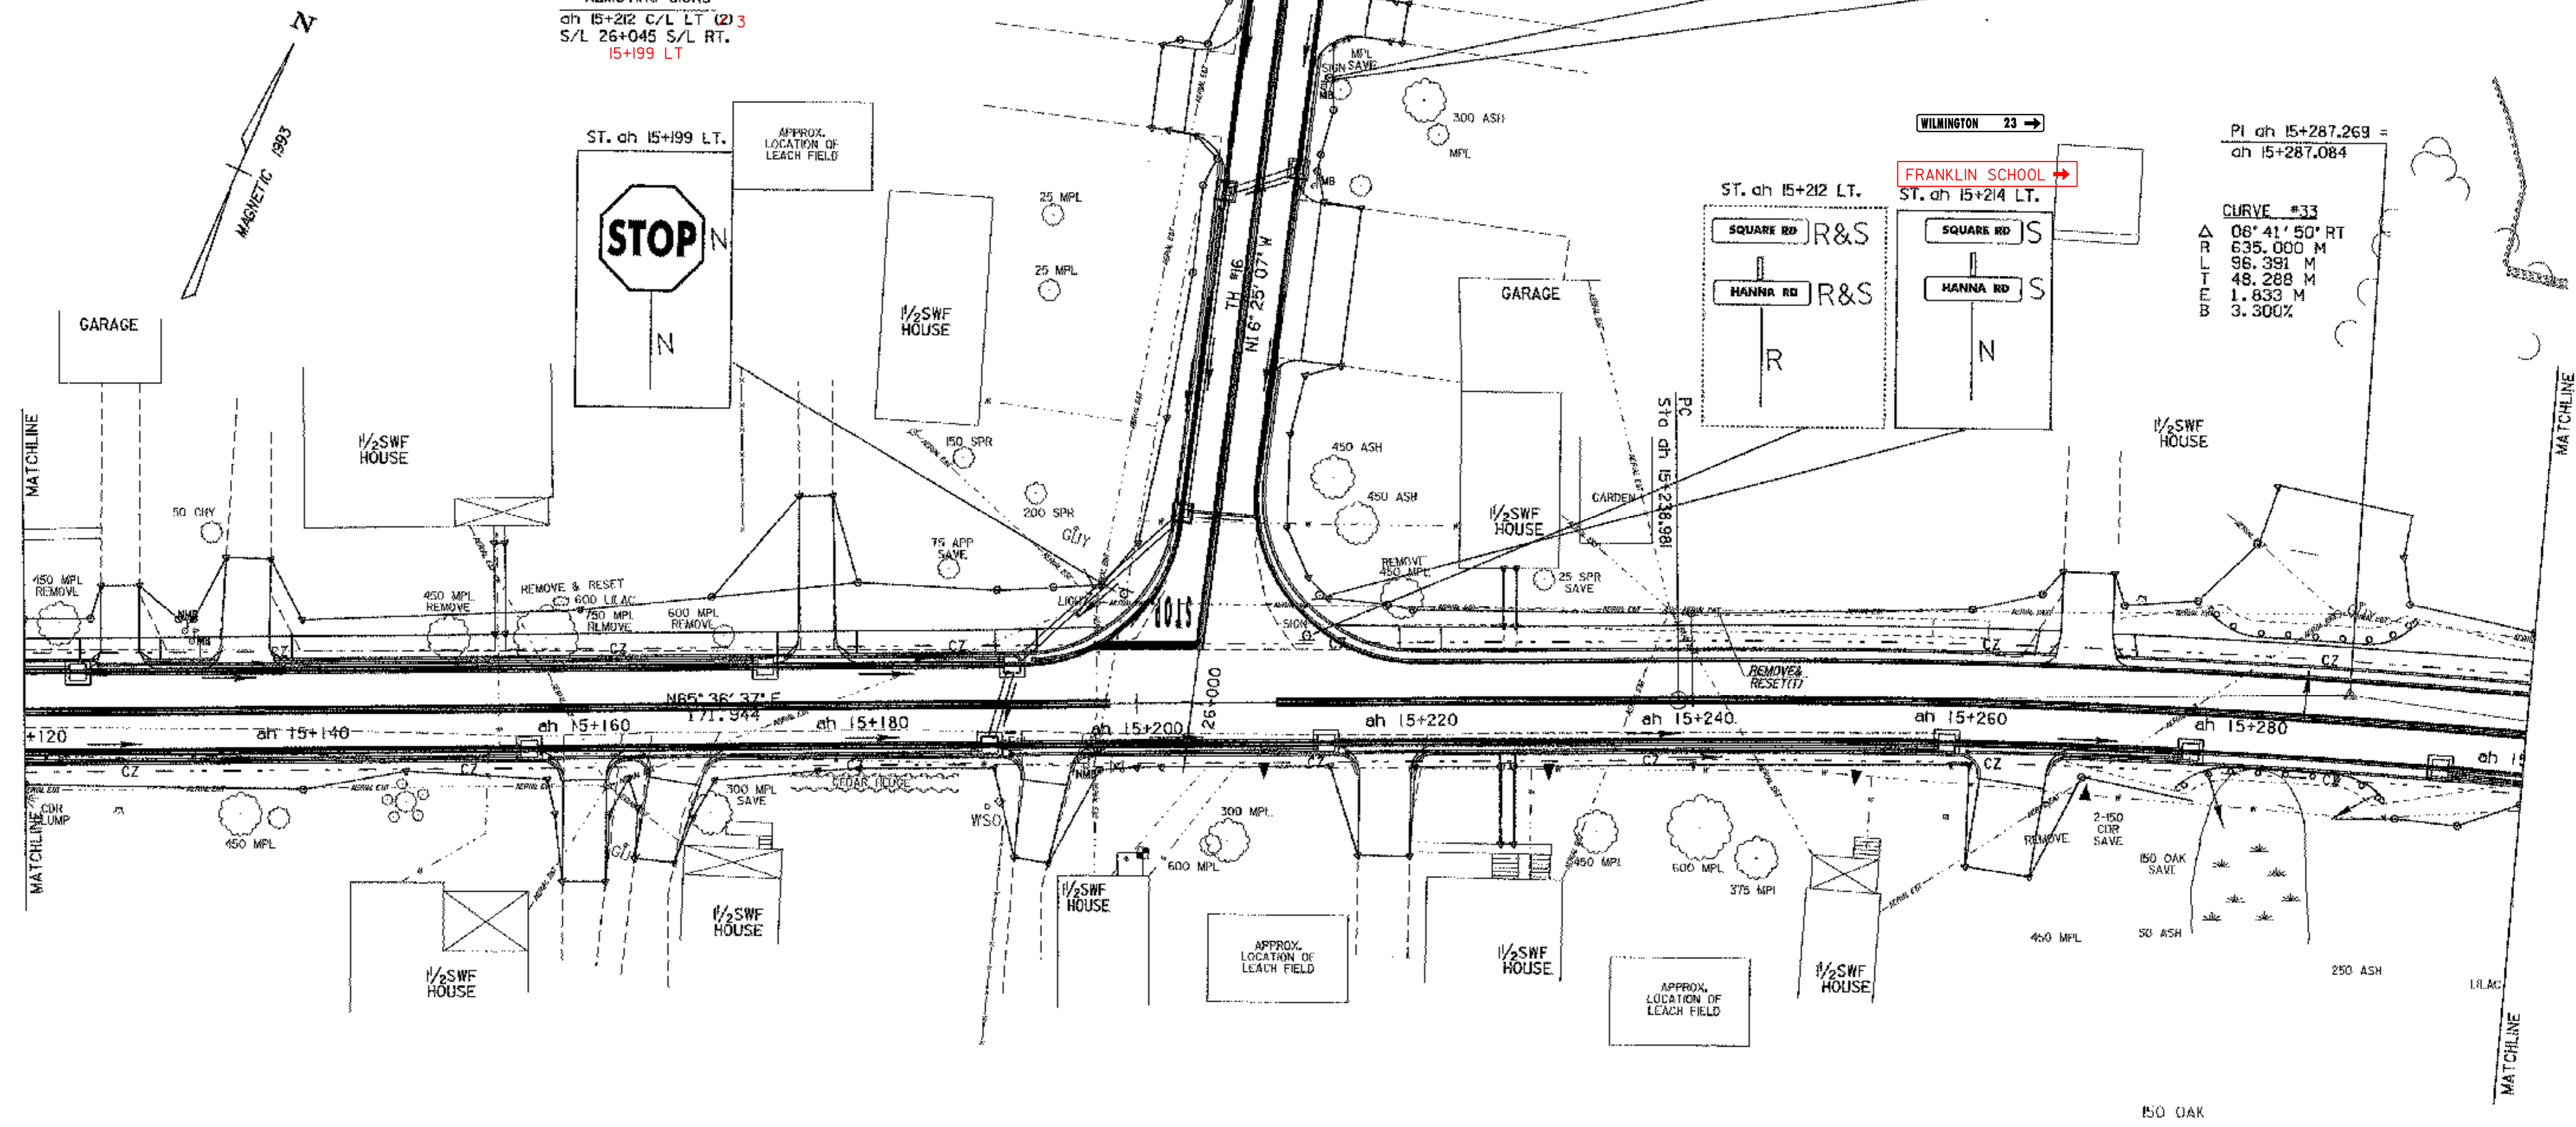

PI ah 15+287.269 =
ah 15+287.084
CURVE #33
Δ 08° 41' 50" RT
R 635.000 M
L 96.391 M
T 48.288 M
E 1.833 M
B 3.300%

LEGEND
R = REMOVE
N = NEW
R&S = REMOVE & SALVAGE
RET = RETAIN

PAVEMENT MARKING & TRAFFIC SIGNING LAYOUT

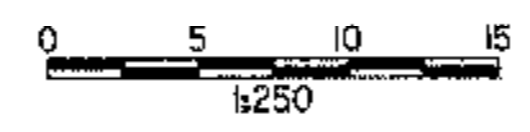

○ DENOTES TREE OR STUMP REMOVAL

ALL DRIVE RADII SHALL BE 6M UNLESS OTHERWISE NOTED PER STD B-71M

PROJECT NAME:	FRANKLIN
PROJECT NUMBER:	STP 0301(18)
FILE NAME:	...85c060/design/dc060bdr.dgn
PLOT DATE:	27-MAR-2003
PROJECT LEADER:	DELLASANTA
DRAWN BY:	SQUAD B
DESIGNED BY:	SQUAD B
CHECKED BY:	SQUAD B
IPARM FILE NAME:	(2) dc060pms2
SHEET	35 OF 60