



**CURVE #32**  
 Δ 14° 35' 45" RT  
 R 700.000 M  
 L 178.323 M  
 T 89.647 M  
 E 5.717 M  
 B 3.000%

PI ch 14+978.362 =  
 ch 14+977.390

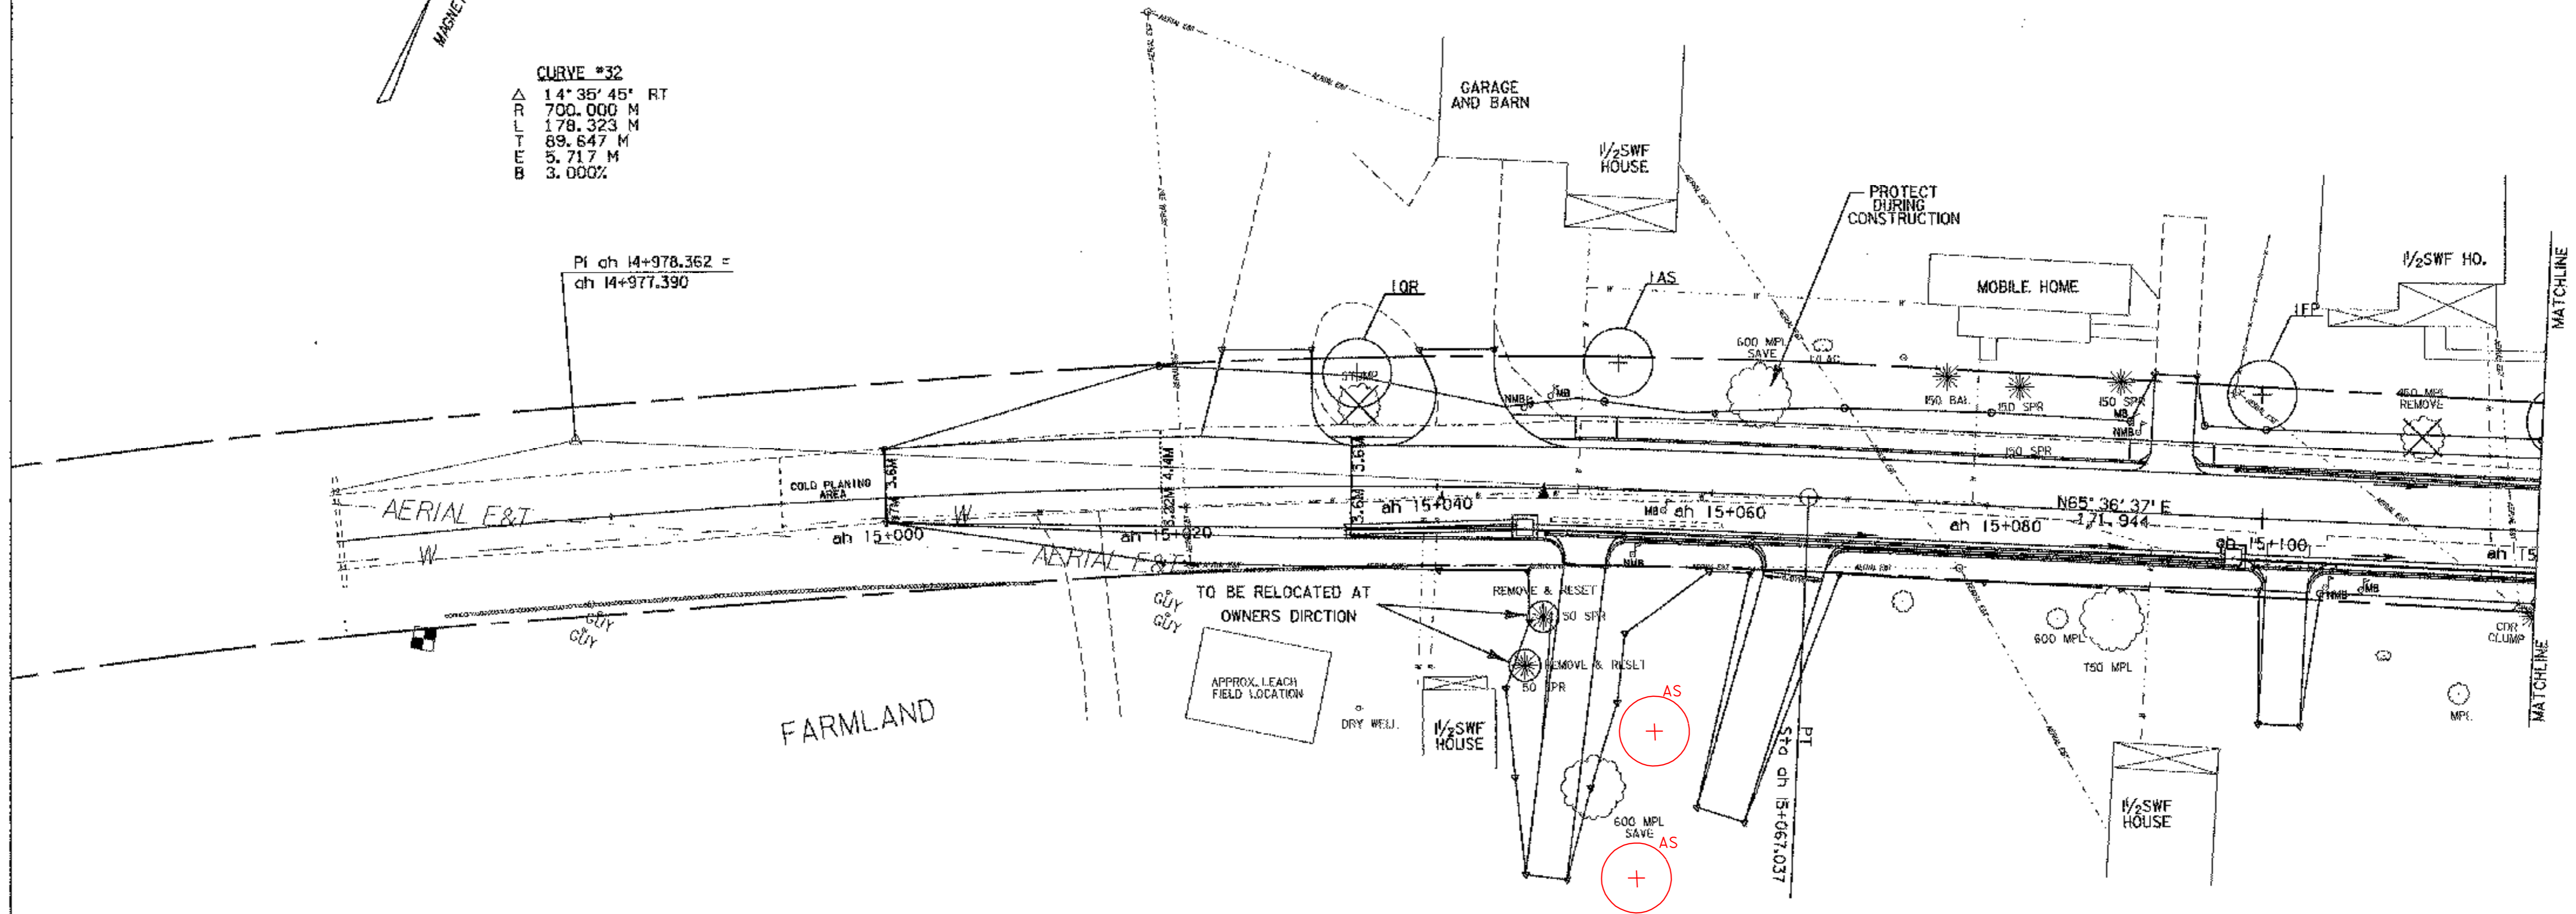

**LEGEND**

- TO BE REMOVED
- PROPOSED TREE
- TO BE RELOCATED BY OTHERS
- PROTECT EXISTING TREES DURING CONSTRUCTION
- EXISTING TREE (TO REMAIN)

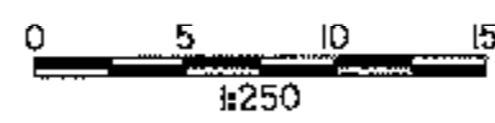

○ DENOTES TREE OR STUMP REMOVAL

ALL DRIVE RADII SHALL BE 6M UNLESS OTHERWISE NOTED PER STD B-71M

**LANDSCAPE PLANS**

PROJECT NAME:	FRANKLIN
PROJECT NUMBER:	STP 0301(18)
FILE NAME:	85c060/design/2bdr.dgn
PROJECT LEADER:	DELLASANTA
DESIGNED BY:	SQUAD B
IPARM FILE NAME:	(2)dc060in1
PLOT DATE:	27-MAR-2003
DRAWN BY:	SQUAD B
CHECKED BY:	SQUAD B
SHEET	40 OF 60