
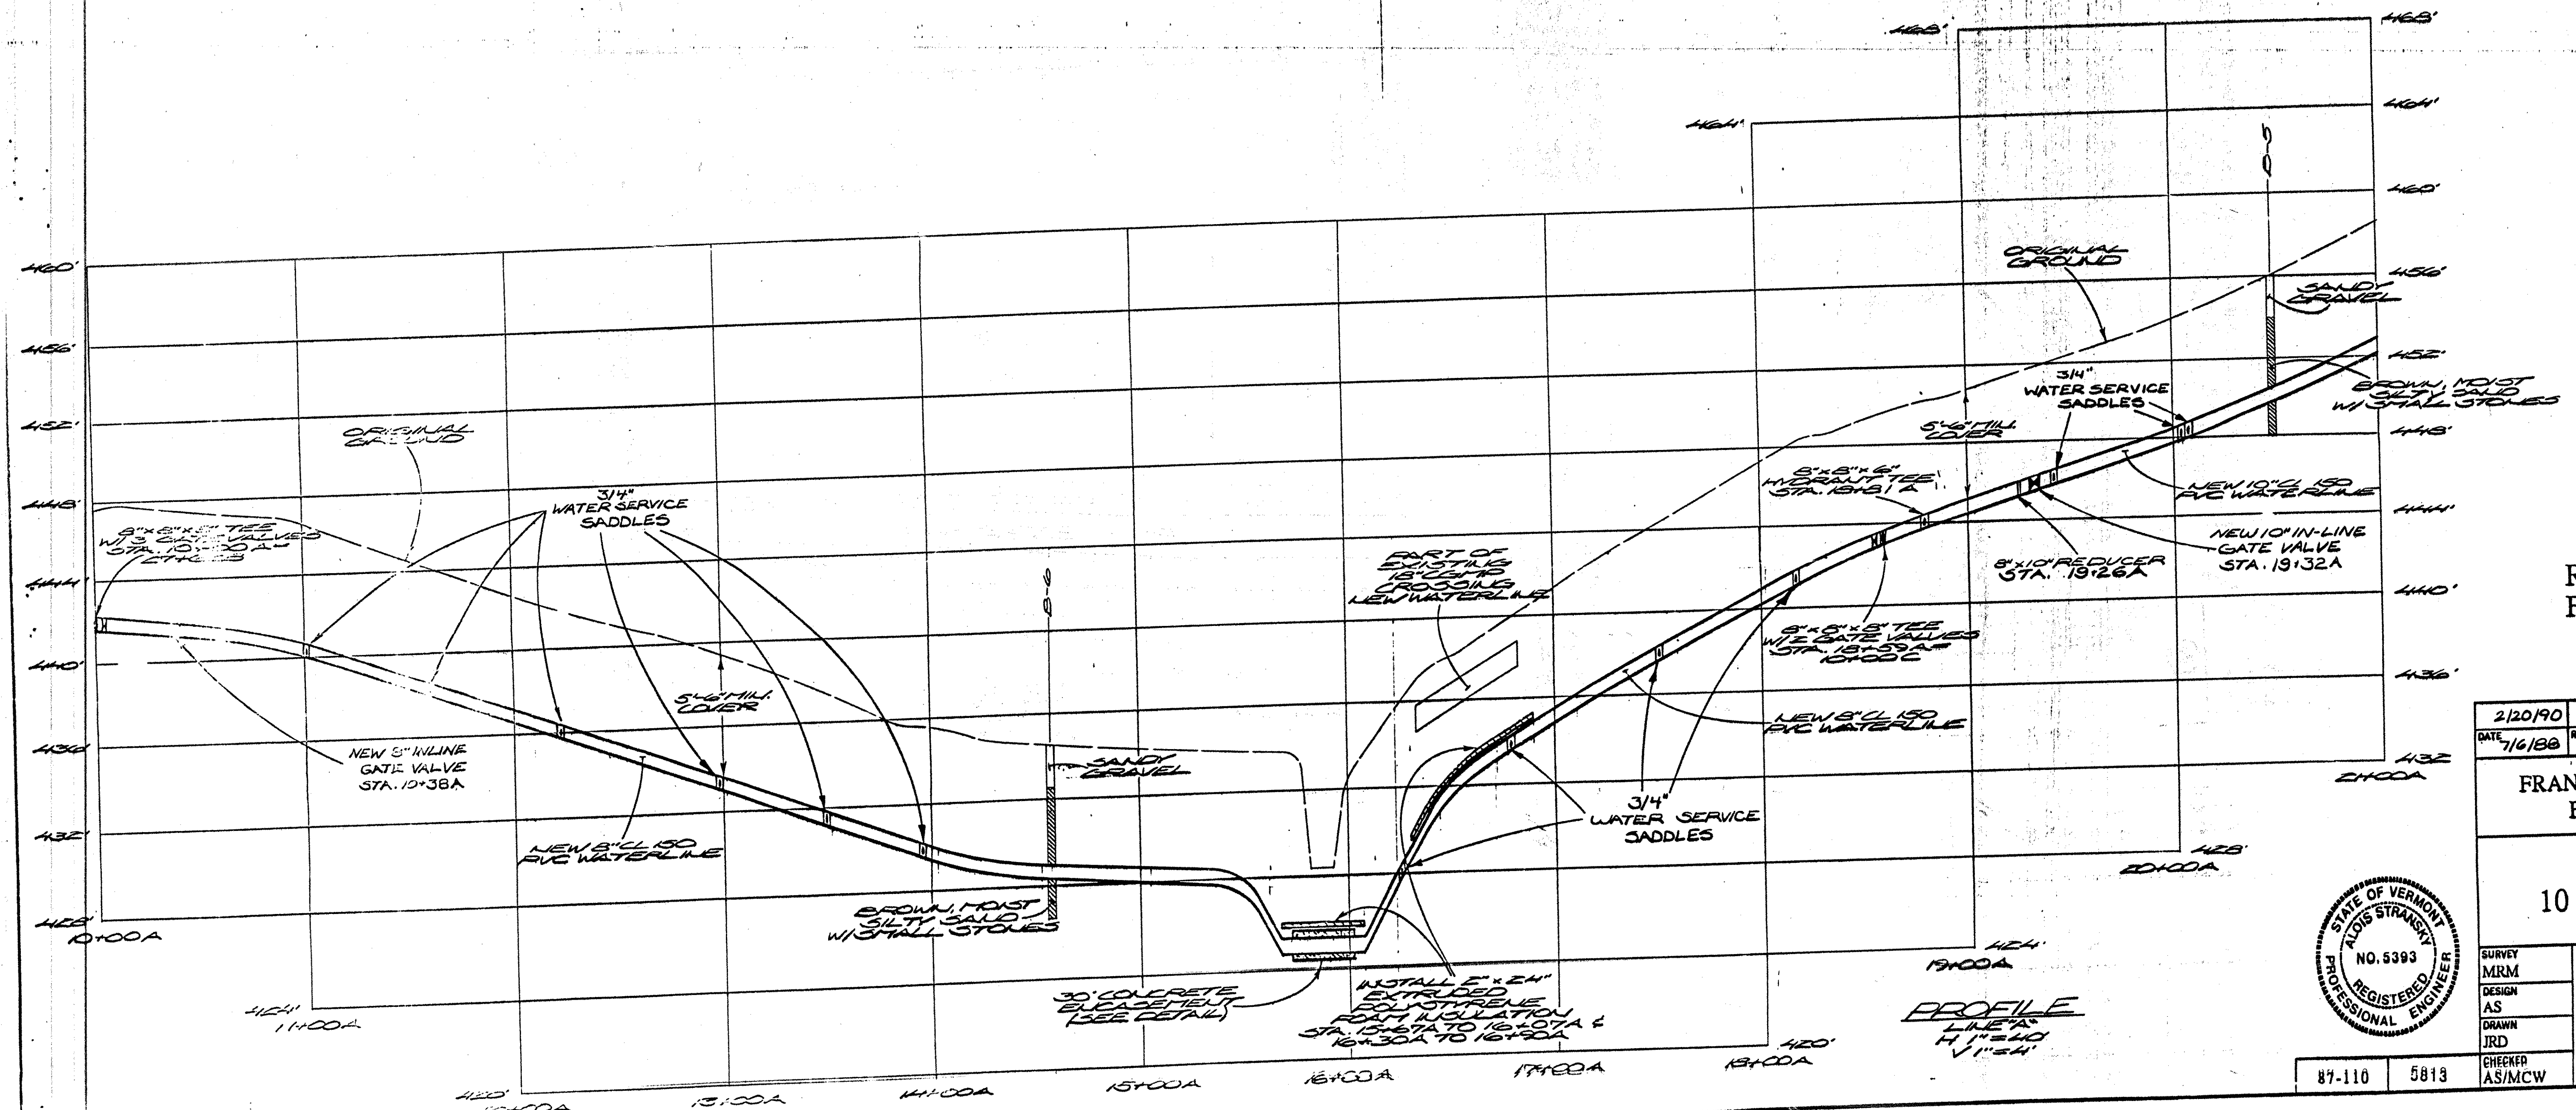


at locations which may be in the immediate vicinity of underground utilities.

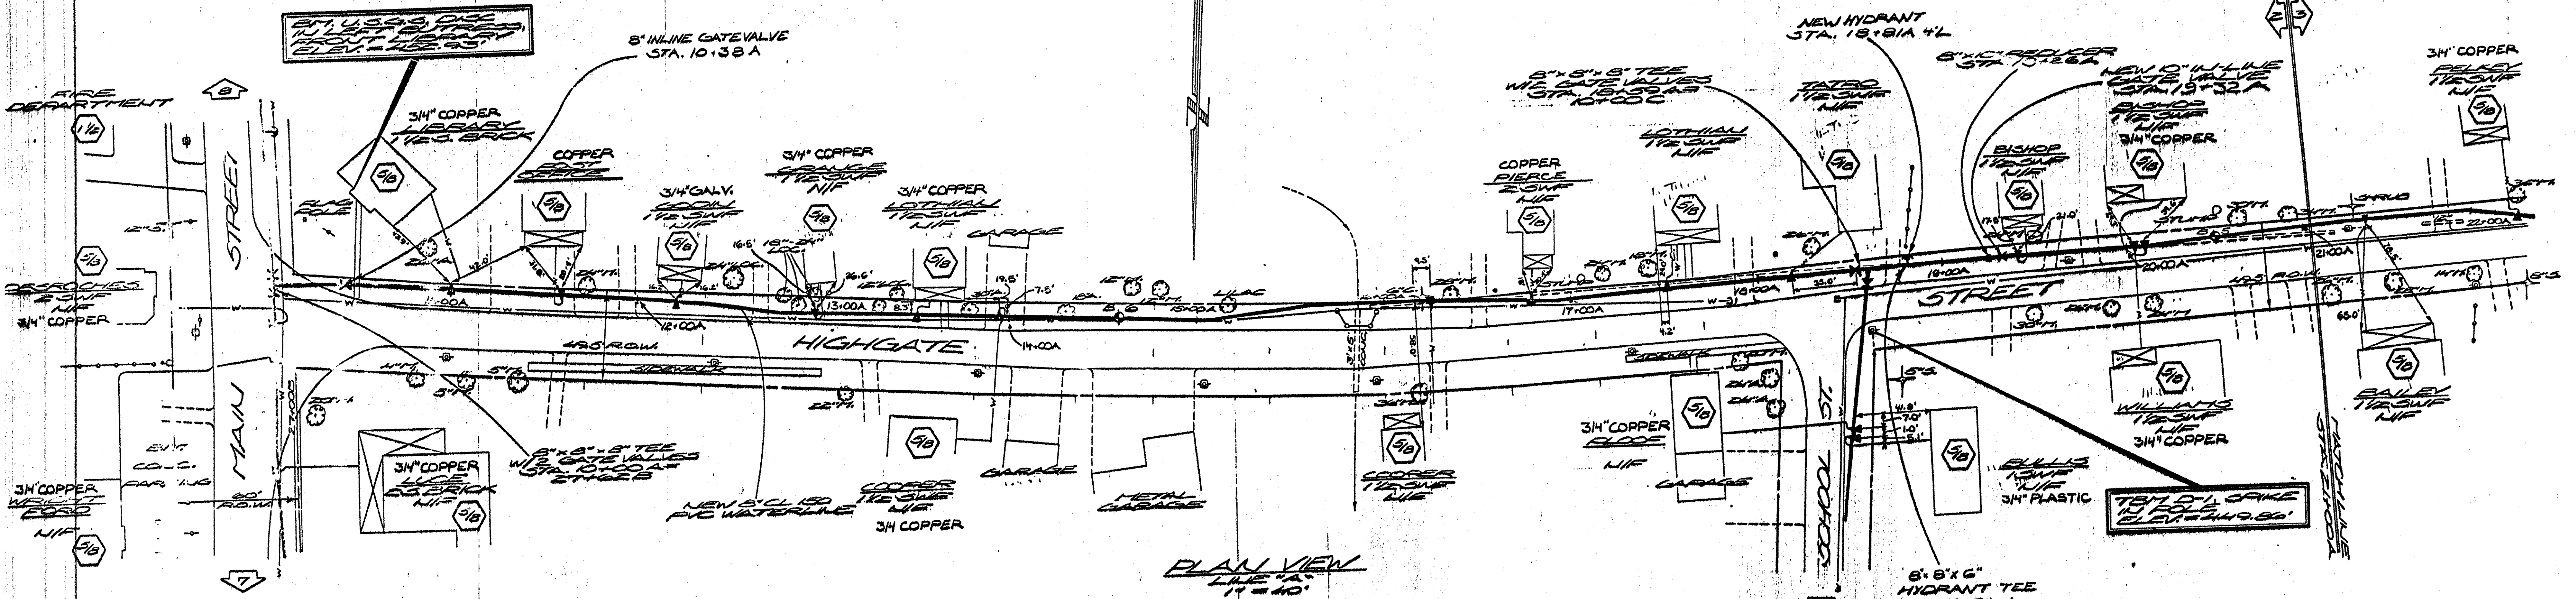

RECORD DRAWING
FEBRUARY 1990

2/20/90	RECORD DRAWING	T.C.R.
DATE 7/6/88	REVISION ADDED GATE VALVE STA. 18+95A	BY AS
FRANKLIN FIRE DISTRICT No. 1 FRANKLIN, VERMONT		
PLAN and PROFILE 10 + 00A to 21 + 00A		
SURVEY MRM	Donald L. Hamlin CONSULTING ENGINEERS, INC. Essex Junction, Vermont	SCALE SHOWN
DESIGN AS		DATE 5/24/88
DRAWN JRD		DRW. NO. 2 of 20
CHECKED AS/MCW		57 OF 60