


<p>ITEM 204.20 TRENCH ETC CATCH BASIN @ 15+102.5 RT DEPTH 0-1.5 1.5x2.52x2.52 = 9.53 m<sup>3</sup> DEPTH OVER 1.5 1.14x0.53x2.42 = 0.89 m<sup>3</sup> 10.42</p> <p>PIPE 15+102.1-15+155.9 RT DEPTH 0-1.5 1.6x1.75x51.85 = 54.89 m<sup>3</sup> DEPTH OVER 1.5 NONE 0.89x1.5 = 1.34 59.89 Total 70.76</p>	<p>ITEM 204.30 GRAN. BACKFILL CATCH BASIN DEPTH 0-1.5 9.53-(1.37x1.75) = 7.17 m<sup>3</sup> DEPTH OVER 1.5 1.14x2.52x2.42 = 0.89 m<sup>3</sup> 8.06</p> <p>PIPE DEPTH 0-1.5 1.01x1.75x51.85 = 52.32 m<sup>3</sup> DEPTH OVER 1.5 NONE Total 60.43</p>
---	---

Bk 3 Pg 67

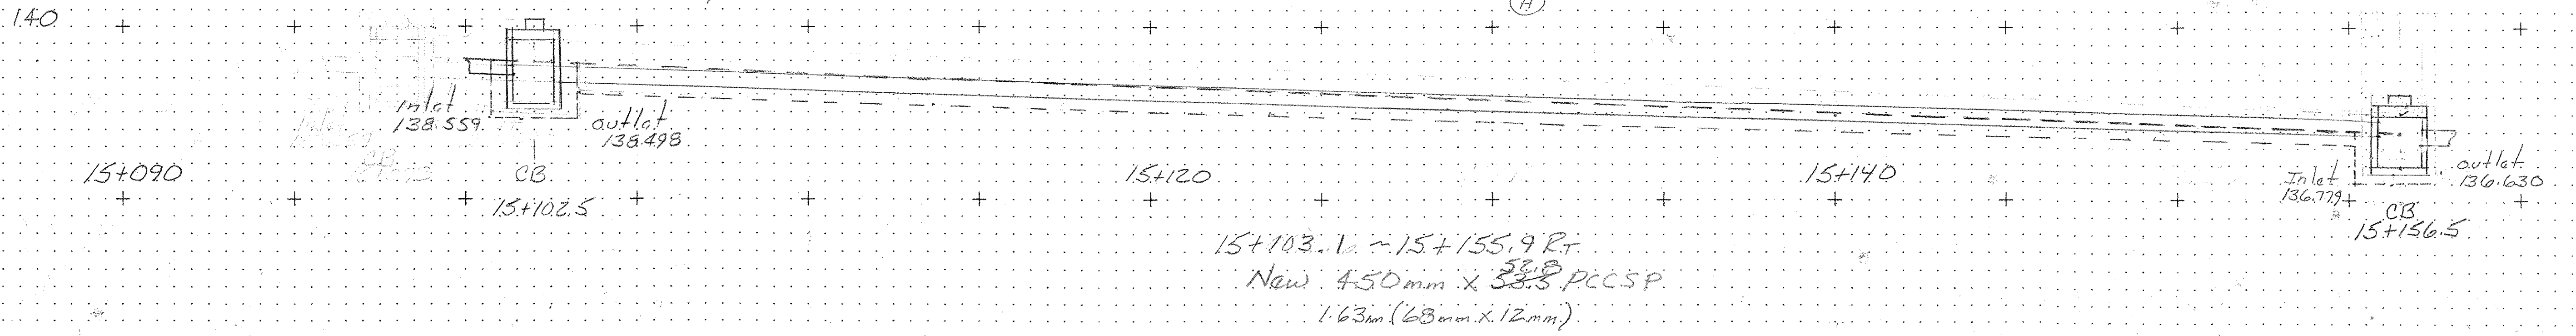


<p>ITEM 204.20 TRENCH ETC PIPE 15+032-15+045.9 RT DEPTH 0-1.5 1.4x1.75x13.2 = 14.1 m<sup>3</sup> DEPTH OVER 1.5 NONE</p>	<p>ITEM 204.30 GRAN. BACKFILL CATCH BASIN DEPTH 0-1.5 8.8x1.1x1.75 = 7.0 m<sup>3</sup> DEPTH OVER 1.5 NONE</p>
--	--

Bk 3 Pg 61

<p>ITEM 204.20 TRENCH ETC CATCH BASIN @ 15+046.5 RT DEPTH 0-1.5 1.4x2.52x2.52 = 8.89 m<sup>3</sup> DEPTH OVER 1.5 NONE</p> <p>PIPE 15+047.1-15+101.9 RT DEPTH 0-1.5 1.6x1.75x54.8 = 77.36 m<sup>3</sup> DEPTH OVER 1.5 NONE Total 86.19</p>	<p>ITEM 204.30 GRAN. BACKFILL CATCH BASIN DEPTH 0-1.5 8.89-(1.1x1.75) = 7.0 m<sup>3</sup> DEPTH OVER 1.5 NONE</p> <p>PIPE DEPTH 0-1.5 1.36x1.75x54.8 = 67.98 m<sup>3</sup> DEPTH OVER 1.5 NONE Total 69.68</p>
---	--

Bk 3 Pg 65

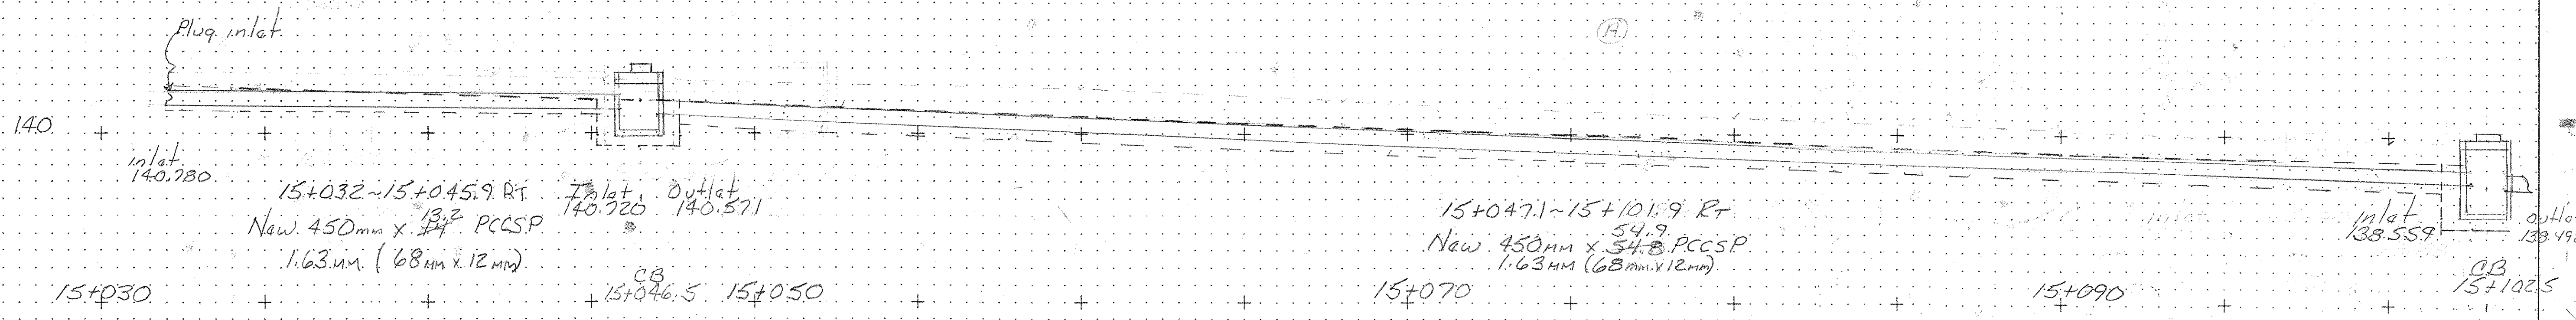

PROJECT: FRANKLIN	PROJECT NO.: STP 0301(18)
DESIGN FILE NAME:	PLOT DATE: 01-MAY-1996
IPARM FILE NAME:	SHEET: 2 OF 6