


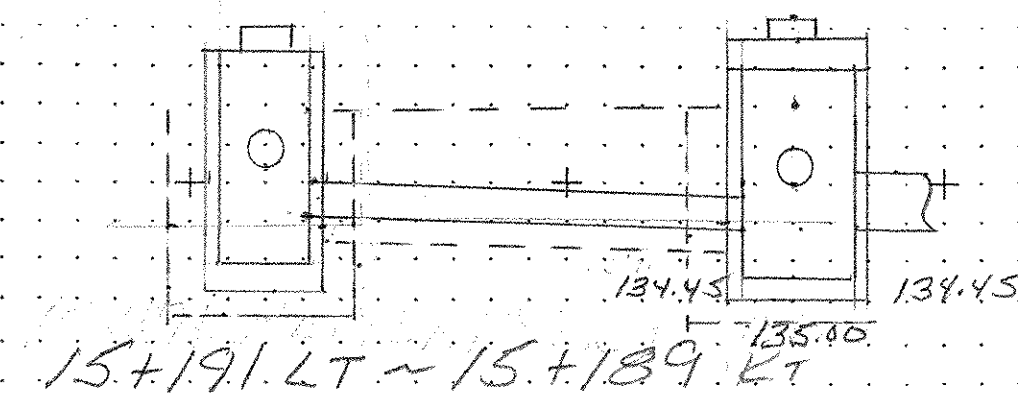


N4w 450mm x 5.8PCCSP
1.63mm (68mm x 12mm)
BK 3 Pg 80


Item 204.20 Trench Exc.
Catch Basin @ 15+191.2T
Depth 0-1.5
1.5 x 2.48 x 2.48 = 9.21 m³
Depth over 1.5
None
Pipe 15+189.2T ~ 15+191.2T
Depth 0-1.5
1.5 x 1.75 x 4.45 = 11.7 m³
Depth over 1.5
None
Total 21.91 m³
BK 3 Pg 80

Item 204.20 Trench Exc.
Catch Basin @ 15+191.2T
Depth 0-1.5
1.5 x 2.48 x 2.48 = 9.21 m³
Depth over 1.5
None
Pipe 15+189.2T ~ 15+191.2T
Depth 0-1.5
1.5 x 1.75 x 4.45 = 11.7 m³
Depth over 1.5
None
Total 21.91 m³
BK 3 Pg 80

Item 204.20 Trench Exc.
Catch Basin @ 15+191.2T
Depth 0-1.5
1.5 x 2.48 x 2.48 = 9.21 m³
Depth over 1.5
None
Pipe 15+189.2T ~ 15+191.2T
Depth 0-1.5
1.5 x 1.75 x 4.45 = 11.7 m³
Depth over 1.5
None
Total 21.91 m³
BK 3 Pg 80

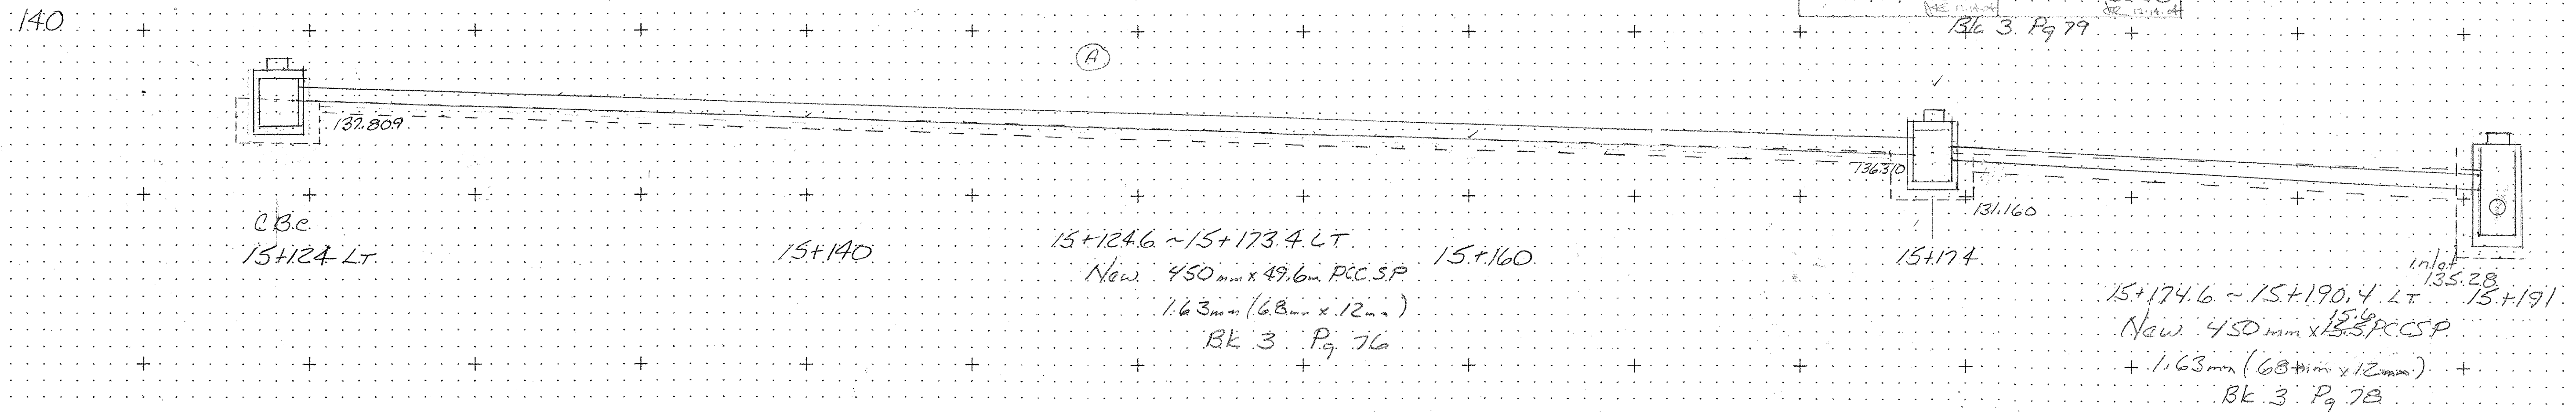

Item 204.20 Trench Exc.
Catch Basin @ 26+013.5 LT
Depth 0-1.5
1.5 x 2.48 x 2.48 = 9.21 m³
Depth over 1.5
None
Pipe 15+214.8T ~ 26+013.5 LT
Depth 0-1.5
1.5 x 1.75 x 9.7 = 21.32 m³
Depth over 1.5
None
Total 30.53 m³
BK 3 Pg 98

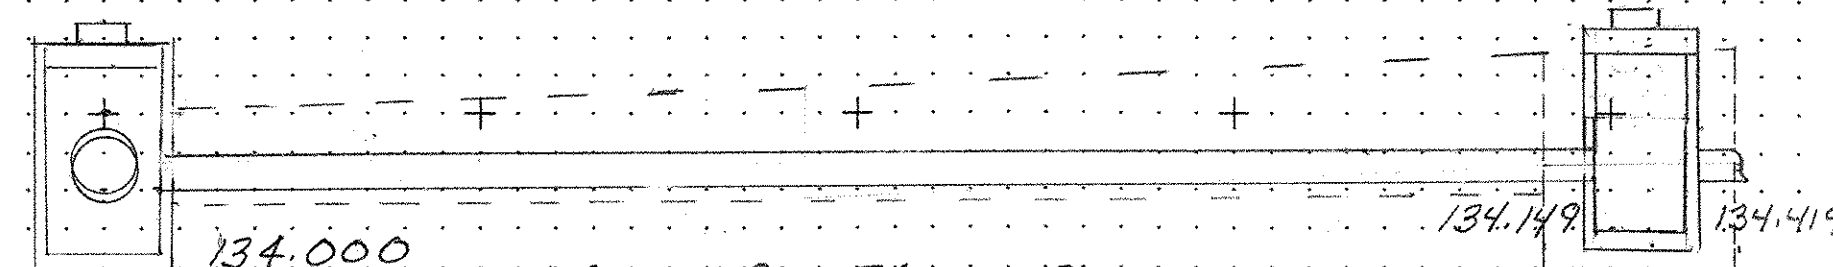

N4w 450mm x 17.0m PCCSP
1.63mm (68mm x 12mm)
BK 3 Pg 98