
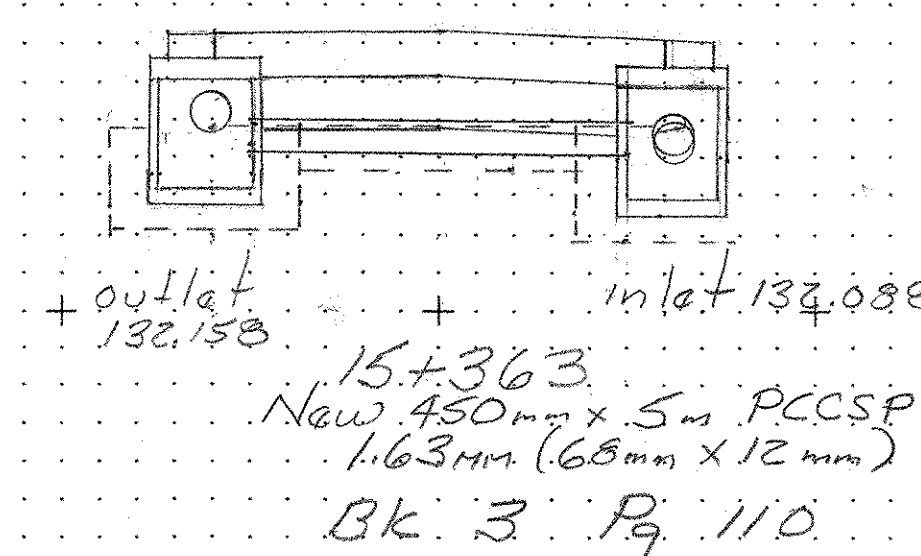


ITEM 204.20 TRENCH EXC. CATCH BASIN @ 15+383 RT DEPTH 0-1.5 1.63x2.55x2.55 = 9.75 m ³ DEPTH OVER 1.5 2.25x2.55x2.55 = 1.46 m ³ NONE PIPE 15+363.6-15+382.4 RT DEPTH 0-1.5 71x1.75x17.35 = 21.56 m ³ DEPTH OVER 1.5 NONE Total 34.50	ITEM 204.30 GRAN. BACKFILL CATCH BASIN DEPTH 0-1.5 9.75-11.4x(1.75) = 7.34 m ³ DEPTH OVER 1.5 2.25x2.55x2.55 = 1.46 m ³ 8.80 m ³ PIPE 15+363.6-15+382.4 RT DEPTH 0-1.5 1.06 m ³ x 17.35 = 18.39 m ³ DEPTH OVER 1.5 NONE Total 27.19
--	--

Bk 3 Pg 113

ITEM 204.20 TRENCH EXC. CATCH BASIN @ 15+363 RT DEPTH 0-1.5 1.25x2.55x2.55 = 8.44 m ³ DEPTH OVER 1.5 NONE PIPE 15+363.6-15+362.4 RT DEPTH 0-1.5 6x1.75x2.65 = 3.18 m ³ DEPTH OVER 1.5 NONE Total 11.62	ITEM 204.30 GRAN. BACKFILL CATCH BASIN DEPTH 0-1.5 8.44-11.4x(1.75) = 6.55 m ³ DEPTH OVER 1.5 NONE PIPE 15+363.6-15+362.4 RT DEPTH 0-1.5 71x1.75x3.65 = 2.59 m ³ DEPTH OVER 1.5 NONE Total 9.14
---	--

Bk 3 Pg 111

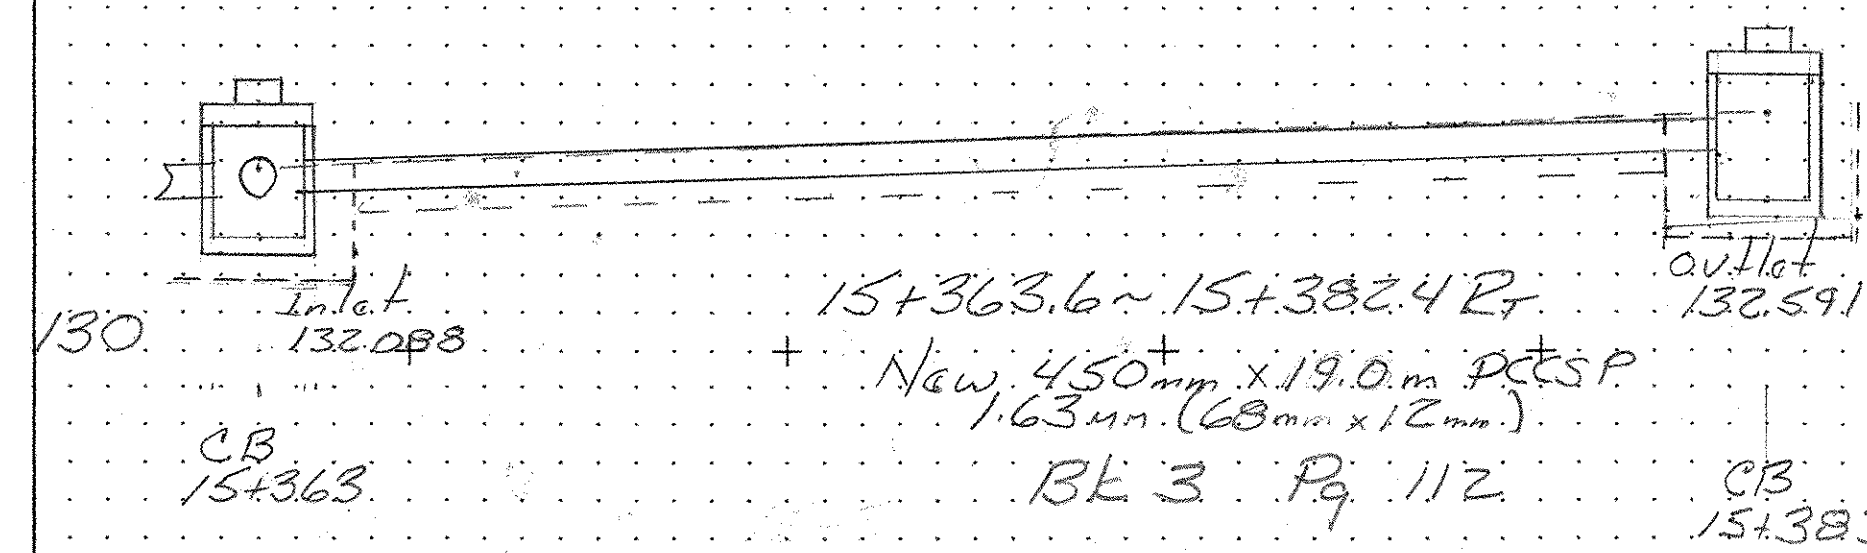

ITEM 204.20 TRENCH EXC. CATCH BASIN @ 15+311 RT DEPTH 0-1.5 1.35x2.15x2.15 = 6.24 m ³ DEPTH OVER 1.5 NONE PIPE 15+293.6-15+310.6 RT DEPTH 0-1.5 63x1.75x15.6 = 17.28 m ³ DEPTH OVER 1.5 NONE Total 23.44	ITEM 204.30 GRAN. BACKFILL CATCH BASIN DEPTH 0-1.5 6.24-11.4x(1.75) = 5.26 m ³ DEPTH OVER 1.5 NONE PIPE 15+293.6-15+310.6 RT DEPTH 0-1.5 43x1.75x15.6 = 14.54 m ³ DEPTH OVER 1.5 NONE Total 19.76
---	--

Bk 3 Pg 103

ITEM 204.20 TRENCH EXC. CATCH BASIN @ 15+319 RT DEPTH 0-1.5 1.30x2.5x2.5 = 8.13 m ³ DEPTH OVER 1.5 NONE PIPE 15+311.5-15+319.4 RT DEPTH 0-1.5 47x1.75x5.55 = 4.56 m ³ DEPTH OVER 1.5 NONE Total 12.69	ITEM 204.30 GRAN. BACKFILL CATCH BASIN DEPTH 0-1.5 8.13-10.6x(1.75) = 6.41 m ³ DEPTH OVER 1.5 NONE PIPE 15+311.5-15+319.4 RT DEPTH 0-1.5 66x1.75x5.55 = 3.66 m ³ DEPTH OVER 1.5 NONE Total 10.07
--	---

Bk 3 Pg 105

ITEM 204.20 TRENCH EXC. CATCH BASIN @ 15+345 RT DEPTH 0-1.5 1.43x2.55x2.55 = 9.30 m ³ DEPTH OVER 1.5 NONE PIPE 15+319.6-15+344.4 RT DEPTH 0-1.5 47x1.75x23.35 = 19.93 m ³ DEPTH OVER 1.5 NONE Total 29.53	ITEM 204.30 GRAN. BACKFILL CATCH BASIN DEPTH 0-1.5 9.30-11.4x(1.75) = 7.36 m ³ DEPTH OVER 1.5 NONE PIPE 15+319.6-15+344.4 RT DEPTH 0-1.5 72x1.75x23.35 = 16.83 m ³ DEPTH OVER 1.5 NONE Total 24.19
--	---

Bk 3 Pg 107

ITEM 204.20 TRENCH EXC. CATCH BASIN @ 15+363 RT DEPTH 0-1.5 1.05x1.2x2.65 = 10.14 m ³ DEPTH OVER 1.5 NONE PIPE 15+345.6-15+362.4 RT DEPTH 0-1.5 61x1.75x15.49 = 16.59 m ³ DEPTH OVER 1.5 NONE Total 26.68	ITEM 204.30 GRAN. BACKFILL CATCH BASIN DEPTH 0-1.5 10.14-11.4x(1.75) = 8.08 m ³ DEPTH OVER 1.5 NONE PIPE 15+345.6-15+362.4 RT DEPTH 0-1.5 81x1.75x15.49 = 13.79 m ³ DEPTH OVER 1.5 NONE Total 21.87
--	--

Bk 3 Pg 109

