

SEE SHEET 2 INDEX OF SHEETS

STATE OF VERMONT AGENCY OF TRANSPORTATION




PROPOSED IMPROVEMENT TOWN OF FRANKLIN COUNTY OF FRANKLIN

TOWN HIGHWAY NO. 3, CLASS 2 (MAJOR COLLECTOR)

PROJECT LOCATION:
BEGINNING ON FRANKLIN TOWN HIGHWAY 3, 0.438KM FROM THE INTERSECTION OF FRANKLIN TOWN HIGHWAY 21 AND 3, AND EXTENDING IN A NORTHEASTERLY DIRECTION TO END AT THE INTERSECTION OF FRANKLIN TOWN HIGHWAY 3 AND VERMONT ROUTE 120

LENGTH OF ROADWAY = 434.39 m = 0.434KM
LENGTH OF PROJECT = 434.39 m = 0.434KM


PROJECT DESCRIPTION:
RECONSTRUCTION OF TOWN HIGHWAY 3 IN THE VILLAGE OF FRANKLIN, INCLUDING NEW DRAINAGE SYSTEM, SUBBASE, BITUMINOUS CONCRETE PAVEMENT AND CURB

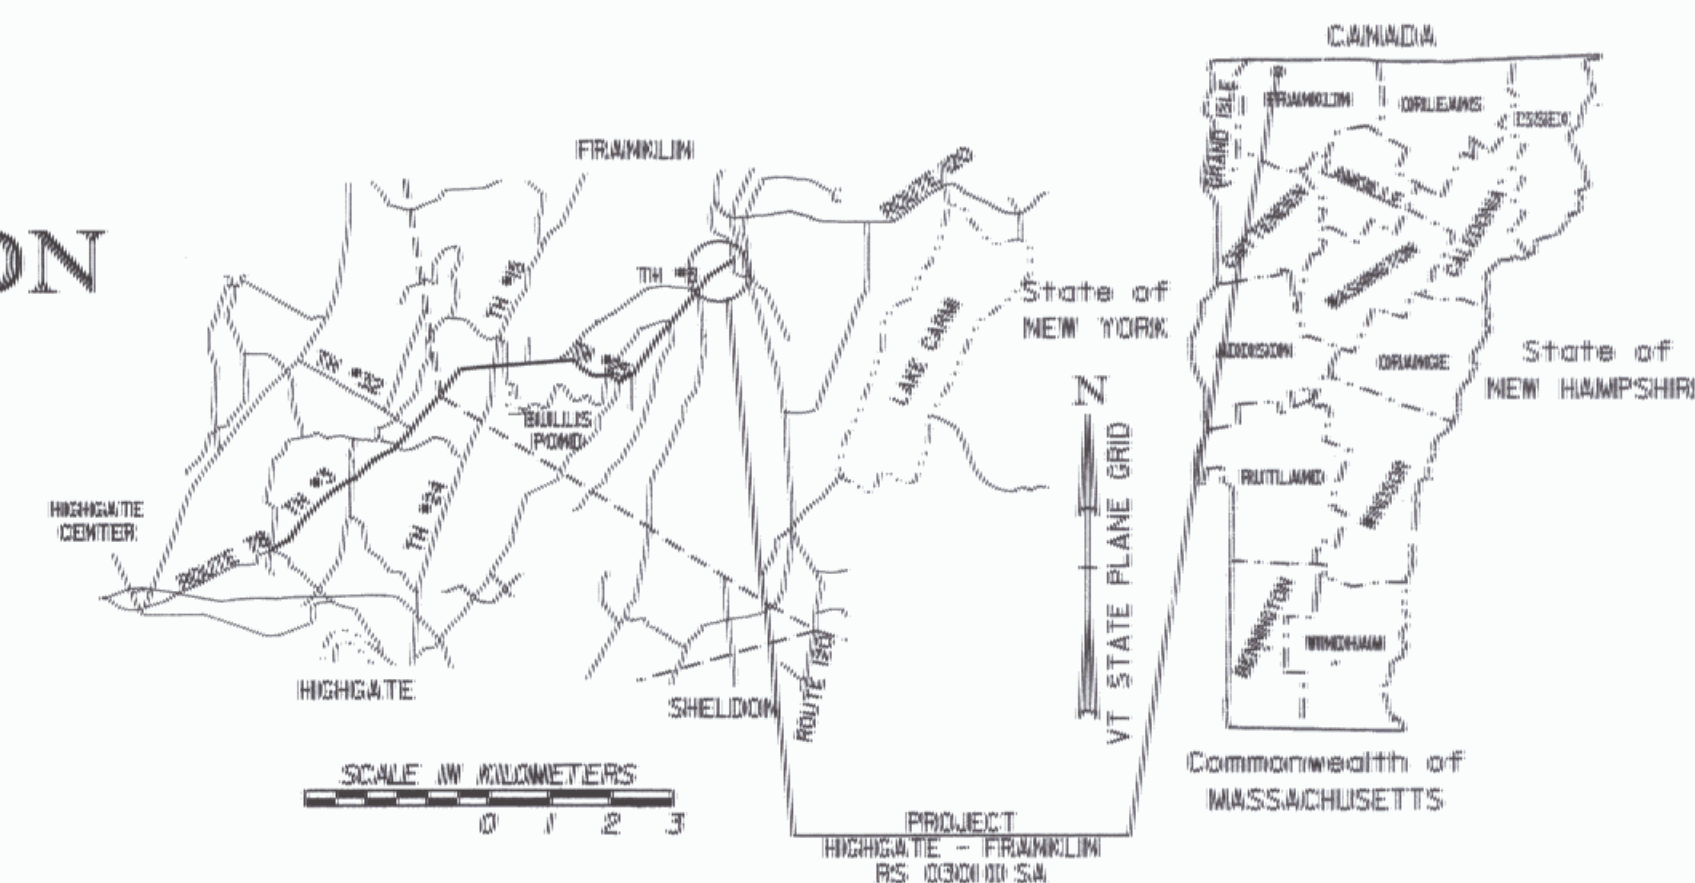

Wright's Excavating Inc
Contractor
Mrenda J. Wright
Signature
Sec.
Title

[Signature]
Director of Finance and Administration
or Duly Authorized Agent
August 4, 2003
Date

TH#3 @ P.O.T. ah 15+464.139 =
ROUTE 120 P.O.T. 304+095.461
END PROJECT

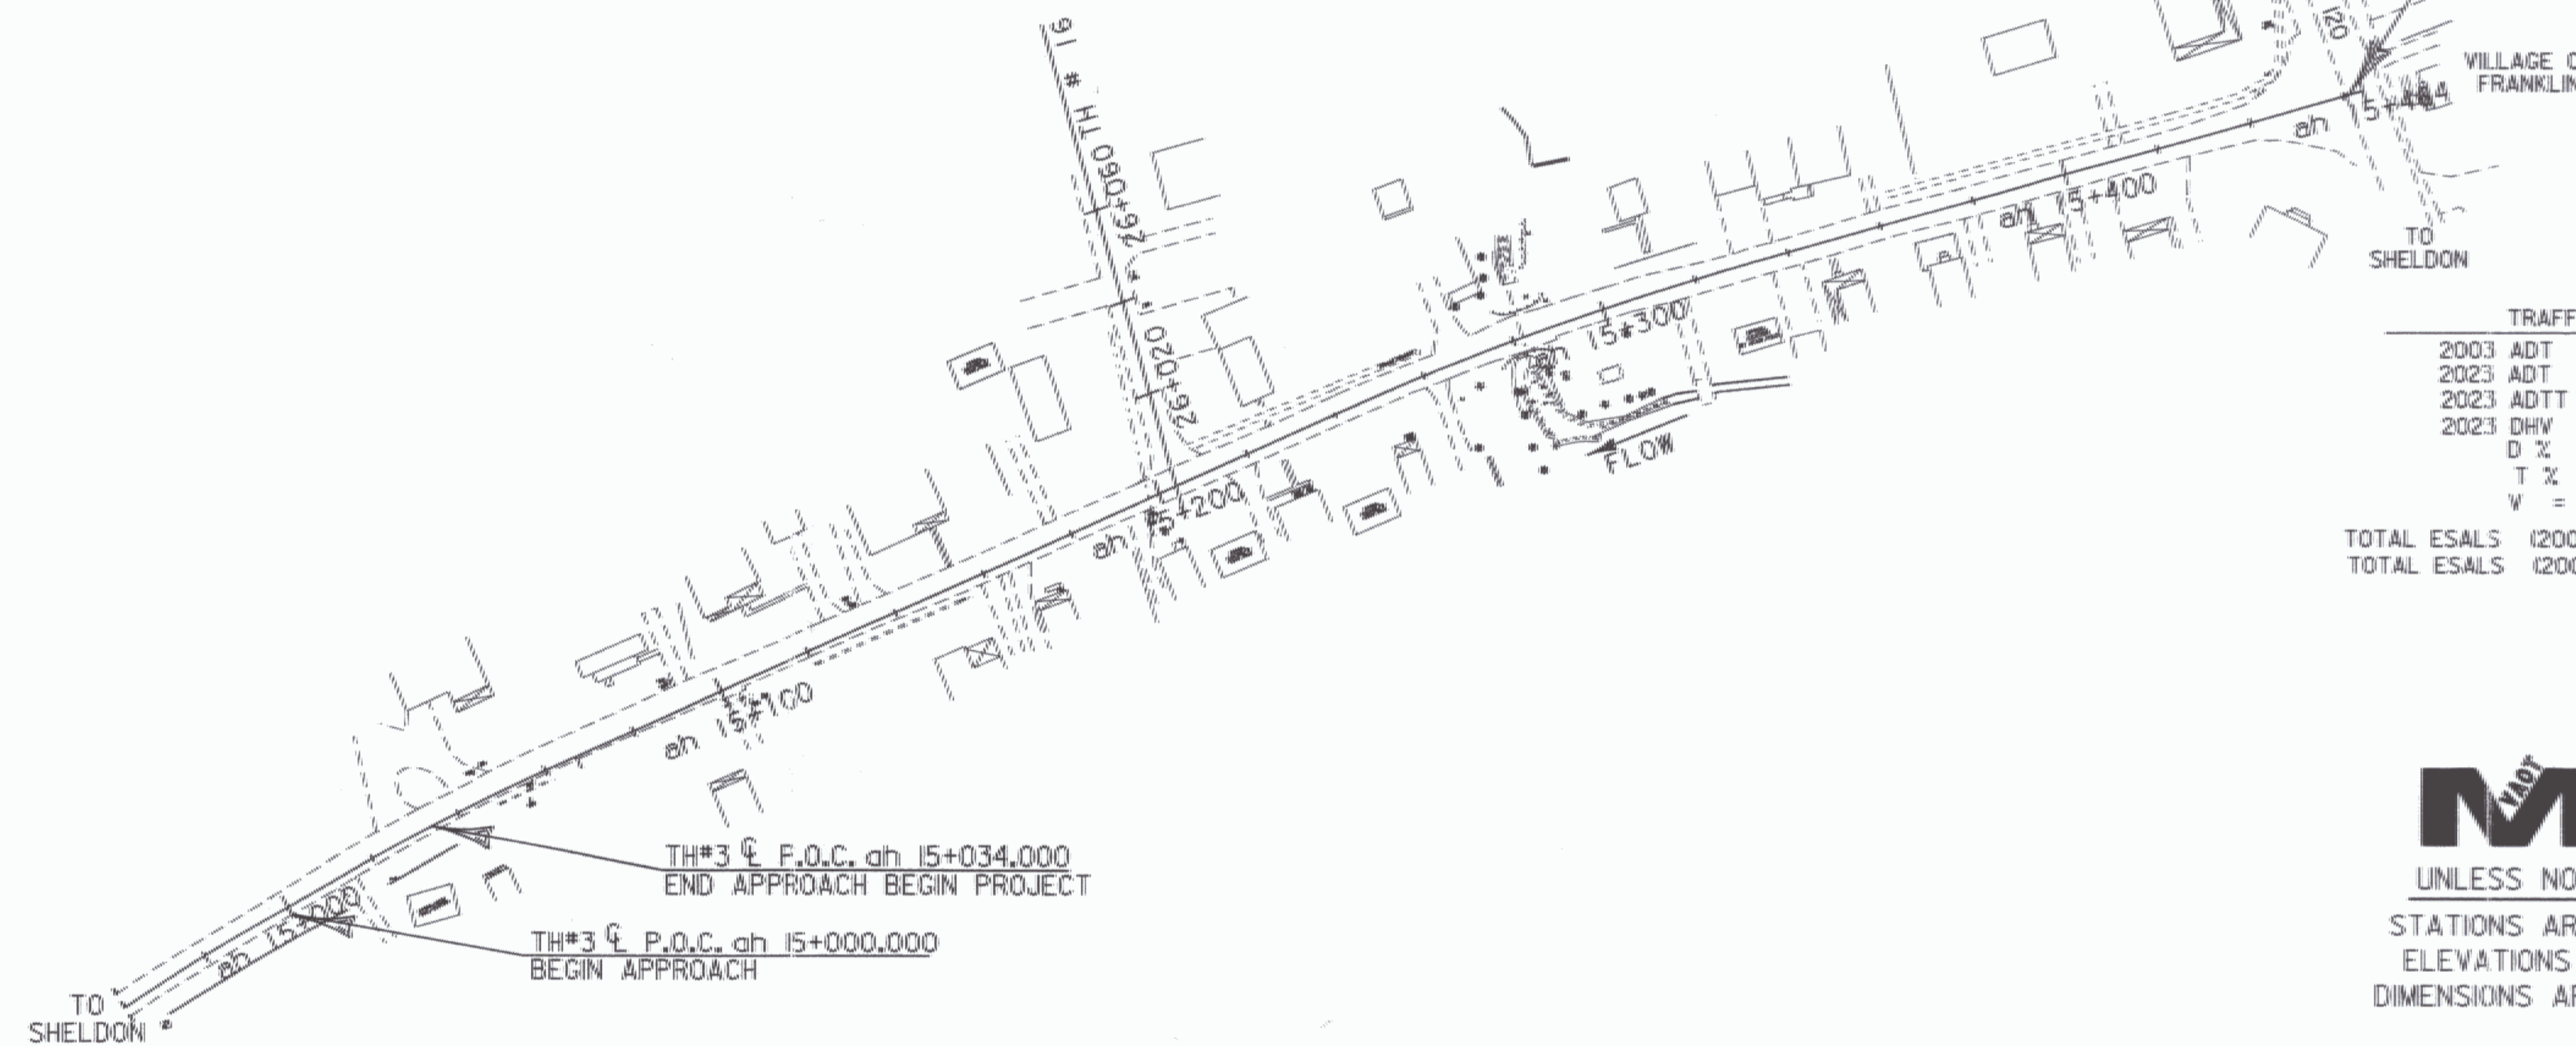

TRAFFIC DATA	
2003 ADT	= 300
2023 ADT	= 400
2023 ADTT	= 30
2023 DHV	= 105
D %	= 59
T %	= 5
V	= 50 KPH
TOTAL ESALS (2003 ~ 2023)	= 80,000
TOTAL ESALS (2003 ~ 2043)	= 209,000

CONVENTIONAL SYMBOLS

COUNTY LINE	
TOWN LINE	
LIMITS OF ACCESS	
POINT OF ACCESS	
FENCE LINE	
STONE WALL	
TRAVELED WAY	
GUARD RAIL	
RAILROAD	
SURVEY LINE	
CULVERT	
POWER POLE	
TELEPHONE POLE	
TREES	
CONTROL OF ACCESS	
PROPERTY LINE	
R.O.W. TAKING LINE	
SLOPE RIGHTS	
TOP OF CUT	
TOE OF SLOPE	

SURVEYED BY :
SURVEYED DATE :
DATUM :
VERTICAL : NGVD 1929
HORIZONTAL : N/A

0 20 40 60 80 100
SCALE IN METERS

THESE PLANS ARE SUBJECT TO SUCH ENGINEERING CHANGES AS MAY BE REQUIRED BY THE FEDERAL HIGHWAY ADMINISTRATION OR THE DIRECTOR OF PROGRAM DEVELOPMENT.
CONSTRUCTION IS TO BE CARRIED ON IN ACCORDANCE WITH THESE PLANS AND THE STANDARD SPECIFICATIONS FOR CONSTRUCTION DATED 2001, AS APPROVED BY THE FEDERAL HIGHWAY ADMINISTRATION ON JANUARY 4, 2001 FOR USE ON THIS PROJECT, INCLUDING ALL SUBSEQUENT REVISIONS AND SUCH REVISED SPECIFICATIONS AND SPECIAL PROVISIONS AS ARE INCORPORATED IN THESE PLANS.

Metric
UNLESS NOTED OTHERWISE
STATIONS ARE IN KILOMETERS
ELEVATIONS ARE IN METERS
DIMENSIONS ARE IN MILLIMETERS

DIRECTOR OF PROGRAM DEVELOPMENT
APPROVED [Signature] DATE 4/15/02
PROJECT MANAGER : G. DuBroy
PROJECT NAME : FRANKLIN
PROJECT NUMBER : STP 0301(18)
SHEET 1 OF 60 SHEETS