

**VERTICAL GRANITE CURB**

15+300.0	TO 15+328.8	LT 324.1
15+300.0	TO 15+313.8	RT 312.2
15+317.9	TO 15+338.6	RT 334.3
15+322.5	TO 15+357.4	RT 356.4
15+341.4	TO 15+410.1	RT 376.0
15+380.6	TO 15+398.2	RT 395.9
15+401.5	TO 15+408.6	RT 408.1
15+413.9	TO 15+457.7	LT
15+423.2	TO 15+458.9	RT 458.0
15+36.25 TO 15+408.7 LT		

**PORTLAND CEMENT CONCRETE SIDEWALK (530MM)**

15+300 TO 15+458 LT 454

**PORTLAND CEMENT CONCRETE WALK**

15+338 TO 15+343 LT (BACK 4.6 M)

15+349 RT 3M BACK

15+391 RT 4.6M BACK

**REMOVING AND RESETTING FENCE**

15+305 TO 15+323 LT

15+366 TO 15+368 RT

**REMOVAL OF EXISTING SIDEWALK**

15+363.830 TO 15+455.220 LT

**TRANSPLANTING SHRUBS**




15+339 LT ROSE BUSHES

15+341 LT ROSE BUSHES

FINAL LOCATION WILL BE AT A MUTUALLY AGREED UPON LOCATION BETWEEN THE ENGINEER AND THE PROPERTY OWNER

**CONSTRUCT DRIVE**

15+316	RT	GRAVEL
15+333	LT	GRAVEL
15+339	RT	GRAVEL
15+360	LT	GRAVEL
15+379	RT	GRAVEL
15+400	RT	GRAVEL
15+412	LT	GRAVEL
15+416	RT	GRAVEL

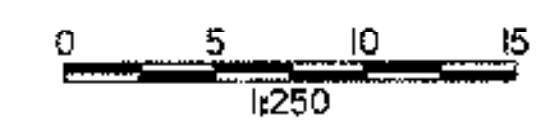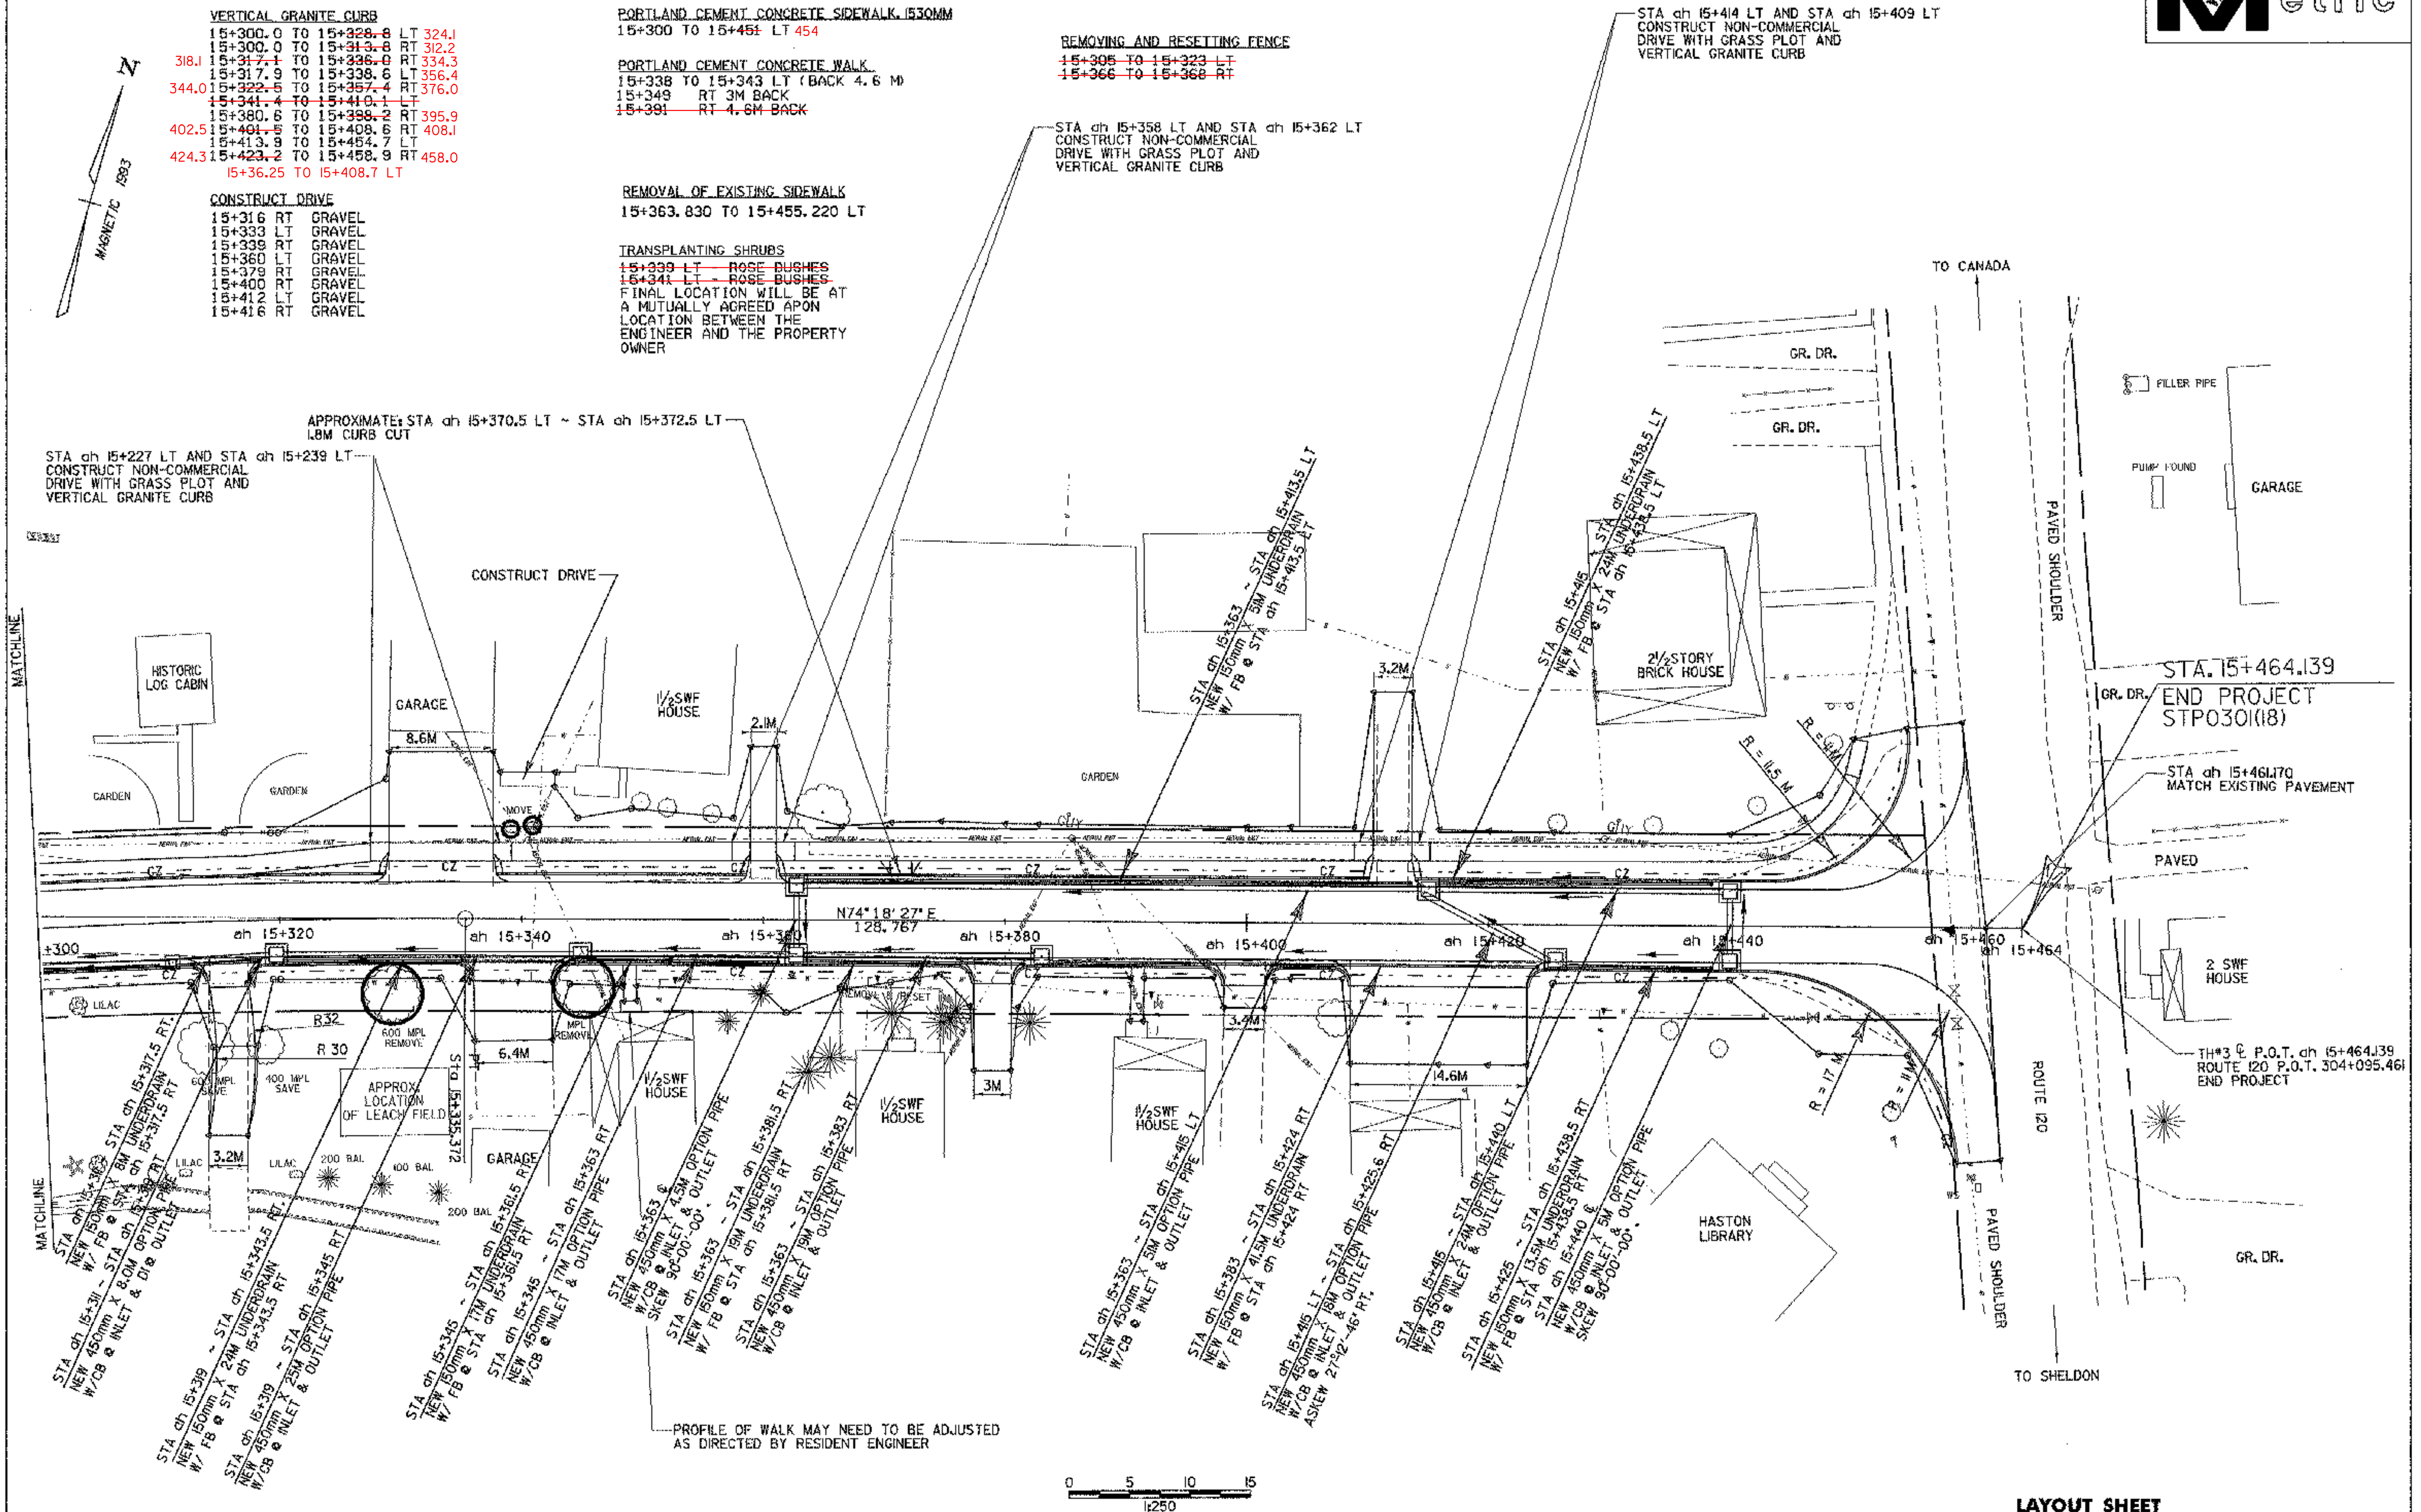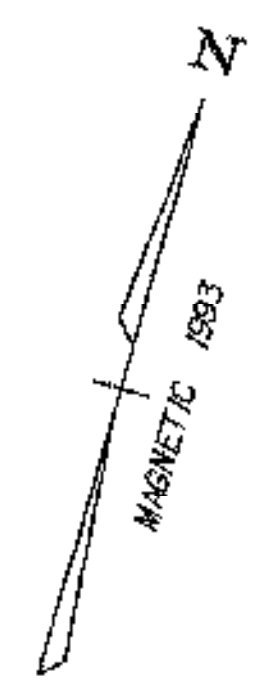

○ DENOTES TREE OR STUMP REMOVAL

ALL DRIVE RADII SHALL BE 5M UNLESS OTHERWISE NOTED PER STD B-71M

**LAYOUT SHEET**

PROJECT NAME:	FRANKLIN
PROJECT NUMBER:	STP 030(18)
FILE NAME:	85c060/design/2bdr.dgn
PROJECT LEADER:	DELLASANTA
DESIGNED BY:	SQUAD B
IPARM FILE NAME:	(2)c06013.1
PLOT DATE:	24-MAR-2003
DRAWN BY:	SQUAD B
CHECKED BY:	SQUAD B
SHEET	19 OF 60