
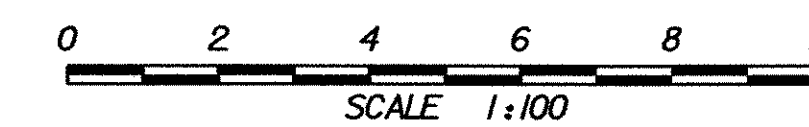


TH #16 PROFILE

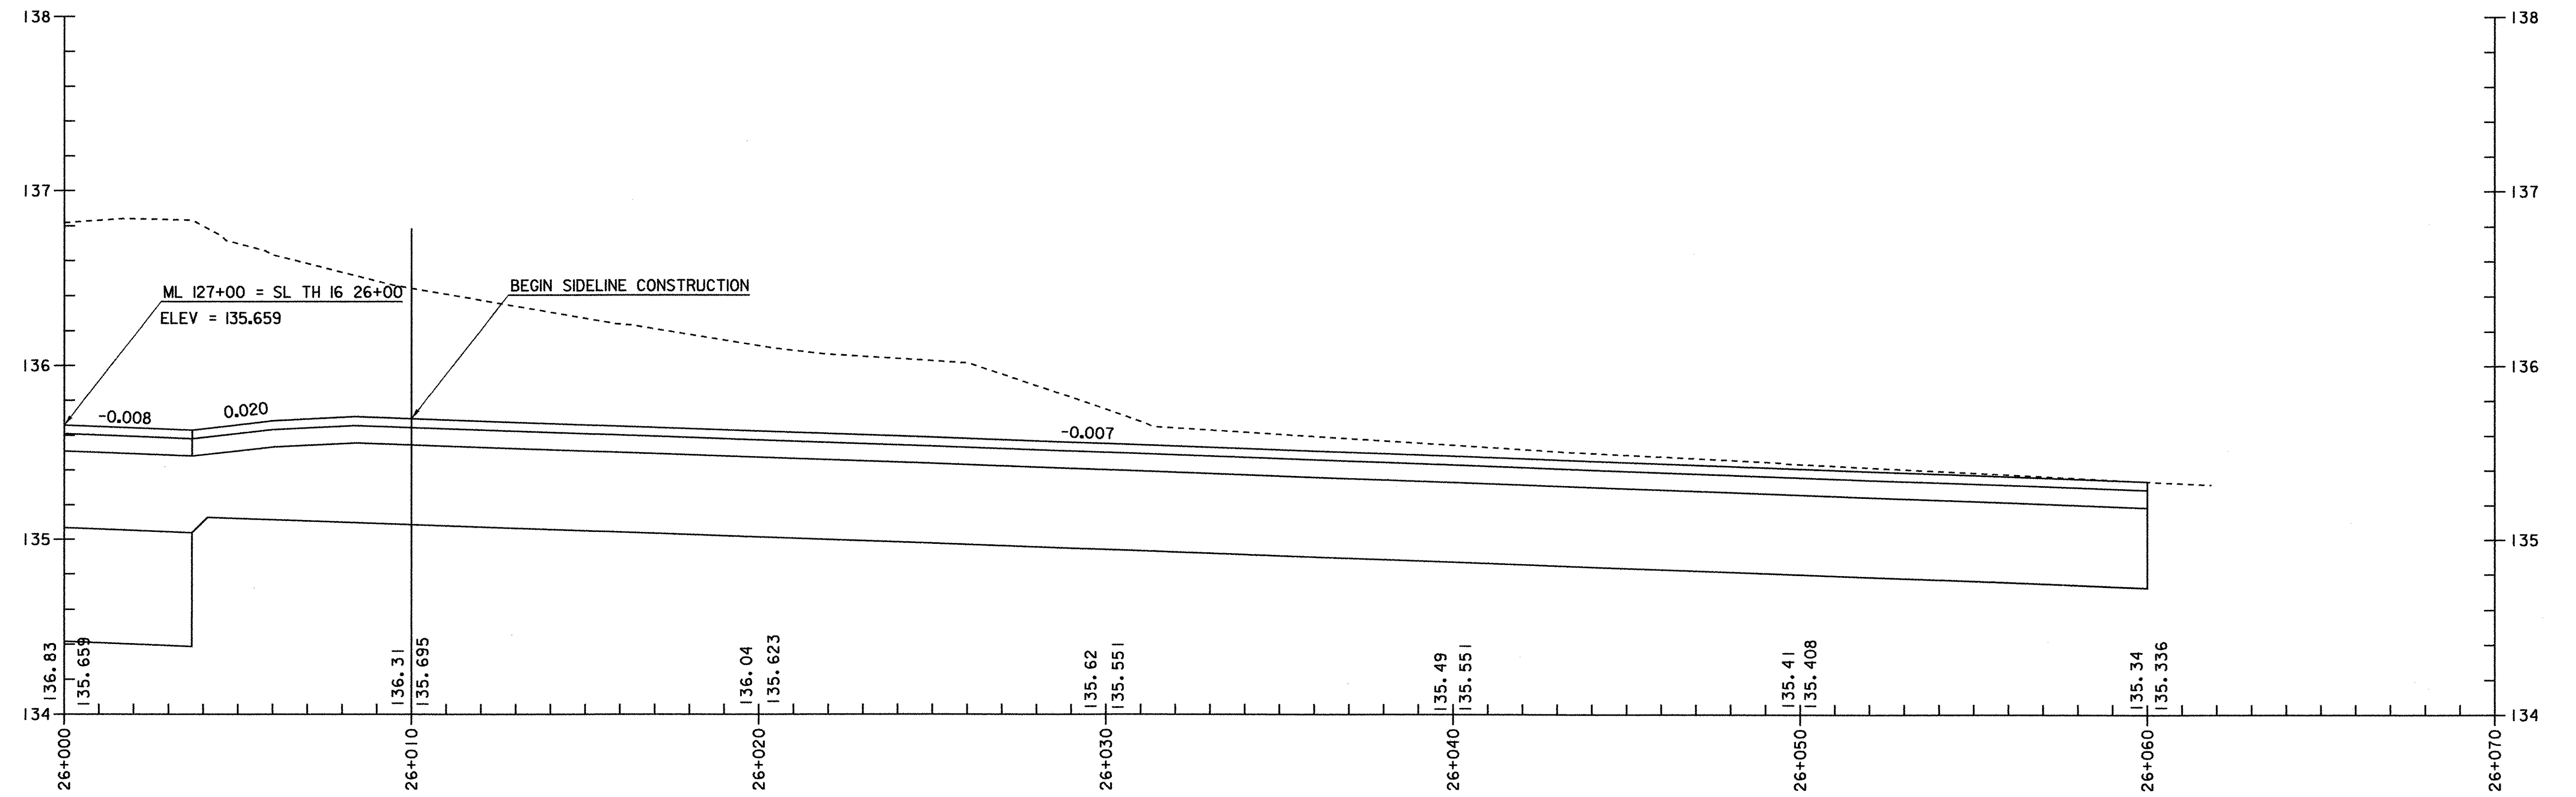

PROJECT NAME:	FRANKLIN	FILE NAME:	...85c060\design\dc060x12.dgn	PLOT DATE:	20-MAR-2003
PROJECT NUMBER:	STP 030I(18)	PROJECT LEADER:	DELLASANTA	DRAWN BY:	SQUAD B
		DESIGNED BY:	SQUAD B	CHECKED BY:	SQUAD B
		IPARM FILE NAME:	(2)dc060p04.l	SHEET	23 OF 60