
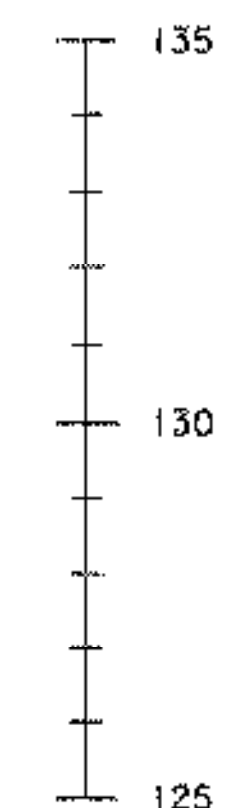
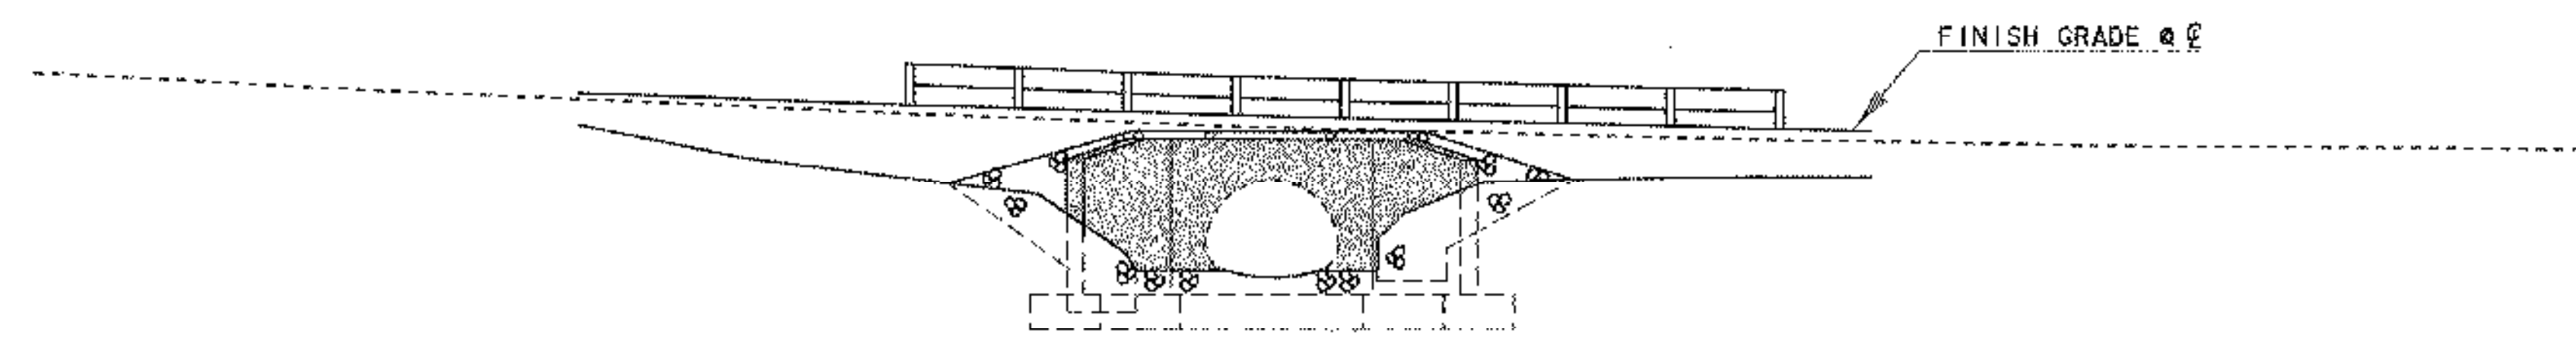
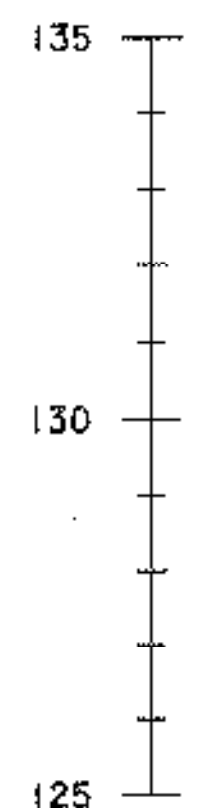


MAINLINE STA. $ah\ 15+282.18$
 CHANNEL LINE STA. $110+000.00$
 ASKEW $85^{\circ}-18'-53''$ FROM
 TANGENT TO CURVE

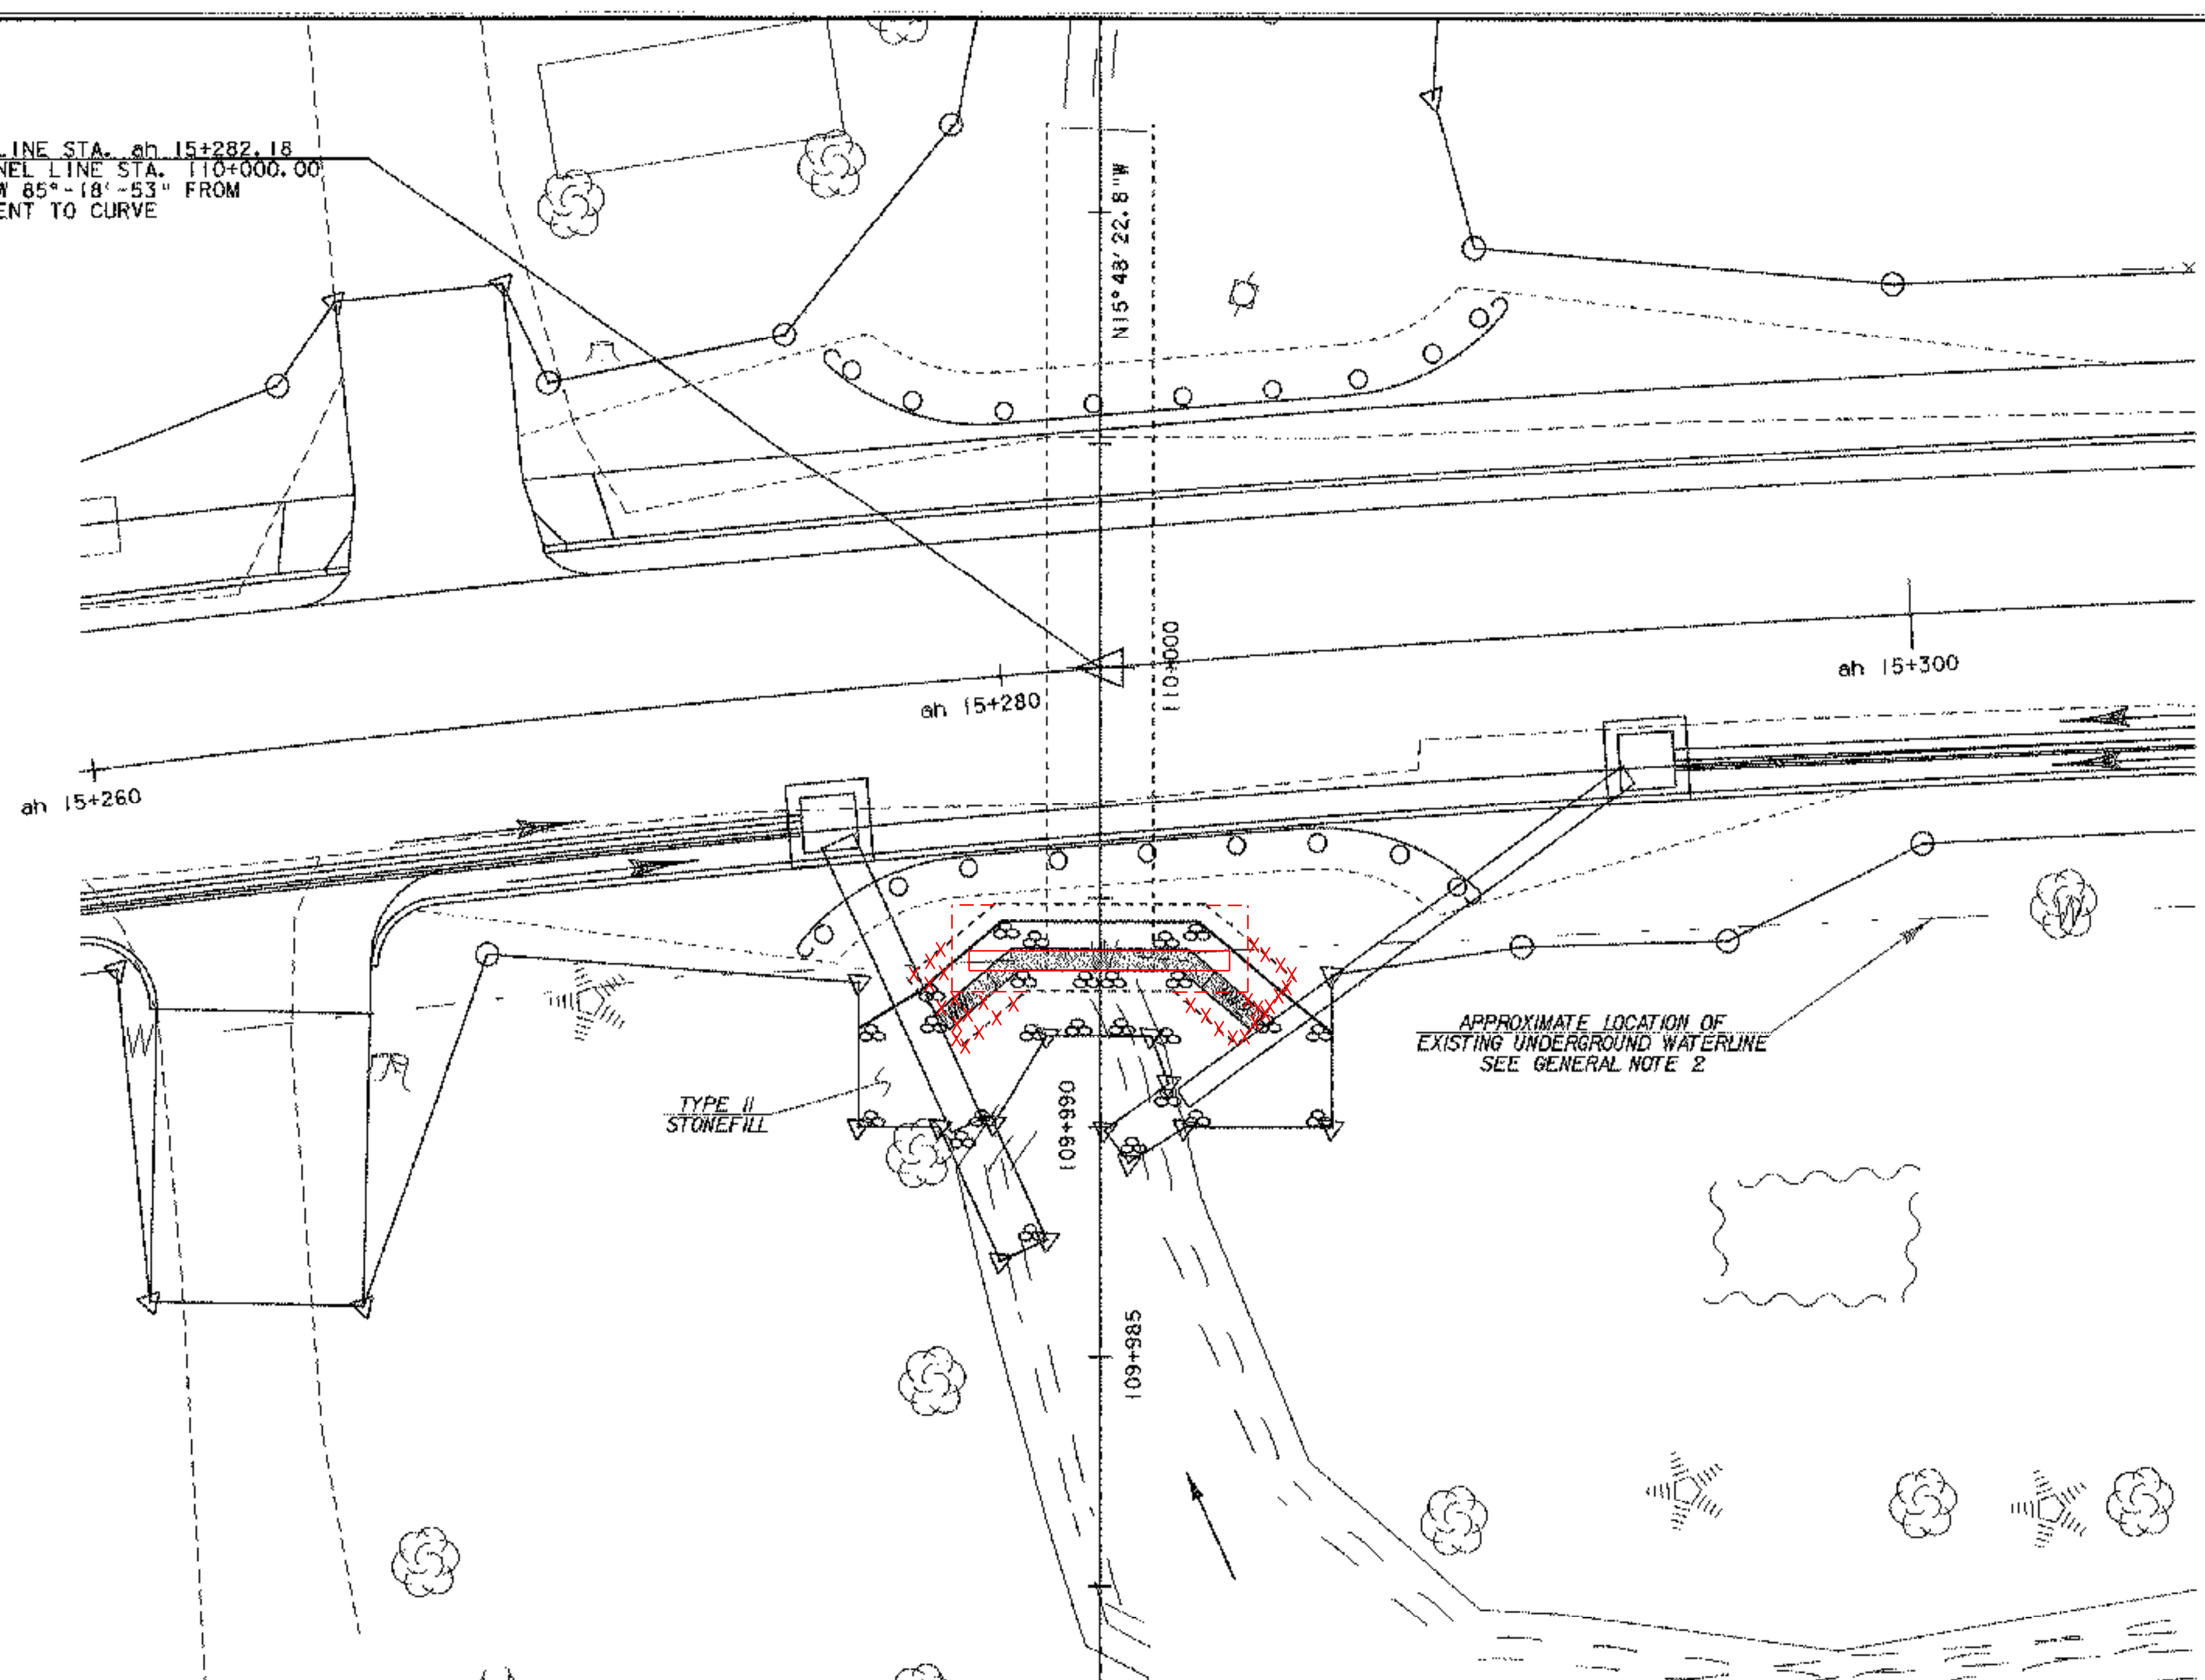

ELEVATION VIEW

PLAN AND ELEVATION SHEET

PROJECT NAME:	FRANKLIN	PLOT DATE:	21-MAR-2003
PROJECT NUMBER:	STP 030(18)	DRAWN BY:	R. PELLETT
FILE NAME:	/85c060/stt/sc85c060bdr.dg	CHECKED BY:	G. SPILAK
PROJECT LEADER:	S. FARNSWORTH	SHEET	24 OF 60
DESIGNED BY:	M. FOWLER		
sc060pel5282.l			

