

PAVMENT MARKING & TRAFFIC SIGNING LAYOUT



TEMPORARY 100mm WHITE LINE
 M/L ah 15+120 LT ~ SL 26+060 LT, EDGE LINE-SOLID
 S/L 26+060 RT ~ ah 15+300 LT, EDGE LINE-SOLID
 M/L ah 15+120 ~ ah 15+300 RT, EDGE LINE-SOLID


DURABLE 100mm WHITE LINE
 M/L ah 15+120 LT ~ SL 26+060 LT, EDGE LINE-SOLID
 S/L 26+060 RT ~ ah 15+300 LT, EDGE LINE-SOLID
 M/L ah 15+120 ~ ah 15+300 RT, EDGE LINE-SOLID

TEMPORARY 100mm YELLOW LINE
 M/L ah 15+120 C/L ~ 15+198 C/L DBL. LINE-SOLID
 M/L ah 15+210 C/L ~ ah 15+300 C/L DBL. LINE-SOLID
 M/L 26+010 C/L ~ 26+060 C/L DBL. LINE-SOLID

DURABLE 100mm YELLOW LINE
 M/L ah 15+120 C/L ~ ah 15+198 C/L DBL. LINE-SOLID
 M/L ah 15+210 C/L ~ ah 15+300 C/L DBL. LINE-SOLID
 S/L 26+010 C/L ~ 26+060 C/L DBL. LINE-SOLID

REMOVING SIGNS
 ah 15+212 C/L LT (2) 3
 S/L 26+045 S/L RT.
 15+199 LT


DURABLE 24" STOP BAR
 S/L 26+004 C/L ~ 26+04.5 C/L LT (7M)
 DURABLE LETTER OR SYMBOL
 S/L 26+013.5 C/L ~ 26+015.9 C/L LT (STOP)

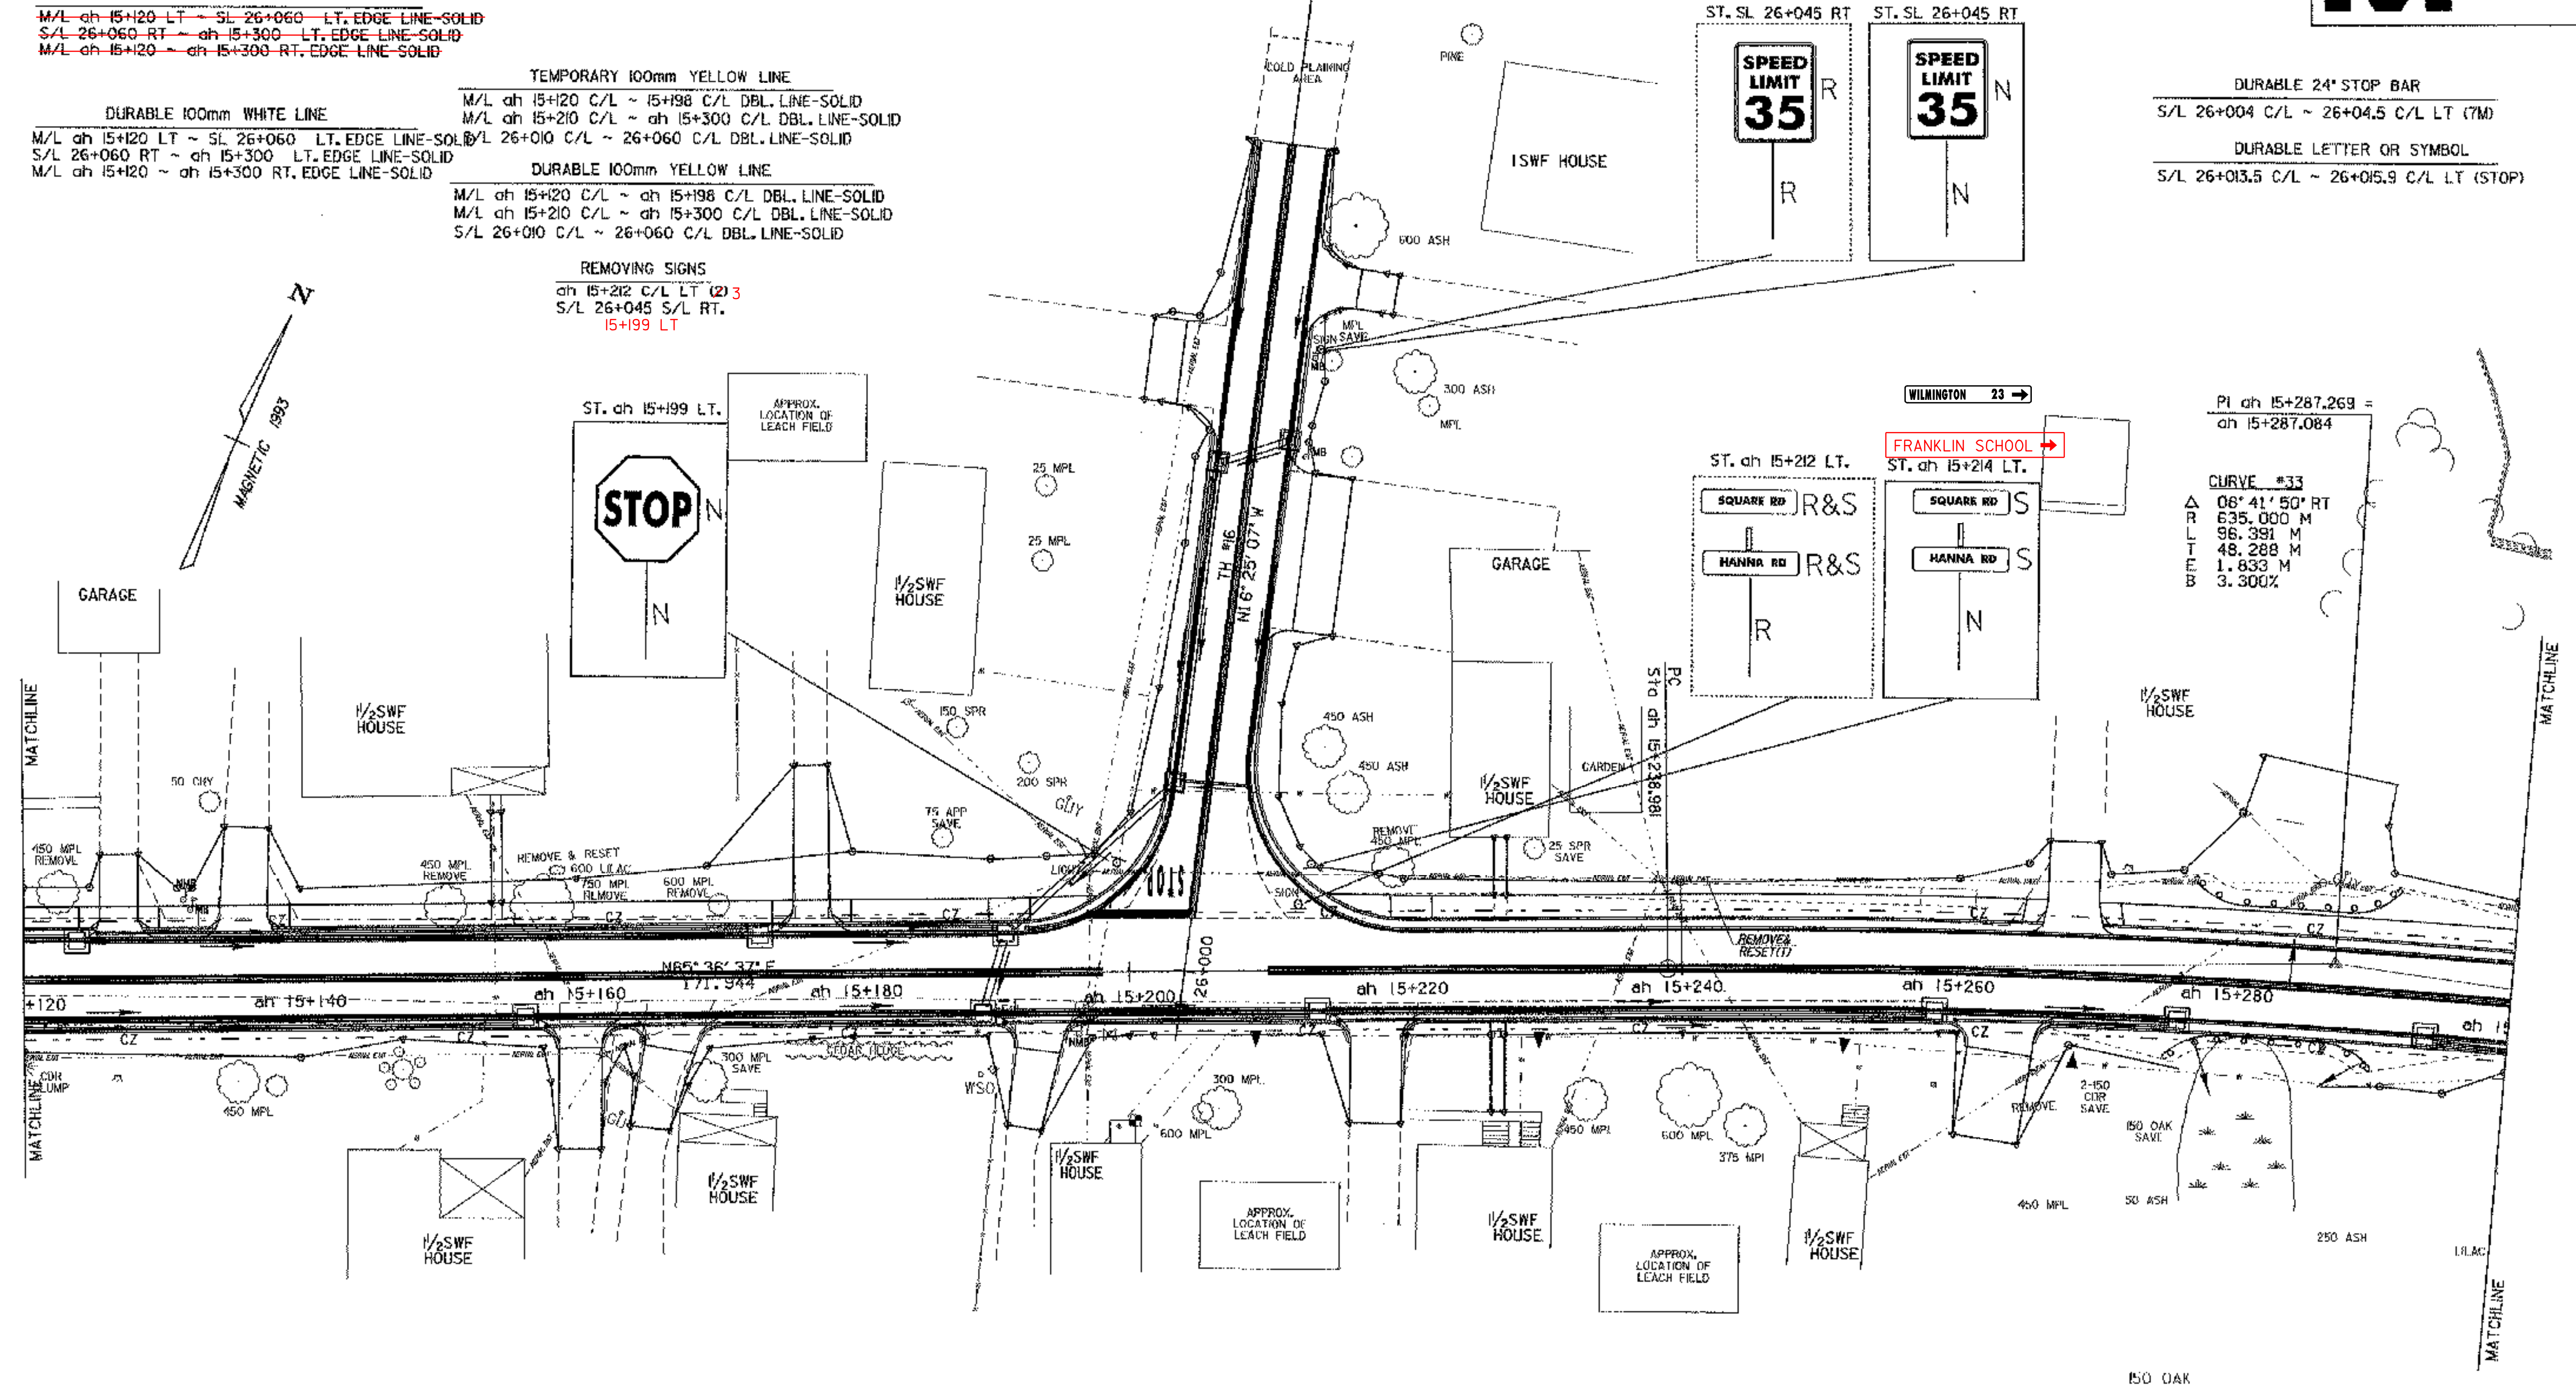

PI ah 15+287.269 =
 ah 15+287.084
 CURVE #33
 Δ 08° 41' 50" RT
 R 635.000 M
 L 96.391 M
 T 48.288 M
 E 1.833 M
 B 3.300%

LEGEND
 R = REMOVE
 N = NEW
 R&S = REMOVE & SALVAGE
 RET = RETAIN

PAVEMENT MARKING & TRAFFIC SIGNING LAYOUT

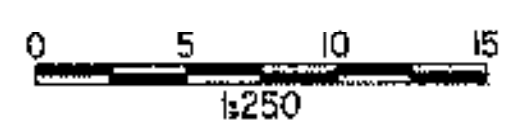

○ DENOTES TREE OR STUMP REMOVAL

ALL DRIVE RADII SHALL BE 6M UNLESS OTHERWISE NOTED PER STD B-71M

PROJECT NAME:	FRANKLIN
PROJECT NUMBER:	STP 030K18
FILE NAME: ...85c060/design/dc060bdr.dgn	PLOT DATE: 27-MAR-2003
PROJECT LEADER: DELLASANTA	DRAWN BY: SQUAD B
DESIGNED BY: SQUAD B	CHECKED BY: SQUAD B
IPARM FILE NAME: (2) dc060pms2	SHEET 35 OF 60