






LEGEND

-  - TO BE REMOVED
-  - PROPOSED TREE
-  - TO BE RELOCATED BY OTHERS
-  - PROTECT EXISTING TREES DURING CONSTRUCTION
-  - EXISTING TREE (TO REMAIN)

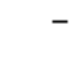

○ DENOTES TREE OR STUMP REMOVAL

ALL DRIVE RADII SHALL BE 6M UNLESS OTHERWISE NOTED PER STD B-71 M

LANDSCAPE PLANS

SCAPE PLANS

PROJECT NAME:	FRANKLIN
PROJECT NUMBER:	STP 030(18)
FILE NAME:	85c060/design/2)boreo.dgn
PROJECT LEADER:	DELLASANTA
DESIGNED BY:	SQUAD B
IPARM FILE NAME:	(2)dc060ln2.1
PLOT DATE:	27-MAR-2003
DRAWN BY:	SQUAD B
CHECKED BY:	SQUAD B
SHEET	41 OF 60