


PLAN VIEW  
SCALE 1" = 10'-0"

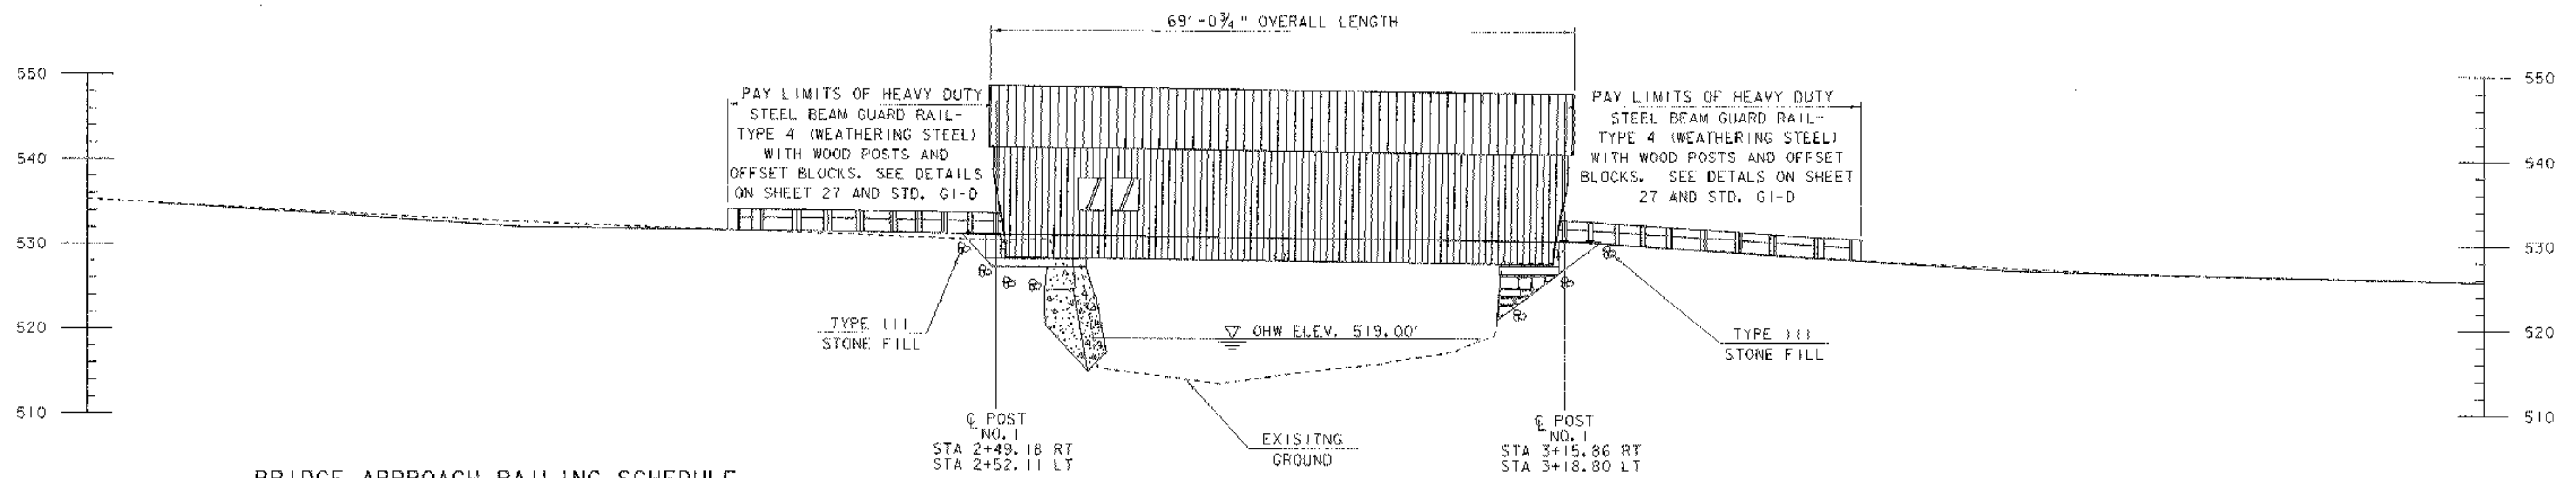

DOWNSTREAM ELEVATION  
SCALE 1" = 10'-0"

BRIDGE APPROACH RAILING SCHEDULE

POST NO.	SPACING	PAYMENT FACTOR
1	3'-1 1/2"	1.4 X 12'-6"
2	3'-1 1/2"	
3	3'-1 1/2"	
4	3'-1 1/2"	
5	4'-2"	1.2 X 12'-6"
6	4'-2"	
7	4'-2"	
8	6'-3"	1.0 (TYP.)
9	6'-3"	
10	6'-3"	

DATUM  
VERTICAL ... NAVD83  
HORIZONTAL ... NAD83 (96)

SCALE 1" = 10'-0"

PROJECT: TUNBRIDGE  
DESIGN FILE NAME: s03j032/Structures/s03j032pe.dgn  
IPARM FILE NAME: s03j032pe.i  
SURVEYED BY: R. GILMAN  
SQUAD LEADER: C.P. WILLIAMS

PROJECT NO.: BHO 1444 (42)  
PLOT DATE: 25-AUG-2005  
SURVEY DATE: 06/08/03  
DRAWN BY: E.L. RUSTAY  
SHEET: 9 OF 40