



I+25

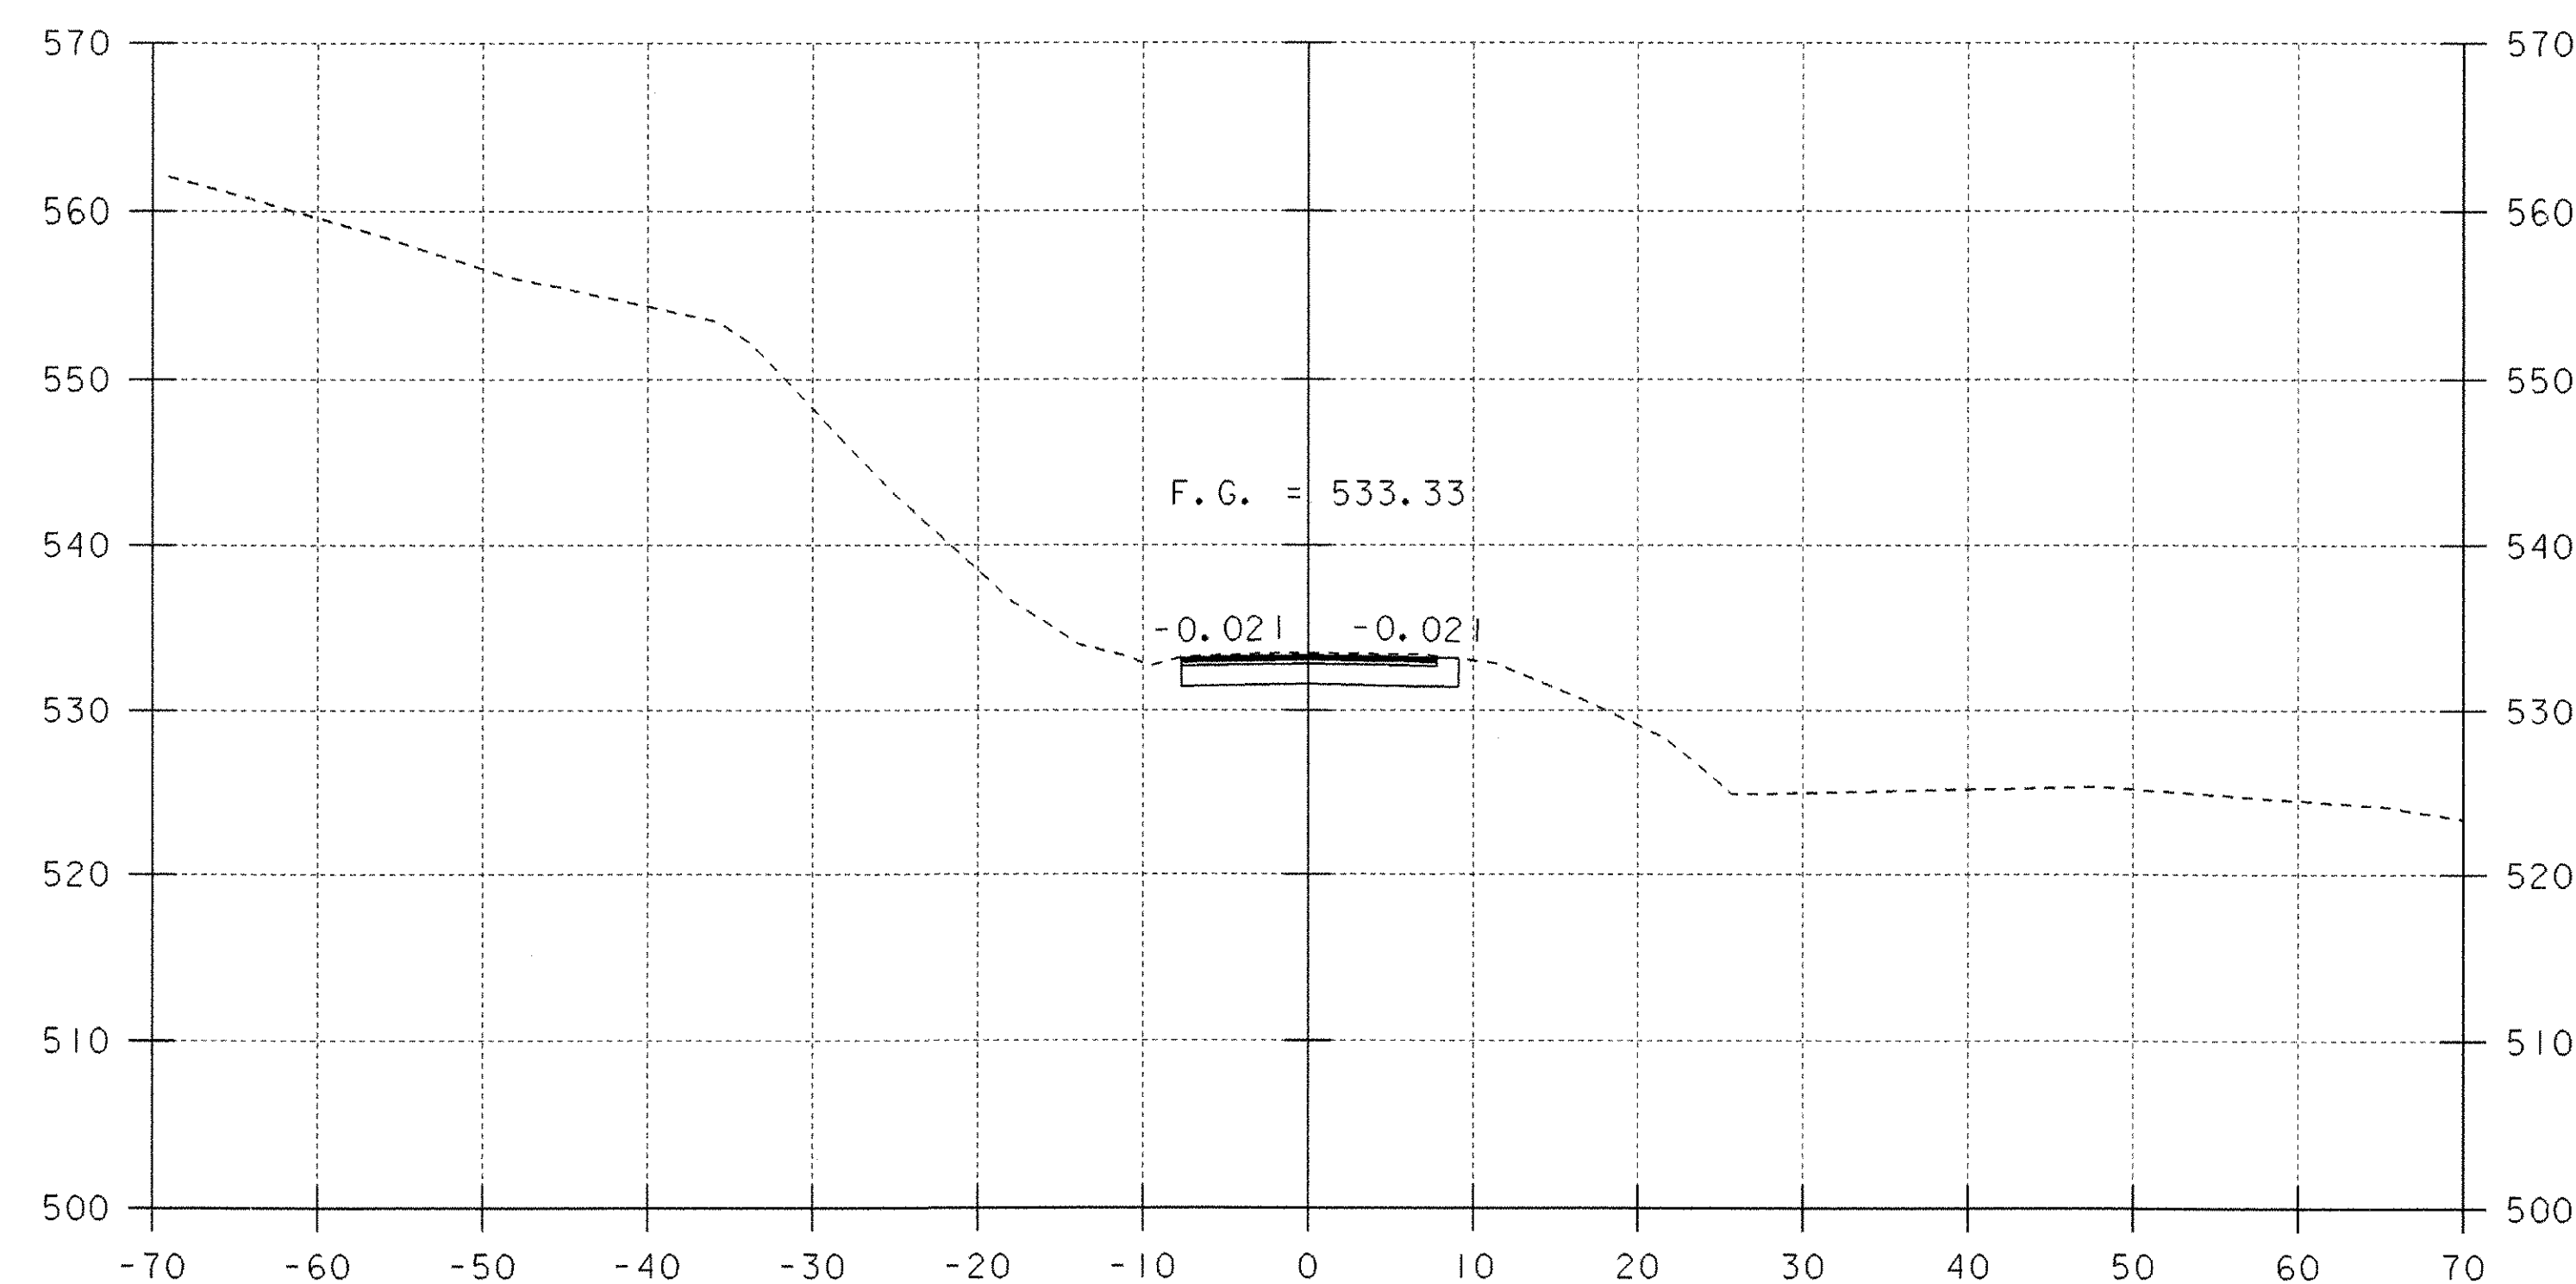


F. G. = 533.33

-0.021 -0.021

I+75

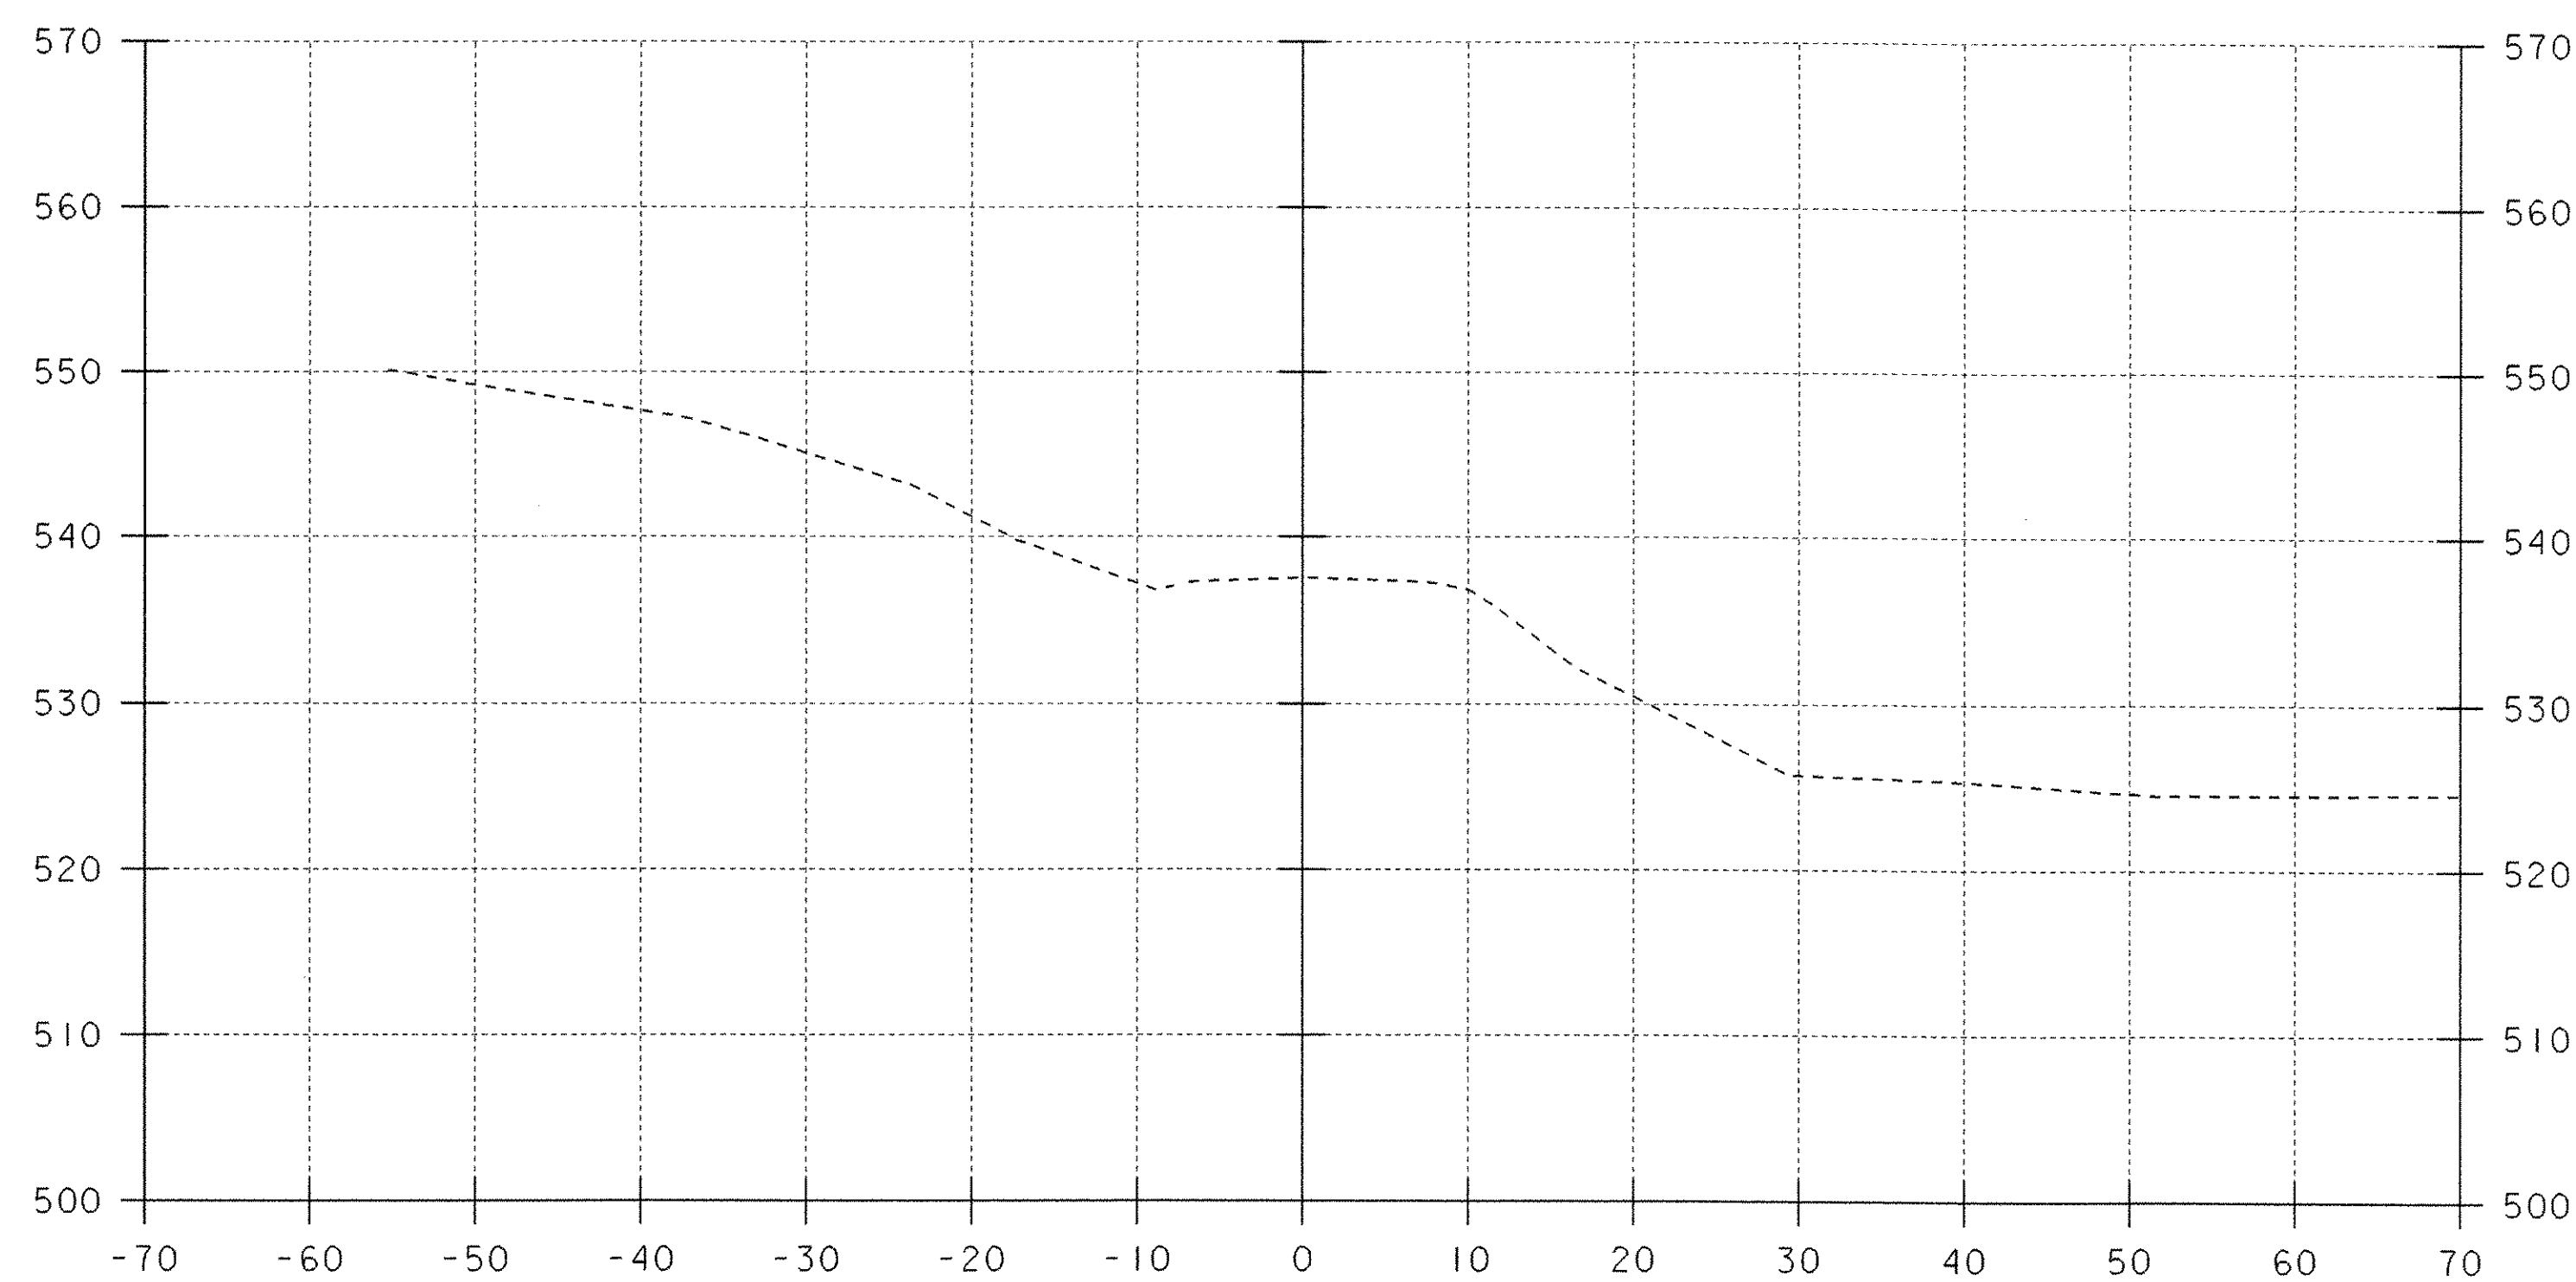

I+00

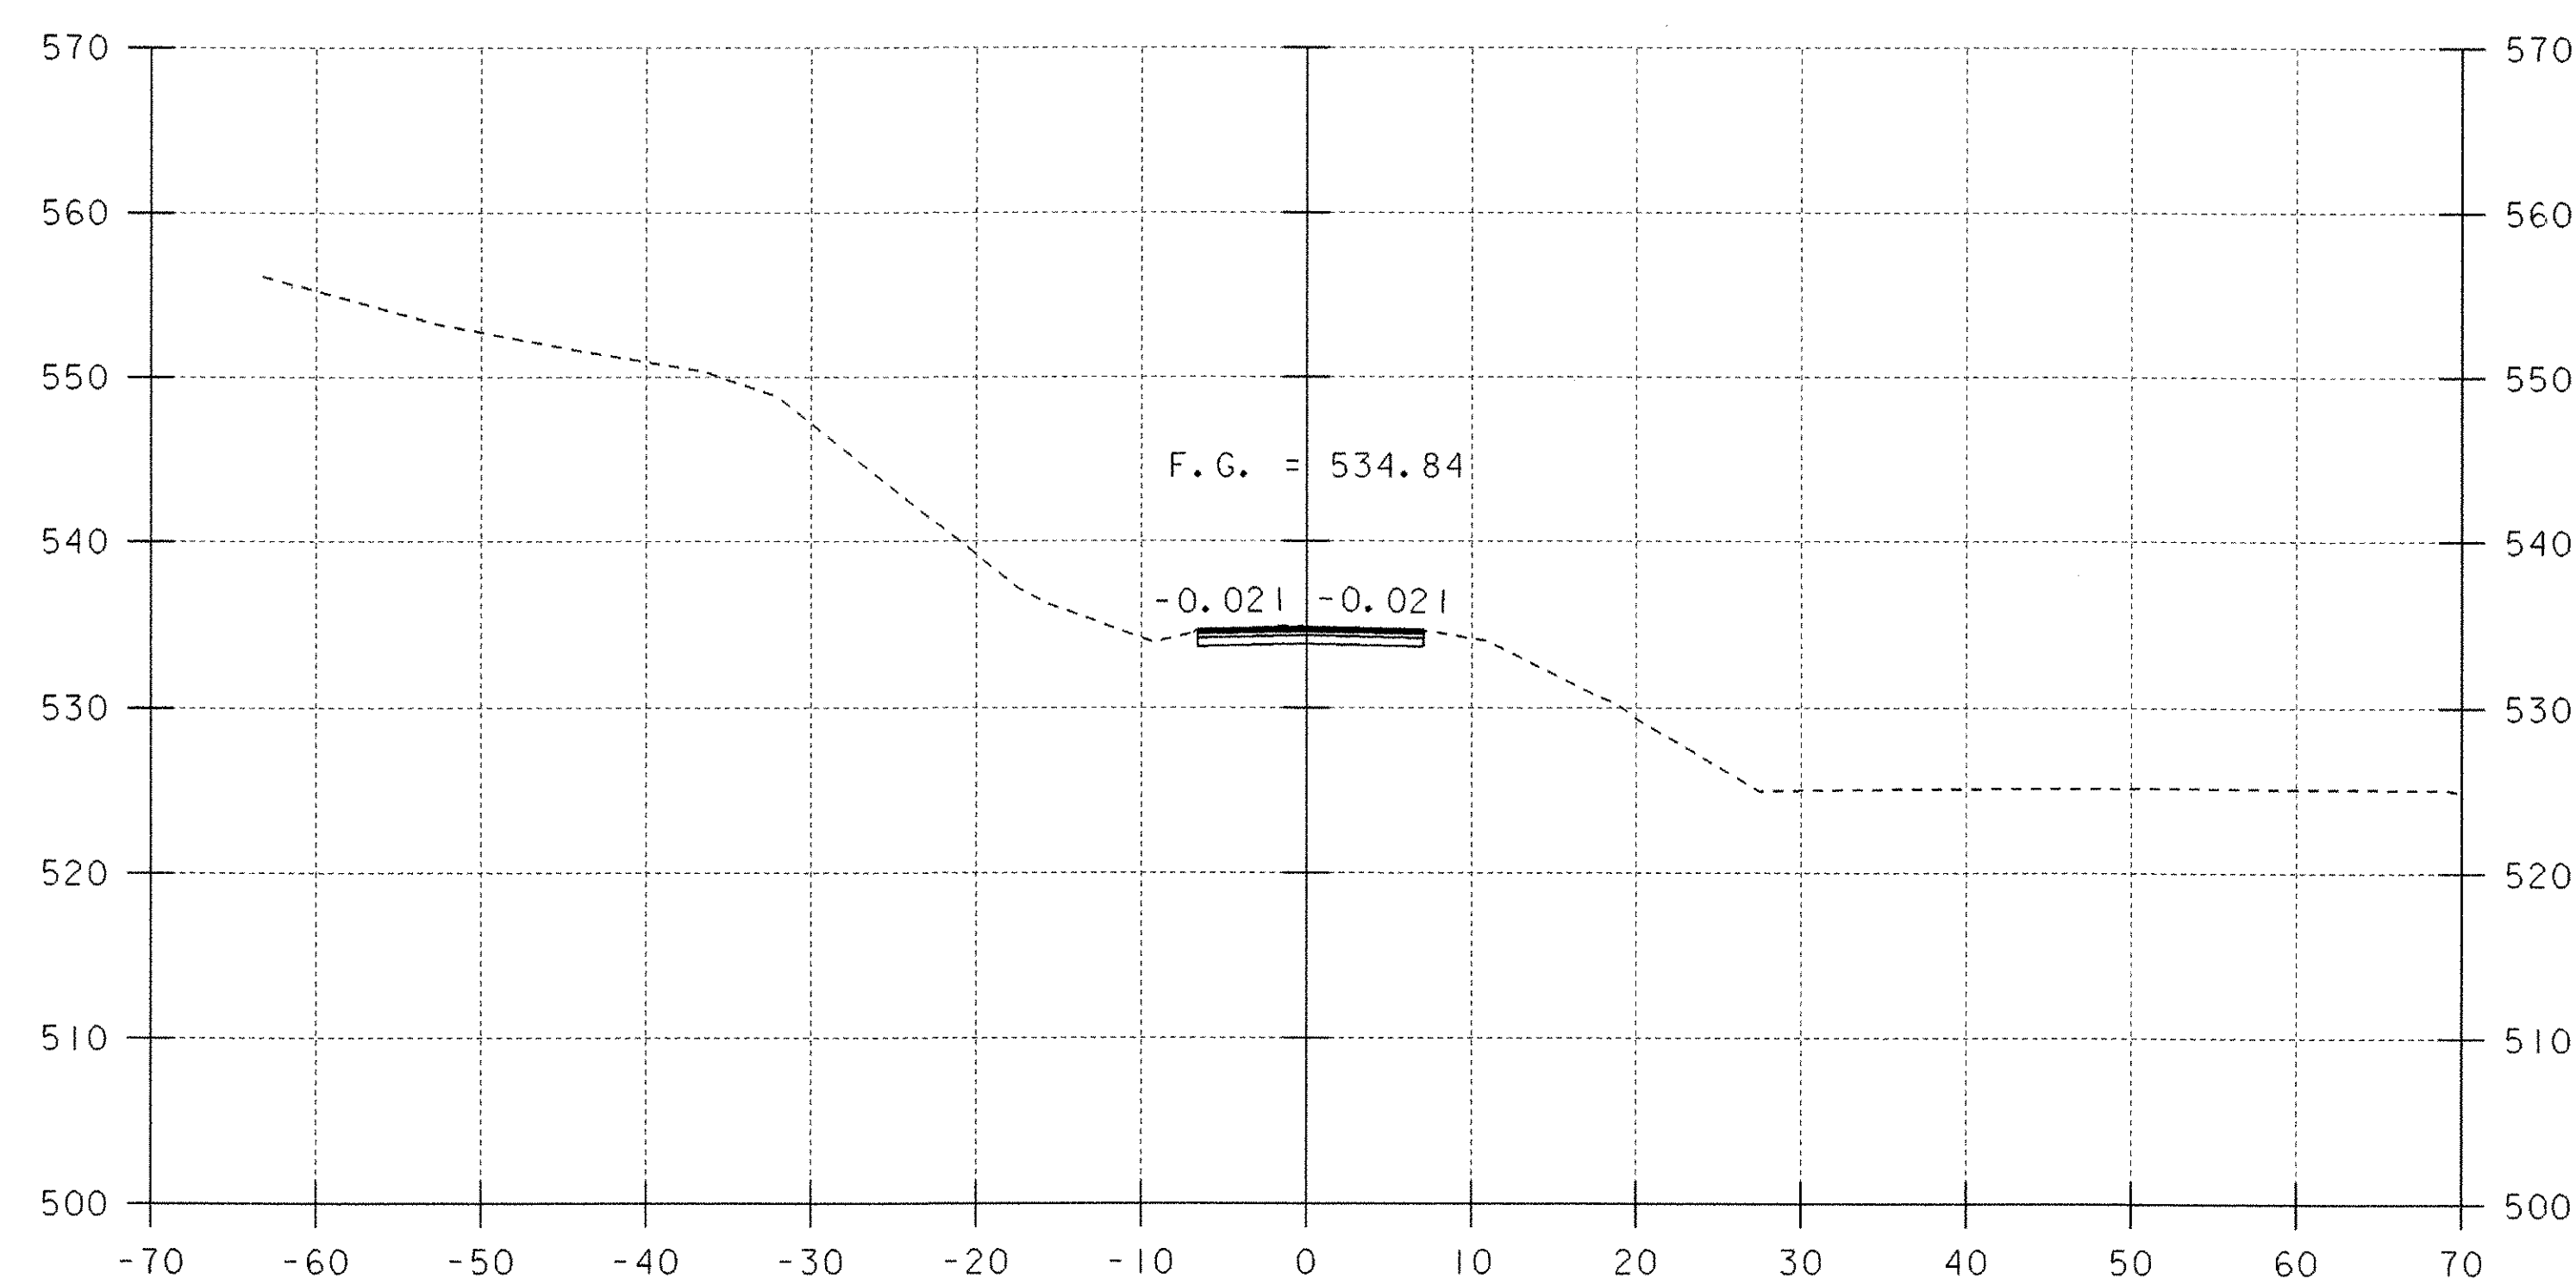

F. G. = 534.84

-0.021 -0.021

I+50

BEGIN APPROACH AT
STATION I+50.00

SCALE 1" = 10'-0"
10 0 10

PROJECT: TUNBRIDGE	PROJECT NO.: BHO 1444 (42)
DESIGN FILE NAME: 03j032/Structures/s03j032mx.dgn	PLOT DATE: 25-AUG-2005
IPARM FILE NAME: s03j032m1x1.i	
MAINLINE CROSS SECTIONS	
STA I+00 TO STA I+75	SHEET: 26 OF 40