



2+25

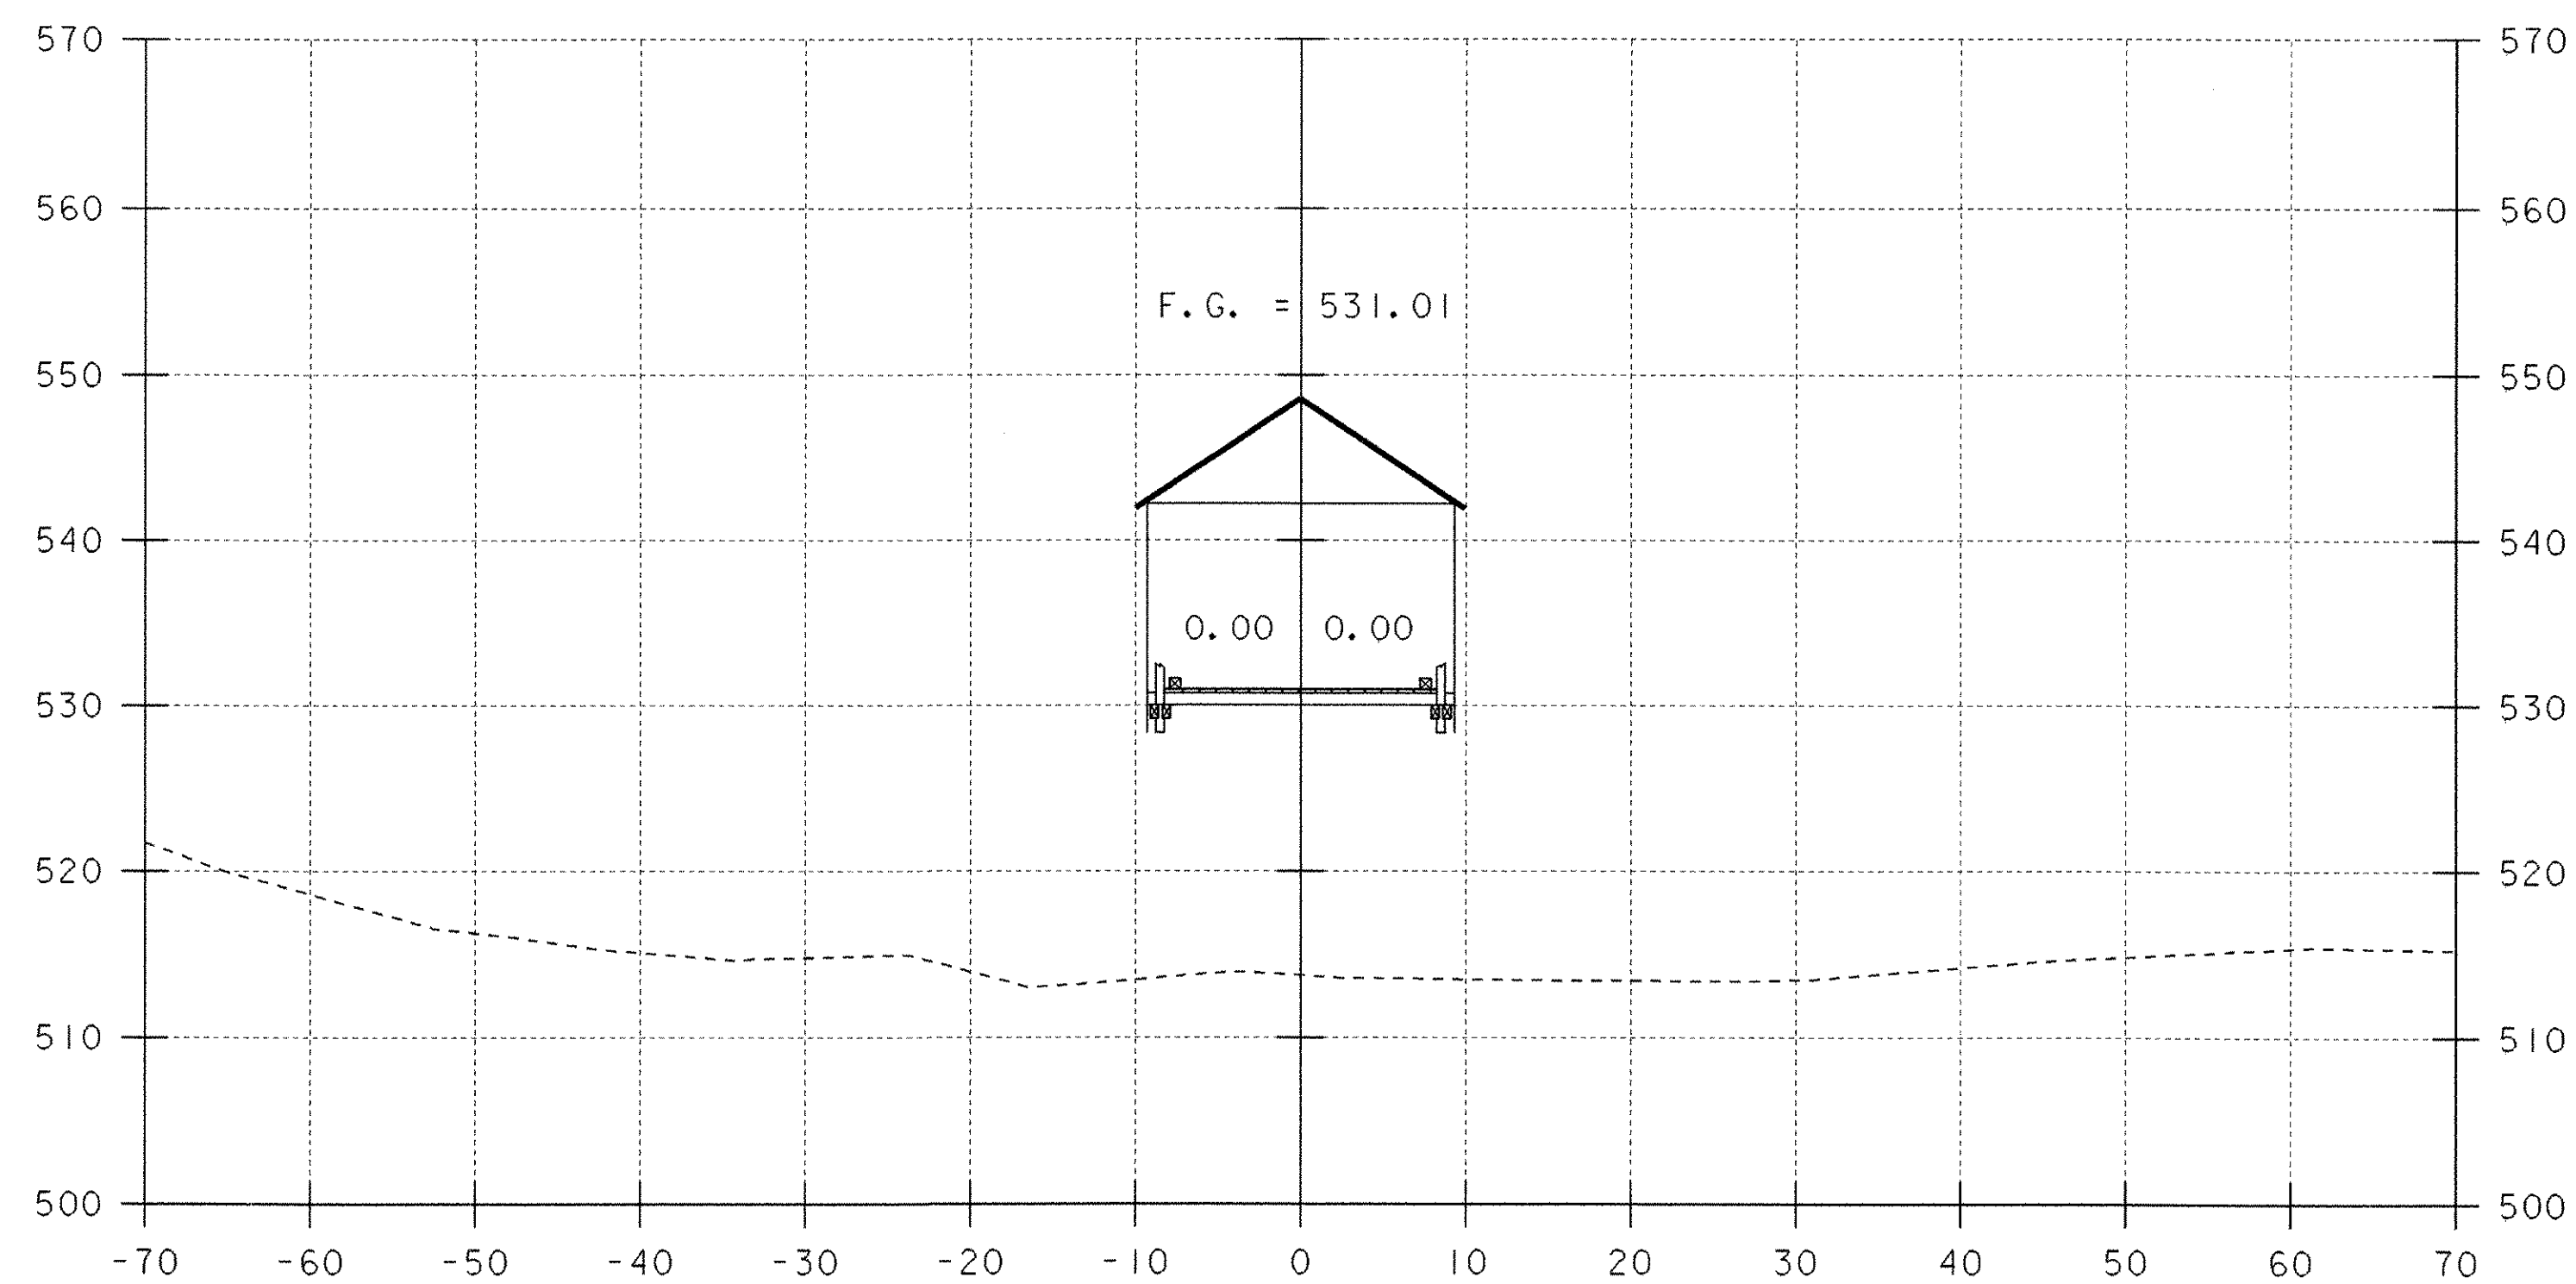


2+75

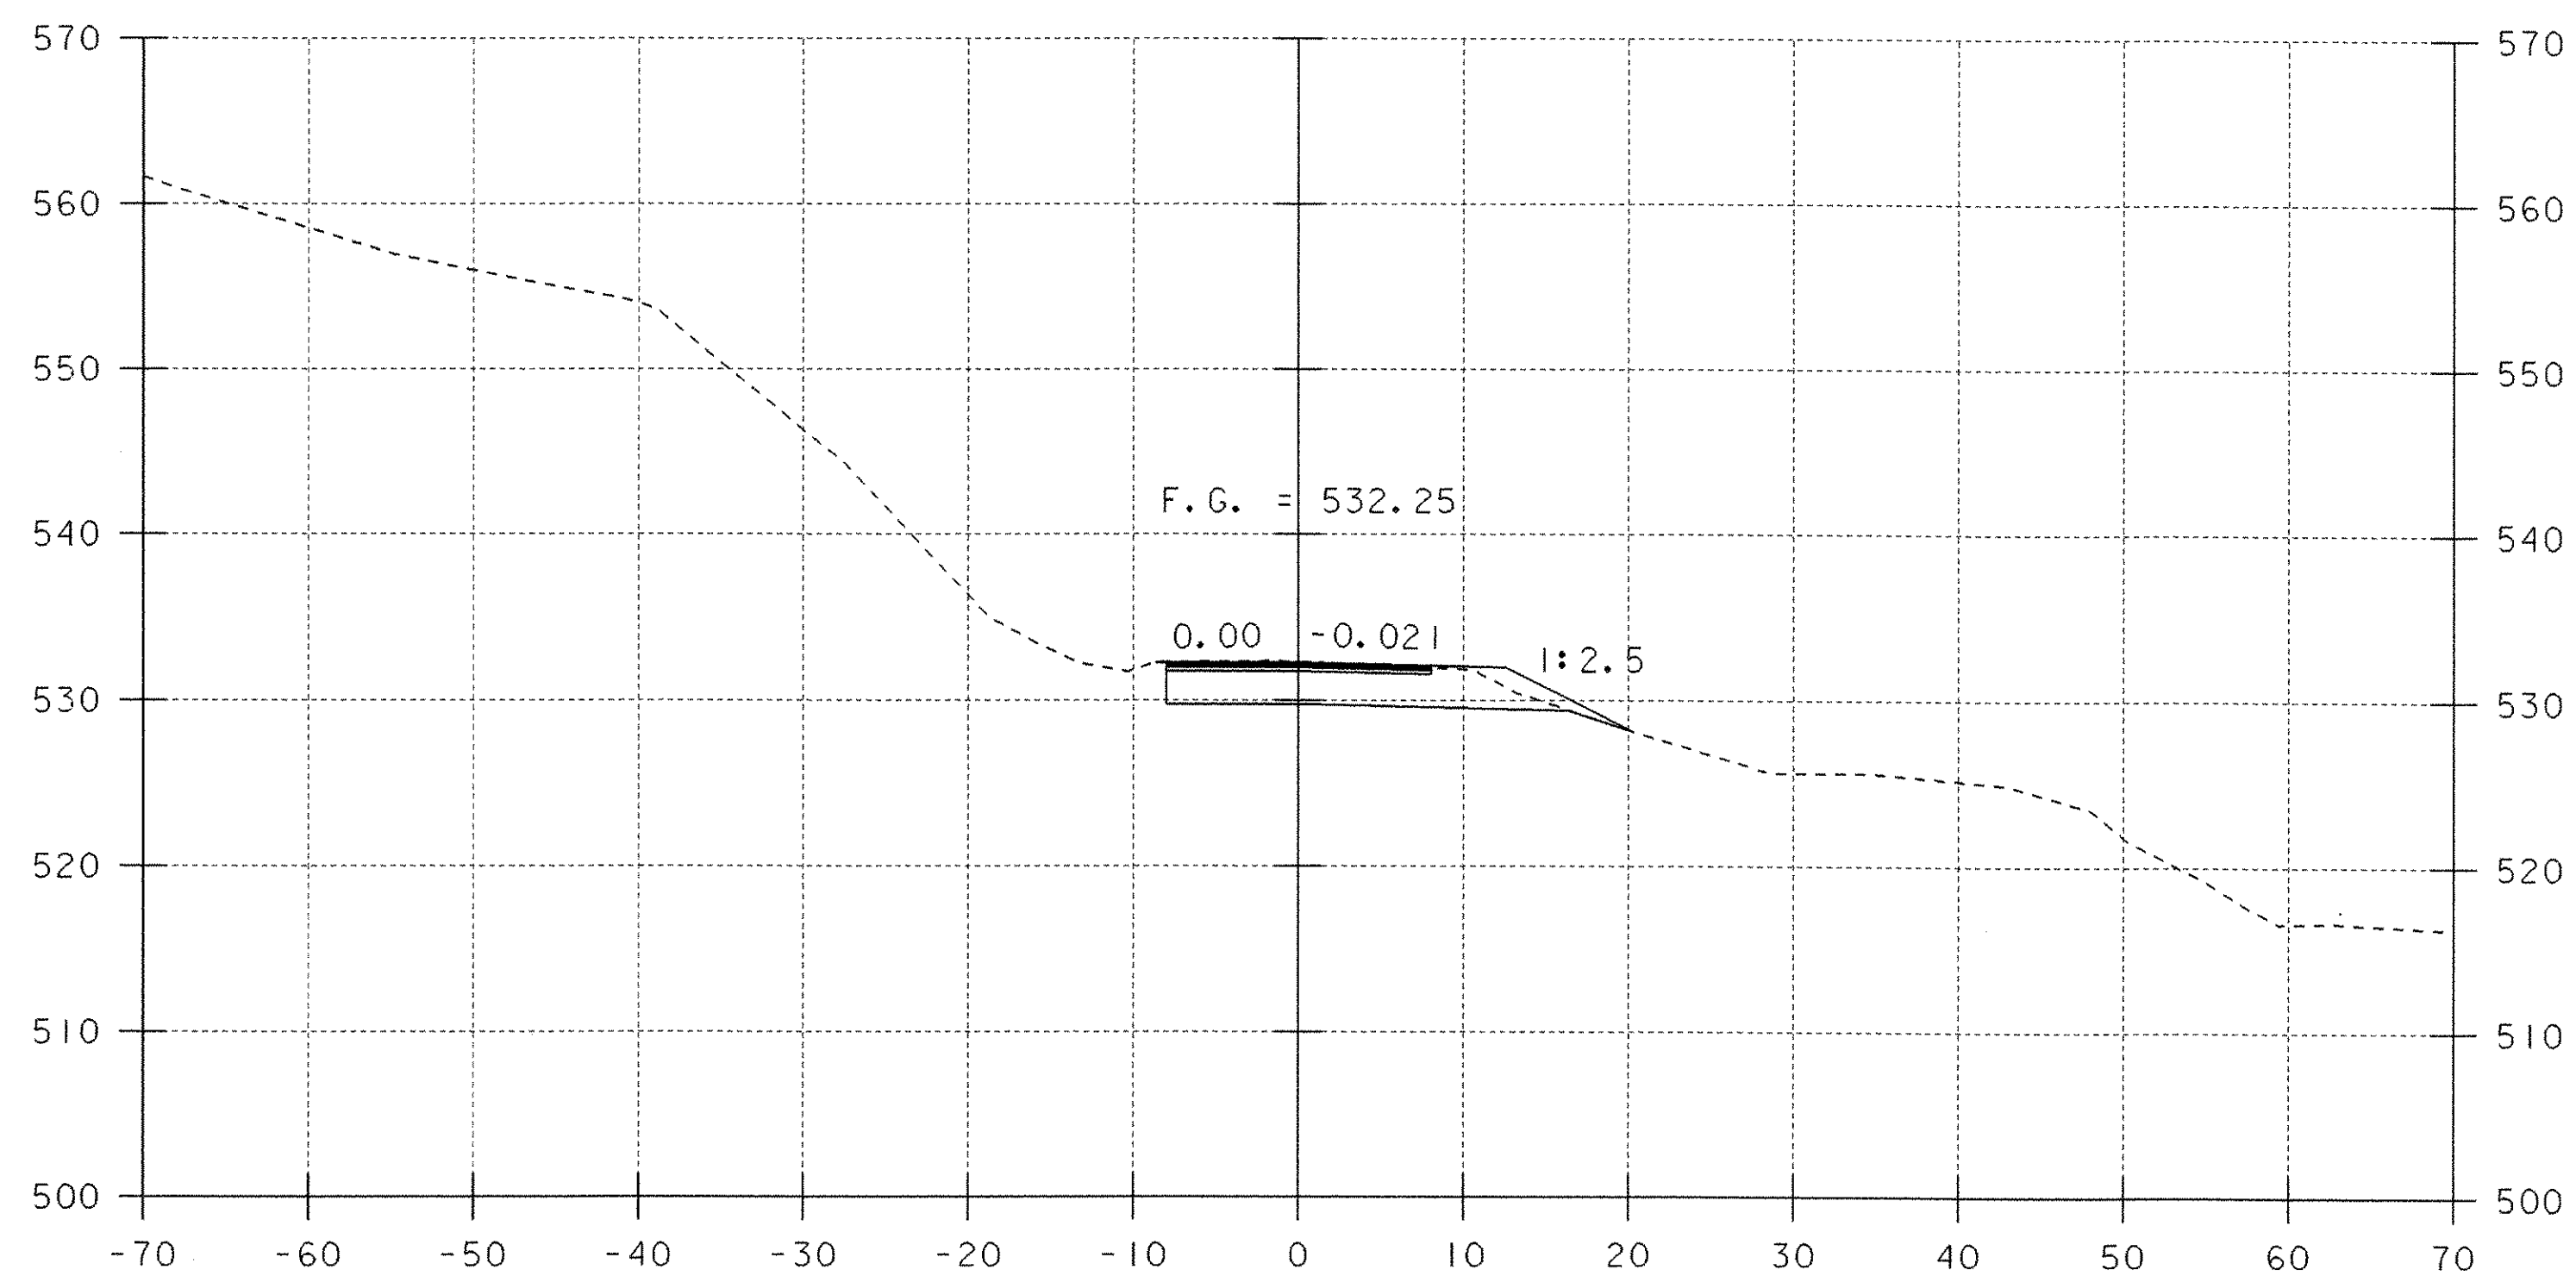

2+00

BEGIN PROJECT AT  
STATION 2+00.00

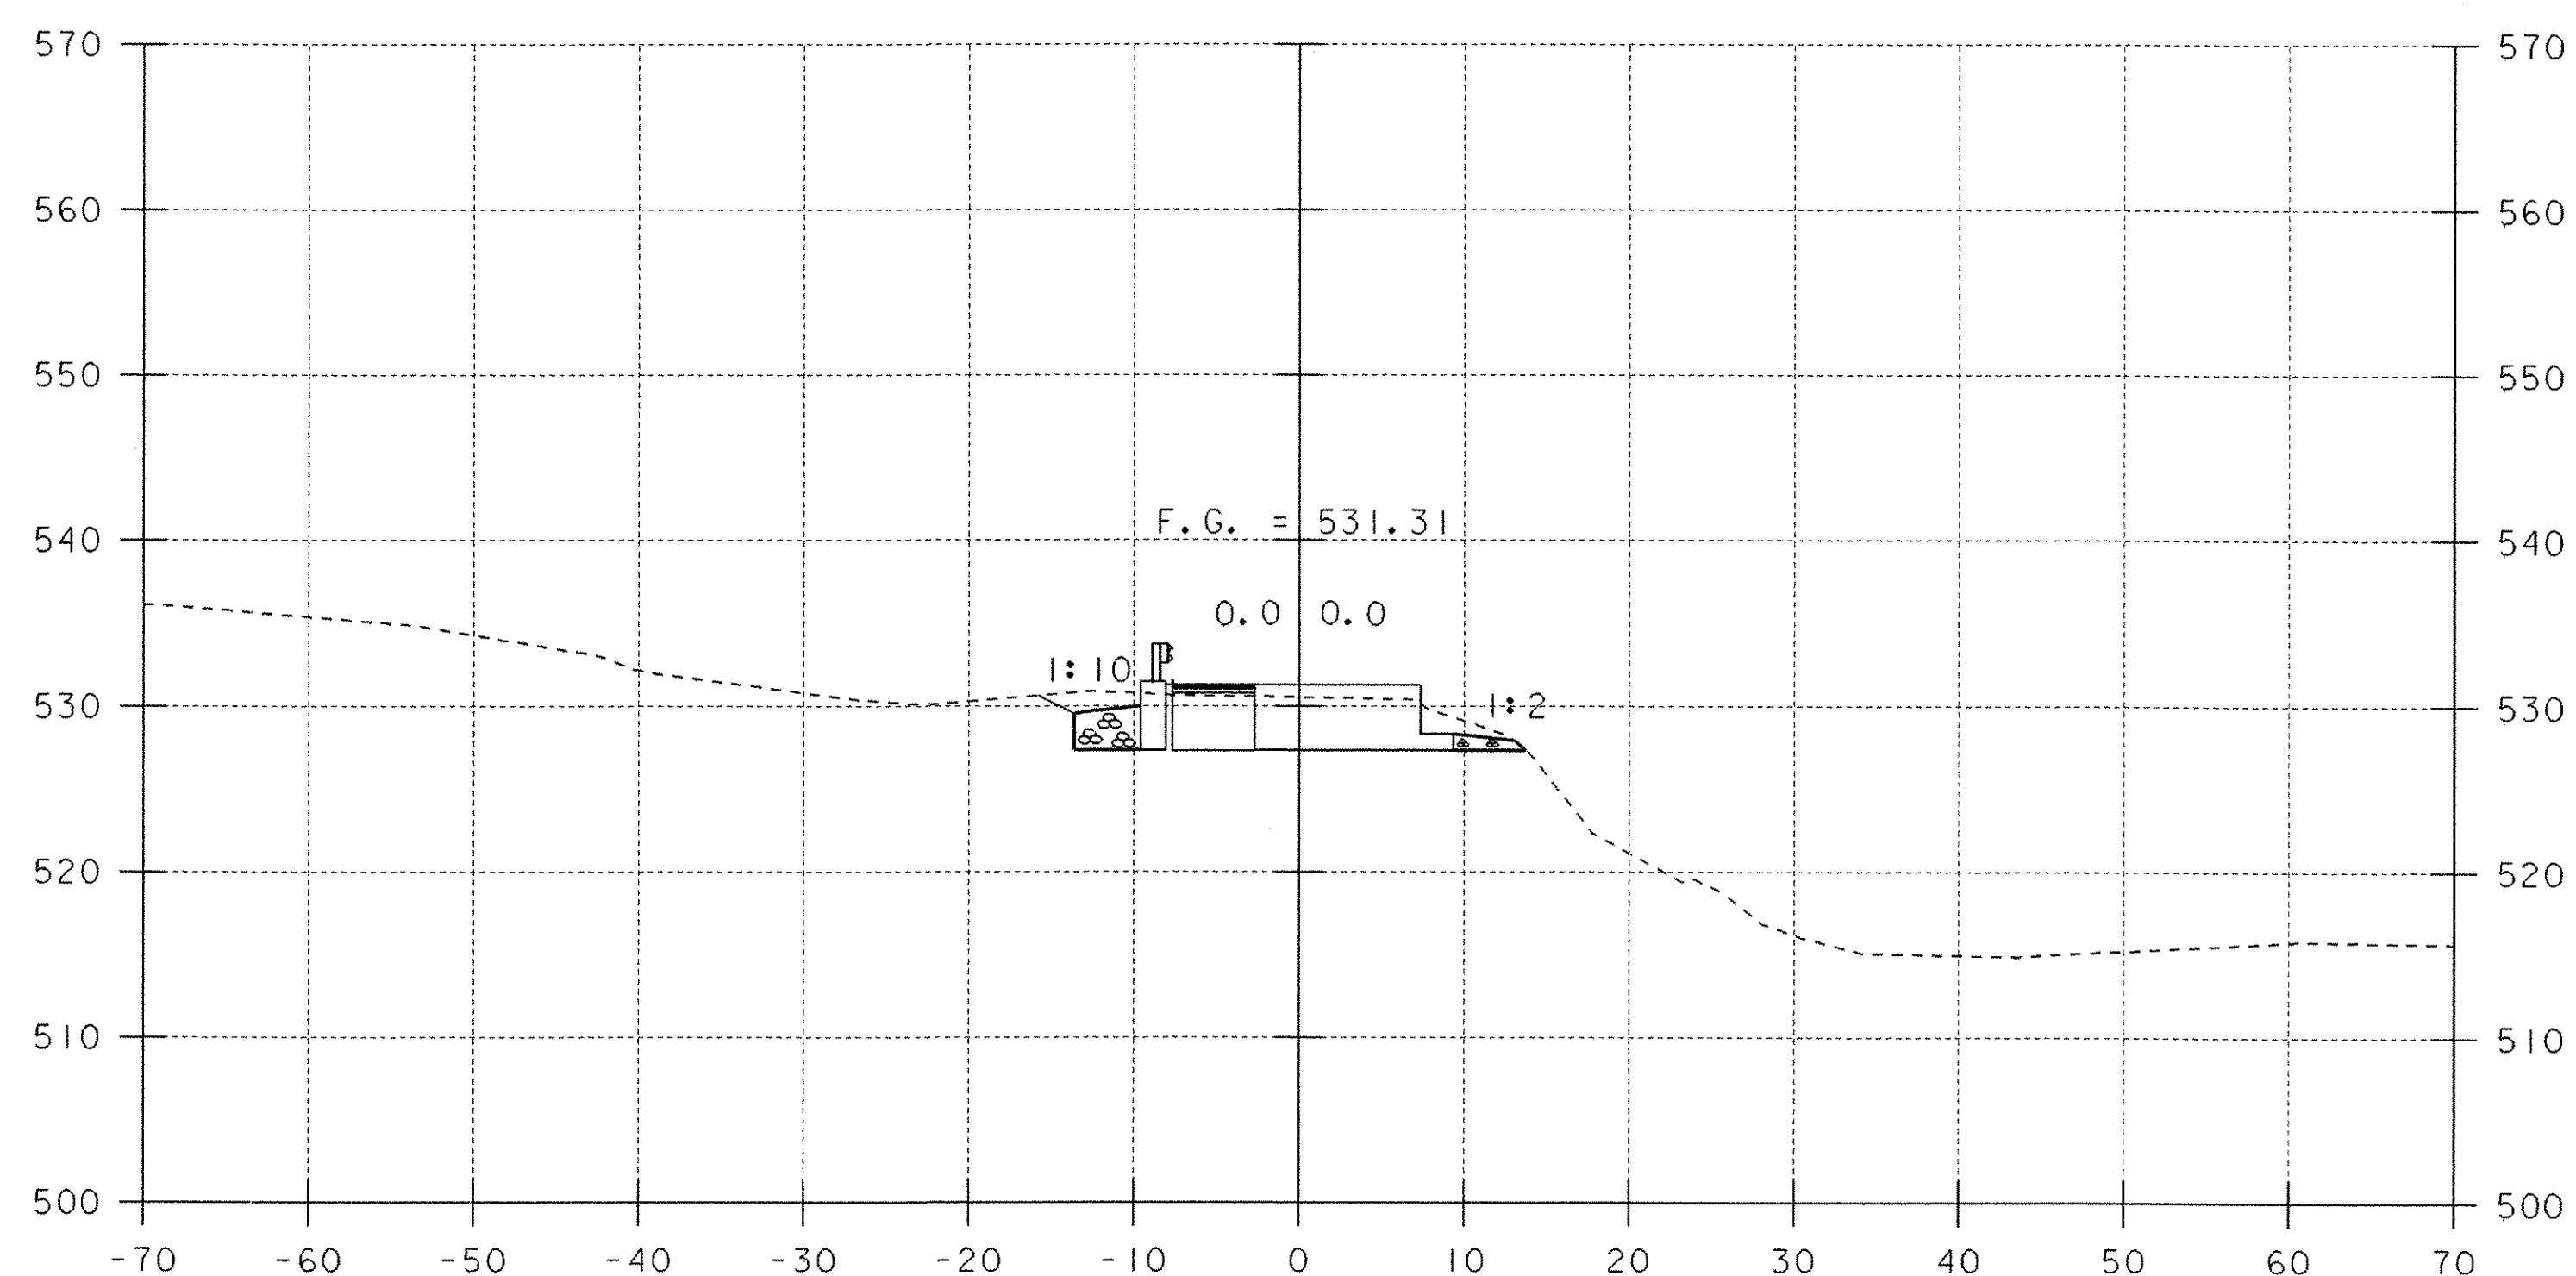

2+50

BEGIN BRIDGE AT  
STATION 2+49.00

SCALE 1" = 10'-0"  
10 0 10

PROJECT: TUNBRIDGE	PROJECT NO.: BHO 1444 (42)
DESIGN FILE NAME: 03j032/Structures/s03j032mx.dgn	PLOT DATE: 25-AUG-2005
IPARM FILE NAME: s03j032m1x2.i	
MAINLINE CROSS SECTIONS	
STA 2+00 TO STA 2+75	SHEET: 27 OF 40