




4+25

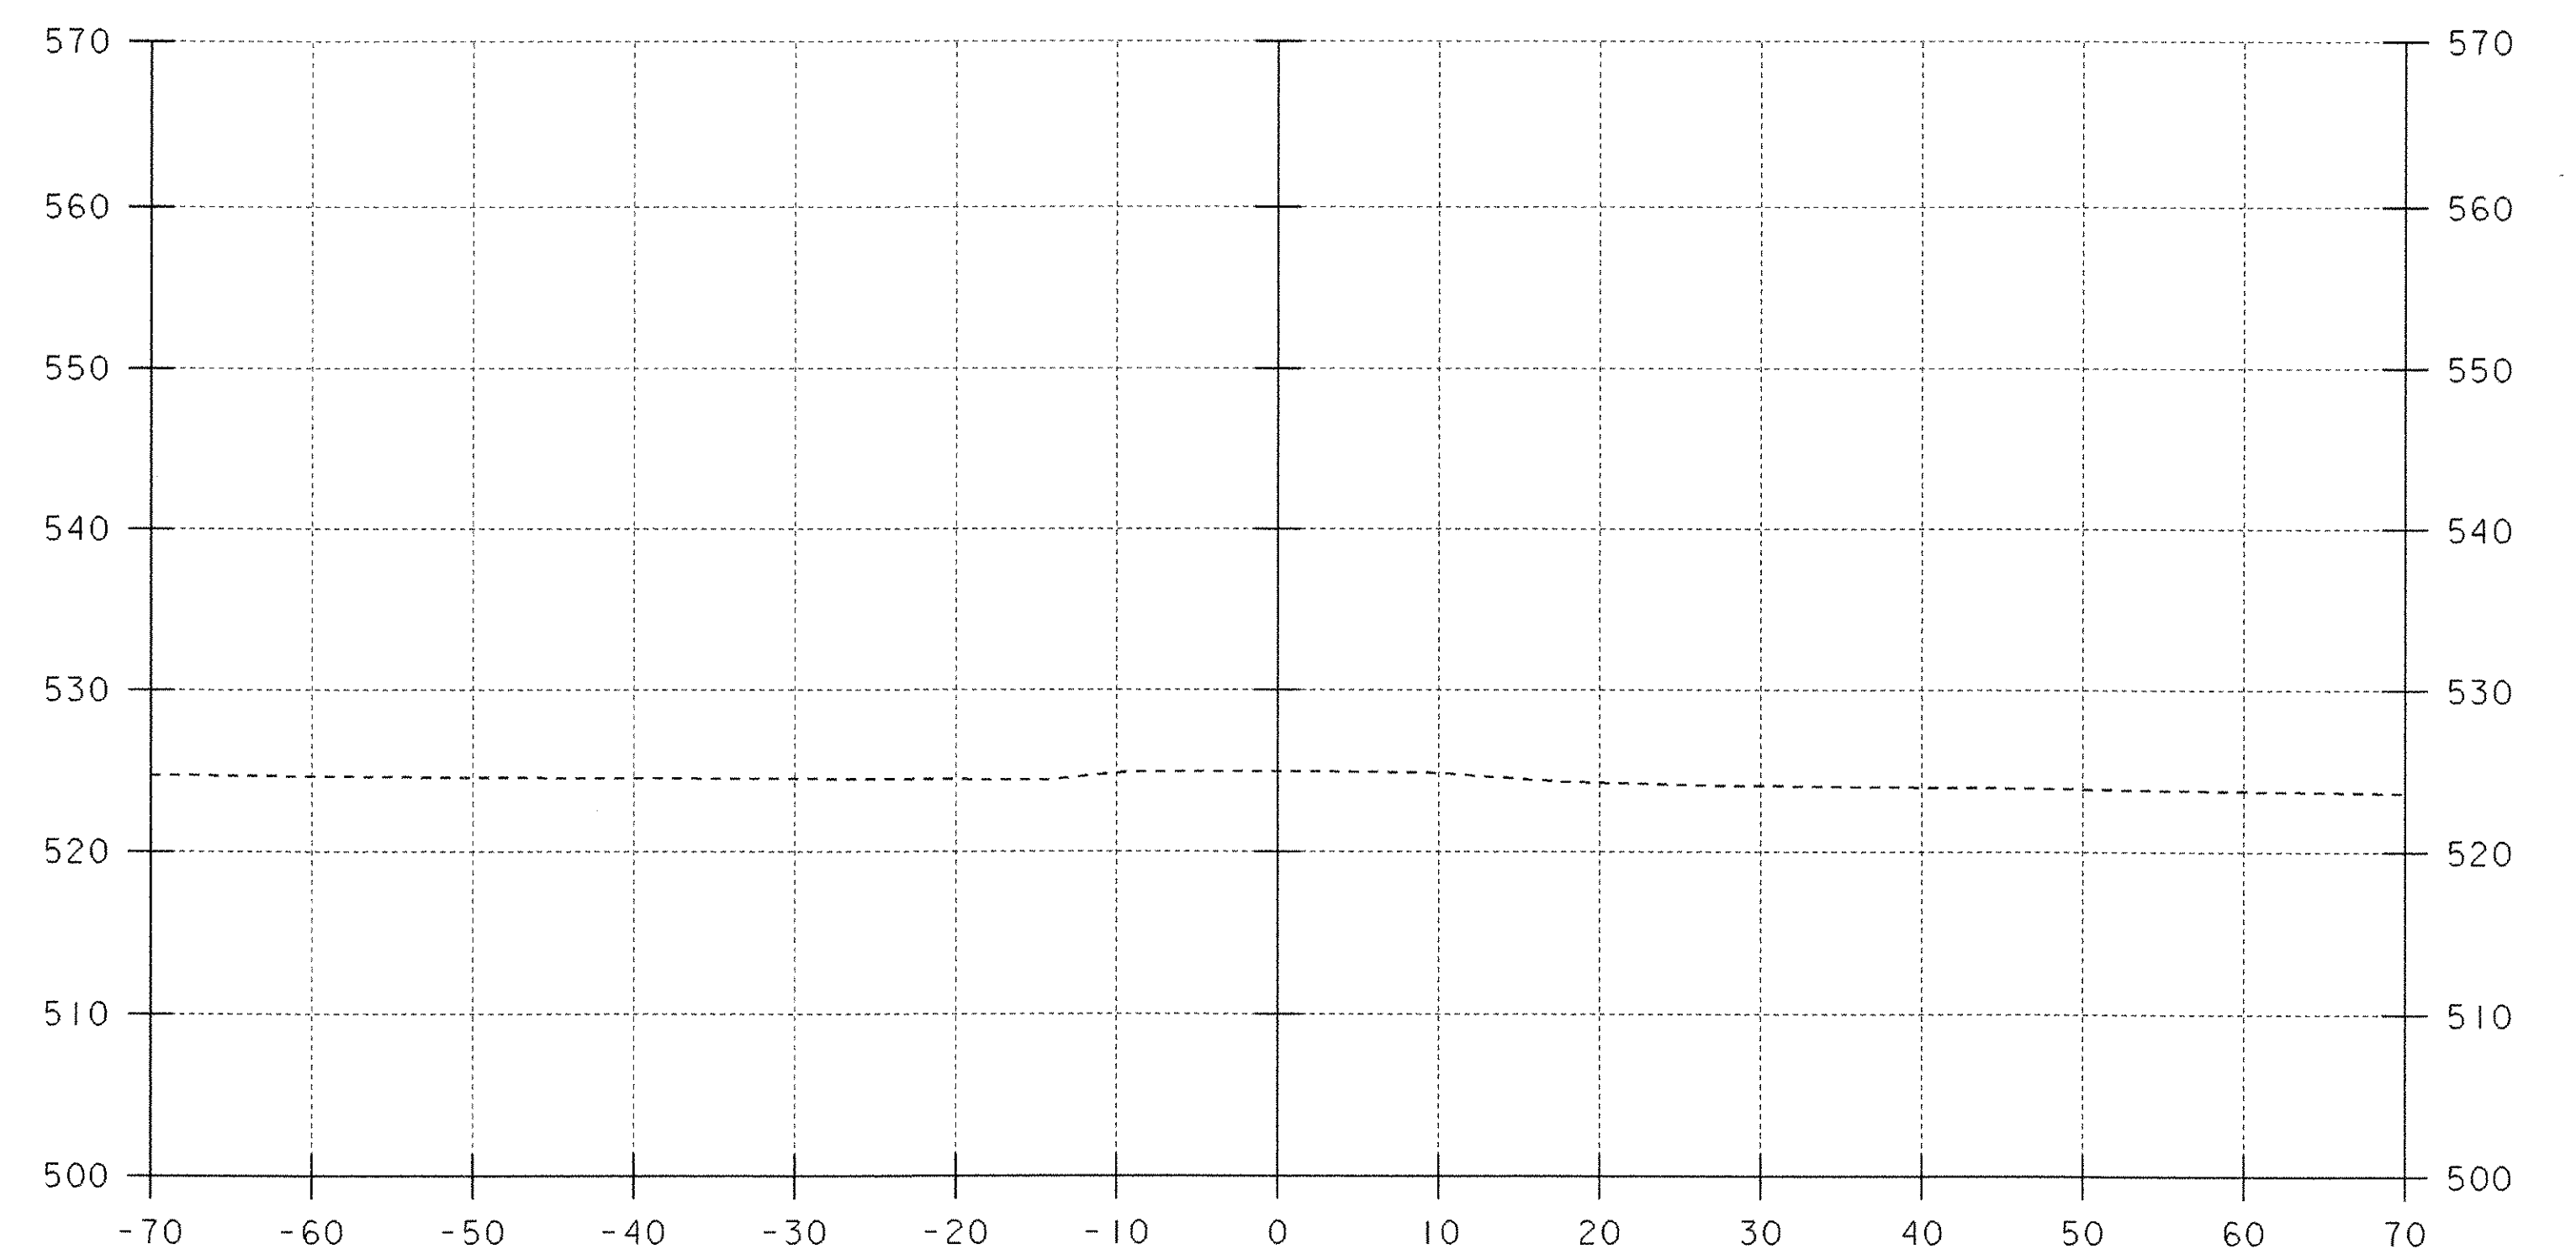

4+75

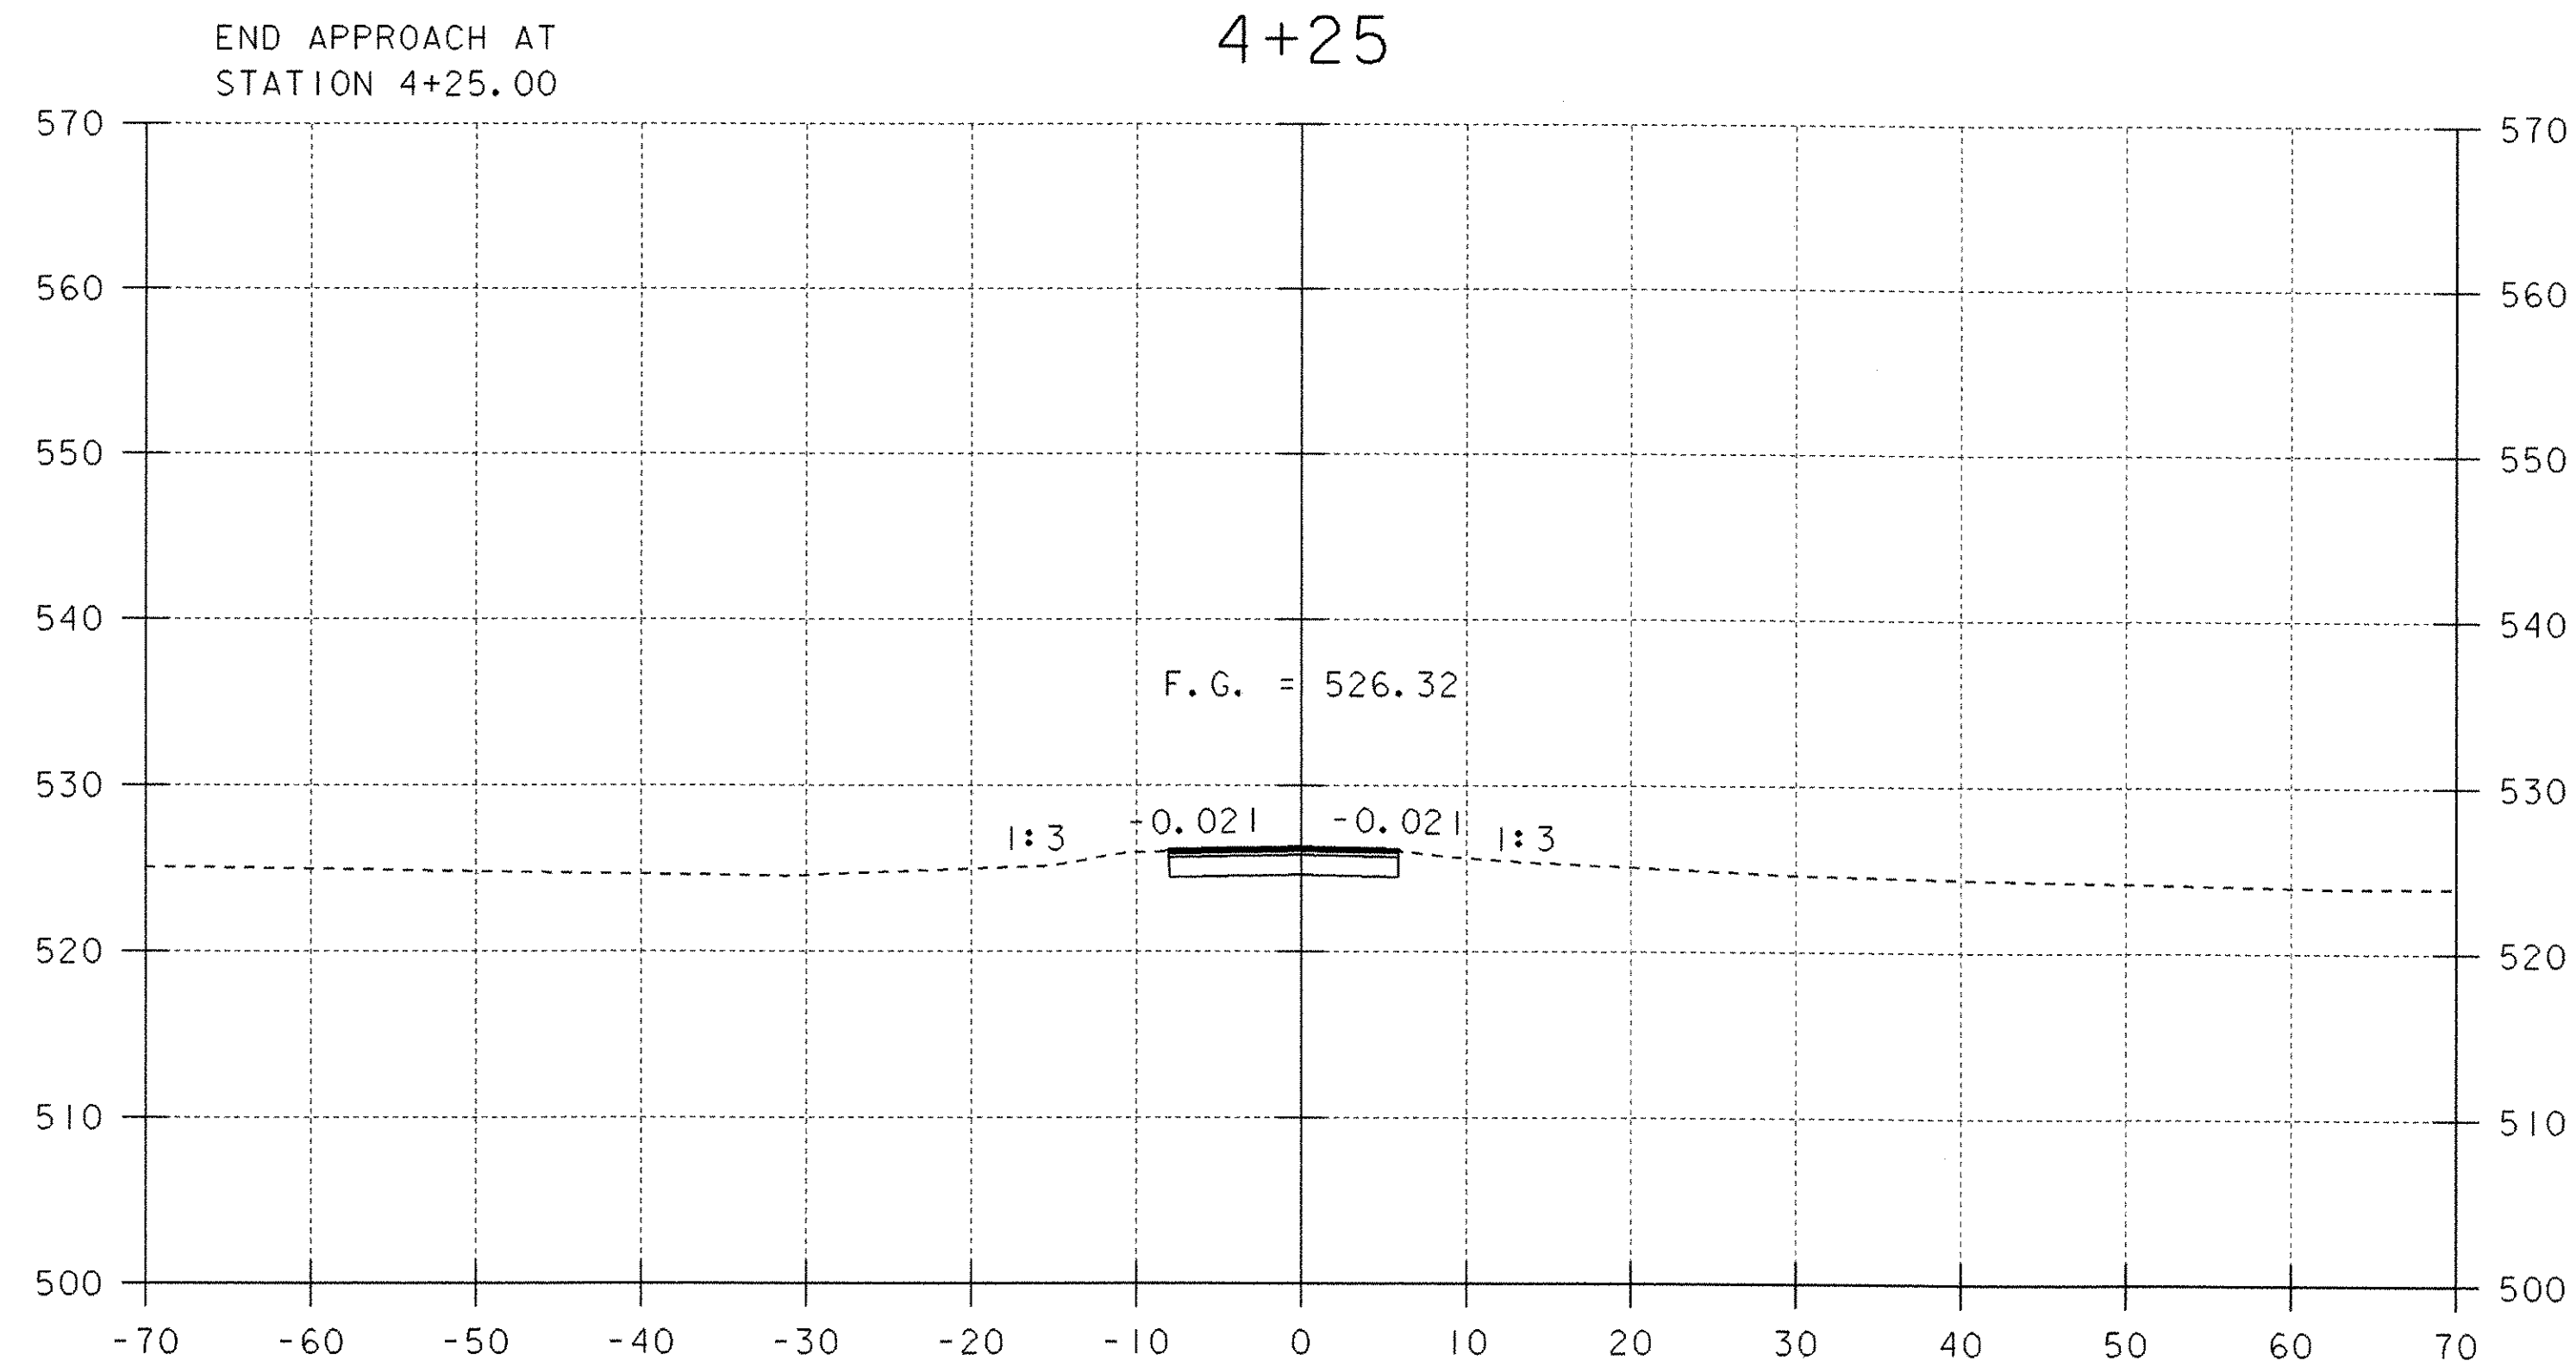

4+00

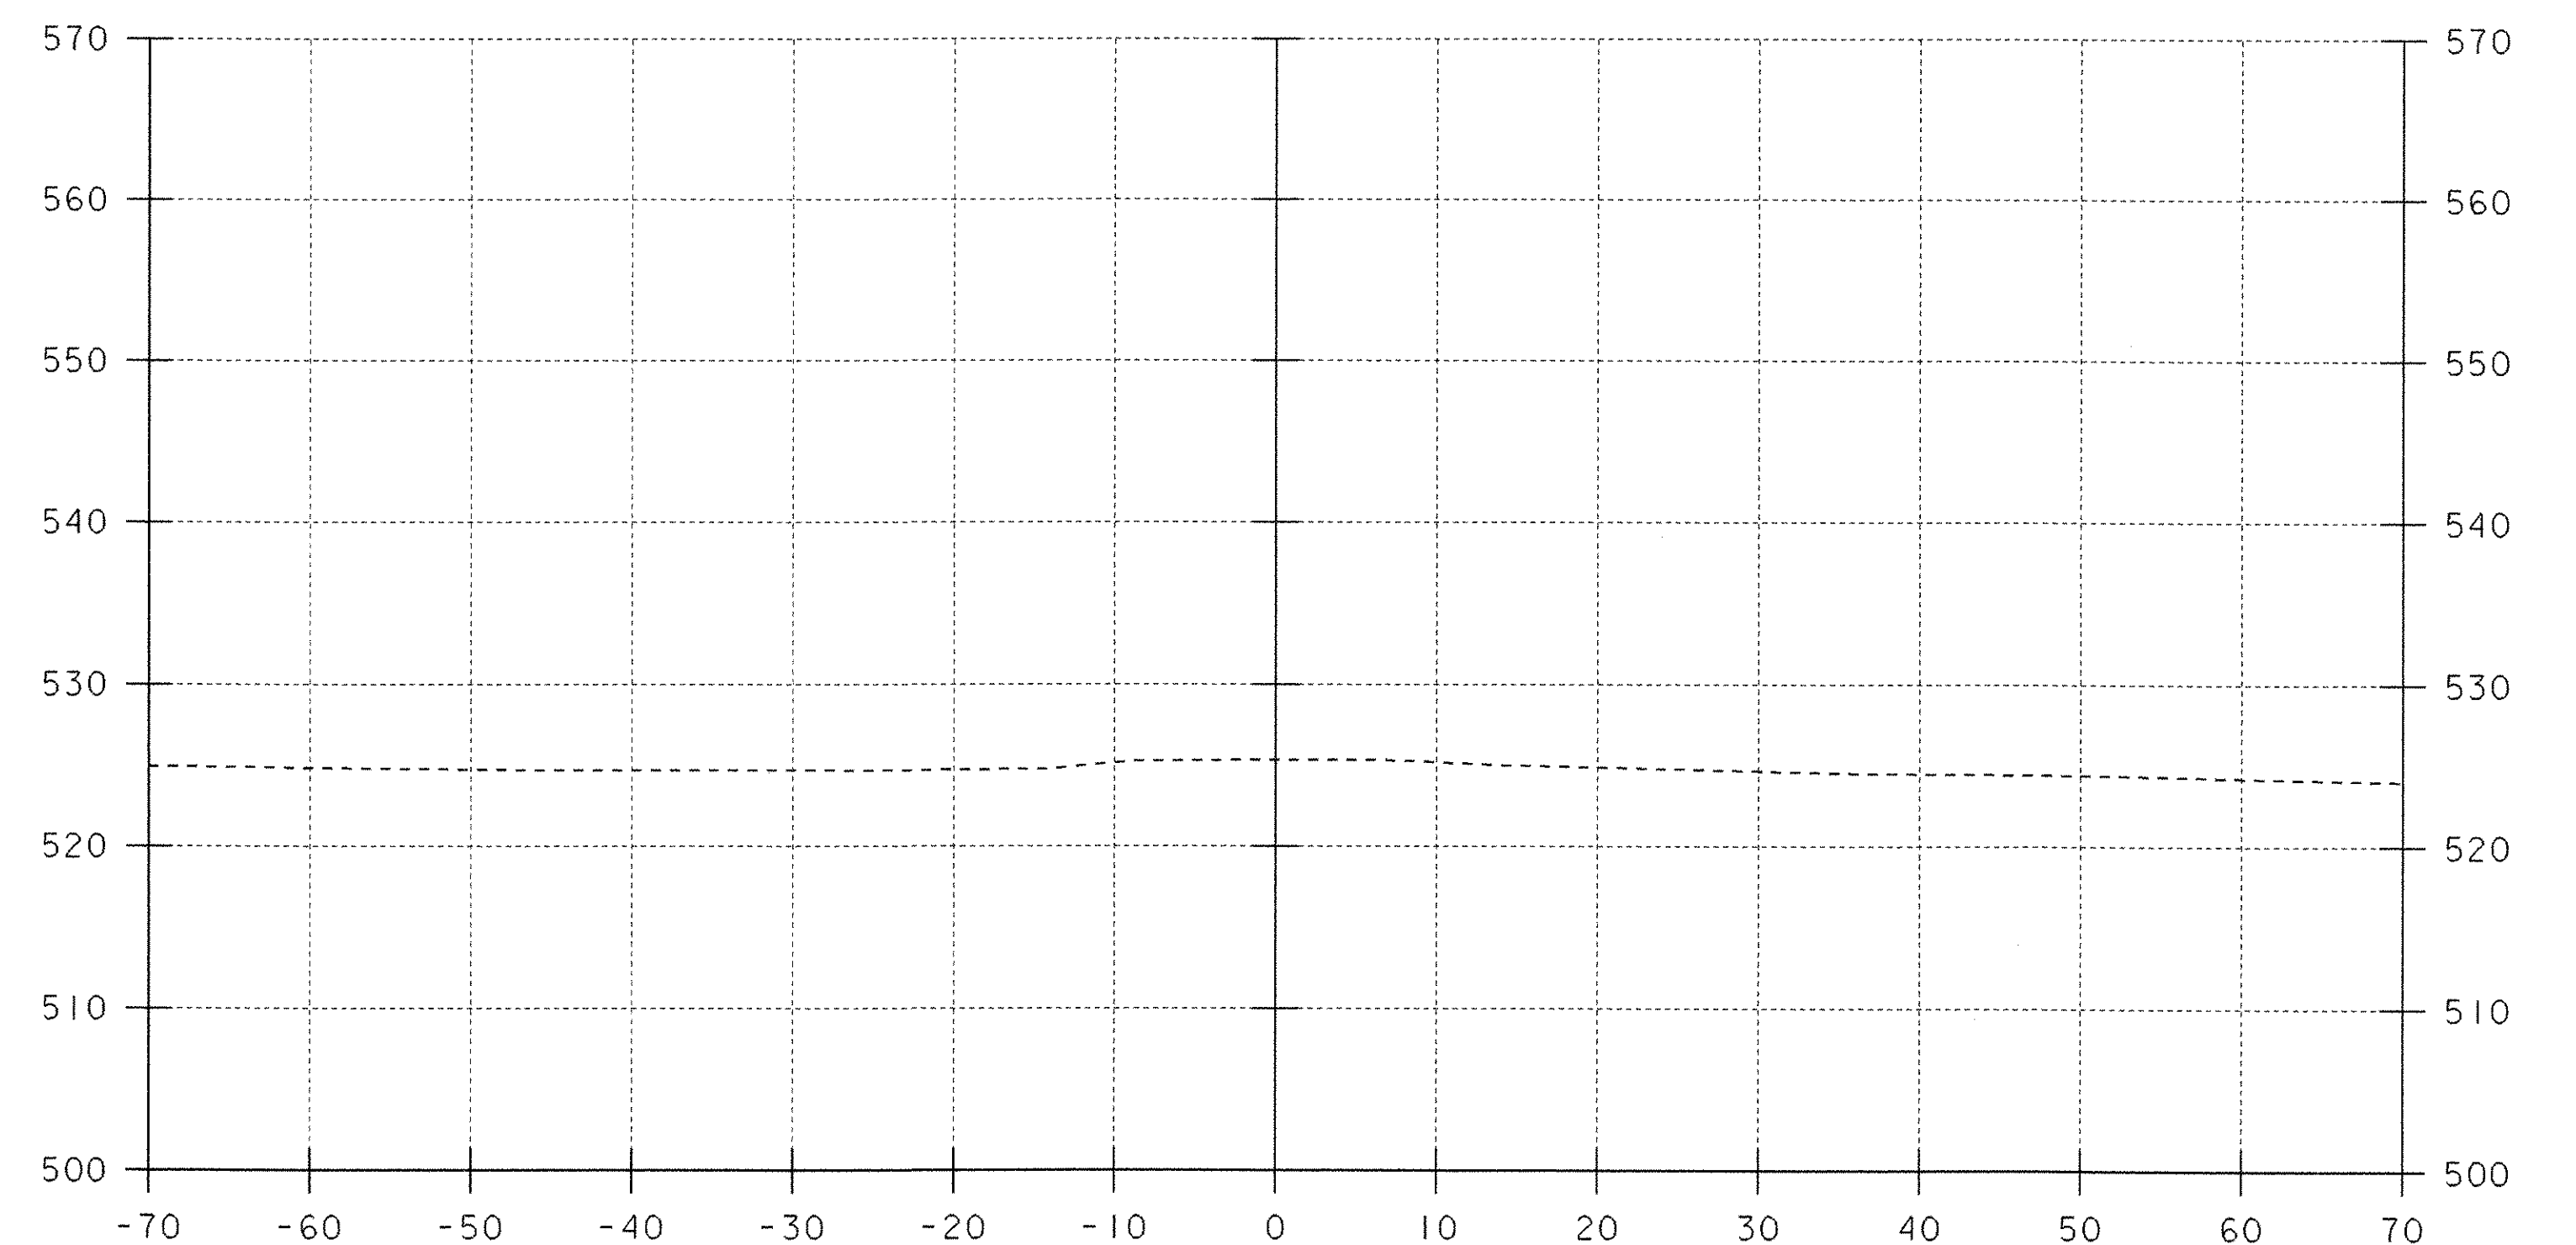

4+50

SCALE 1" = 10'-0"



PROJECT: TUNBRIDGE	PROJECT NO.: BHO 1444 (42)
DESIGN FILE NAME: 03j032/Structures/s03j032mx.dgn	PLOT DATE: 25-AUG-2005
IPARM FILE NAME: s03j032mix4.i	
MAINLINE CROSS SECTIONS	
STA 4+00 TO STA 4+75	SHEET: 29 OF 40