




6+60

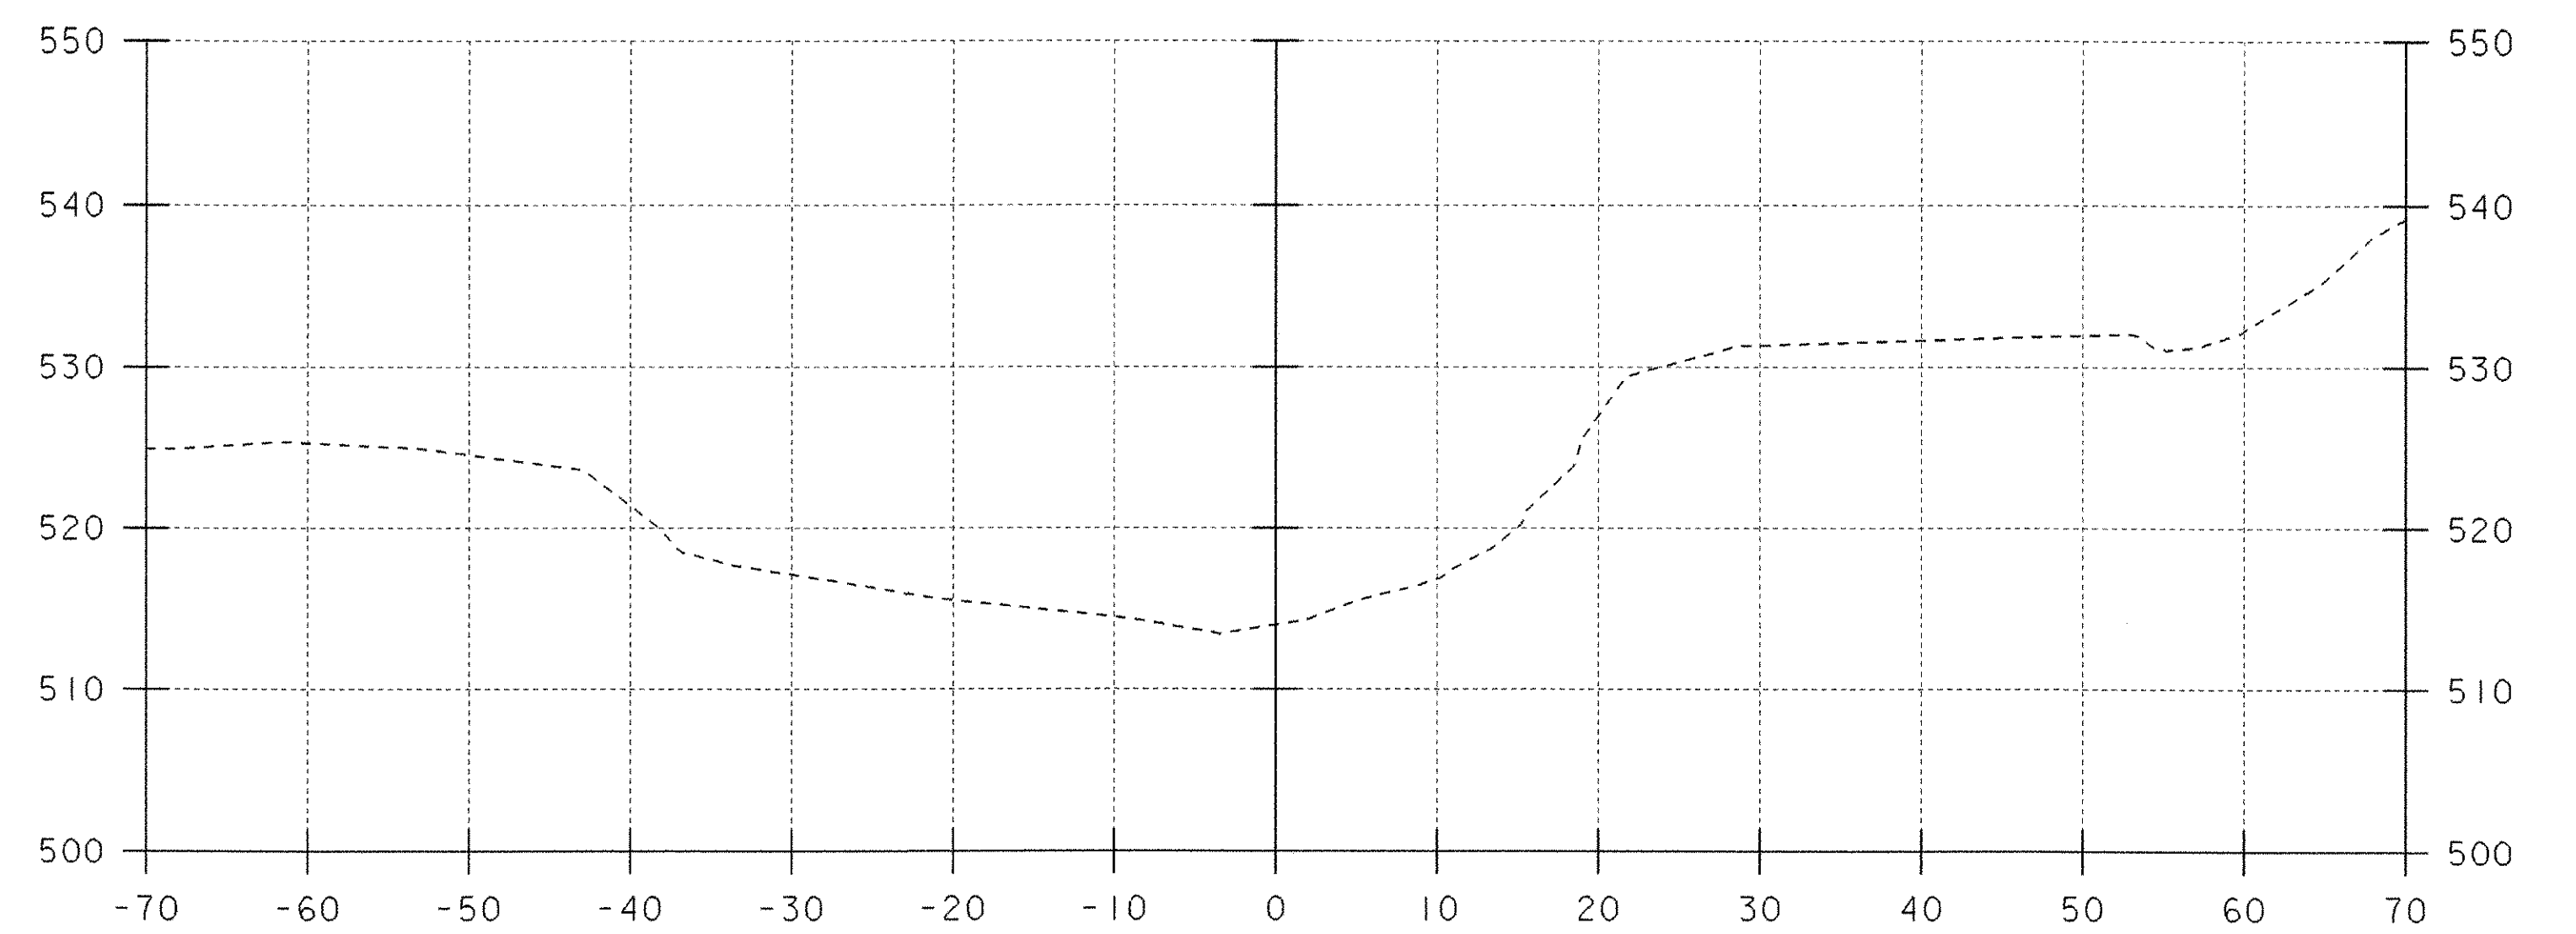

6+80

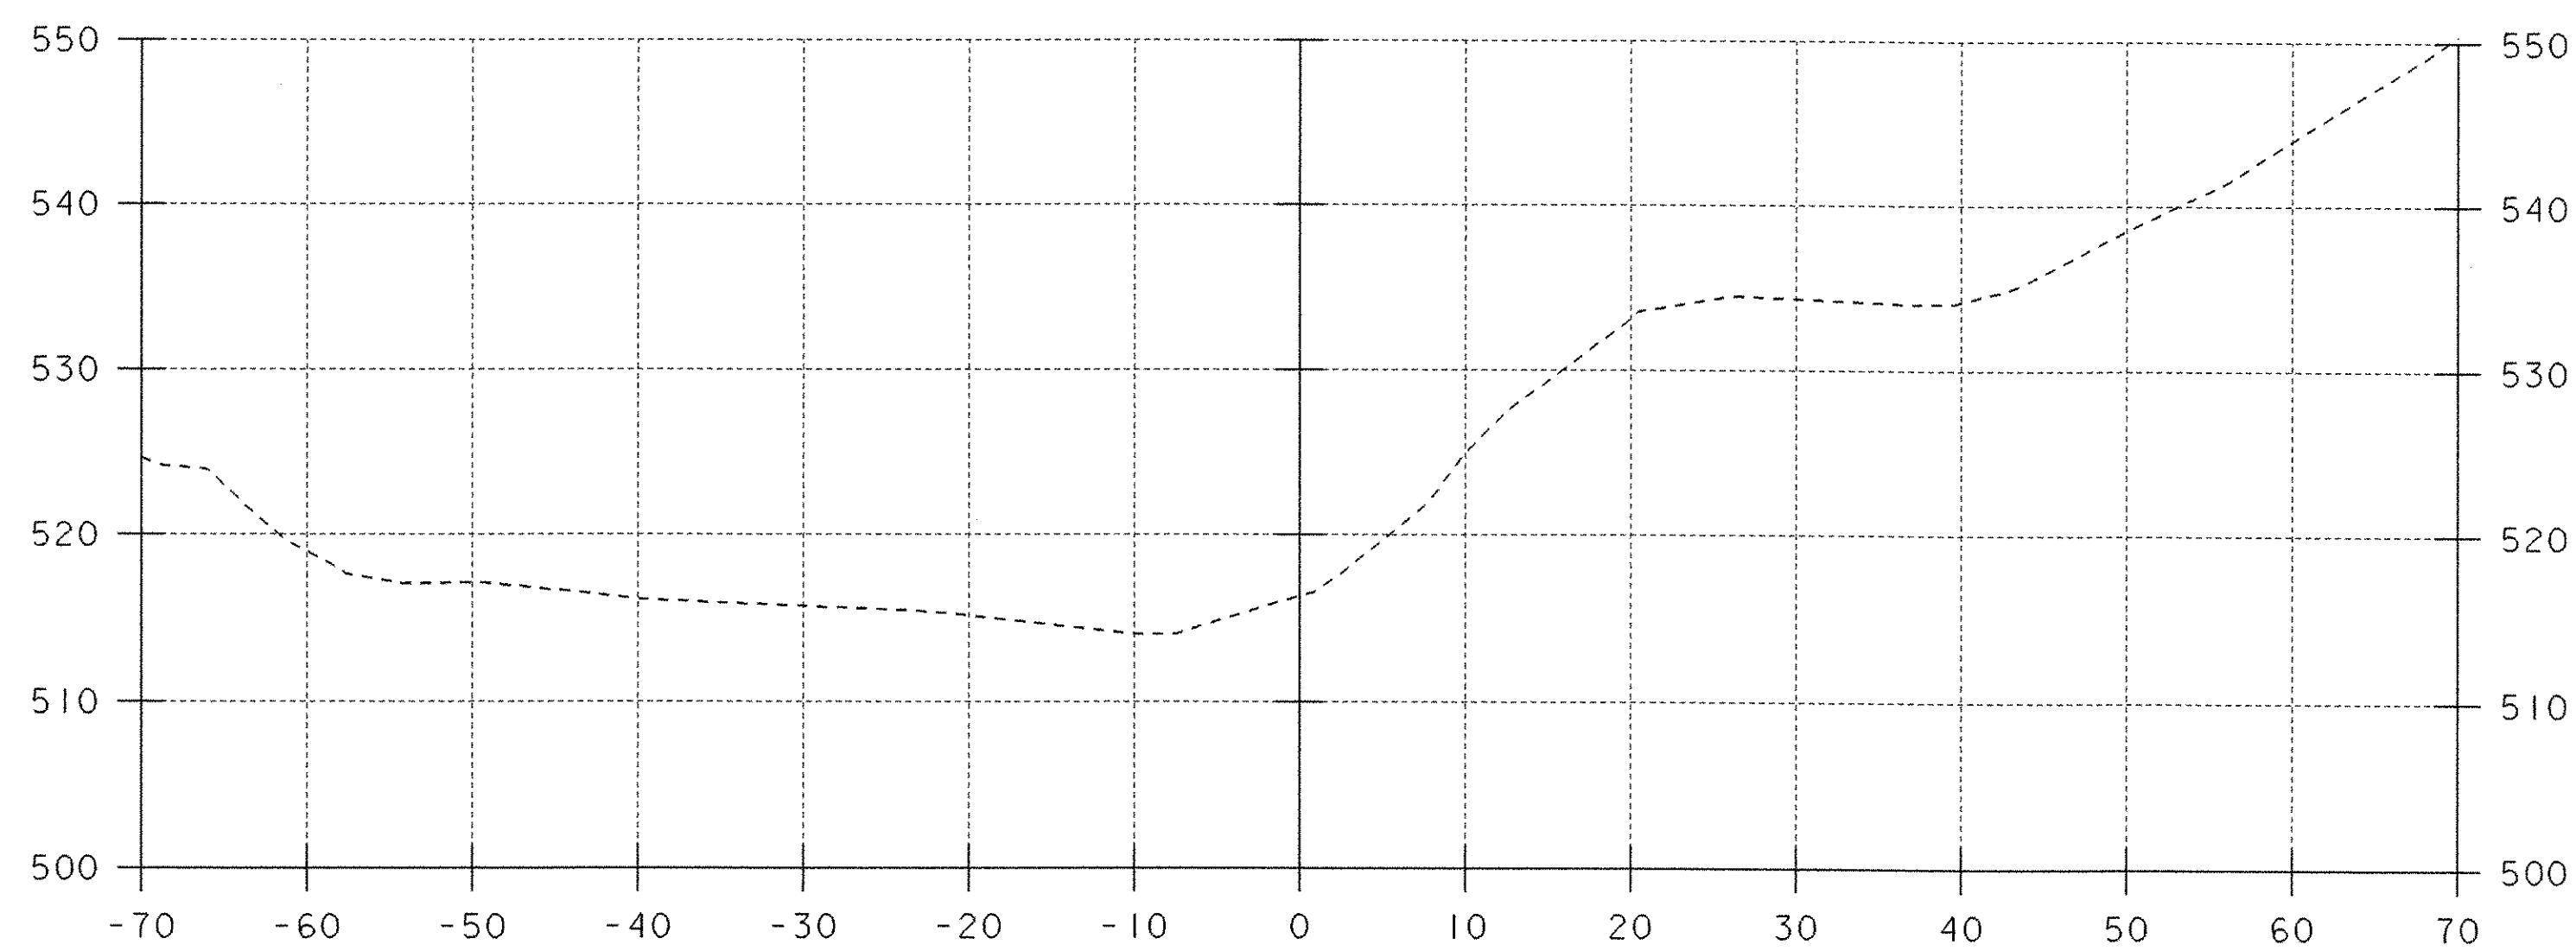

6+50

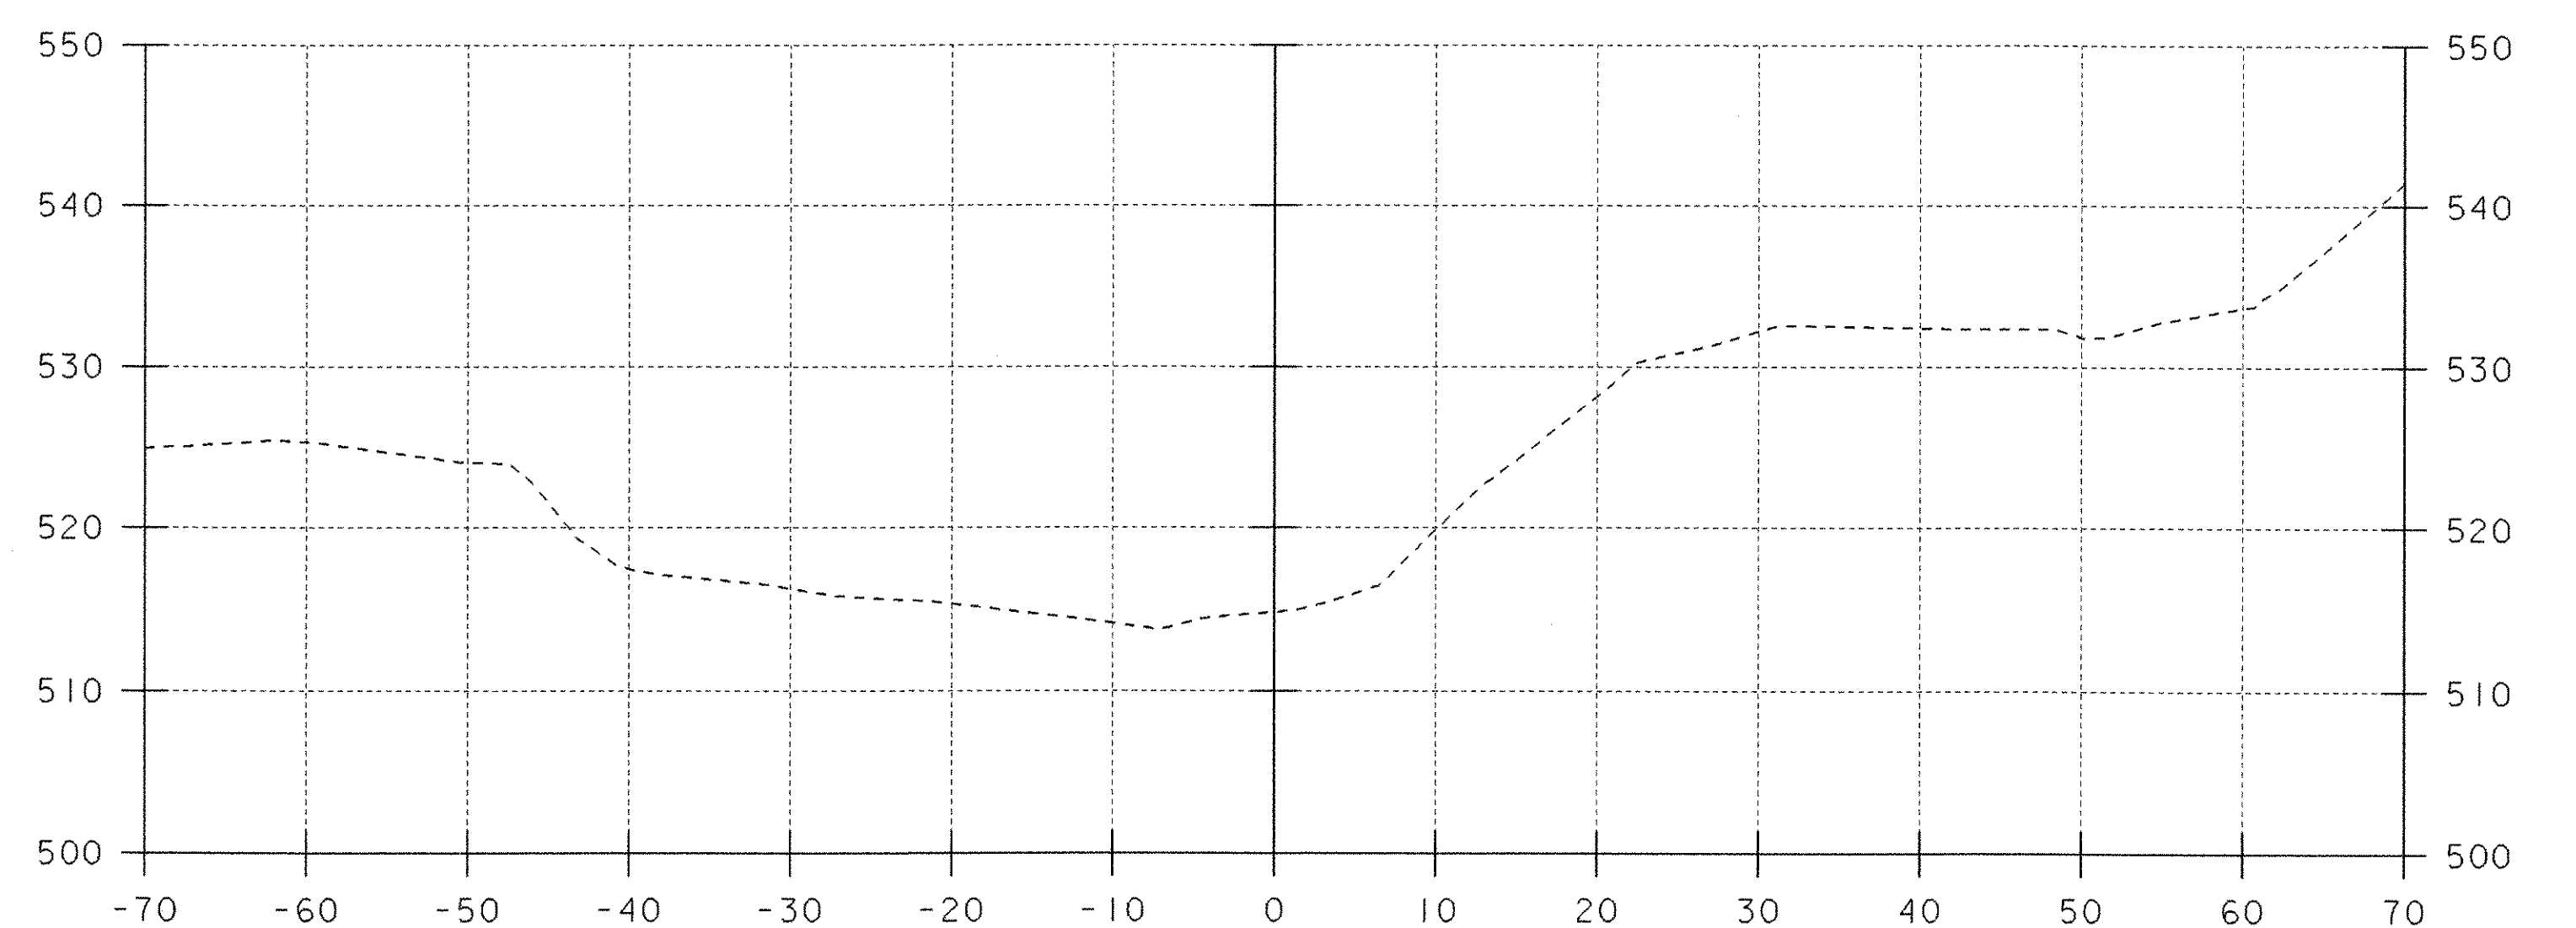

6+70

SCALE 1" = 10'-0"  
 10 0 10

PROJECT: TUNBRIDGE	PROJECT NO.: BHO 1444 (42)
DESIGN FILE NAME: 03j032/Structures/s03j032chx.dgn	PLOT DATE: 25-AUG-2005
IPARM FILE NAME: s03j032ch2xs1.i	
CHANNEL CROSS SECTIONS	
STA. 6+50 TO STA. 6+80	SHEET: 30 OF 40