


FINAL CONDITIONS SITE PLAN

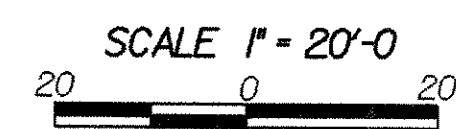

DATUM	NAVD 88
VERTICAL	NAD 83 (96)
HORIZONTAL	

PROJECT: TUNBRIDGE	PROJECT NO.: BHO 1444 (42)
DESIGN FILE NAME: s03j032/Structures/s03j032bdr.dgn	PLLOT DATE: 25-AUG-2005
IPARM FILE NAME: s03j032fincon.i	SURVEY DATE: 06/08/03
SURVEYED BY: R. GILMAN	DRAWN BY: M. FESSEL
SQUAD LEADER: C. P. WILLIAMS	SHEET: 35 OF 40
FINAL CONDITIONS SITE PLAN	