


STATE OF VERMONT
AGENCY OF TRANSPORTATION

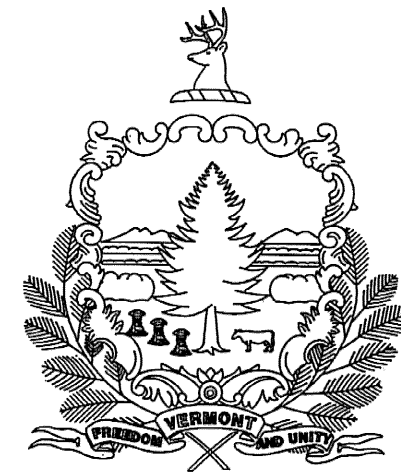


PROPOSED IMPROVEMENT
BRIDGE REHABILITATION PROJECT
TOWN OF THETFORD CENTER
COUNTY OF ORANGE

THETFORD BHO 1444 (43)
BRIDGE NO. 27 TOWN HIGHWAY 6 (CLASS 2)

PROJECT LOCATION: BEGINNING APPROXIMATELY 0.30 MILES SOUTH WEST ON TOWN HIGHWAY NO. 6 MEASURED FROM THE INTERSECTION OF TH. 6 AND VT 113 AND EXTENDING NORTH EAST 0.07 MILES.

PROJECT DISCRIPTION: REHABILITATION OF SAYERS COVERED BRIDGE

LENGTH OF ROADWAY = 269.94 FT.
LENGTH OF BRIDGE = 117.06 FT.
LENGTH OF PROJECT = 387.0 FT.

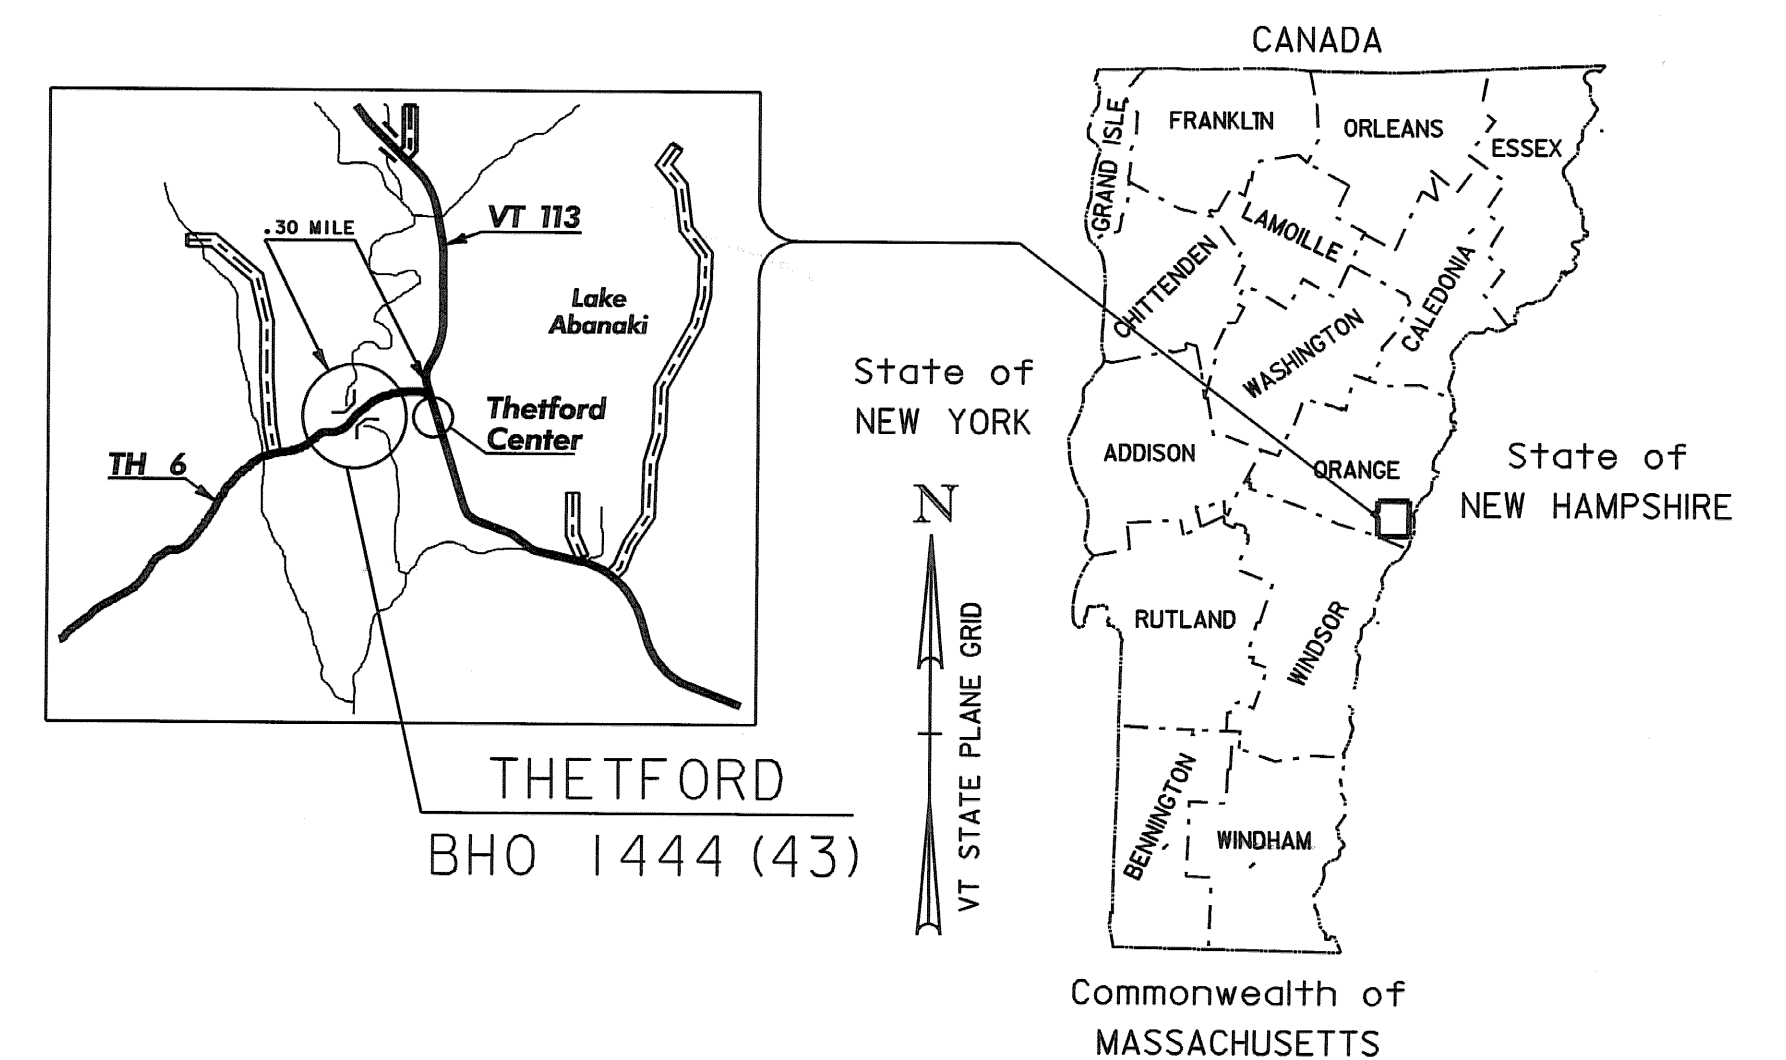


RECORD PLANS

CONTRACTOR: ALPINE CONSTRUCTION, LLC - SCHUYLerville, NY
RESIDENT ENGINEER: DAN BREER
CONSTRUCTION BEGAN: APRIL 2, 2007
CONSTRUCTION COMPLETE: SEPTEMBER 14, 2008
RECORD PLANS BY: DAN BREER & NICK GARBACIK

I HEREBY CERTIFY THAT ALL THE CONSTRUCTION REQUIRED BY THIS SET OF DRAWINGS HAS BEEN ACCOMPLISHED AS INDICATED HEREIN.

BY DW Breer RESIDENT ENGINEER
DATE 10/30/09

NOTE: Any further information concerning final quantities, amounts or other details relative to this project may be found at Central Files in the electronic archives.

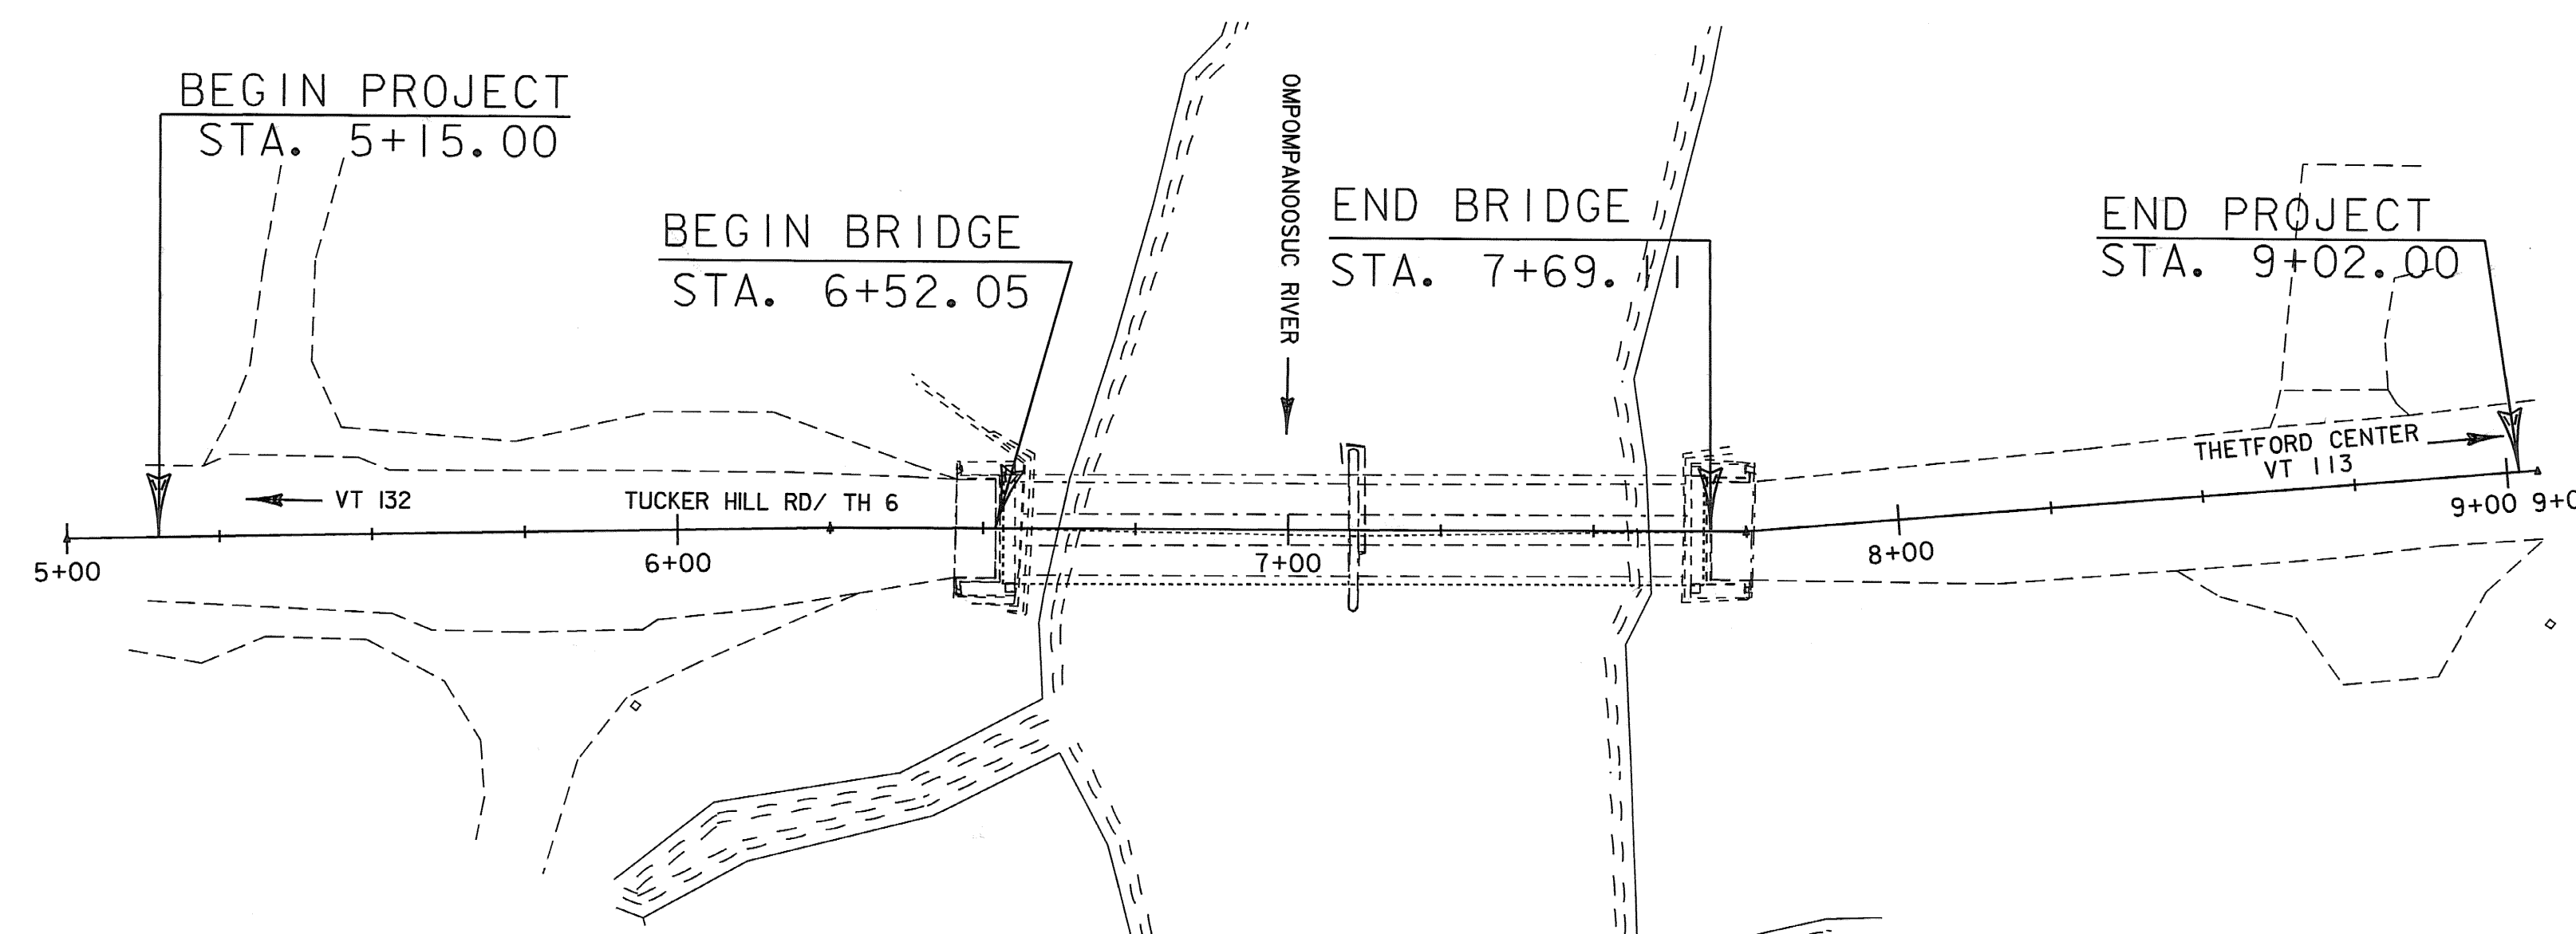


CONVENTIONAL SYMBOLS

COUNTY LINE	
TOWN LINE	
LIMITS OF ACCESS	
POINT OF ACCESS	
FENCE LINE	
STONE WALL	
TRAVELED WAY	
GUARD RAIL	
RAILROAD	
SURVEY LINE	
CULVERT	
POWER POLE	
TELEPHONE POLE	
TREES	
CONTROL OF ACCESS	
PROPERTY LINE	
R.O.W. TAKING LINE	
SLOPE RIGHTS	
TOP OF CUT	
TOE OF SLOPE	

SURVEYED BY : GILMAN
SURVEYED DATE : 2003

DATUM
VERTICAL NAVD88
HORIZONTAL NAD 83 (1996)

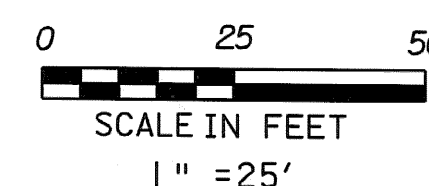

THESE PLANS ARE SUBJECT TO SUCH ENGINEERING CHANGES AS MAY BE REQUIRED BY THE FEDERAL HIGHWAY ADMINISTRATION OR THE DIRECTOR OF PROGRAM DEVELOPMENT.

CONSTRUCTION IS TO BE CARRIED ON IN ACCORDANCE WITH THESE PLANS AND THE STANDARD SPECIFICATIONS FOR CONSTRUCTION DATED 1995, AS APPROVED BY THE FEDERAL HIGHWAY ADMINISTRATION ON MARCH 15, 1990 FOR USE ON THIS PROJECT, INCLUDING ALL SUBSEQUENT REVISIONS AND SUCH REVISED SPECIFICATIONS AND SPECIAL PROVISIONS AS ARE INCORPORATED IN THESE PLANS.

DEPARTMENT OF TRANSPORTATION
FEDERAL HIGHWAY ADMINISTRATOR

APPROVED Mark P. Ricketts DATE 10-10-06

DIRECTOR OF PROGRAM DEVELOPMENT

APPROVED Paul J. Hunt DATE 9-27-06

PROJECT MANAGER : M. EVANS-MONGEON

PROJECT NAME : THETFORD
PROJECT NUMBER : BHO 1444 (43)

SHEET 1 OF 60 SHEETS