



# MATERIAL TRANSITION

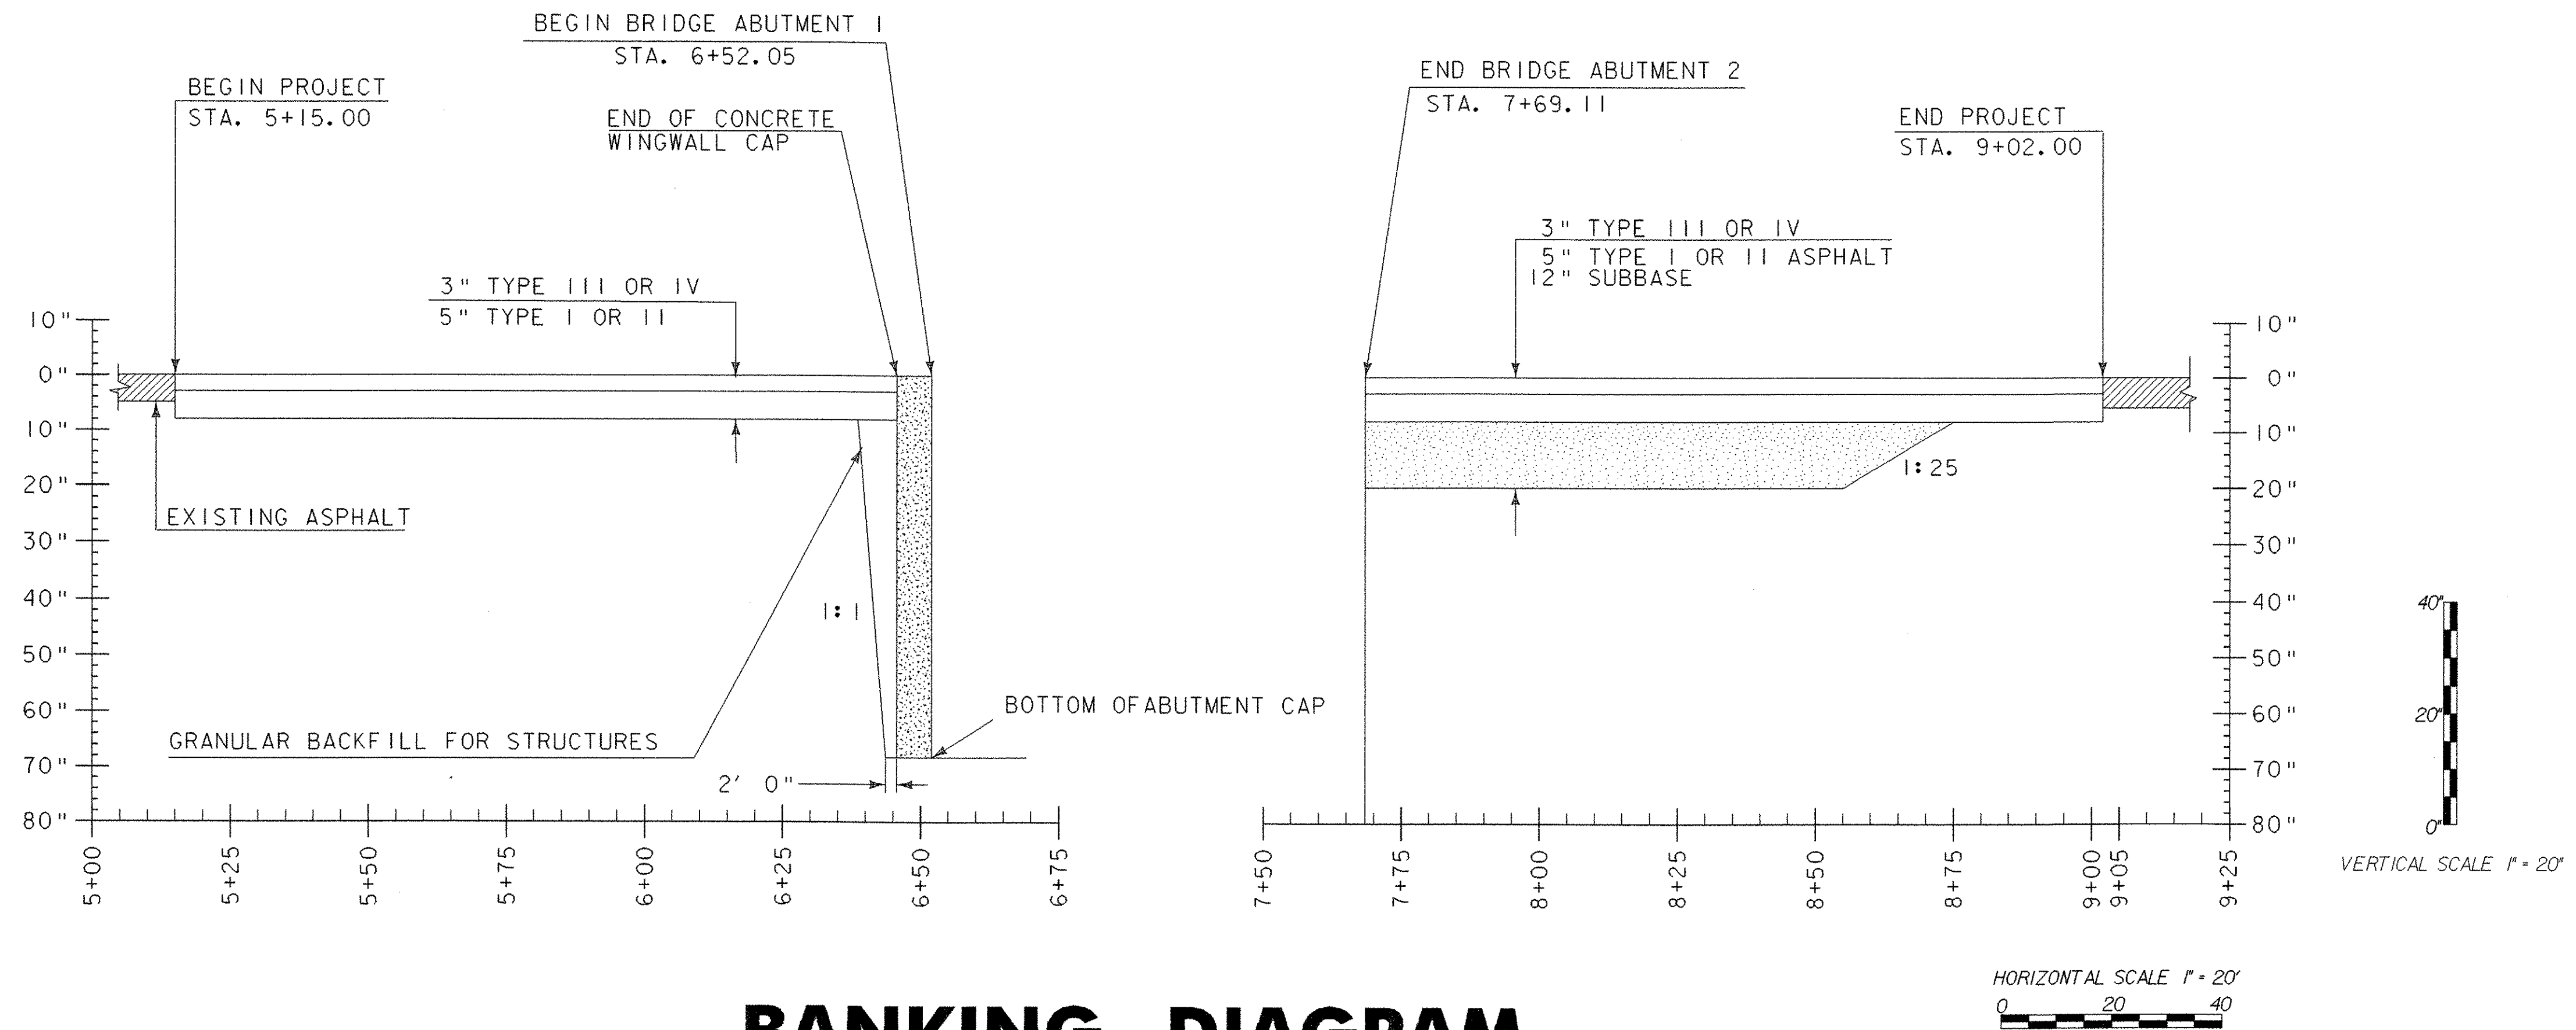

# BANKING DIAGRAM

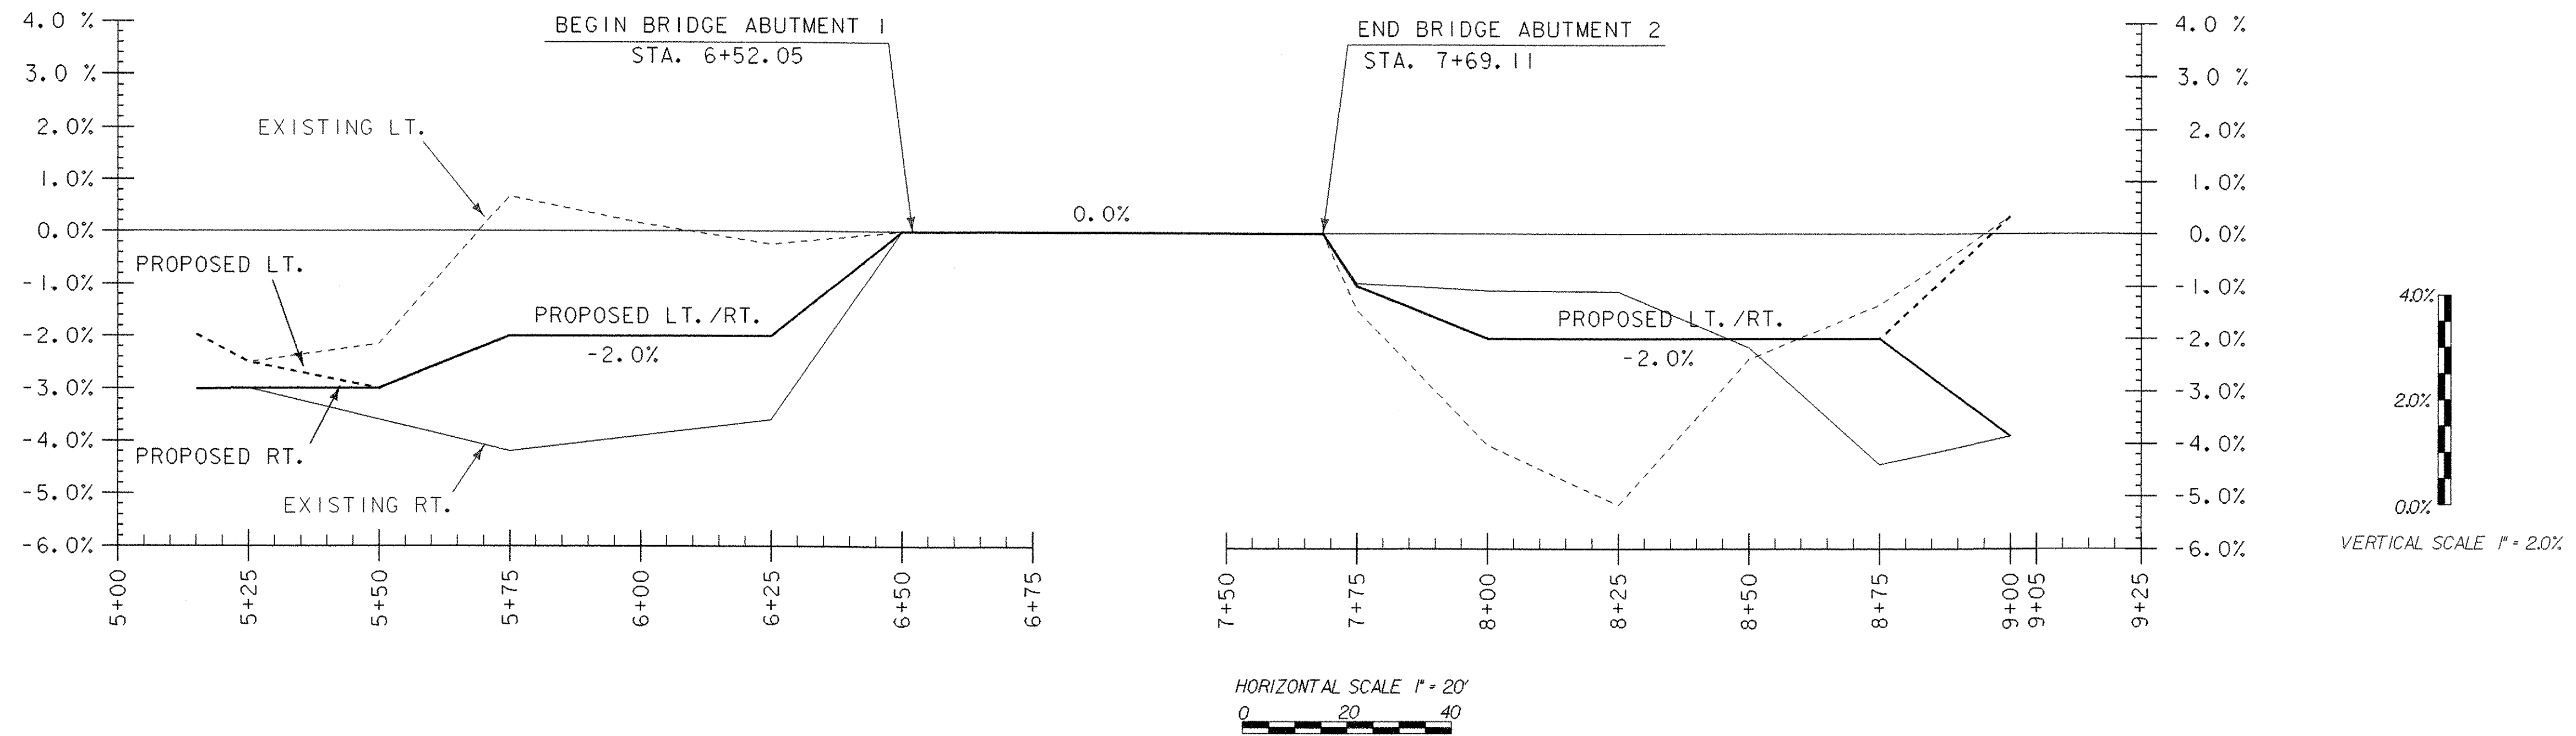

## MATERIAL TRANSITION / BANKING DIAGRAM

PROJECT NAME: THETFORD	PLOT DATE: 27-SEP-2006
PROJECT NUMBER: BHO 1444 (43)	DRAWN BY: G. ROKES
FILE NAME: Structures\s03j036typ.dgn	CHECKED BY: S. SCRIBNER
PROJECT LEADER: M. EVANS-MONGEON	SHEET II OF 60
DESIGNED BY: G. ROKES	
IPARM: s03j036mat.i	