


LEGEND	
-----	WETLAND BUFFER ZONE
-----	RIPARIAN BUFFER
////	LEDGE
ARCH	ARCHEOLOGICAL LIMITS
FLOOD PLAIN	ESTIMATED FLOOD PLAIN
HISTORIC DIST	HISTORIC DISTRICT
▲	WETLAND BOUNDARY
-----	SOIL TYPE BOUNDARY

NOTE:
 CONTOURS SHOWN ARE THE EXISTING SITE CONTOURS.
 SEE CROSS SECTIONS AND PLAN VIEW FOR GRADE CHANGES.

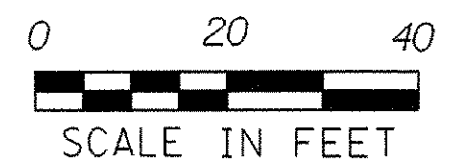

**EROSION AND SEDIMENT CONTROL PLAN
 FINAL SITE CONDITIONS**

PROJECT NAME:	THETFORD
PROJECT NUMBER:	BHO 1444 (43)
FILE NAME:	Structures\s03j036ero.dgn
PROJECT LEADER:	M.EVANS-MONGEON
DESIGNED BY:	G. ROKES
IPARM:	s03j036er3.1
PLOT DATE:	27-SEP-2006
DRAWN BY:	G.ROKES
CHECKED BY:	S. SCRIBNER
SHEET	23 OF 60