



ABUTMENT #1 FRONT ELEVATION VIEW

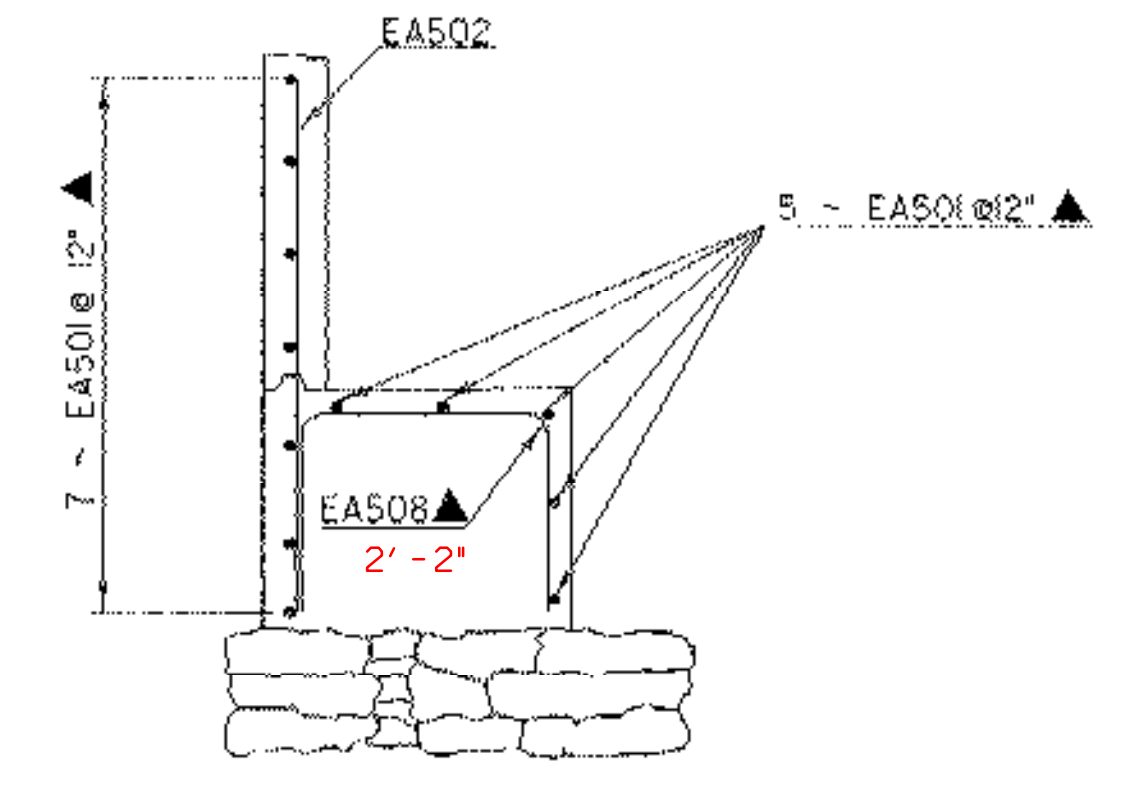


E-E SECTION

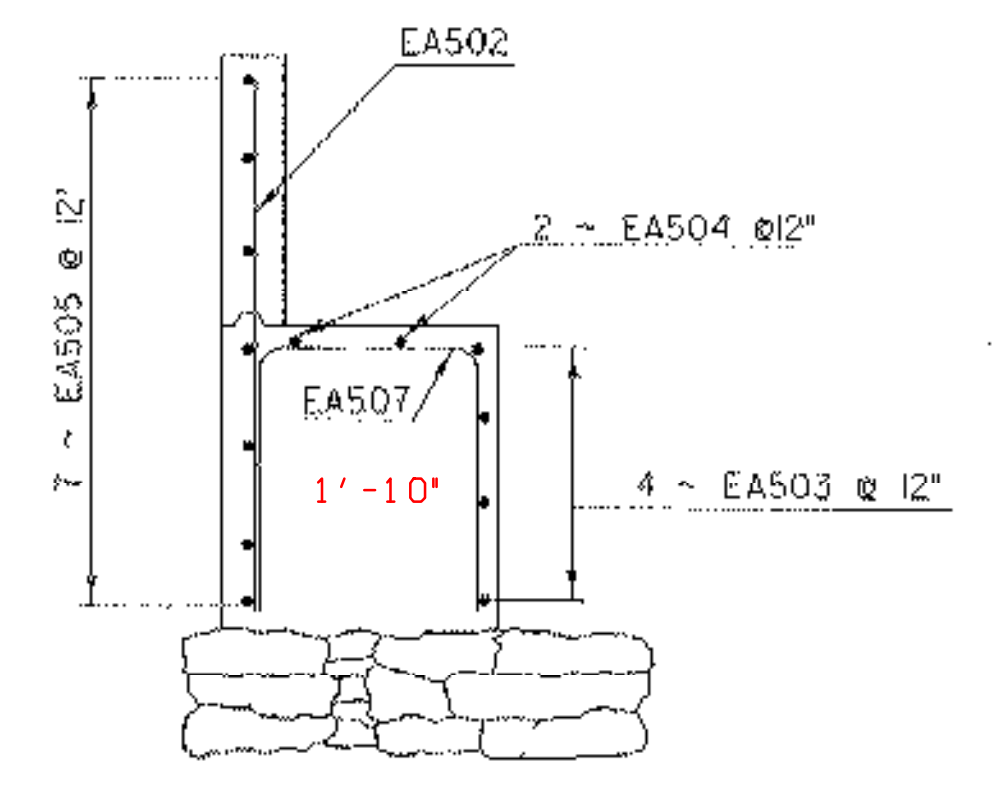

F-F SECTION

ELEVATION NOTE: PROPOSED BRIDGE SEAT ELEVATION WILL BE SET $\frac{1}{16}$ " BELOW THE EXISTING BRIDGE SEAT ELEVATION. EXISTING BRIDGE SEAT ELEVATION TO BE MEASURED IN THE FIELD.

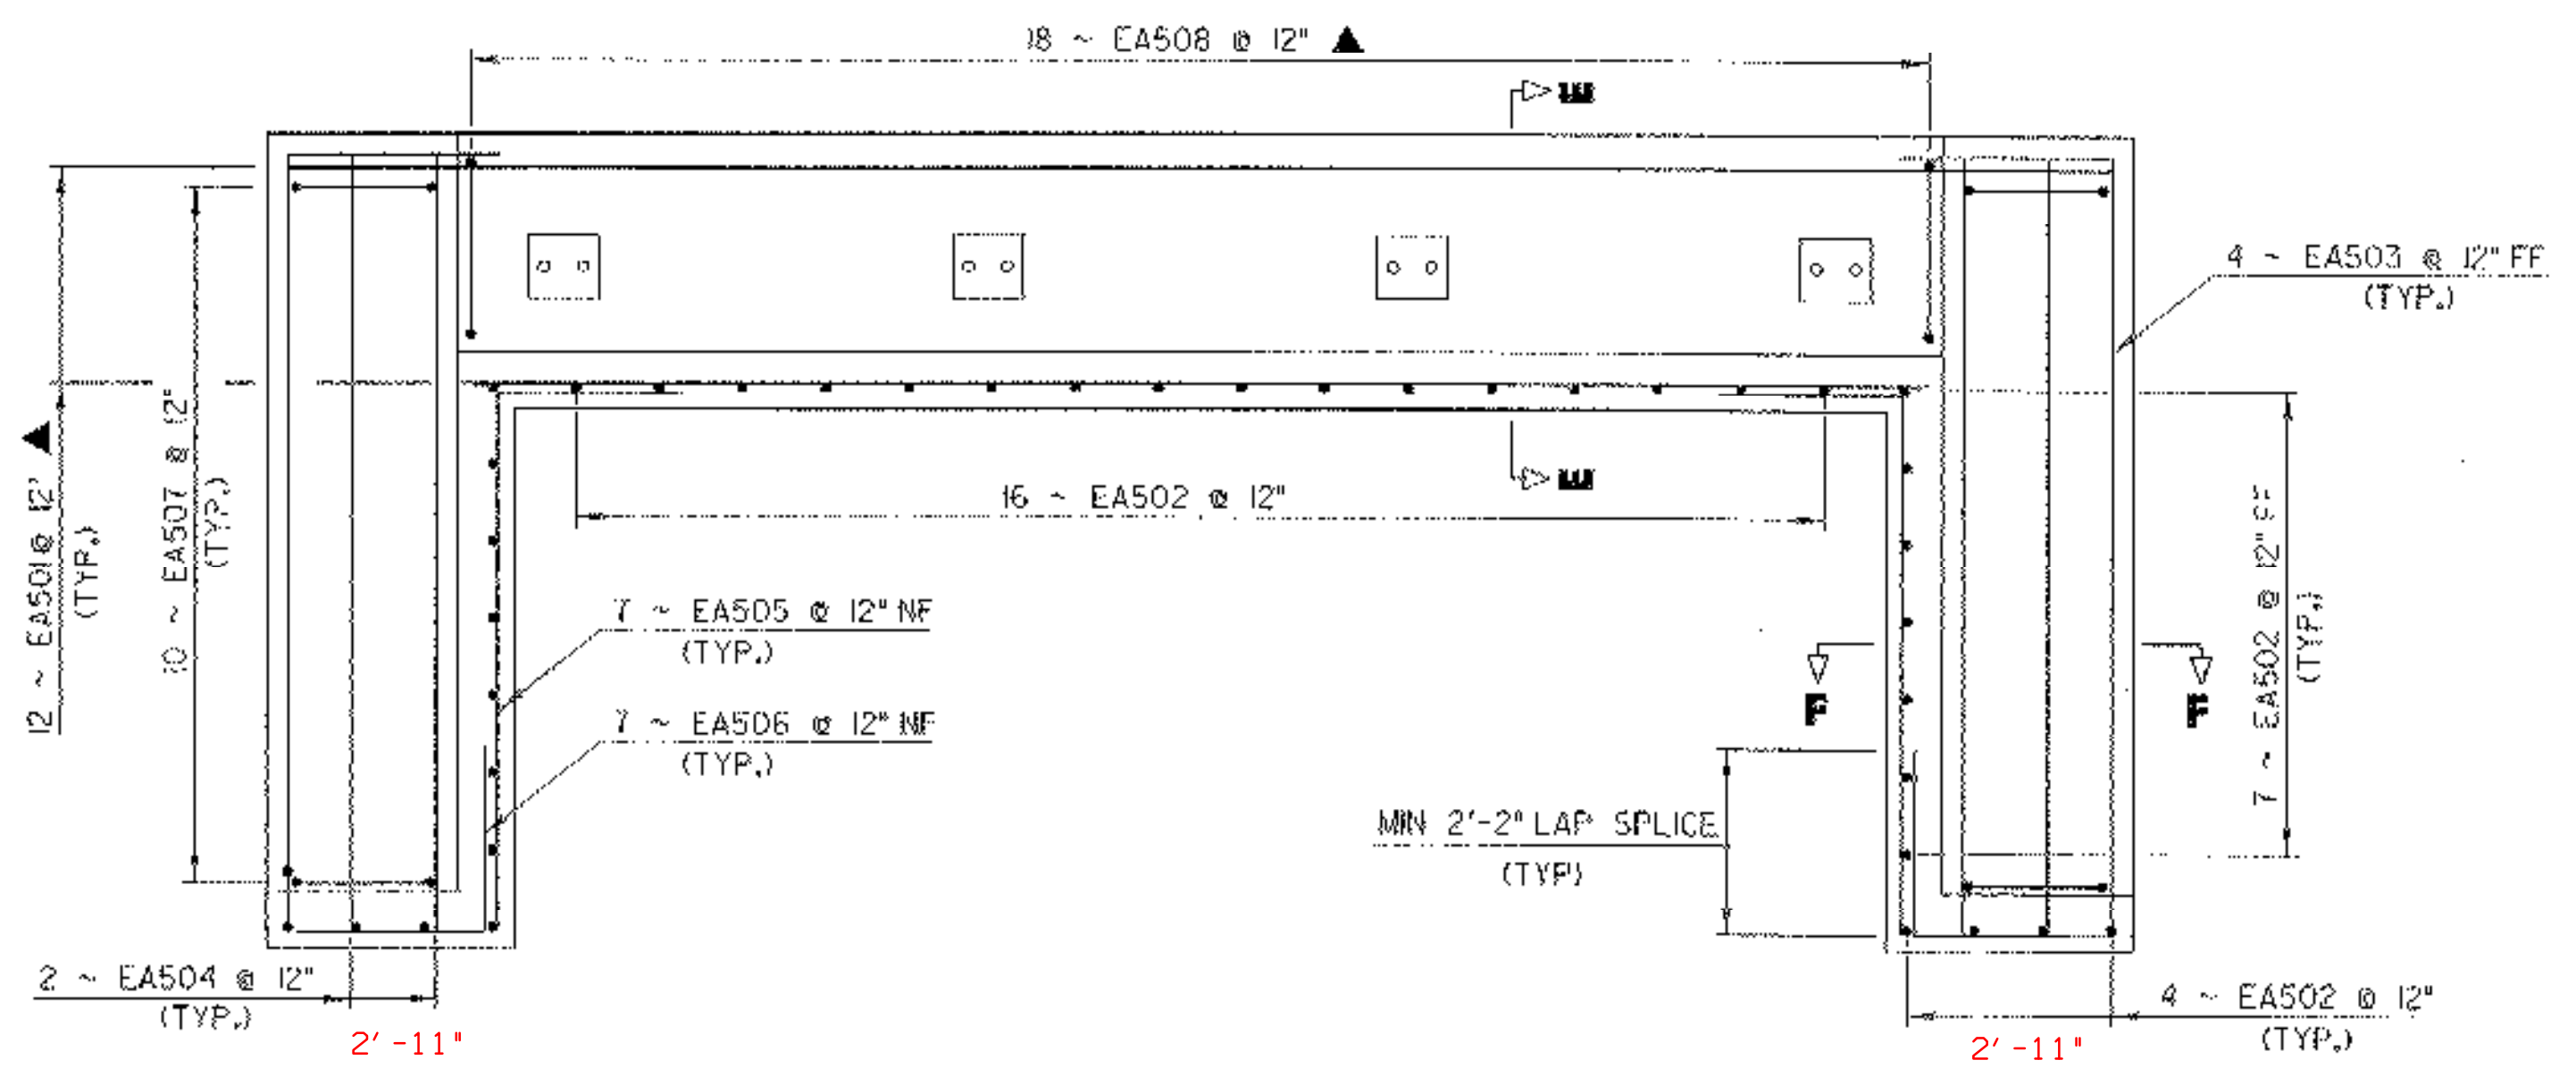

ABUTMENT #1 PLAN VIEW

NOTE:
 NF = NEAR FACE
 FF = FAR FACE
 EF = EACH FACE
 ▲ = A CUT TO FIT IN THE FIELD. EPOXY COATED STEEL MUST BE PROPERLY SEALED AFTER THE CUT. REFER TO SPEC. 507.04 3 INCHES CLEAR UNLESS OTHERWISE SPECIFIED ON THE PLANS

ABUTMENT CAP #1 REBAR LAYOUT SHEET

PROJECT NAME:	THETFORD		
PROJECT NUMBER:	BHO 1444 (43)		
FILE NAME:	Structures\03j036abt.dgn	PLOT DATE:	27-SEP-2006
PROJECT LEADER:	M. EVANS-MONGEON	DRAWN BY:	G. ROKES
DESIGNED BY:	M. EVANS-MONGEON	CHECKED BY:	S. SCRIBNER
IPARM:	03j036ar-1	SHEET	37 OF 60

SCALE $\frac{1}{2}$ " = 1'-0"